


7-88-1A

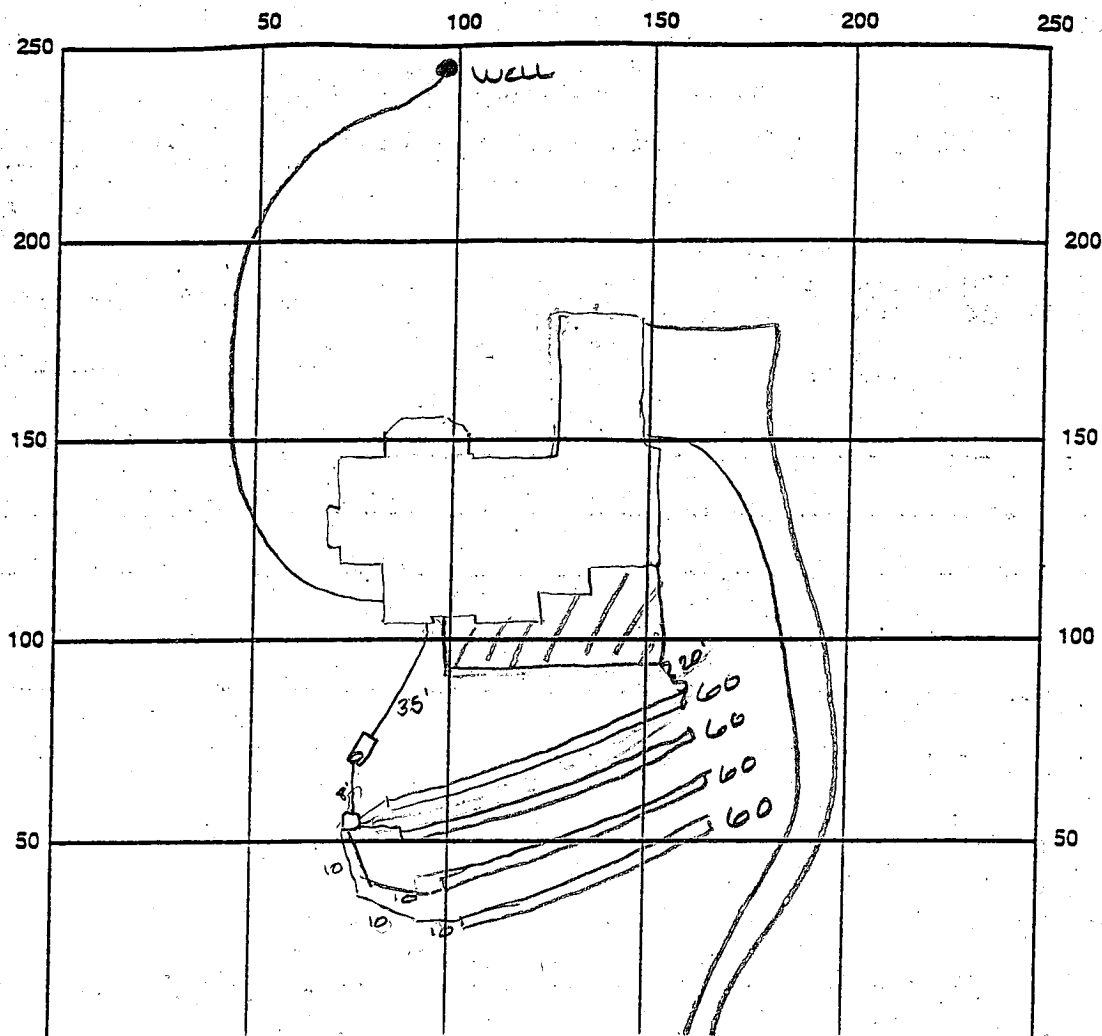

INDICATE NORTH - NAME ADJOINING ROADWAY AS BASE LINE

Ridge Hunt Dr

SEPTIC TANK LEVEL OK 1250 gal CLEANOUTS OK  
 DISTRIBUTION BOX LEVEL OK baffles in  
 DRAIN FIELD/TITLE DEPTH 4.5 FT. TRENCH WIDTH 3.0 FT. INLET DEPTH 3.0 FT.  
 EFFECTIVE GRAVEL DEPTH 1.5 FT. TOTAL LENGTH 240 FT.  
 NUMBER OF TRENCHES 4 ONE SIDEWALL/BOTTOM AREA 720 SQ. FT. <sup>240</sup>  
 DRYWALL INSIDE DIAMETER — FT. EFFECTIVE DEPTH BELOW INLET 4.5 FT.  
 ABSORBENT AREA — SQ. FT.

REMARKS: 12/14/98 OK to cover all work A

DATE SYSTEM APPROVED 12/14/98 INSPECTOR A McMill

# APPLICATION

## PERCOLATION TESTING

A 50388 UU

P \_\_\_\_\_

HOWARD COUNTY HEALTH DEPARTMENT

BUREAU OF ENVIRONMENTAL HEALTH

3525-H ELLICOTT MILLS DRIVE/ELLICOTT CITY, MARYLAND 21043  
TELEPHONE: 313-2640

DISTRICT \_\_\_\_\_

DATE 11/10/94

TO: THE COUNTY HEALTH OFFICER  
ELLICOTT CITY, MARYLAND

I HEREBY APPLY FOR THE NECESSARY TEST PRIOR TO APPLICATION FOR PERMIT TO CONSTRUCT (OR RECONSTRUCT) A SEWAGE DISPOSAL SYSTEM.

PROPERTY OWNER Richard Hoenes Selfridge Builders

8668 Baltimore National Pike  
ADDRESS Ellicott City, Maryland 21043 PHONE (410) 465-2321

AGENT OR PROSPECTIVE BUYER Same

ADDRESS \_\_\_\_\_ PHONE \_\_\_\_\_

PROPERTY LOCATION:

SUBDIVISION White Property LOT NO. 21 2024 1 & 2

ROAD AND DESCRIPTION South side 15000 block of Carrs Mill Road; 1 mile +/- west  
of Roxbury Mills Road intersection. (15255 Ridge Hunt Drive)

TAX MAP 14 PARCEL # 14

SIZE OF LOT 60,000 SF TYPE BLDG. Single Family - 4 Bdrms  
(SINGLE FAMILY DWELLING OR COMMERCIAL)

AND RETURNED 8-13-94  
Serial # B10 113383

THE SYSTEM INSTALLED UNDER THIS APPLICATION IS ACCEPTABLE ONLY UNTIL PUBLIC FACILITIES BECOME AVAILABLE. I FULLY UNDERSTAND THE

FEE CONNECTED WITH THE FILING OF THIS PERC TEST APPLICATION IS NON-REFUNDABLE UNDER ANY CIRCUMSTANCES. I ALSO AGREE TO

COMPLY WITH ALL M.O.S.H.A. REQUIREMENTS IN TESTING THIS LOT. Richard Hoenes  
(SIGNATURE OF APPLICANT)

APPROVED BY \_\_\_\_\_ FOR \_\_\_\_\_ DATE \_\_\_\_\_

DISAPPROVED BY \_\_\_\_\_ FOR \_\_\_\_\_ DATE \_\_\_\_\_

HOLD PENDING FURTHER TESTS \_\_\_\_\_

REASONS FOR REJECTION OR HOLDING \_\_\_\_\_

PERCOLATION TEST PLAT/PRELIMINARY PLAT - TITLE OR I.D. # \_\_\_\_\_ DATE \_\_\_\_\_

SITE DEVELOPMENT PLAN/FINAL PLAT - TITLE OR I.D. # \_\_\_\_\_ DATE \_\_\_\_\_

# THIS IS NOT A PERMIT

A50388U  
COUNTY#

SOIL PROFILE

0' 1189

orange  
red  
SiCL

5' orange  
yellow  
SiL

45%  
very  
decayed  
saprolite

9' red  
SL

very  
powdery  
10% saprolite

1186

1' top soil

red brn  
C

3' yellow  
tan  
CSiL

4' pink  
SL

yellow  
red mottled  
appearance  
probably  
from  
parent  
rock

12' 1185

red  
brn  
C


3' yellow  
brn C

4' pink  
SL

red &  
yellow  
streaks  
on side  
walls

white SL  
at bottom

12'

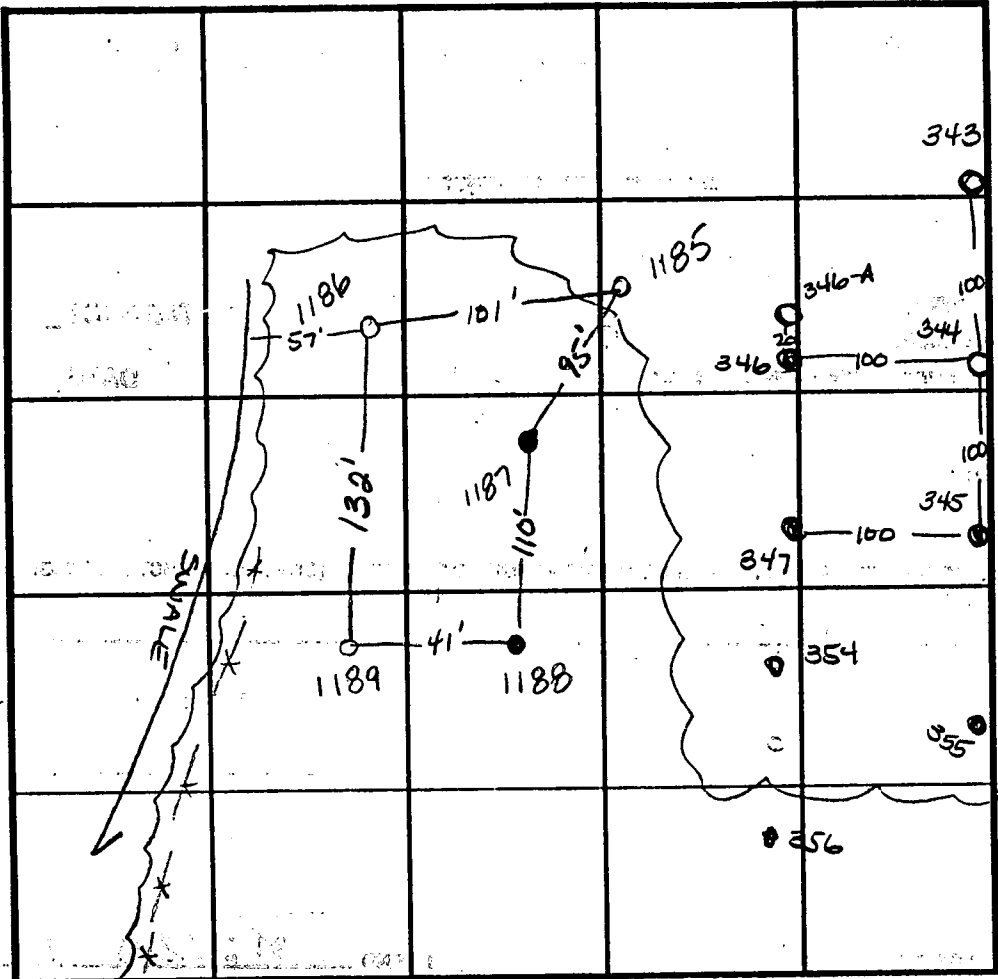

SOIL PROFILE

343 344

yellow  
brown  
SiCLm

2.0' dark  
pink  
red

Salmon  
25%  
shale  
fragments

INDICATE NORTH - NAME ADJOINING ROADWAY AS BASE LINE.

DATE	TEST NO.	DEPTH	PRE-WET		TEST - 1" DROP		TIME
			START	STOP	START	STOP	
12-15-94	1189	4' VII	5:35 <sup>15</sup>	5:37 <sup>30</sup>	5:37 <sup>30</sup>	5:42 <sup>30</sup>	4 1/2 min
	1188	Hard bottom at 4'					F
	1187	Hard bottom at 6'					F
	1186	4' VII.5	6:11 <sup>15</sup>	6:12 <sup>45</sup>	6:12 <sup>45</sup>	6:17 <sup>30</sup>	4 1/4 min
	1185	4' VII.2	6:07	6:08	6:08	6:09 <sup>45</sup>	1 3/4 min
3-20-96	343	Visual	to 13.0 - see profile -				OK
	344	Visual	to 13.0 - see profile -				OK
	346	>50% rock	refusal @ 10.0' -				F
	345	>50% rock	refusal @ 10.5' -				F
	346	>50% rock	bottom at 11' -				F

REMARKS

TYPE OF SOIL

TESTED BY

ALSO PRESENT

TRENCH DESIGN DATA: AVERAGE PERCOLATION TIME

TRENCH WIDTH

INLET DEPTH

MAXIMUM BOTTOM DEPTH

SQ. FT./BEDROOM

# APPLICATION

PERCOLATION TESTING

A 50388T

P \_\_\_\_\_

HOWARD COUNTY HEALTH DEPARTMENT  
BUREAU OF ENVIRONMENTAL HEALTH

3525-H ELLICOTT MILLS DRIVE/ELLICOTT CITY, MARYLAND 21043  
TELEPHONE: 313-2840

DISTRICT \_\_\_\_\_

DATE 11/10/99

TO: THE COUNTY HEALTH OFFICER  
ELLICOTT CITY, MARYLAND

I HEREBY APPLY FOR THE NECESSARY TEST PRIOR TO APPLICATION FOR PERMIT TO CONSTRUCT (OR RECONSTRUCT) A SEWAGE DISPOSAL SYSTEM.

PROPERTY OWNER Richard Hoenes

ADDRESS 8668 Baltimore National Pike  
Ellicott City, Maryland 21043 PHONE (410) 465-2321

AGENT OR PROSPECTIVE BUYER Same

ADDRESS \_\_\_\_\_ PHONE \_\_\_\_\_

PROPERTY LOCATION:

SUBDIVISION White Property LOT NO. 20 1A 23

ROAD AND DESCRIPTION South side 15000 block of Carrs Mill Road; 1 mile +/- west  
of Roxbury Mills Road intersection.

TAX MAP 14 PARCEL # 14

SIZE OF LOT 60,000 SF TYPE BLDG. Single Family  
(SINGLE FAMILY DWELLING OR COMMERCIAL)

THE SYSTEM INSTALLED UNDER THIS APPLICATION IS ACCEPTABLE ONLY UNTIL PUBLIC FACILITIES BECOME AVAILABLE. I FULLY UNDERSTAND THE  
FEE CONNECTED WITH THE FILING OF THIS PERC TEST APPLICATION IS NON-REFUNDABLE UNDER ANY CIRCUMSTANCES. I ALSO AGREE TO  
COMPLY WITH ALL M.O.S.H.A. REQUIREMENTS IN TESTING THIS LOT. Richard Hoenes  
(SIGNATURE OF APPLICANT)

APPROVED BY \_\_\_\_\_ FOR \_\_\_\_\_ DATE \_\_\_\_\_

DISAPPROVED BY \_\_\_\_\_ FOR \_\_\_\_\_ DATE \_\_\_\_\_

HOLD PENDING FURTHER TESTS \_\_\_\_\_

REASONS FOR REJECTION OR HOLDING \_\_\_\_\_

PERCOLATION TEST PLAT/PRELIMINARY PLAT - TITLE OR I.D. # \_\_\_\_\_ DATE \_\_\_\_\_

SITE DEVELOPMENT PLAN/FINAL PLAT - TITLE OR I.D. # \_\_\_\_\_ DATE \_\_\_\_\_

# THIS IS NOT A PERMIT


AS 0388T  
COUNTY #

SOIL PROFILE

0' 1184  
dark red  
brn  
C  
3.5' white  
yellow  
orange  
mottled  
appearance  
sil  
very  
powdery  
appears  
pink  
m  
PILC  
12' white  
S.S.L

1183  
dark  
red  
C  
4' bright  
red  
w/  
yellow  
streaks  
sil  
brn parent  
fossil  
very  
hard  
soil/  
saprolite  
at bottom  
10'

1186  
top soil  
1' red brn  
C  
3' yellow  
tan  
sil  
4' pink  
SL  
yellow/red  
mottled  
appearance  
probably  
from  
parent  
rock  
12'

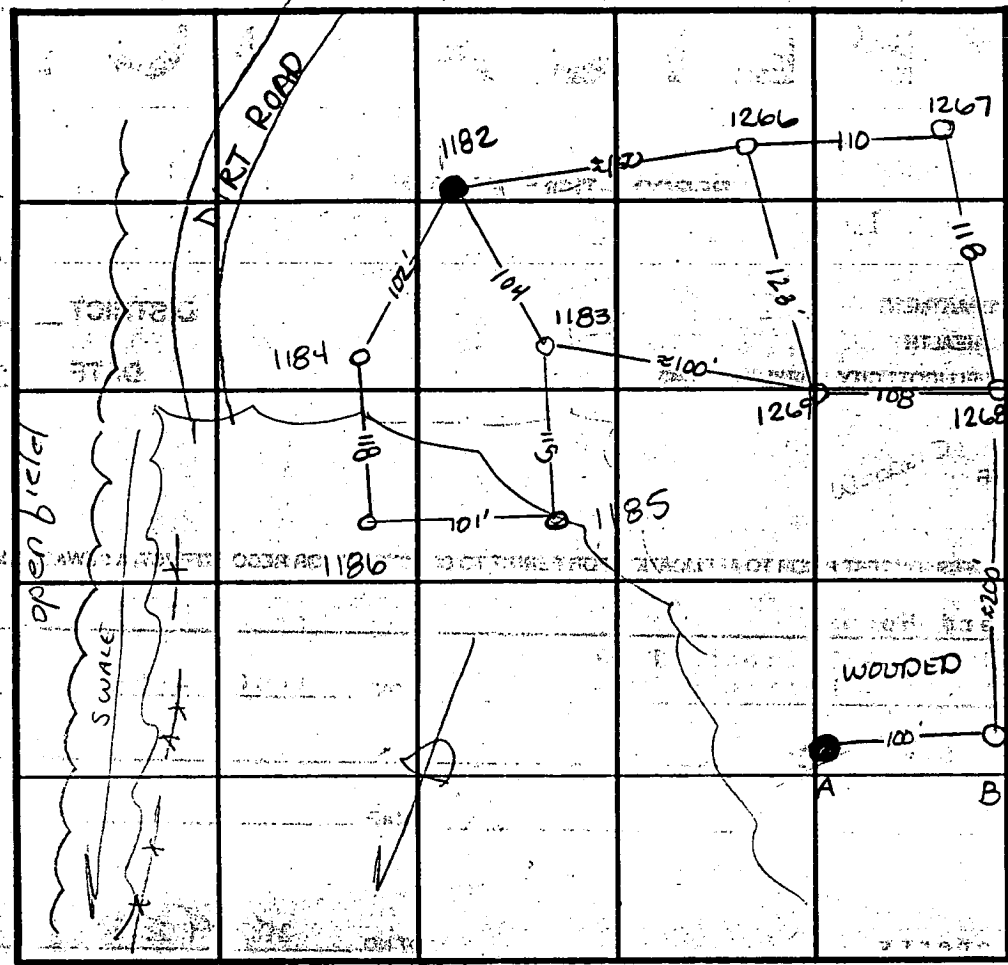

SOIL PROFILE

0' 1185  
red brn  
C  
3' yellow  
brn C  
4' pink  
SL  
red  
yellow  
streaks  
on  
side  
walls  
12' white SL  
at bottom  
B  
3' reddish  
brn  
SIL  
orange  
brn  
sil

INDICATE NORTH - NAME ADJOINING ROADWAY AS BASE LINE.

DATE	TEST NO.	DEPTH	PRE-WET START	PRE-WET STOP	TEST - 1" DROP START	TEST - 1" DROP STOP	TIME
12-15-94	1184	3' V12	6:14	6:32	6:32	7:30min	slow
	1183	4' V10	6:17	6:31	6:31	6:57	26min
	1182	Visual to 7'	>50%	rock			F
	1184	4.5' V12	9:04	9:12	9:12	9:31	17min
	1186	4' V11.5	6:11	6:12	6:12	6:17	4'4min
	1185	4' V12	6:07	6:08	6:08	6:09	14min
DATE 2-24-95	A	>50%	rock				F
DATE	B	Visual to 12'					OK

REMARKS

TYPE OF SOIL

TESTED BY Amy McMullen

ALSO PRESENT

TRENCH DESIGN DATA: AVERAGE PERCOLATION TIME

TRENCH WIDTH

INLET DEPTH

MAXIMUM BOTTOM DEPTH

SQ. FT./BEDROOM

A50388-U

COUNTY #

SOIL PROFILE

SOIL PROFILE


SEE ATTACHED  
FOR  
DIAGRAM

INDICATE NORTH - NAME ADJOINING ROADWAY AS BASE LINE.

DATE	TEST NO.	DEPTH	PRE-WET		TEST - 1" DROP		TIME
			START	STOP	START	STOP	
3-20-96	347	Not dug	—	—	—	—	—
	355	>50% rock	bottom	at 10.0	—	—	F
	356	>50% rock	bottom	at 9.5	—	—	F
	354	>50% rock	bottom	at 10.0	—	—	F

REMARKS \_\_\_\_\_

TYPE OF SOIL \_\_\_\_\_

TESTED BY Amy McMillen ALSO PRESENT \_\_\_\_\_

TRENCH DESIGN DATA: AVERAGE PERCOLATION TIME \_\_\_\_\_ TRENCH WIDTH \_\_\_\_\_

INLET DEPTH \_\_\_\_\_ MAXIMUM BOTTOM DEPTH \_\_\_\_\_ SQ. FT./BEDROOM \_\_\_\_\_

COUNTY

SOIL PROFILE

1268

bed w/  
reddish  
tint  
CSL  
5% rock

yellow s  
black s  
red  
streaked  
SIL

pink  
SSIL

1267

bright  
red  
CSL  
10-20%  
rock frags

orange  
tan SSIL  
10% rock  
frags  
pockets of  
decayed  
white  
stone

1266 1269

same as  
1267  
but  
25%  
rock  
throughout

SOIL PROFILE


INDICATE NORTH - NAME ADJOINING ROADWAY AS BASE LINE.

DATE	TEST NO.	DEPTH	PRE-WET		TEST - 1" DROP		TIME
			START	STOP	START	STOP	
12-22-94	1269	4' VII	8:03 <sup>30</sup>	8:04	8:04	8:05 <sup>30</sup>	1 1/2 min
	1269	repour	8:06	8:09	8:09	8:12	3 min
	1266	4.5' VII.5'	8:14	8:16	8:16	8:18	2 min
	1267	6' VI.2	7:58	7:58 <sup>45</sup>	7:58 <sup>45</sup>	8:00 <sup>30</sup>	1 3/4 min
	1268	5' VI.2	7:54 <sup>15</sup>	7:55 <sup>30</sup>	7:55 <sup>30</sup>	7:57 <sup>30</sup>	2 min

REMARKS

TYPE OF SOIL

TESTED BY

ALSO PRESENT

TRENCH DESIGN DATA: AVERAGE PERCOLATION TIME


TRENCH WIDTH

INLET DEPTH

MAXIMUM BOTTOM DEPTH

SQ. FT./BEDROOM



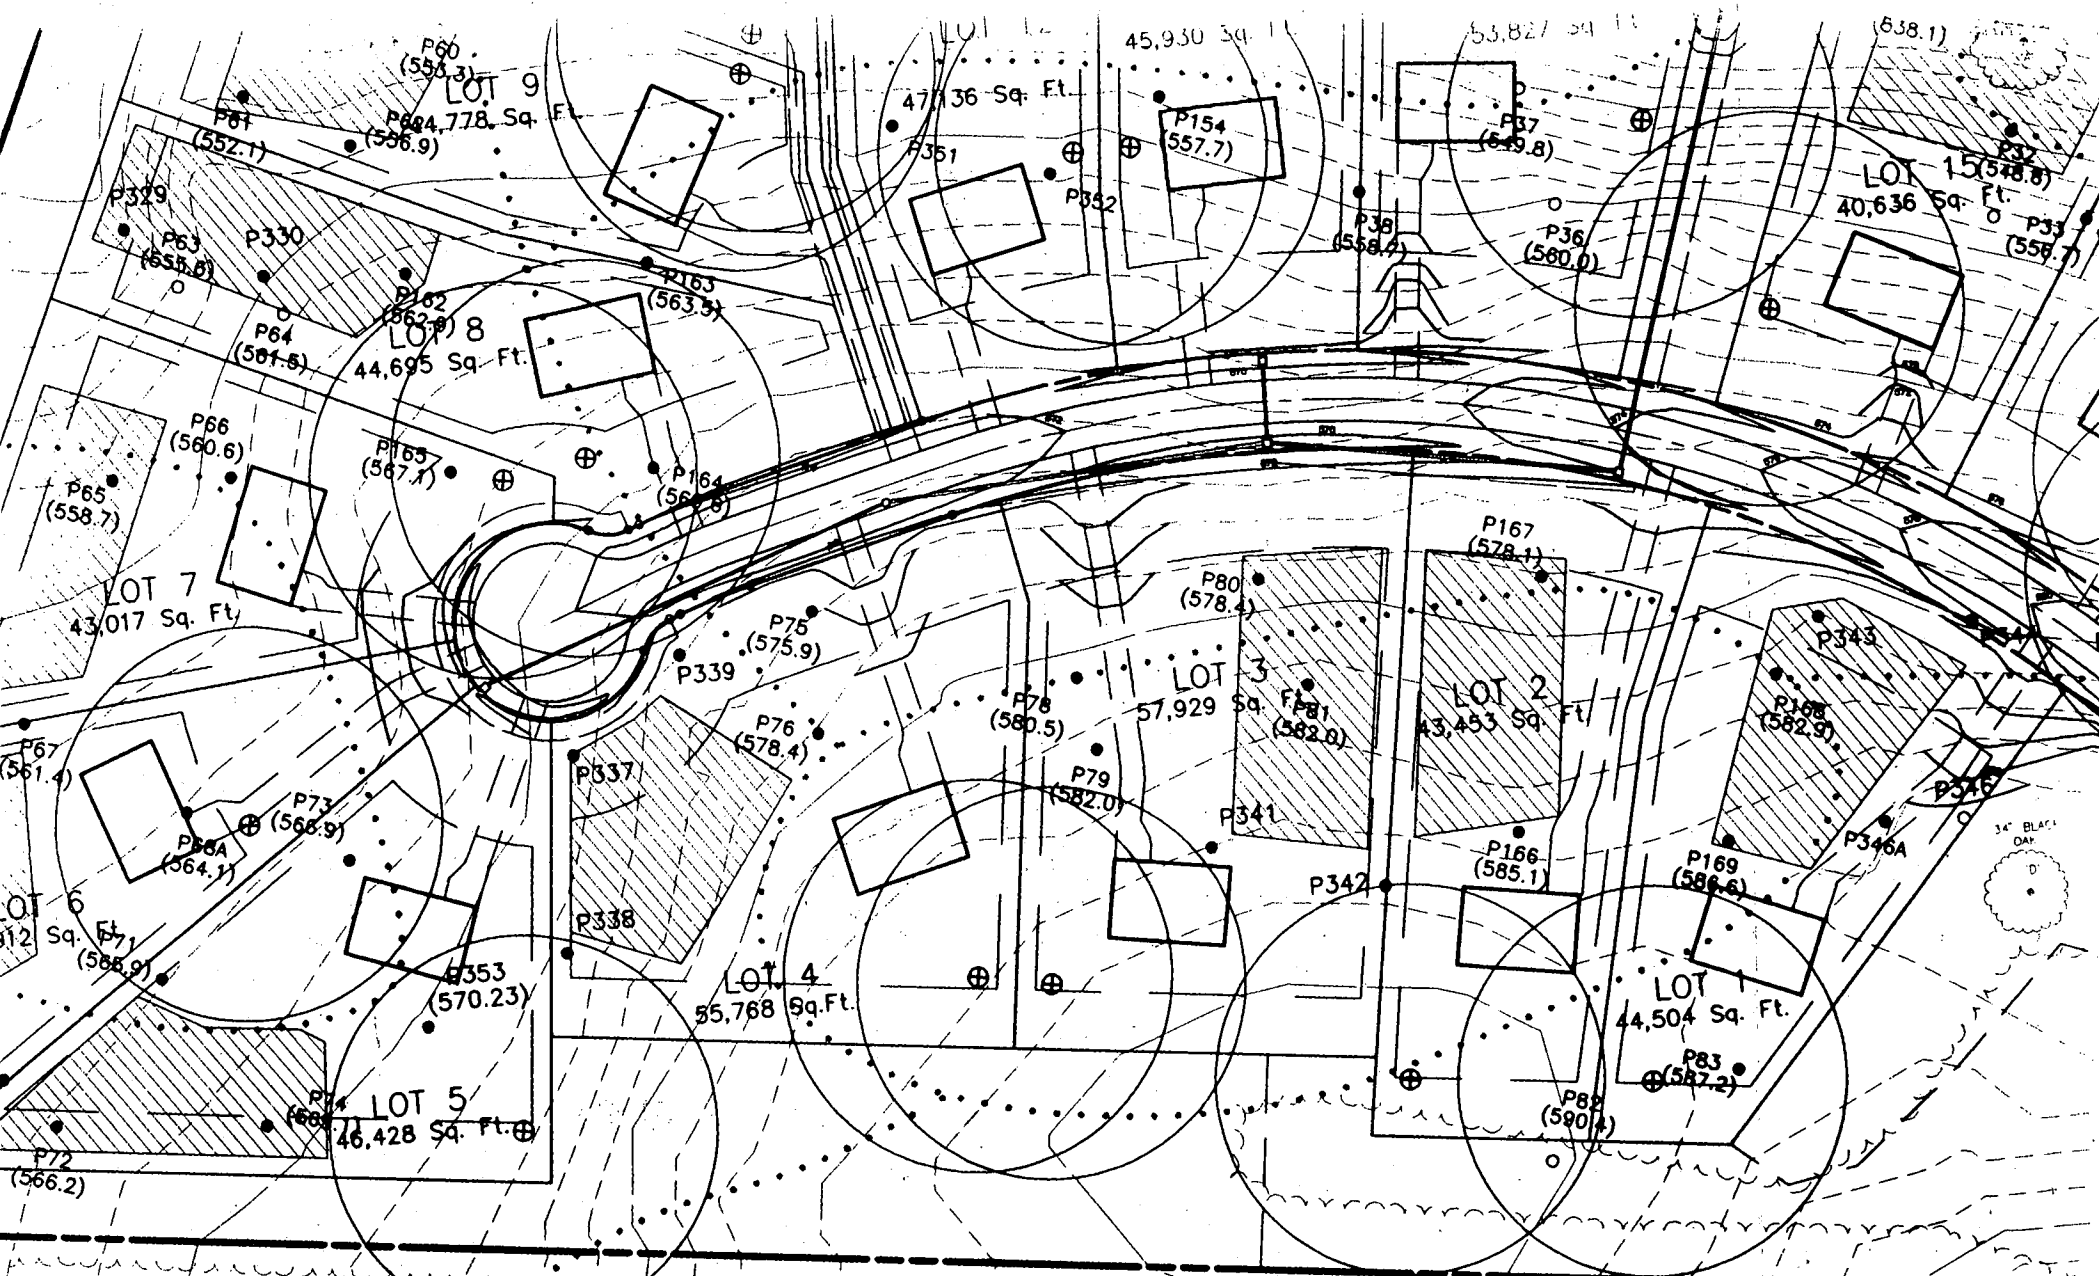

LIMIT.

OF

SUBMISSION

CLEVENGER PROPERTY

LOT 1  
PLAT No. 5860

Approved

Revised

Per-Cert

1-97

N 594.700


7547

Boat # B0013383

Revised

Signature \_\_\_\_\_

**Date**

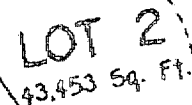


TO ACCOMPANY APPLICATION FOR  
PERMIT

1) THIS PLAT IS PREPARED FOR THE BENEFIT OF THE CLIENT SIGNING THE HOUSE LOCATION SURVEY APPROVAL FORM INsofar AS IT IS REQUIRED BY A LENDER OR TITLE INSURANCE COMPANY OR ITS AGENTS IN CONNECTION WITH THE CONTEMPLATED TRANSFER, FINANCING OR RE-FINANCING. UNLESS INDICATED AS BEING A BOUNDARY SURVEY, THIS PLAT IS NOT INTENDED FOR USE IN THE ESTABLISHMENT OF PROPERTY LINES AND IS NOT TO BE RELIED UPON FOR THE ESTABLISHMENT OR LOCATIONS OF FENCES, GARAGES, BUILDINGS OR OTHER EXISTING OR FUTURE IMPROVEMENTS. AS A RESULT, THIS PLAT DOES NOT PROVIDE FOR ACCURATE IDENTIFICATION OF PROPERTY LINE, BUT SUCH IDENTIFICATION MAY NOT BE REQUIRED FOR THE TRANSFER OF TITLE OR SECURING FINANCING OR RE-FINANCING.

2) SUBJECT PROPERTY IS SHOWN IN ZONE C ON THE NATIONAL FLOOD INSURANCE PROGRAM FLOOD INSURANCE RATE MAP OF HOWARD COUNTY, MARYLAND. COMMUNITY PANEL No 2400040000R B EFFECTIVE DATE: DEC. 4, 1985


3) THE OFFSETS FROM BUILDING LINE TO PROPERTY LINE AS SHOWN ON THE PLAT HEREON ARE TO AN ACCURACY OF 1' PLUS OR MINUS (+).

0 SCALF

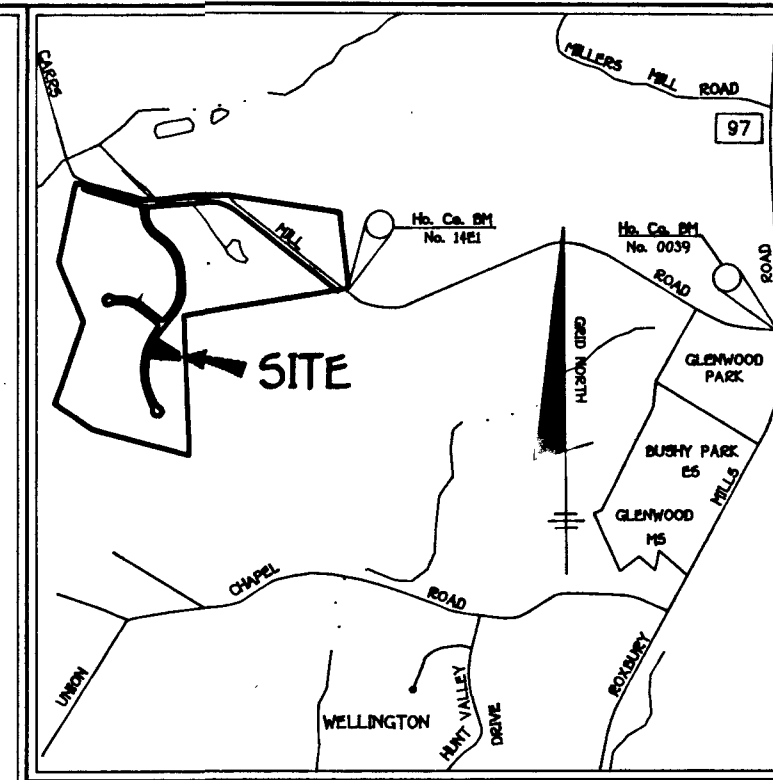

**VICINITY MAP**  
SCALE: 1"=2000'

2. PROPOSED 1500 GALLON SEPTIC TANK.  
3. A. FIRST FLOOR ELEVATION: 521.30  
B. BASEMENT ELEVATION: 522.30  
C. INVERT OF SEPTIC SYSTEM AT HOUSE: 584.40  
D. INVERT IN AT SEPTIC TANK: 583.70 584.10  
E. INVERT OUT AT SEPTIC TANK: 584.60 583.25  
F. PROPOSED GRADE OVER SEPTIC TANK: 586.50  
G. INVERT AT DISTRIBUTION BOX: 587.50 583.60  
H. EXISTING GROUND OVER DISTRIBUTION BOX: 586.70 586.50  
4. LENGTH OF TRENCH TO BE DETERMINED AT TIME OF SEPTIC PERMIT  
ISSUANCE.  
5. CONTRACTOR / BUILDER TO VERIFY ELEVATIONS IN FIELD BEFORE BEGINNING  
ANY CONSTRUCTION.  
6. THERE IS NO BASEMENT SERVICE TO SEPTIC SYSTEM.

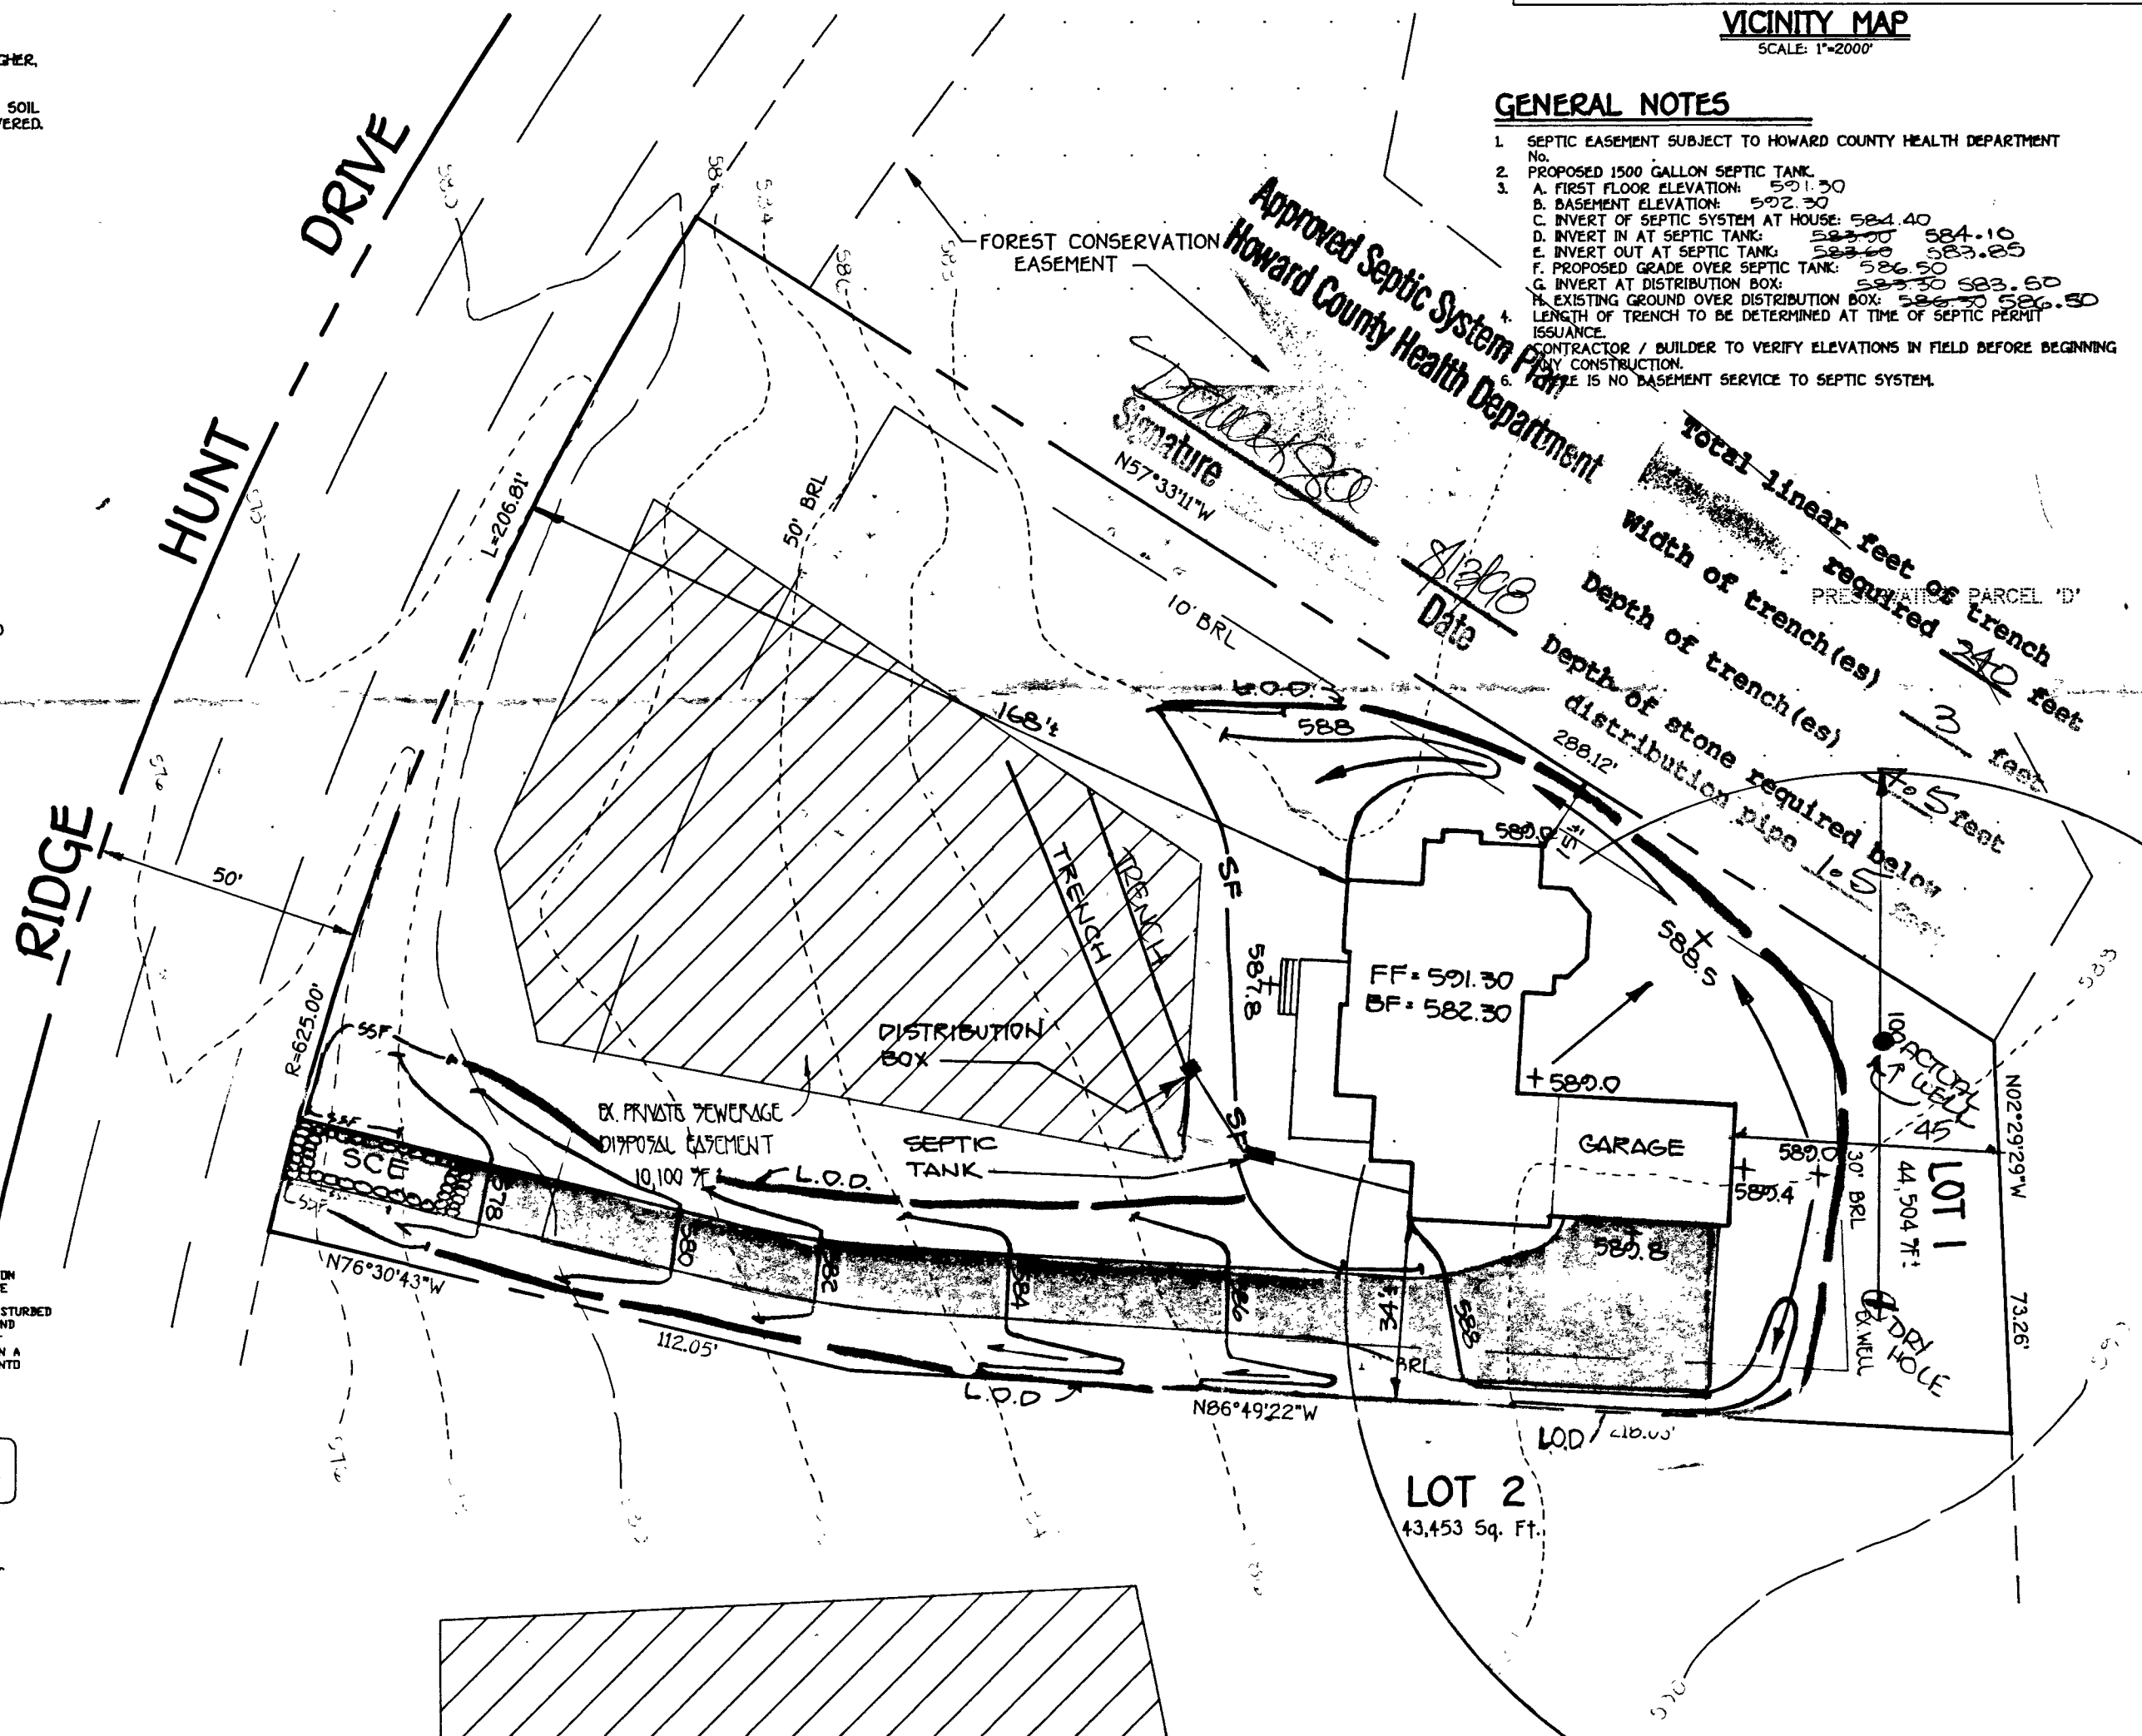

WHERE THE TOPSOIL IS EITHER HIGHLY ACIDIC OR COMPOSED OF HEAVY CLAYS, GROUND LIMESTONE SHALL BE SPREAD AT THE RATE OF 4-6 TONS/ACRE (200-400 POUNDS PER 1,000 SQUARE FEET) PRIOR TO THE PLACEMENT OF TOPSOIL. LIME SHALL BE DISTRIBUTED UNIFORMLY OVER DESIGNATED AREAS AND WORKED INTO THE SOIL IN CONJUNCTION WITH TILLAGE OPERATIONS AS DESCRIBED IN THE FOLLOWING PROCEDURES.



PLAN TO ACCOMPANY APPLICATION FOR  
BUILDING PERMIT  
RIDGE VIEW HUNT  
LOT 1

TAX MAP 14  
FOURTH ELECTION DISTRICT  
SCALE: 1" = 30'

PARCEL: 14  
HOWARD COUNTY, MARYLAND  
DATE: JUNE 30, 1998

GP. 99.16

C 1		4353		WELL COMPLETION REPORT FILL IN THIS FORM COMPLETELY PLEASE TYPE		THIS REPORT MUST BE SUBMITTED AFTER WELL IS COMPLETED.	
COUNTY NUMBER		A 50388 U		PERMIT NO. FROM "PERMIT TO DRILL WELL"		HO - 94 - 11621	
DATE RECEIVED MM DD YY		08 07 98		DEPTH OF WELL (TO NEAREST FOOT)		22 345 26	
OWNER Selbridge Builders		STREET OR RFD Glenview Dr		TOWN Glenwood		LOT 1	
SUBDIVISION Ridge View Hunt		SECTION		LOT			

WELL LOG Not required for driven wells		
STATE THE KIND OF FORMATIONS PENETRATED, THEIR COLOR, DEPTH, THICKNESS AND IF WATER BEARING		
DESCRIPTION (Use additional sheets if needed)	FEET FROM TO	check if water bearing
Top Soil	0 2	
Sandy	2 10	
Sand Stone	10 15	
MICKA	15 45	
Sand Stone	45 50	✓
MICKA	50 100	
Sand Stone	100 105	✓
MICKA	105 345	

GROUTING RECORD	
WELL HAS BEEN GROUTED (Circle Appropriate Box)	
TYPE OF GROUTING MATERIAL (Circle one)	
CEMENT <input checked="" type="checkbox"/> CM	BENTONITE CLAY <input type="checkbox"/> BC
NO. OF BAGS 7	NO. OF POUNDS 45 46 200
GALLONS OF WATER 42	
DEPTH OF GROUT SEAL (to nearest foot)	
from 0	ft. to 19
(enter 0 if from surface)	
CASING RECORD	
casing types insert appropriate code below	
STEEL <input type="checkbox"/> ST	CONCRETE <input type="checkbox"/> CO
PLASTIC <input type="checkbox"/> PL	OTHER <input type="checkbox"/> OT
MAIN CASING TYPE PL	Nominal diameter top (main) casing (nearest inch) 6
	Total depth of main casing (nearest foot) 21
OTHER CASING (if used)	
diameter inch	depth (feet) from to
SCREEN RECORD	
screen type or open hole	
STEEL <input type="checkbox"/> ST	BRASS <input type="checkbox"/> BR
BRONZE <input type="checkbox"/> PL	OPEN HOLE <input checked="" type="checkbox"/> HO
PLASTIC <input type="checkbox"/> PL	OTHER <input type="checkbox"/> OT

PUMPING TEST	
HOURS PUMPED (nearest hour) 6	
PUMPING RATE (gal. per min.) 3	
METHOD USED TO MEASURE PUMPING RATE Bucket	
WATER LEVEL (distance from land surface)	
BEFORE PUMPING 48	ft.
WHEN PUMPING 140	ft.
TYPE OF PUMP USED (for test)	
A air	P piston
C centrifugal	R rotary
J jet	S submersible

NUMBER OF UNSUCCESSFUL WELLS: I
WELL HYDROFRACTURED <input checked="" type="checkbox"/> Y <input type="checkbox"/> N
CIRCLE APPROPRIATE LETTER
A A WELL WAS ABANDONED AND SEALED WHEN THIS WELL WAS COMPLETED
E ELECTRIC LOG OBTAINED
P TEST WELL CONVERTED TO PRODUCTION WELL
I HEREBY CERTIFY THAT THIS WELL HAS BEEN CONSTRUCTED IN ACCORDANCE WITH COMAR 26.04.04 "WELL CONSTRUCTION" AND IN CONFORMANCE WITH ALL CONDITIONS STATED IN THE ABOVE CAPTIONED PERMIT, AND THAT THE INFORMATION PRESENTED HEREIN IS ACCURATE AND COMPLETE TO THE BEST OF MY KNOWLEDGE.
DRILLERS LIC. NO. MS D 116
DRILLERS SIGNATURE (MUST MATCH SIGNATURE ON APPLICATION)
LIC. NO. MS D 116
SITE SUPERVISOR (sign: of driller or journeyman responsible for sitework if different from permittee)

DEPTH (nearest ft.)	
HO 19	345
SLOT SIZE 1 2 3	
DIAMETER OF SCREEN (NEAREST INCH)	
56	60
from	to
GRAVEL PACK IF WELL DRILLED WAS FLOWING WELL INSERT F IN BOX 68	
MDE USE ONLY (NOT TO BE FILLED IN BY DRILLER) (E.R.O.S.) W Q	
70	72
TELESCOPE CASING	LOG INDICATOR
OTHER DATA	

PUMP INSTALLED	
DRILLER INSTALLED PUMP (CIRCLE) (YES or NO)	
IF DRILLER INSTALLS PUMP, THIS SECTION MUST BE COMPLETED FOR ALL WELLS.	
TYPE OF PUMP INSTALLED PLACE (A,C,J,P,R,S,T,O) IN BOX 29	
CAPACITY: GALLONS PER MINUTE (to nearest gallon)	
31	35
PUMP HORSE POWER	
37	41
PUMP COLUMN LENGTH (nearest ft.)	
43	47
CASING HEIGHT (circle appropriate box and enter casing height)	
+ above	LAND SURFACE
- below	2 (nearest foot)
LOCATION OF WELL ON LOT	
SHOW PERMANENT STRUCTURES AND INDICATE NOT LESS THAN TWO DISTANCES (MEASUREMENTS TO WELL)	
Prop Line 400 ft DAY HOLE	
Prop Line 300 ft	
Road	

B 1	<b>4759</b>	SEQUENCE NO. (MDE USE ONLY)	STATE OF MARYLAND PERMIT TO DRILL WELL please print or type	STATE PERMIT NUMBER <b>HO-94-1621</b> <small>fill in this form completely</small>
Date Received (APA) <b>7.6.98</b>		OWNER INFORMATION		
8 MM DD YY 13		15. Last Name Owner First Name 34		
		<b>SELRIDGE Builders Inc</b>		
36		Street or RFD 55		
		<b>14045 GARED DR.</b>		
57		70 State 72 Zip 76		
		<b>GLENWOOD MD. 21738</b>		
DRILLER INFORMATION				
Driller's Name		License No.		
<b>Ralph MAYNE</b>		<b>MSD 117</b>		
Firm Name				
<b>Ralph MAYNE Well Drilling</b>				
Address				
<b>9120 Brown Church Rd Mt Airy</b>				
Signature Date				
<b>Ralph Mayne 6-29-98</b>				
WELL INFORMATION				
B 2		APPROX. PUMPING RATE (GAL. PER MIN.)		
1 2		5		
AVERAGE DAILY QUANTITY NEEDED (GAL. PER DAY)		500		
14		20		
USE FOR WATER (CIRCLE APPROPRIATE BOX)				
<input checked="" type="checkbox"/> DOMESTIC POTABLE SUPPLY & RESIDENTIAL IRRIGATION				
<input type="checkbox"/> FARMING (LIVESTOCK WATERING & AGRICULTURAL IRRIGATION)				
<input type="checkbox"/> INDUSTRIAL, COMMERCIAL, DEWATERING				
<input type="checkbox"/> PUBLIC WATER SUPPLY WELL				
<input type="checkbox"/> TEST, OBSERVATION, MONITORING				
<input type="checkbox"/> GEO-THERMAL				
APPROXIMATE DEPTH OF WELL <u>150</u> FEET				
APPROXIMATE DIAMETER OF WELL <u>6"</u> NEAREST INCH				
METHOD OF DRILLING (circle one)				
BORED (or Augered) JETTED Jetted & DRIVEN				
<input checked="" type="checkbox"/> AIR-ROTARY AIR-PERCussion ROTARY (Hydraulic Rotary)				
CABLE REVERSE-ROTARY DRIVE-POINT				
other				
REPLACEMENT OR DEEPENEED WELLS (CIRCLE APPROPRIATE BOX)				
<input checked="" type="checkbox"/> THIS WELL WILL NOT REPLACE AN EXISTING WELL				
<input type="checkbox"/> THIS WELL WILL REPLACE A WELL THAT WILL BE ABANDONED AND SEALED				
<input type="checkbox"/> THIS WELL WILL REPLACE A WELL THAT WILL BE USED AS A STANDBY-CONTACT LOCAL APPROVING AUTHORITY FOR POLICY ON STANDBY WELLS				
<input type="checkbox"/> THIS WELL WILL DEEPEEN AN EXISTING WELL				
PERMIT NUMBER OF WELL TO BE REPLACED OR DEEPENEED (IF AVAILABLE) 41 _____ 52				
Not to be filled in by driller (MDE OR COUNTY USE ONLY)				
APPROP. PERMIT NUMBER 54 _____ GAP _____ 63				
PERMIT No. <b>HO-94-1621</b>				
70 71 72 73 74 75 76 77 78 79				
SPECIAL CONDITIONS				
NOTE - APPROVING AUTHORITIES SHOULD USE SEPARATE SHEET IF NEEDED.				

B 3 LOCATION OF WELL

8 COUNTY **Howard**

23 SUBDIVISION **RIDGE VIEW Hunt**

SECTION 44 LOT I

52 NEAREST TOWN **GLENWOOD**

MILES FROM TOWN (enter 0 if in town) 2 M I

73 76 77 78

B 4

1 2 DIRECTION OF WELL FROM TOWN (CIRCLE BOX)

ON WHICH SIDE OF ROAD (CIRCLE APPROPRIATE BOX)

34 **300** 37

DISTANCE FROM ROAD ENTER FT OR MI 38 39

TAX MAP: **14** BLK: **8/9** PARCEL: **14**

NOT TO BE FILLED IN BY DRILLER HEALTH DEPARTMENT APPROVAL

**Howard** **A 50388U**

COUNTY NAME COUNTY NO.

STATE SIGNATURE INSERT'S →

DATE ISSUED **7.13.98** Kim Minto **7.13.99**

43. MM DD YY 48 CO SIGNATURE EXP. DATE

NORTH GRID **536** 0 0 0 EAST GRID **788** 0 0 0

50 55 57 63

SHOW MAJOR FEATURES OF BOX & LOCATE WELL WITH AN X

SOURCES OF DRILLING WATER

1. **well**

2.

3.

WRITE THE BOX NUMBER FROM THE MAP HERE

E **29588**

N **54836**


000 000

DRAW A SKETCH BELOW SHOWING LOCATION OF WELL IN RELATION TO NEARBY TOWNS AND ROADS AND GIVE DISTANCE FROM WELL TO NEAREST ROAD JUNCTION



7.9.98  
Well site for Lot 1  
ok as staked  
14m

NON-  
PRESERVA  
FOR PURPOSE  
MANAGEMENT  
DRAINAGE  
94,879 Sq

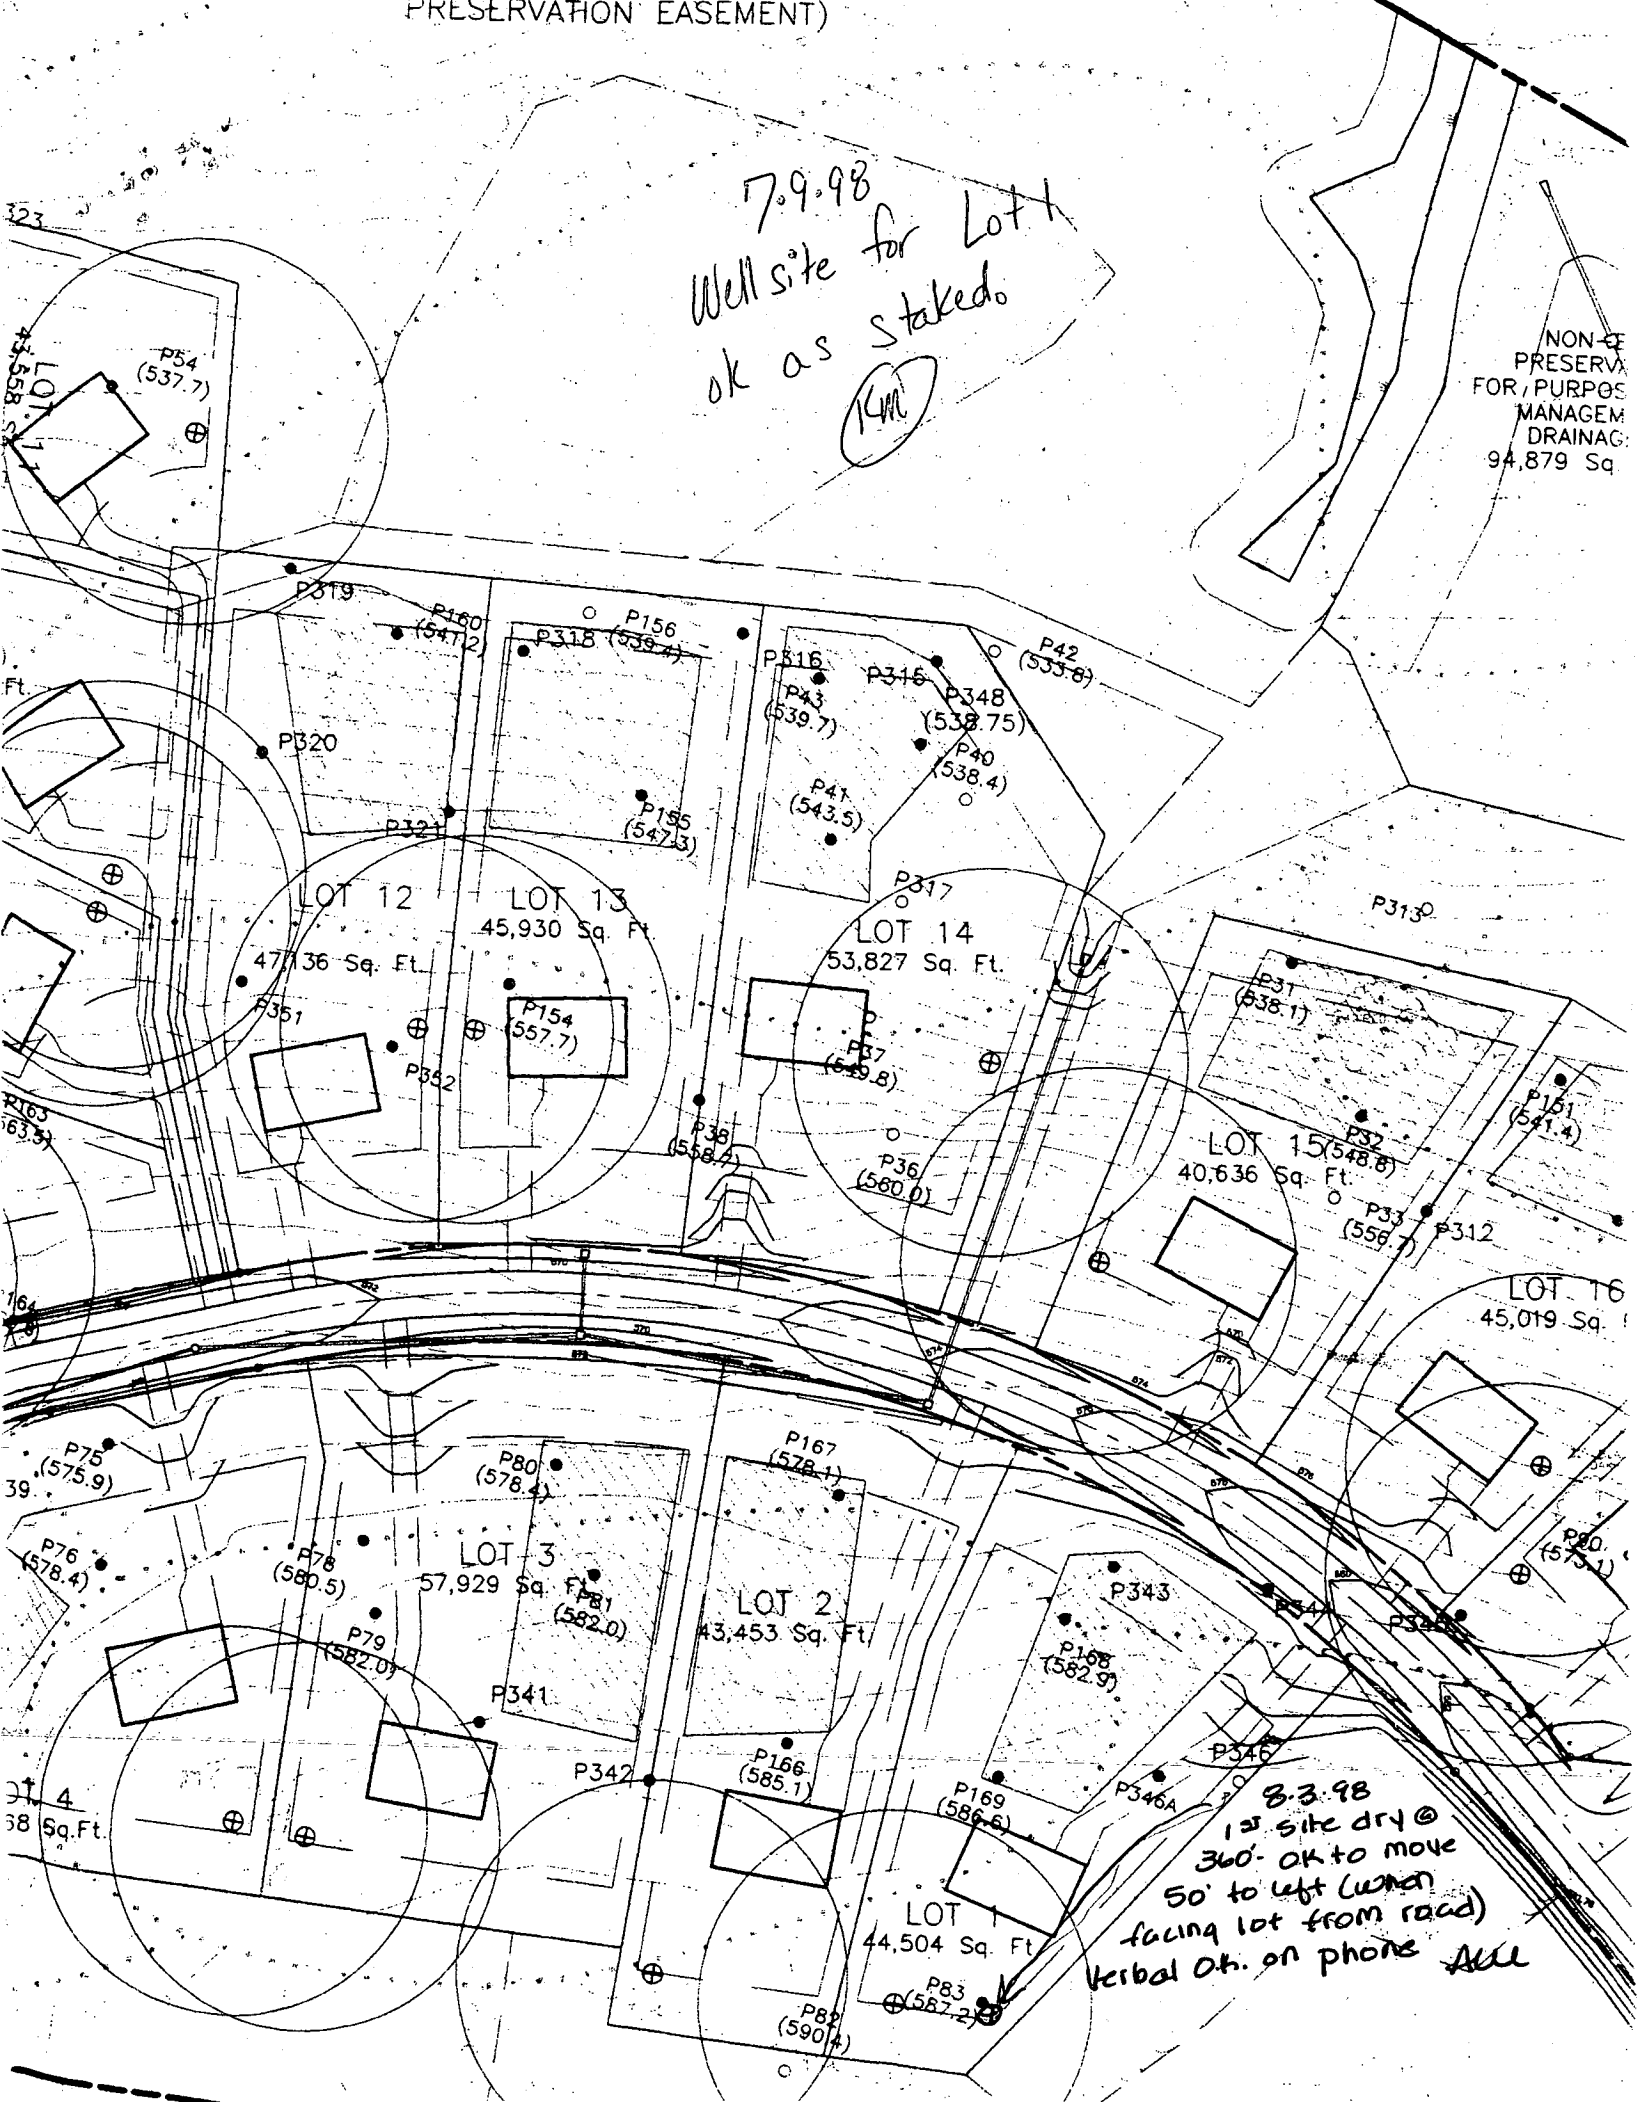

8.3.98  
1st site dry @  
360' OK to move  
50' to left (when  
facing lot from road)  
verbal ok. on phone  
AKL