

PERMIT

SEWAGE DISPOSAL SYSTEM

DEPARTMENT OF HEALTH AND MENTAL HYGIENE

INDEXED

P 512045

A 50388-UU

DISTRICT

DATE 8/2/99

HOWARD COUNTY HEALTH DEPARTMENT

BUREAU OF ENVIRONMENTAL HEALTH

~~XXXXXX~~

410-313-2640

DATE SYSTEM APPROVED 8/16/99

INSPECTOR SRK

360702

K & K Excavating

IS PERMITTED TO INSTALL ☒ ALTER

ADDRESS 14960 Frederick Road (Route 144), Woodbine, MD 21797 PHONE 410-442-1336

SUBDIVISION Ridge View Hunt LOT 2 ROAD 15259 Ridge Hunt Drive

PROPERTY OWNER Selfridge Builders

ADDRESS

SEPTIC TANK CAPACITY 1250 GALLONS

NUMBER OF BEDROOMS 4

180 SQUARE FEET PER BEDROOM

LINEAR FEET OF TRENCH REQUIRED 240

TRENCHES - Trench to be 3 feet wide. Inlet 4 feet below original grade. Bottom maximum depth 5.5 feet below original grade. Effective area begins at 4 feet below original grade. 1.5 feet of stone below distribution pipe.

LOCATION - Place the distribution box 160 feet down the right lot line and 10 feet off this same lot line as seen from Ridge Hunt Drive. Run trenches along contour towards the left side of the lot.

NOTES - No trench to exceed 100 feet in length. Provide 6" - 8" diameter cleanout and cap to grade or above on septic tank. 6/30/99 OK ALL

PLANS APPROVED BY Donna K. Soe DATE 10-17-1999

COVER NO WORK UNTIL INSPECTED AND APPROVED

NEITHER THE HOWARD COUNTY COUNCIL NOR THE HEALTH DEPARTMENT IS RESPONSIBLE FOR THE SUCCESSFUL OPERATION OF ANY SYSTEM

NOTE: CLEANOUT REQUIRED EVERY 70 FEET OF SEWER LINE AND/OR AT 90° SWEEPS IN LINES FROM HOUSE TO DRAIN FIELDS. 90° ELBOWS NOT ACCEPTABLE.

NOTE: ALL PARTS OF SEPTIC SYSTEMS (I.E. TANK, DISTRIBUTION BOX TRENCHES) TO BE 100 FEET FROM WELL (UNLESS OTHERWISE SPECIFICALLY AUTHORIZED)

NOTE: IF DEEP TRENCH(ES) ARE USED CALL FOR INSPECTION BEFORE AND AFTER PLACING GRAVEL IN TRENCH(ES)

NOTE: NO DRY WELL SHALL EXCEED 15 FOOT IN DIAMETER NO ABSORPTION TRENCH TO EXCEED 100 FEET IN LENGTH

NOTE: ALL PIPE FROM HOUSE TO SEPTIC TANK MUST BE CAST IRON OR SCHEDULE 35/40 PVC OR ABS

PERMIT VOID AFTER TWO YEARS


NOTE: INSTALL STAND PIPE ON SEPTIC TANK AND DRY WELL STAND PIPES MUST BE 6 INCHES IN DIAMETER CAST IRON, CONCRETE OR TERRA COTTA OR PVA OR ABS ACCEPTED. IF TOP OF SEPTIC TANK IS DEEPER THAN 3 FEET, MANHOLE TO GRADE REQUIRED.

NOTE: DISTRIBUTION BOXES MUST HAVE BAFFLES

*INSTALLER IS RESPONSIBLE FOR OBTAINING FINAL APPROVAL ON THIS PERMIT

*CALL 461-9933 FOR INSPECTION OF SEPTIC SYSTEM.

50388-UU

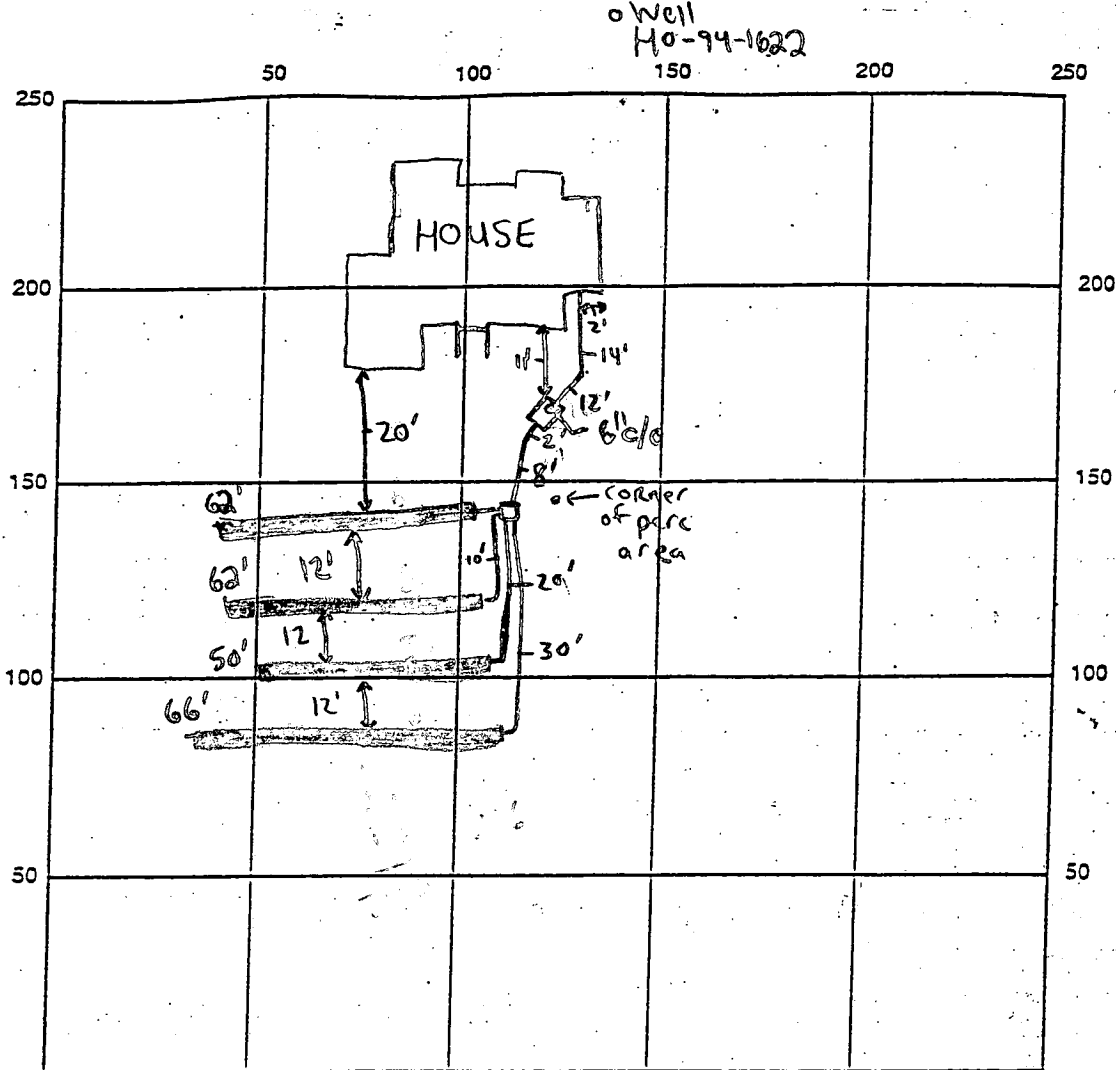

INDICATE NORTH - NAME ADJOINING ROADWAY AS BASE LINE
RIDGE HUNT DRIVE

SEPTIC TANK LEVEL 1250 gallon midseam

CLEANOUTS 6" @ Tank

DISTRIBUTION BOX LEVEL ✓ Baffle is in

DRAIN FIELD/TITLE DEPTH 5.5 FT.

TRENCH WIDTH 3 FT.

INLET DEPTH 4 FT.

EFFECTIVE GRAVEL DEPTH 1.5-2 FT.

TOTAL LENGTH 240 FT.

NUMBER OF TRENCHES 4

~~ONE SIDEWALL~~ BOTTOM AREA 720 SQ. FT.

DRYWALL INSIDE DIAMETER N/A FT.

EFFECTIVE DEPTH BELOW INLET N/A FT.

ABSORBENT AREA N/A SQ. FT.

REMARKS: 8/16/99 - WPI needs conduit pipe, let installer know to call for reinspection

OK TO COVER ALL WORK - SRV 9/15/99 - WPI OK - SRK

DATE SYSTEM APPROVED 8/16/99

INSPECTOR

Steven R. Krieg

APPLICATION

PERCOLATION TESTING

A 50388T

P _____

HOWARD COUNTY HEALTH DEPARTMENT

BUREAU OF ENVIRONMENTAL HEALTH

3525-H ELLICOTT MILLS DRIVE/ELLICOTT CITY, MARYLAND 21043
TELEPHONE: 313-2840

DISTRICT _____

DATE 11/10/99

TO: THE COUNTY HEALTH OFFICER
ELLICOTT CITY, MARYLAND

I HEREBY APPLY FOR THE NECESSARY TEST PRIOR TO APPLICATION FOR PERMIT TO CONSTRUCT (OR RECONSTRUCT) A SEWAGE DISPOSAL SYSTEM.

PROPERTY OWNER Richard Hoenes Selfridge Builders

ADDRESS 8668 Baltimore National Pike
Ellicott City, Maryland 21043 PHONE (410) 465-2321

AGENT OR PROSPECTIVE BUYER Same

ADDRESS _____ PHONE _____

PROPERTY LOCATION:

SUBDIVISION White Property LOT NO. 20 1A 23

ROAD AND DESCRIPTION South side 15000 block of Carrs Mill Road; 1 mile +/- west
of Roxbury Mills Road intersection. (15259 Ridgely Hunt Drive)

TAX MAP 14 PARCEL # 14

SIZE OF LOT 60,000 SF TYPE BLDG. Single Family - 4 Bm
(SINGLE FAMILY DWELLING OR COMMERCIAL)

THE SYSTEM INSTALLED UNDER THIS APPLICATION IS ACCEPTABLE ONLY UNTIL PUBLIC FACILITIES BECOME AVAILABLE. I FULLY UNDERSTAND THE
FEE CONNECTED WITH THE FILING OF THIS PERC TEST APPLICATION IS NON-REFUNDABLE UNDER ANY CIRCUMSTANCES. I ALSO AGREE TO
COMPLY WITH ALL M.O.S.H.A. REQUIREMENTS IN TESTING THIS LOT. Richard Hoenes
(SIGNATURE OF APPLICANT)

APPROVED BY _____ FOR _____ DATE _____

DISAPPROVED BY _____ FOR _____ DATE _____

HOLD PENDING FURTHER TESTS _____

REASONS FOR REJECTION OR HOLDING _____

PERCOLATION TEST PLAT/PRELIMINARY PLAT - TITLE OR I.D. # _____ DATE _____

SITE DEVELOPMENT PLAN/FINAL PLAT - TITLE OR I.D. # _____ DATE _____

THIS IS NOT A PERMIT

AS 0388T
COUNTY #

SOIL PROFILE


0' 1184
dark red brn C
3.5' white yellow, orange mottled appearance
SiL very powdery appears pink in pile
12' white SiSL

1183

4' dark red C
bright red w/ yellow streaks
SiL from parent rock
very hard soil
saprolite at bottom
10'

1186

1' top soil
red brn C
3' yellow tan SiL
4' pink SL
yellow/red mottled appearance probably from parent rock
12'

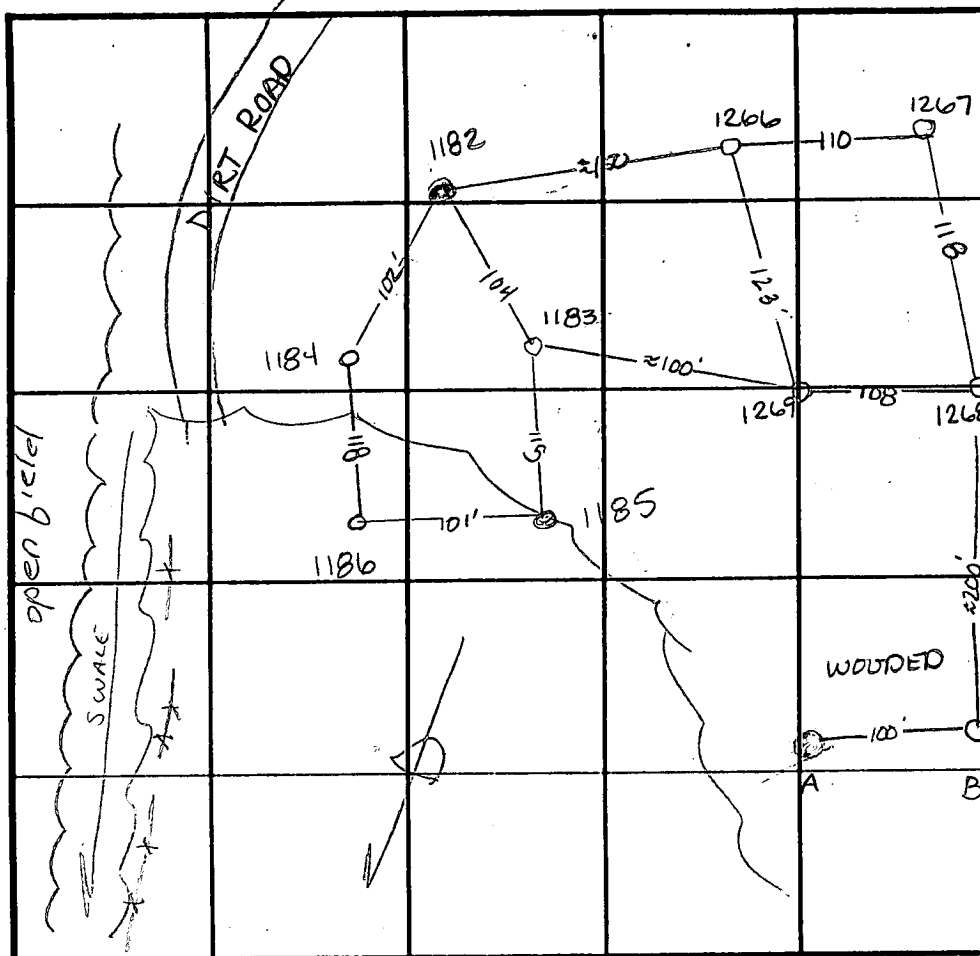

INDICATE NORTH - NAME ADJOINING ROADWAY AS BASE LINE.

SOIL PROFILE

0' 1185
red brn C
3' yellow brn C
4' pink SL
red yellow streaks on side walls
white SL at bottom
12' B
reddish brn SiL
3' orange brn SiL

DATE	TEST NO.	DEPTH	PRE-WET		TEST - 1" DROP		TIME
			START	STOP	START	STOP	
12-15-94	1184	3' / 12'	6:14 ³⁰	6:32	6:32	>30min	slow
	1183	4' / 10'	6:17 ¹⁵	6:31	6:31	6:57	26min
	1182	Visual	to 7'	>50%	rock	—	F
	1184	4.5' / 12'	9:04	9:12	9:12	9:31	17min
	1186	4' / 11.5'	6:11 ¹⁵	6:12 ¹⁵	6:12 ⁴⁵	6:17	4 1/4 min
	1185	4' / 12'	6:07	6:08	6:08	6:09 ⁴⁵	13/4 min
2-24-95	A	>50%	rock	—	—	—	F
	B	Visual	to 12'	—	—	—	OK

REMARKS

TYPE OF SOIL

TESTED BY Amy McMillen

ALSO PRESENT

TRENCH DESIGN DATA: AVERAGE PERCOLATION TIME

TRENCH WIDTH

INLET DEPTH

MAXIMUM BOTTOM DEPTH

SQ. FT./BEDROOM

APPLICATION

PERCOLATION TESTING

A 50388UU

P _____

HOWARD COUNTY HEALTH DEPARTMENT

BUREAU OF ENVIRONMENTAL HEALTH

3525-H ELLICOTT MILLS DRIVE/ELLICOTT CITY, MARYLAND 21043
TELEPHONE: 313-2640

DISTRICT _____

DATE 11/10/94

TO: THE COUNTY HEALTH OFFICER
ELLICOTT CITY, MARYLAND

I HEREBY APPLY FOR THE NECESSARY TEST PRIOR TO APPLICATION FOR PERMIT TO CONSTRUCT (OR RECONSTRUCT) A SEWAGE DISPOSAL SYSTEM.

PROPERTY OWNER Richard Hoenes

ADDRESS 8668 Baltimore National Pike
Ellicott City, Maryland 21043 PHONE (410) 465-2321

AGENT OR PROSPECTIVE BUYER Same

ADDRESS _____ PHONE _____

PROPERTY LOCATION:

SUBDIVISION White Property LOT NO. 212024 1 & 2

ROAD AND DESCRIPTION South side 15000 block of Carrs Mill Road; 1 mile +/- west
of Roxbury Mills Road intersection.

TAX MAP 14 PARCEL # 14

SIZE OF LOT 60,000 SF TYPE BLDG. Single Family
(SINGLE FAMILY DWELLING OR COMMERCIAL)

THE SYSTEM INSTALLED UNDER THIS APPLICATION IS ACCEPTABLE ONLY UNTIL PUBLIC FACILITIES BECOME AVAILABLE. I FULLY UNDERSTAND THE
FEE CONNECTED WITH THE FILING OF THIS PERC TEST APPLICATION IS NON-REFUNDABLE UNDER ANY CIRCUMSTANCES. I ALSO AGREE TO
COMPLY WITH ALL M.O.S.H.A. REQUIREMENTS IN TESTING THIS LOT. Richard Hoenes
(SIGNATURE OF APPLICANT)

APPROVED BY _____ FOR _____ DATE _____

DISAPPROVED BY _____ FOR _____ DATE _____

HOLD PENDING FURTHER TESTS _____

REASONS FOR REJECTION OR HOLDING _____

PERCOLATION TEST PLAT/PRELIMINARY PLAT - TITLE OR I.D. # _____ DATE _____

SITE DEVELOPMENT PLAN/FINAL PLAT - TITLE OR I.D. # _____ DATE _____

THIS IS NOT A PERMIT

A50388U
COUNTY #


21

SOIL PROFILE

0' 1189
orange
red
SIL
3.5' orange
yellow
SIL
45%
very
decayed
saprolite
9' red
SL
very
powdery
10% saprolite
11'

1186
1' top soil
red brn
C
3' yellow
tan
CSIL
4' pink
SL
yellow
red mottled
appearance
probably
glom
parent
rock
12'

1185
3' red
brn
C
4' yellow
brn C
pink
SL
red &
yellow
streaks
on side
walls
12' white SL
at bottom

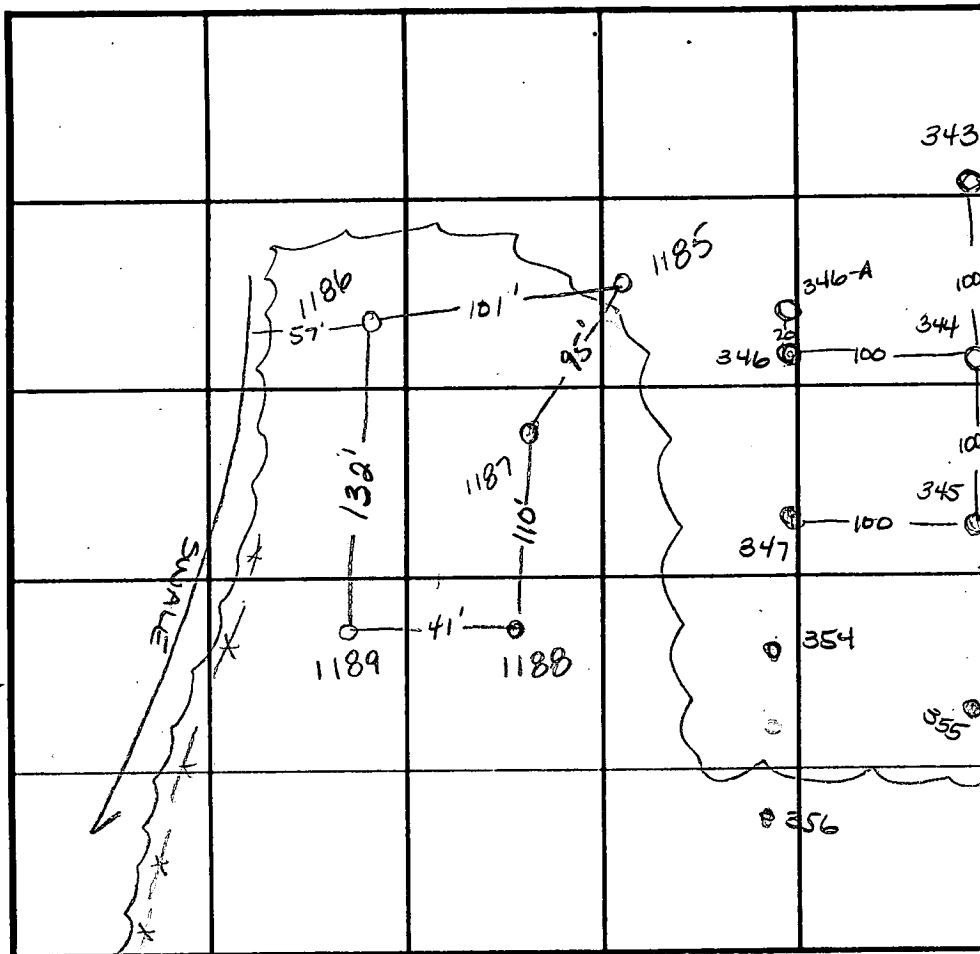

INDICATE NORTH - NAME ADJOINING ROADWAY AS BASE LINE.

SOIL PROFILE

0' 343 344
yellow
brown
SIL
2.0' dark
pink
red
Salm
25%
shale
frag
13.0'

DATE	TEST NO.	DEPTH	PRE-WET		TEST - 1" DROP		TIME
			START	STOP	START	STOP	
12-15-94	1189	4' VII'	5:35 ¹⁵	5:37 ³⁰	5:37 ³⁰	5:42	4 1/2 min
	1188	Hard bottom at 4'					F
	1187	Hard bottom at 6'					F
	1186	4' VII.5	6:11 ¹⁵	6:12 ⁴⁵	6:12 ⁴⁵	6:17 ³⁰	4 1/4 min
	1185	4' XII'	6:07	6:08	6:08	6:09 ⁴⁵	1 3/4 min
3-20-96	343	Visual	to 13.0 - see profile -				OK
	344	Visual	to 13.0 - see profile -				OK
	346	>50% rock	- refusal @ 10.0' -				F
	345	>50% rock	- refusal @ 10.5 -				F
	346	>50% rock	bottom at 11' -				F

REMARKS _____
TYPE OF SOIL _____
TESTED BY _____ ALSO PRESENT _____
TRENCH DESIGN DATA: AVERAGE PERCOLATION TIME _____ TRENCH WIDTH _____
INLET DEPTH _____ MAXIMUM BOTTOM DEPTH _____ SQ. FT./BEDROOM _____

COUNTY #

SOIL PROFILE

1268
brn w/
reddish
tint
CSL
5% rock
yellow s
black s
red
streaked
SIL
pink
SSIL

SOIL PROFILE

1267

bright
red
CSL
10-20%
rock frags
orange
tan SSIL
100% rock
frags
pockets of
decayed
white
stone

1266 1269

same as
1267
but
25%
rock
throughout

INDICATE NORTH - NAME ADJOINING ROADWAY AS BASE LINE.

DATE	TEST NO.	DEPTH	PRE-WET		TEST - 1" DROP		TIME
			START	STOP	START	STOP	
12-22-94	1269	4' VII	8:03 ³⁰	8:04	8:04	8:05 ³⁰	1 1/2 min
	1269	repour	8:06	8:09	8:09	8:12	3 min
	1266	4.5' VII.5'	8:14	8:16	8:16	8:18	2 min
	1267	6' XII	7:58	7:58 ⁴⁵	7:58 ⁴⁵	8:00 ³⁰	1 3/4 min
	1268	5' XII	7:54 ¹⁵	7:55 ³⁰	7:55 ³⁰	7:57 ³⁰	2 min

REMARKS

TYPE OF SOIL

TESTED BY

ALSO PRESENT

TRENCH DESIGN DATA: AVERAGE PERCOLATION TIME

TRENCH WIDTH

INLET DEPTH

MAXIMUM BOTTOM DEPTH

SQ. FT/BEDROOM

A50388-U

COUNTY #

SOIL PROFILE

0'

		SEE ATTACHED FOR		
		DIAGRAM		

SOIL PROFILE

0'

INDICATE NORTH - NAME ADJOINING ROADWAY AS BASE LINE.

DATE	TEST NO.	DEPTH	PRE-WET		TEST - 1" DROP		TIME
			START	STOP	START	STOP	
3-20-96	347	Not dug	—	—	—	—	—
	355	>50% rock	bottom	at 10.0	—	—	F
	356	>50% rock	bottom	at 9.5	—	—	F
	354	>50% rock	bottom	at 10.0	—	—	F

REMARKS _____

TYPE OF SOIL _____

TESTED BY Amy McMullen ALSO PRESENT _____


TRENCH DESIGN DATA: AVERAGE PERCOLATION TIME _____ TRENCH WIDTH _____



INLET DEPTH _____ MAXIMUM BOTTOM DEPTH _____ SQ. FT./BEDROOM _____


C 1		4354		SEQUENCE NO. (MDE USE ONLY)		STATE OF MARYLAND WELL COMPLETION REPORT FILL IN THIS FORM COMPLETELY PLEASE TYPE		THIS REPORT MUST BE SUBMITTED AFTER WELL IS COMPLETED. 9-15-98 OK	
1 2 3 6								COUNTY NUMBER A50388uu	
ST/CO USE ONLY DATE Received MM 9 DD 11 98 8 13		DATE WELL COMPLETED MM 09 DD 08 YY 98 15 20		Depth of Well 22 300 26 (TO NEAREST FOOT)		PERMIT NO. FROM "PERMIT TO DRILL WELL" HO-94-1622 28 29 30 31 32 33 34 35 36 37			
OWNER Selfridge Builders last name first name		STREET OR RFD Ridge View Hunt		TOWN Glenwood		SECTION		LOT 2	
WELL LOG Not required for driven wells		STATE THE KIND OF FORMATIONS PENETRATED, THEIR COLOR, DEPTH, THICKNESS AND IF WATER BEARING		GROUTING RECORD WELL HAS BEEN GROUTED (Circle Appropriate Box) TYPE OF GROUTING MATERIAL (Circle one) CEMENT (CM) BENTONITE CLAY (BC) NO. OF BAGS 6 NO. OF POUNDS 600 GALLONS OF WATER 36 DEPTH OF GROUT SEAL (to nearest foot) from 0 ft. to 19 ft. (enter 0 if from surface)		C 3		PUMPING TEST HOURS PUMPED (nearest hour) 3 PUMPING RATE (gal. per min.) 4 METHOD USED TO MEASURE PUMPING RATE Buck WATER LEVEL (distance from land surface) BEFORE PUMPING 51 ft. WHEN PUMPING 124 ft. TYPE OF PUMP USED (for test) A air P piston T turbine C centrifugal R rotary O other (describe below) J jet S submersible	
DESCRIPTION (Use additional sheets if needed)		FEET FROM TO		check if water bearing		C 2		PUMP INSTALLED DRILLER INSTALLED PUMP (CIRCLE) (YES or NO) YES NO IF DRILLER INSTALLS PUMP, THIS SECTION MUST BE COMPLETED FOR ALL WELLS. TYPE OF PUMP INSTALLED PLACE (A,C,J,P,R,S,T,O) IN BOX 29 CAPACITY: GALLONS PER MINUTE (to nearest gallon) 31 35 PUMP HORSE POWER 37 41 PUMP COLUMN LENGTH (nearest ft.) 43 47 CASING HEIGHT (circle appropriate box and enter casing height) + above LAND SURFACE 2 (nearest foot) - below 50 51	
Top Soil 0 2						DEPTH (nearest ft.) 1 2 3 100			
Sandy 2 10									
Micka 10 50									
Sand Stone 50 54									
Micka 54 210									
Sand Stone 210 215									
Micka 215 300									
NUMBER OF UNSUCCESSFUL WELLS: 0									
WELL HYDROFRACTURED YES NO Y N									
CIRCLE APPROPRIATE LETTER A A WELL WAS ABANDONED AND SEALED WHEN THIS WELL WAS COMPLETED E ELECTRIC LOG OBTAINED P TEST WELL CONVERTED TO PRODUCTION WELL									
I HEREBY CERTIFY THAT THIS WELL HAS BEEN CONSTRUCTED IN ACCORDANCE WITH COMAR 26.04.04 "WELL CONSTRUCTION" AND IN CONFORMANCE WITH ALL CONDITIONS STATED IN THE ABOVE CAPTIONED PERMIT, AND THAT THE INFORMATION PRESENTED HEREIN IS ACCURATE AND COMPLETE TO THE BEST OF MY KNOWLEDGE.									
DRILLERS LIC. NO. MSD116 DRILLERS SIGNATURE (MUST MATCH SIGNATURE ON APPLICATION)									
LIC. NO. MSD117 SITE SUPERVISOR (sign of driller or journeyman responsible for sitework if different from permittee)									
GRVEL PACK IF WELL DRILLED WAS FLOWING WELL INSERT F IN BOX 68									
MDE USE ONLY (NOT TO BE FILLED IN BY DRILLER) T (E.R.O.S.) W Q									
TELESCOPE CASING LOG INDICATOR OTHER DATA									
LOCATION OF WELL ON LOT SHOW PERMANENT STRUCTURES AND INDICATE NOT LESS THAN TWO DISTANCES (MEASUREMENTS TO WELL)									

7.9.98
Lot 2
well site ok
as staked KM

NON-
PRESERV
FOR /PURPOS
MANAGEM
DRAINAG
94,879 Sq.

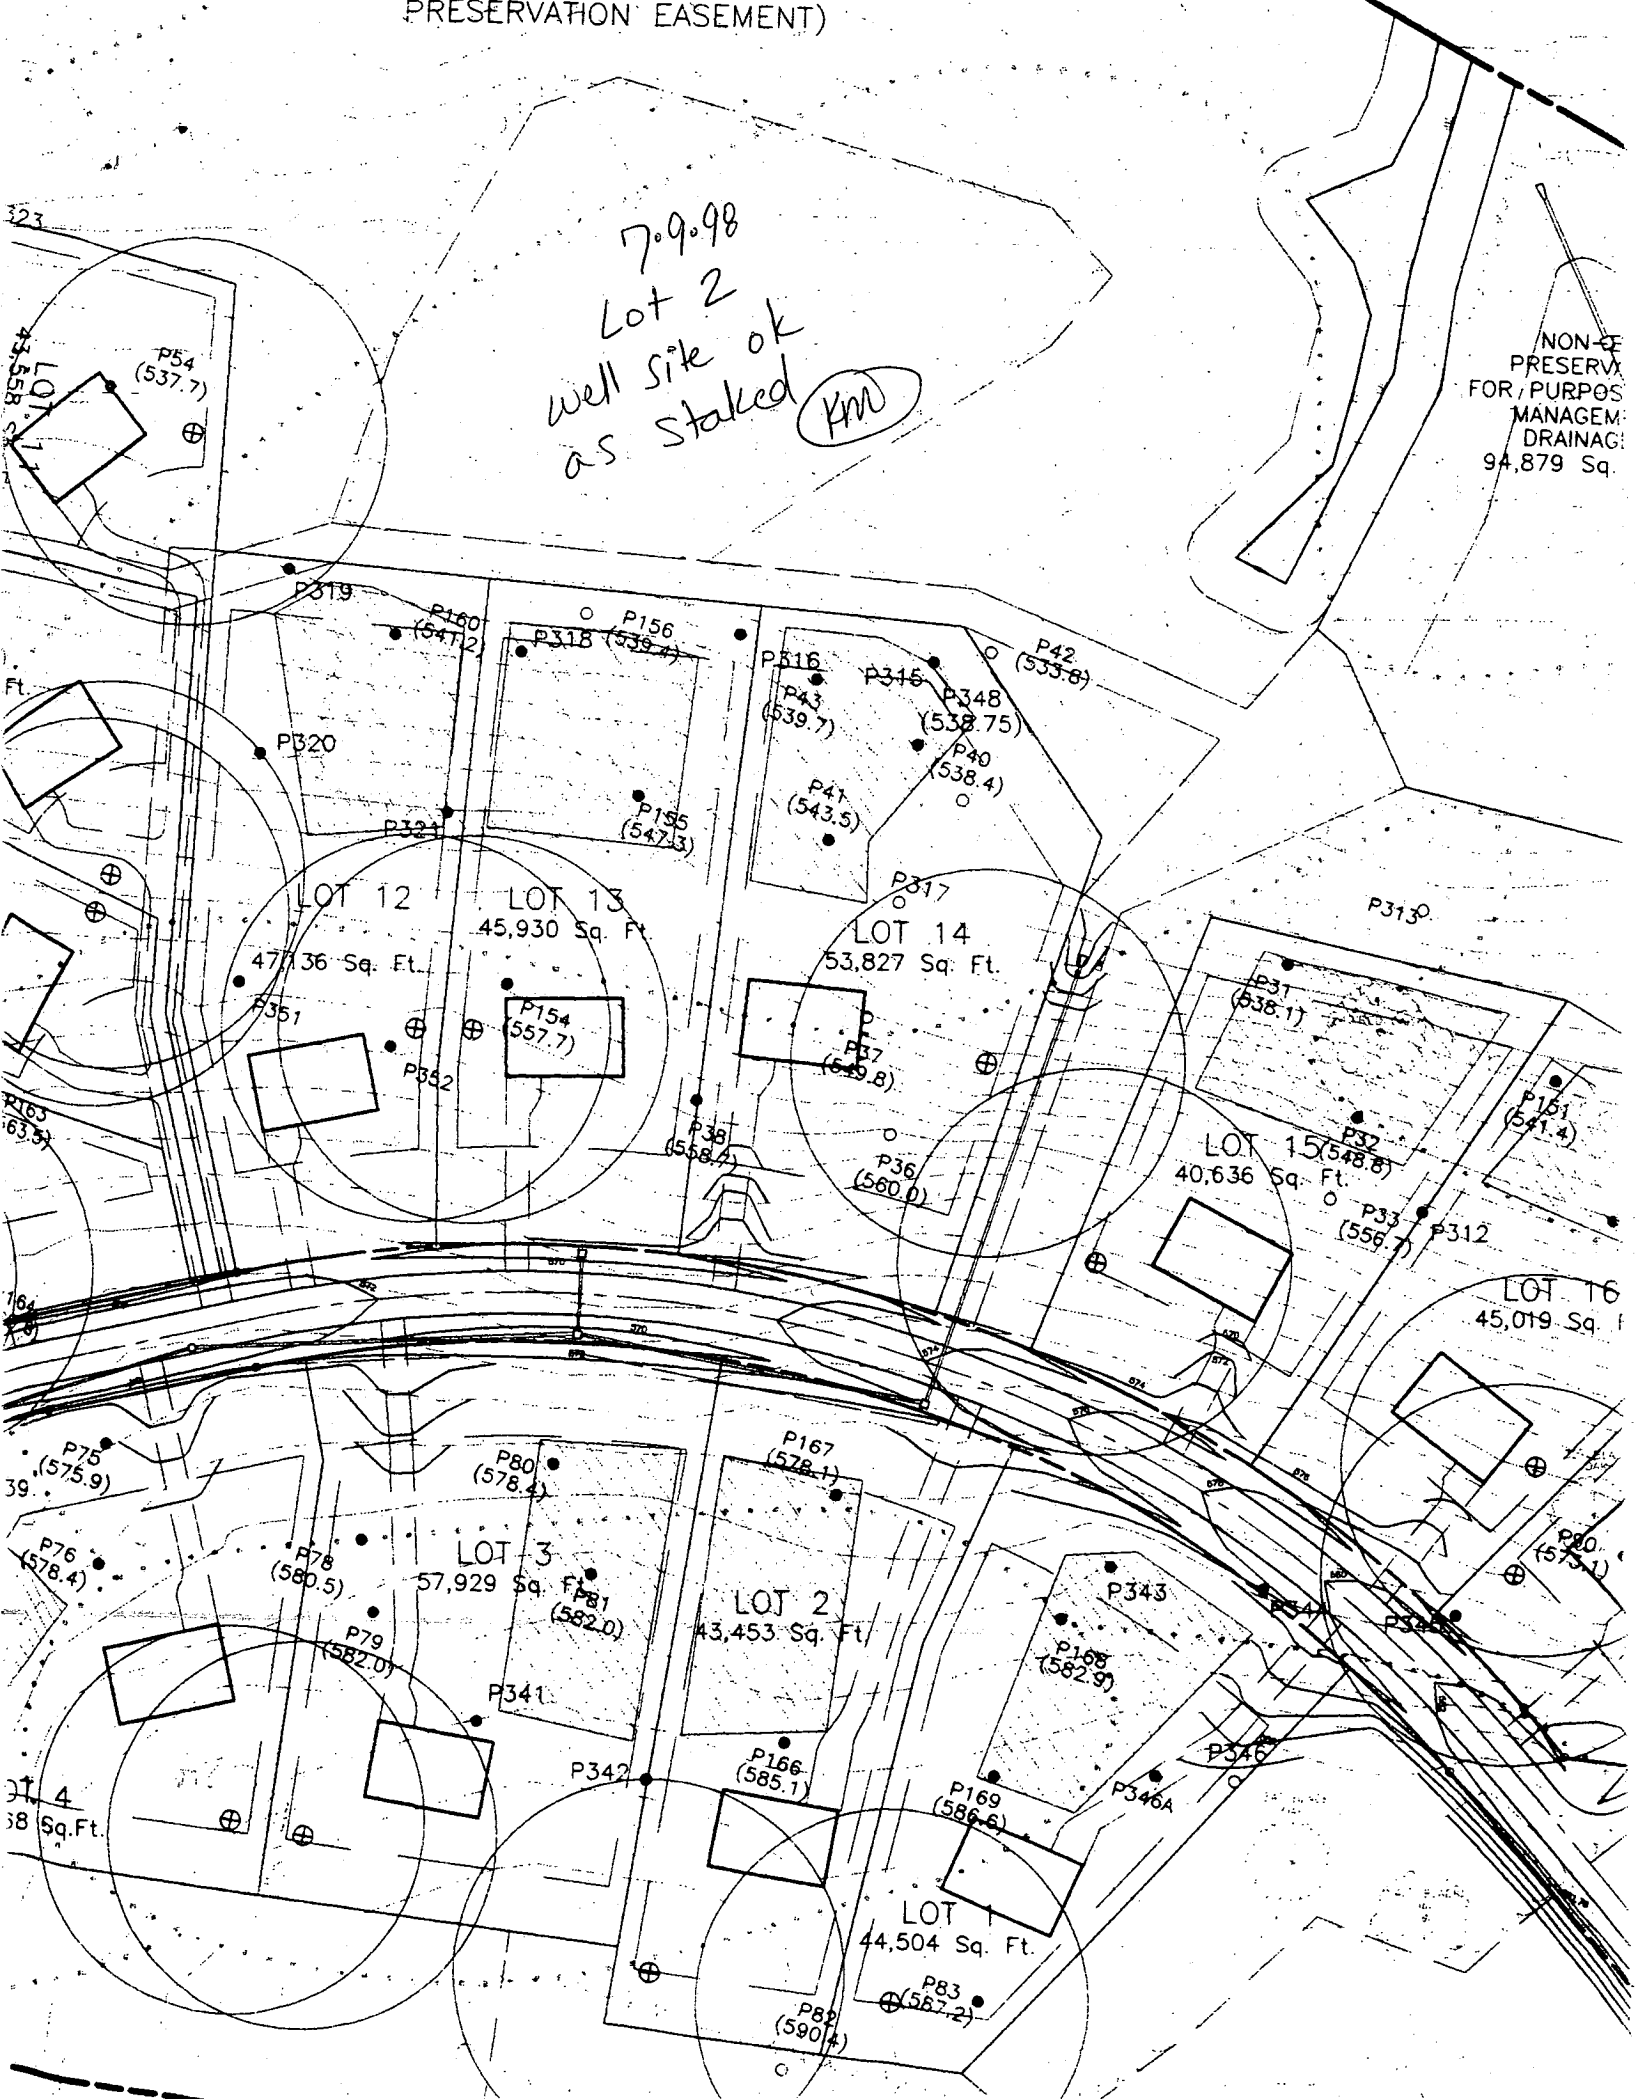

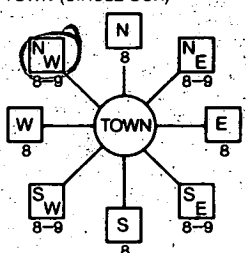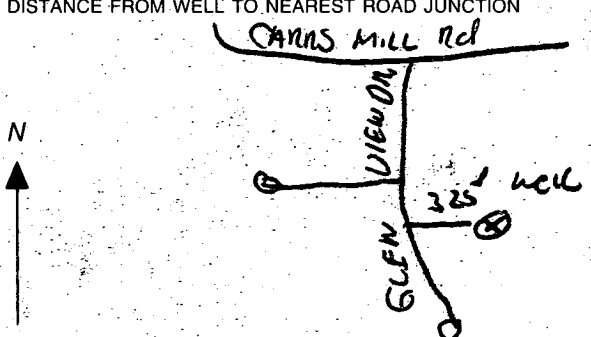B 1 1 2 3 4 5 6 4760	SEQUENCE NO. (MDE USE ONLY) 7 8 9 79	STATE OF MARYLAND PERMIT TO DRILL WELL please print or type	--STATE PERMIT NUMBER H0 - 94 - 1622 70 fill in this form completely 79
Date Received (APA) 7-6-98 8 MM DD YY 13 SELRIDGE Builders 15 Last Name Owner First Name 34 14045 GATED DR. 36 Street or RFD 55 GLENWOOD MD 21738 57 Town 70 State 72 Zip 76		B 3 LOCATION OF WELL 8 COUNTY Howard 21 RIDGE VIEW Hunt 23 SUBDIVISION 42 SECTION 44 46 LOT 2 48 50 GLENWOOD 52 NEAREST TOWN 71 MILES FROM TOWN (enter 0 if in town) 2 M I 73 76 77 78	
DRILLER INFORMATION Ralph MAYNE M S D 116 Driller's Name 76 License No. 81 Ralph MAYNE well DRIVING Firm Name 9120 Brown Church Rd Mt Airy Address Ralph Mayne 6-29-98 Signature Date		B 4 1 2 DIRECTION OF WELL FROM TOWN (CIRCLE BOX)  11 NEAR WHAT ROAD 30 GLEN VIEW DR. ON WHICH SIDE OF ROAD (CIRCLE APPROPRIATE BOX) NORTH WEST SOUTH EAST 34 325 37 DISTANCE FROM ROAD ENTER FT OR MI 38 39 TAX MAP: 14 BLK: 8/9 PARCEL 14	
B 2 WELL INFORMATION 1 2 APPROX. PUMPING RATE (GAL. PER MIN.) 5 8 12 AVERAGE DAILY QUANTITY NEEDED (GAL. PER DAY) 500 14 20		USE FOR WATER (CIRCLE APPROPRIATE BOX) ☒ DOMESTIC POTABLE SUPPLY & RESIDENTIAL IRRIGATION ☐ FARMING (LIVESTOCK WATERING & AGRICULTURAL IRRIGATION) ☐ INDUSTRIAL, COMMERCIAL, DEWATERING ☐ PUBLIC WATER SUPPLY WELL ☐ TEST, OBSERVATION, MONITORING ☐ GEO-THERMAL	
APPROXIMATE DEPTH OF WELL 150 FEET 24 28 APPROXIMATE DIAMETER OF WELL 6" NEAREST INCH		NOT TO BE FILLED IN BY DRILLER HEALTH DEPARTMENT APPROVAL Howard A50388UU COUNTY NAME COUNTY NO. STATE SIGNATURE INSERT S → DATE ISSUED 7-13-98 Jim Minto 7-13-99 43 MM DD YY 48 CO SIGNATURE EXP. DATE NORTH GRID 536 000 EAST GRID 788 000 50 55 57 63	
METHOD OF DRILLING (circle one) BORED (or Augered) JETTED Jetted & DRIVEN 30 AIR-ROTARY AIR-PERCussion ROTARY (Hydraulic Rotary) 37 CABLE REVERSE-ROTARY Drive-POINT other		SHOW MAJOR FEATURES OF BOX & LOCATE WELL WITH AN X SOURCES OF DRILLING WATER 1. well 2. 3. WRITE THE BOX NUMBER FROM THE MAP HERE E 79088 N 536 000 000	
REPLACEMENT OR DEEPEMED WELLS (CIRCLE APPROPRIATE BOX) ☒ THIS WELL WILL NOT REPLACE AN EXISTING WELL ☐ THIS WELL WILL REPLACE A WELL THAT WILL BE ABANDONED AND SEALED 39 ☐ THIS WELL WILL REPLACE A WELL THAT WILL BE USED AS A STANDBY-CONTACT LOCAL APPROVING AUTHORITY FOR POLICY ON STANDBY WELLS ☐ THIS WELL WILL DEEPEM AN EXISTING WELL PERMIT NUMBER OF WELL TO BE REPLACED OR DEEPEMED (IF AVAILABLE) 41 _____ 52		DRAW A SKETCH BELOW SHOWING LOCATION OF WELL IN RELATION TO NEARBY TOWNS AND ROADS AND GIVE DISTANCE FROM WELL TO NEAREST ROAD JUNCTION 	
Not to be filled in by driller (MDE OR COUNTY USE ONLY) APPROP. PERMIT NUMBER 54 _____ 63 PERMIT No. H0 - 94 - 1622 70 71 72 73 74 75 76 77 78 79			
SPECIAL CONDITIONS NOTE - APPROVING AUTHORITIES SHOULD USE SEPARATE SHEET IF NEEDED			

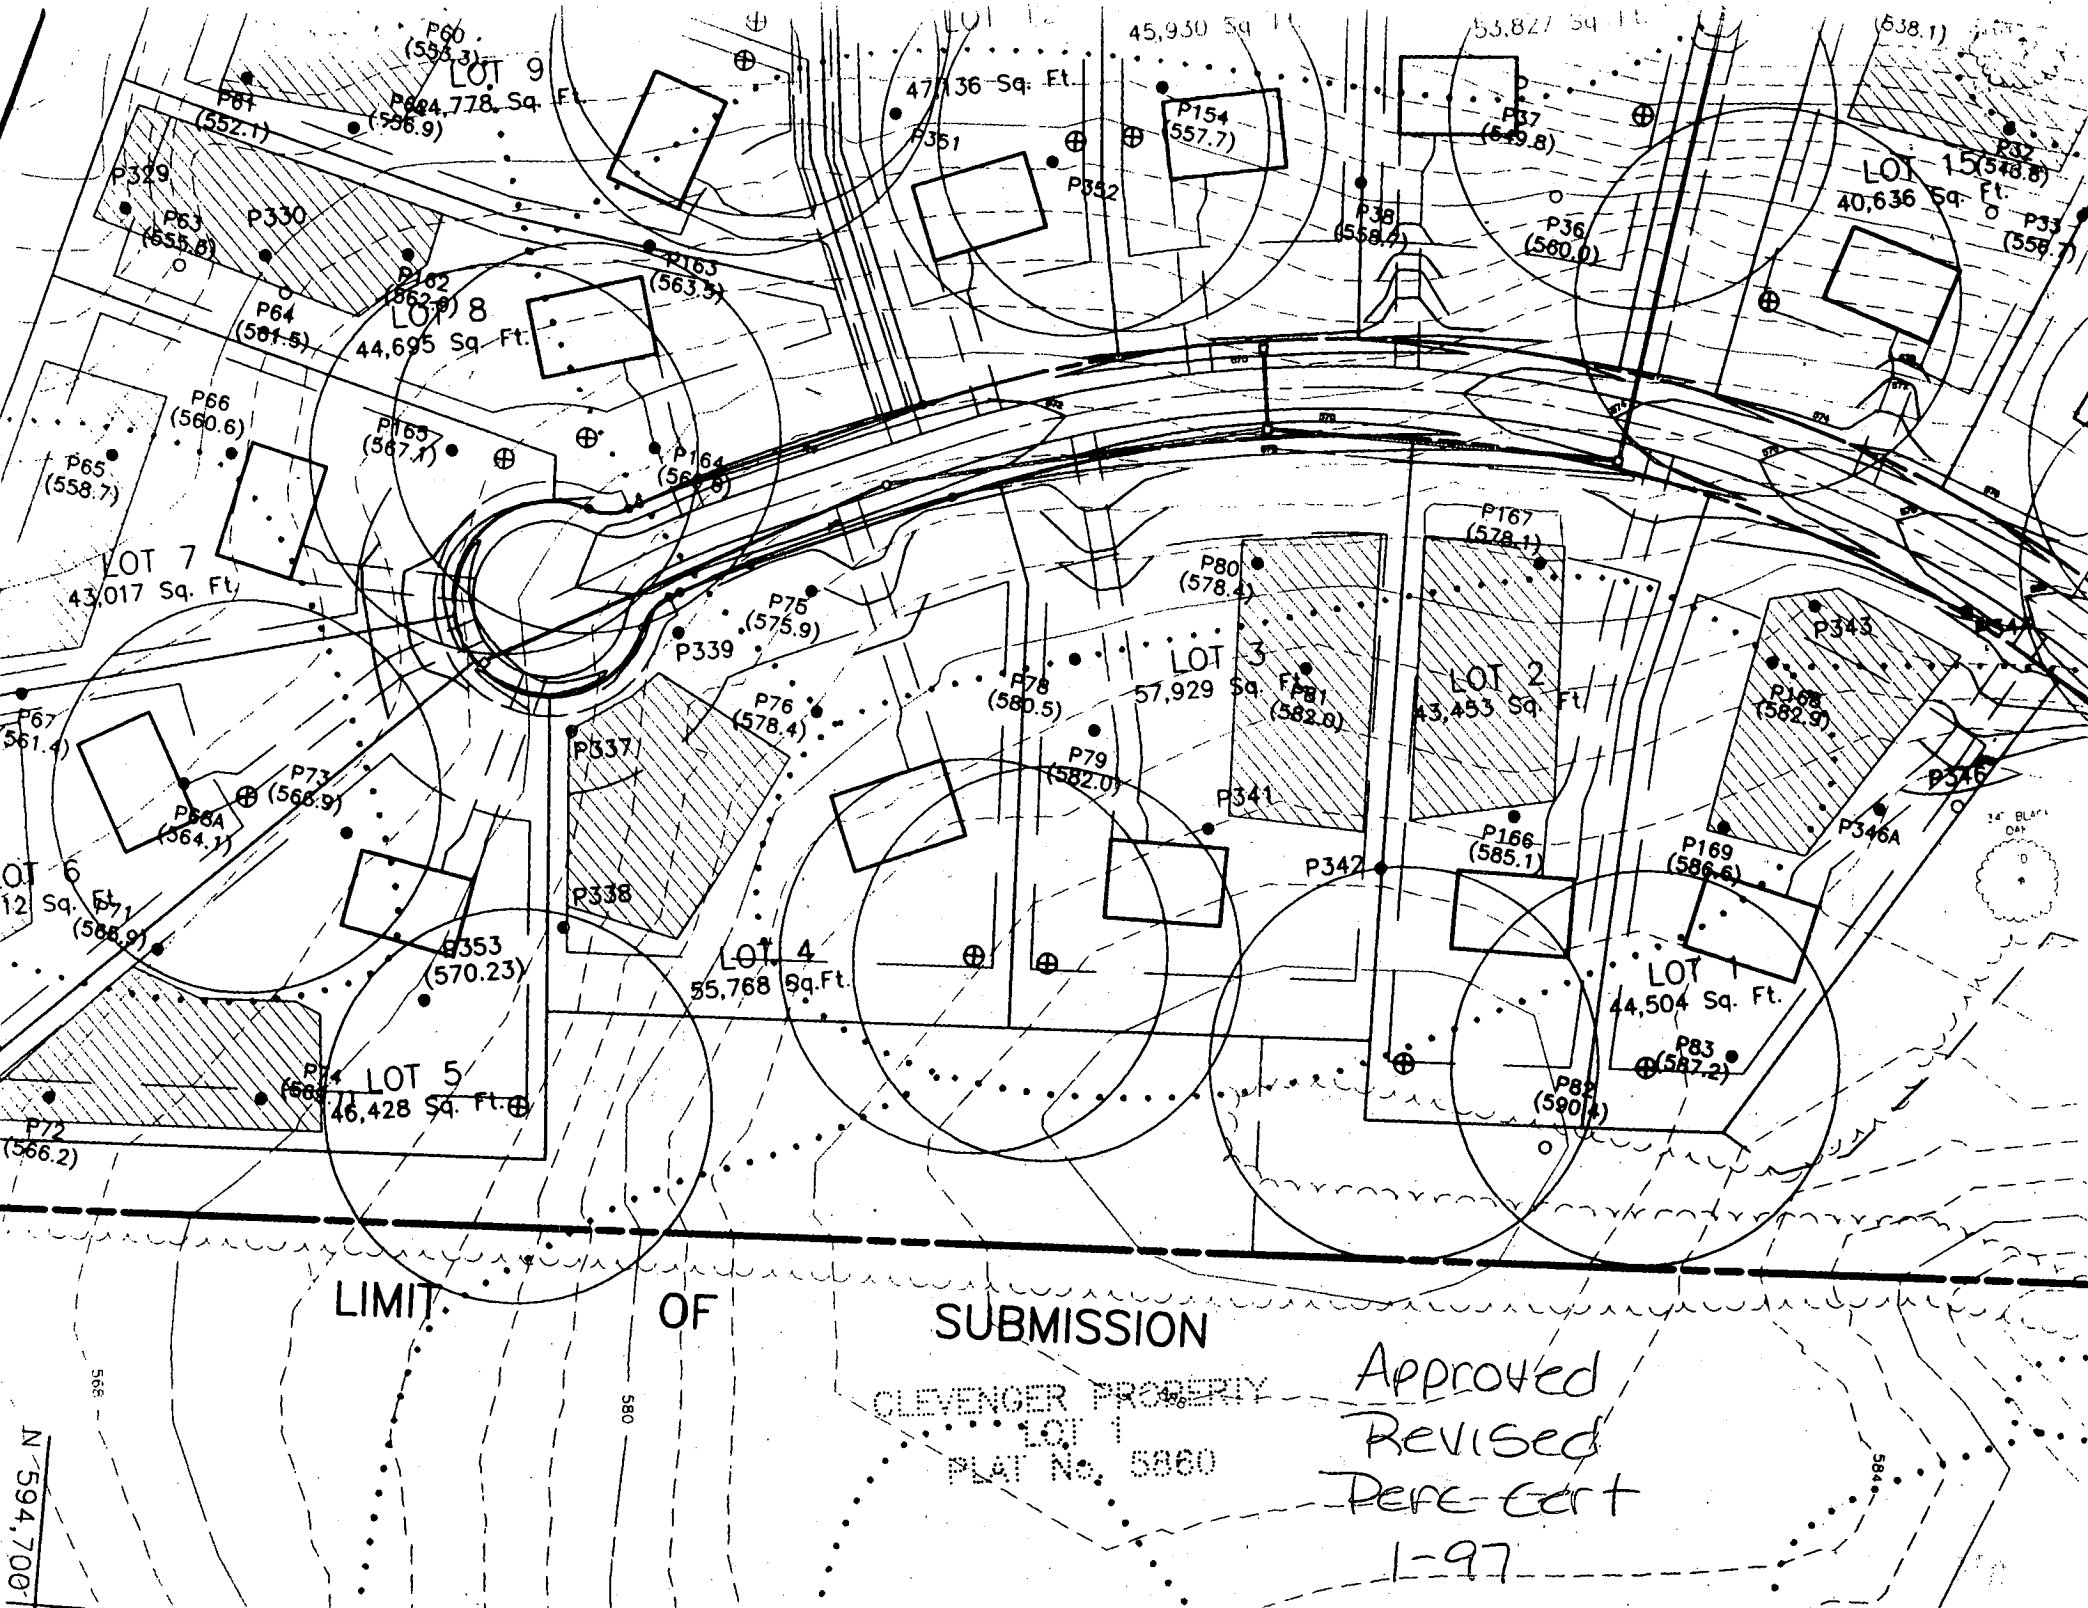

LIMIT

OF

SUBMISSION


CLEVENGER PROPERTY

LOT 1
PLAT No. 5860

Approved
Revised
Perc Cert
1-97

3/11/99

By copy of this plan, the Health Dept. accepts this modification to the recorded

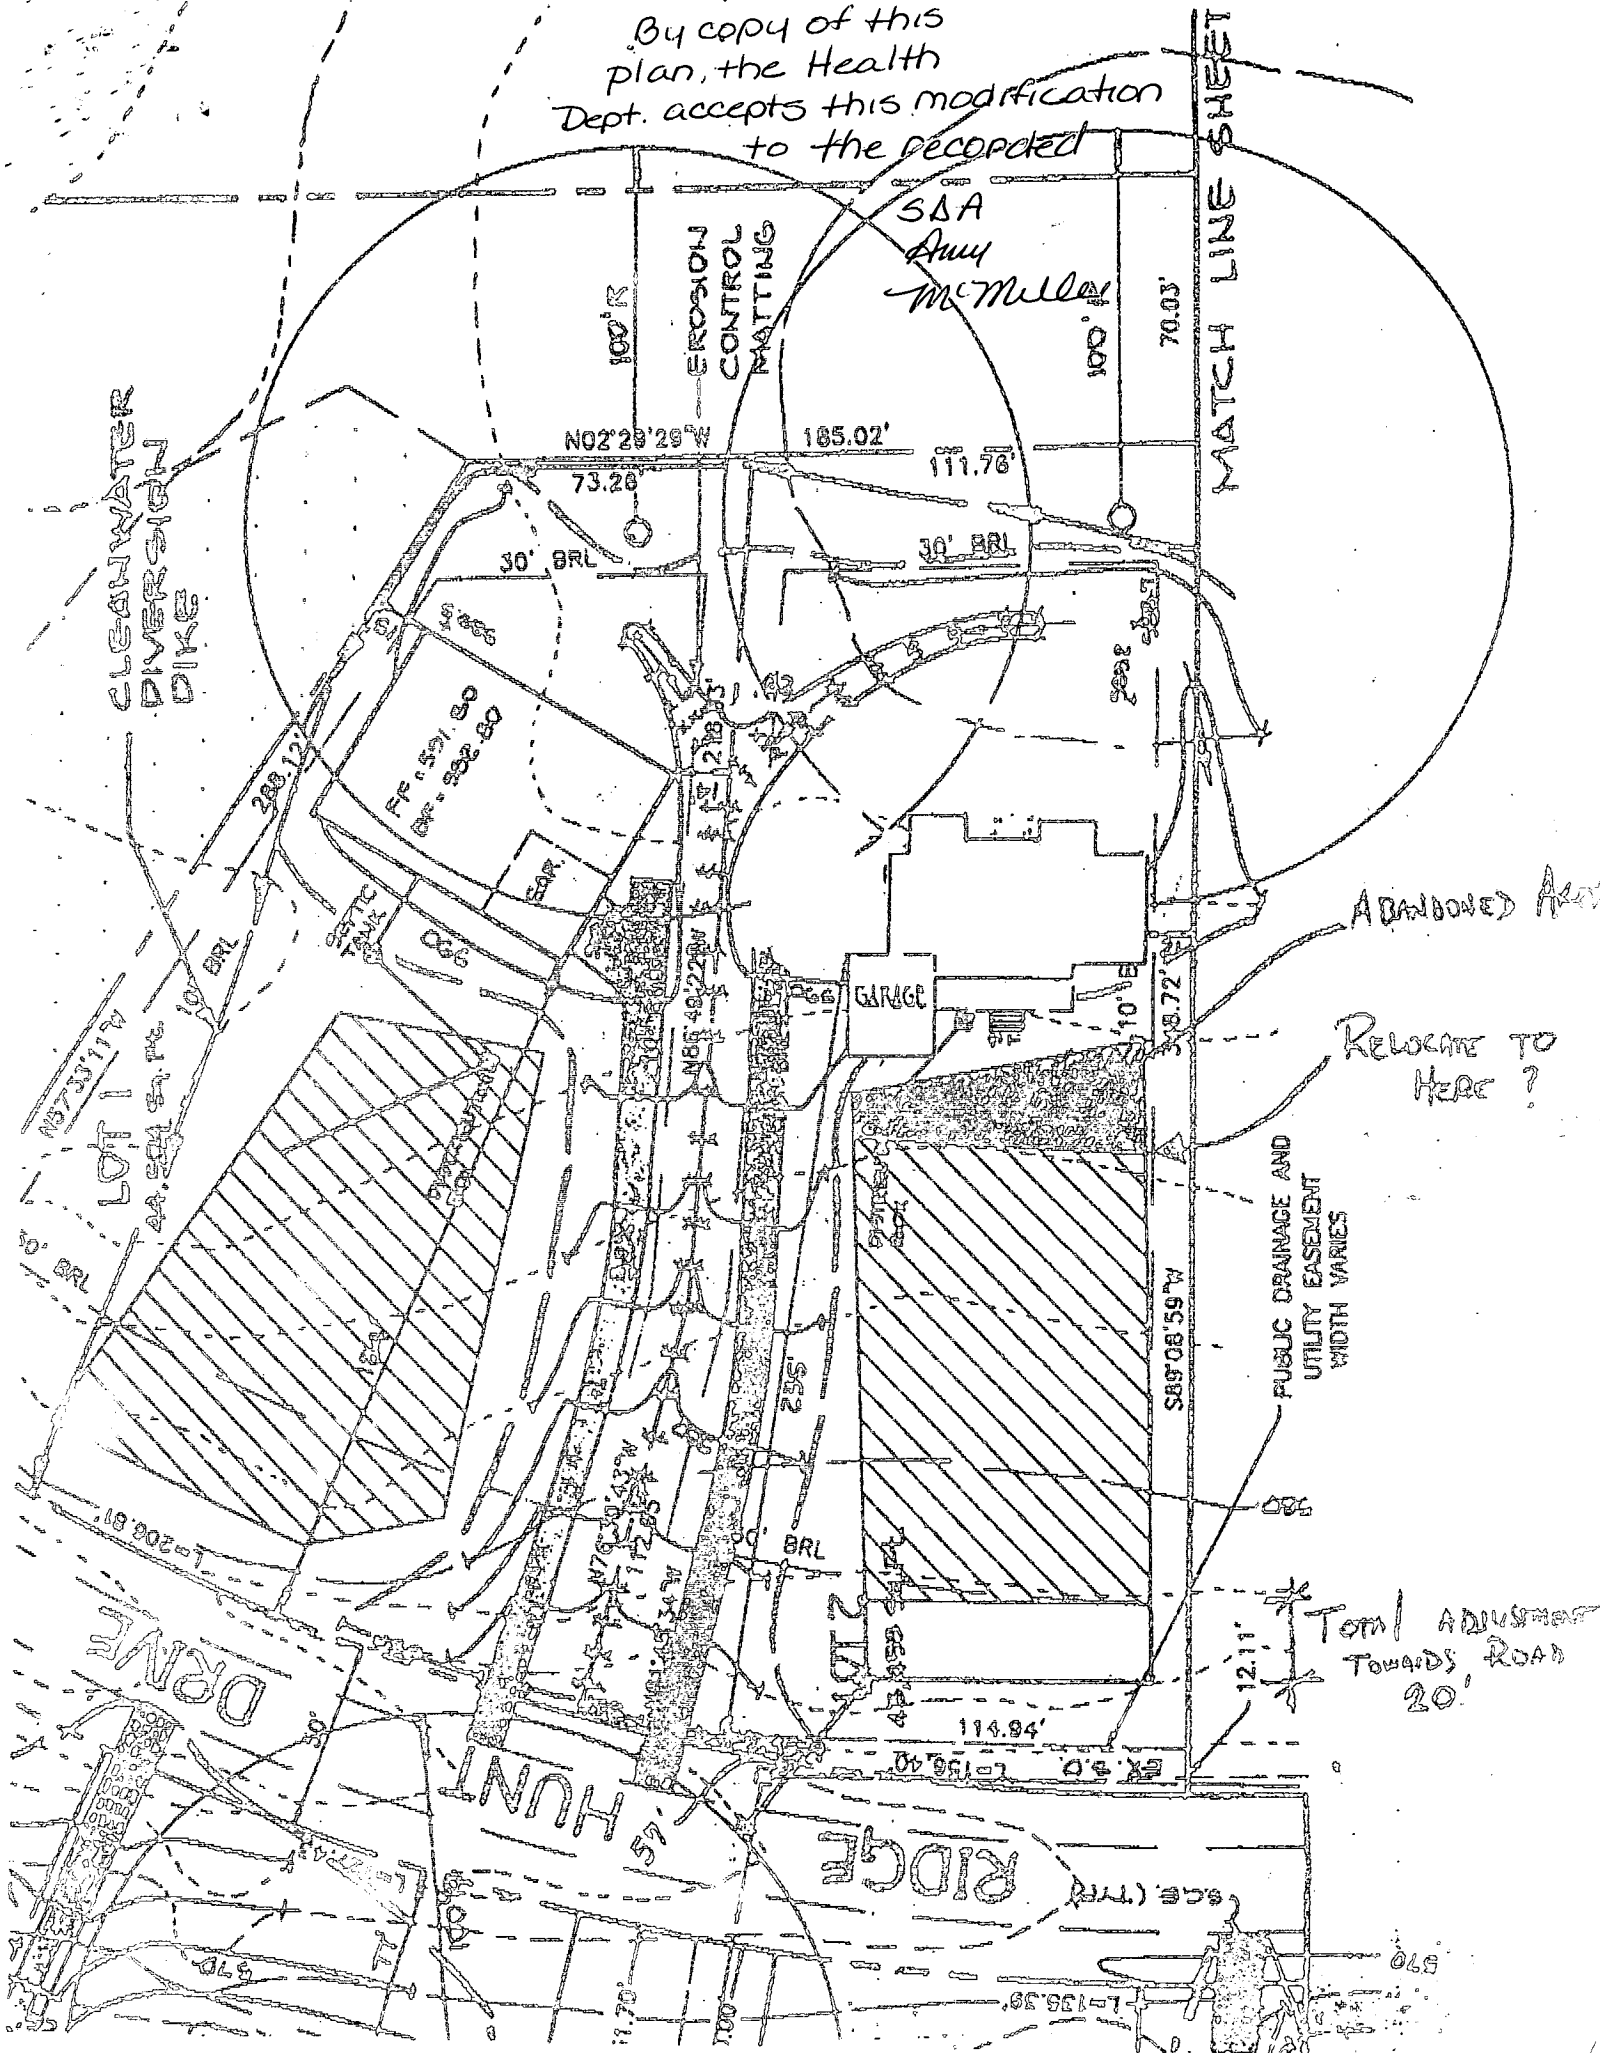


Signature 6/17/97

Width of trench(es) 3 feet

Depth of stone required below
distribution pipe 1.5 feet


MATCH LINE SHEET 3 OF 5

PART OF
PRESERVATION PARCEL 'D'
AREA 2.14 Ac.±
TOTAL AREA 14.41 Ac.±
(AGRICULTURAL PRESERVATION EASEMENT)

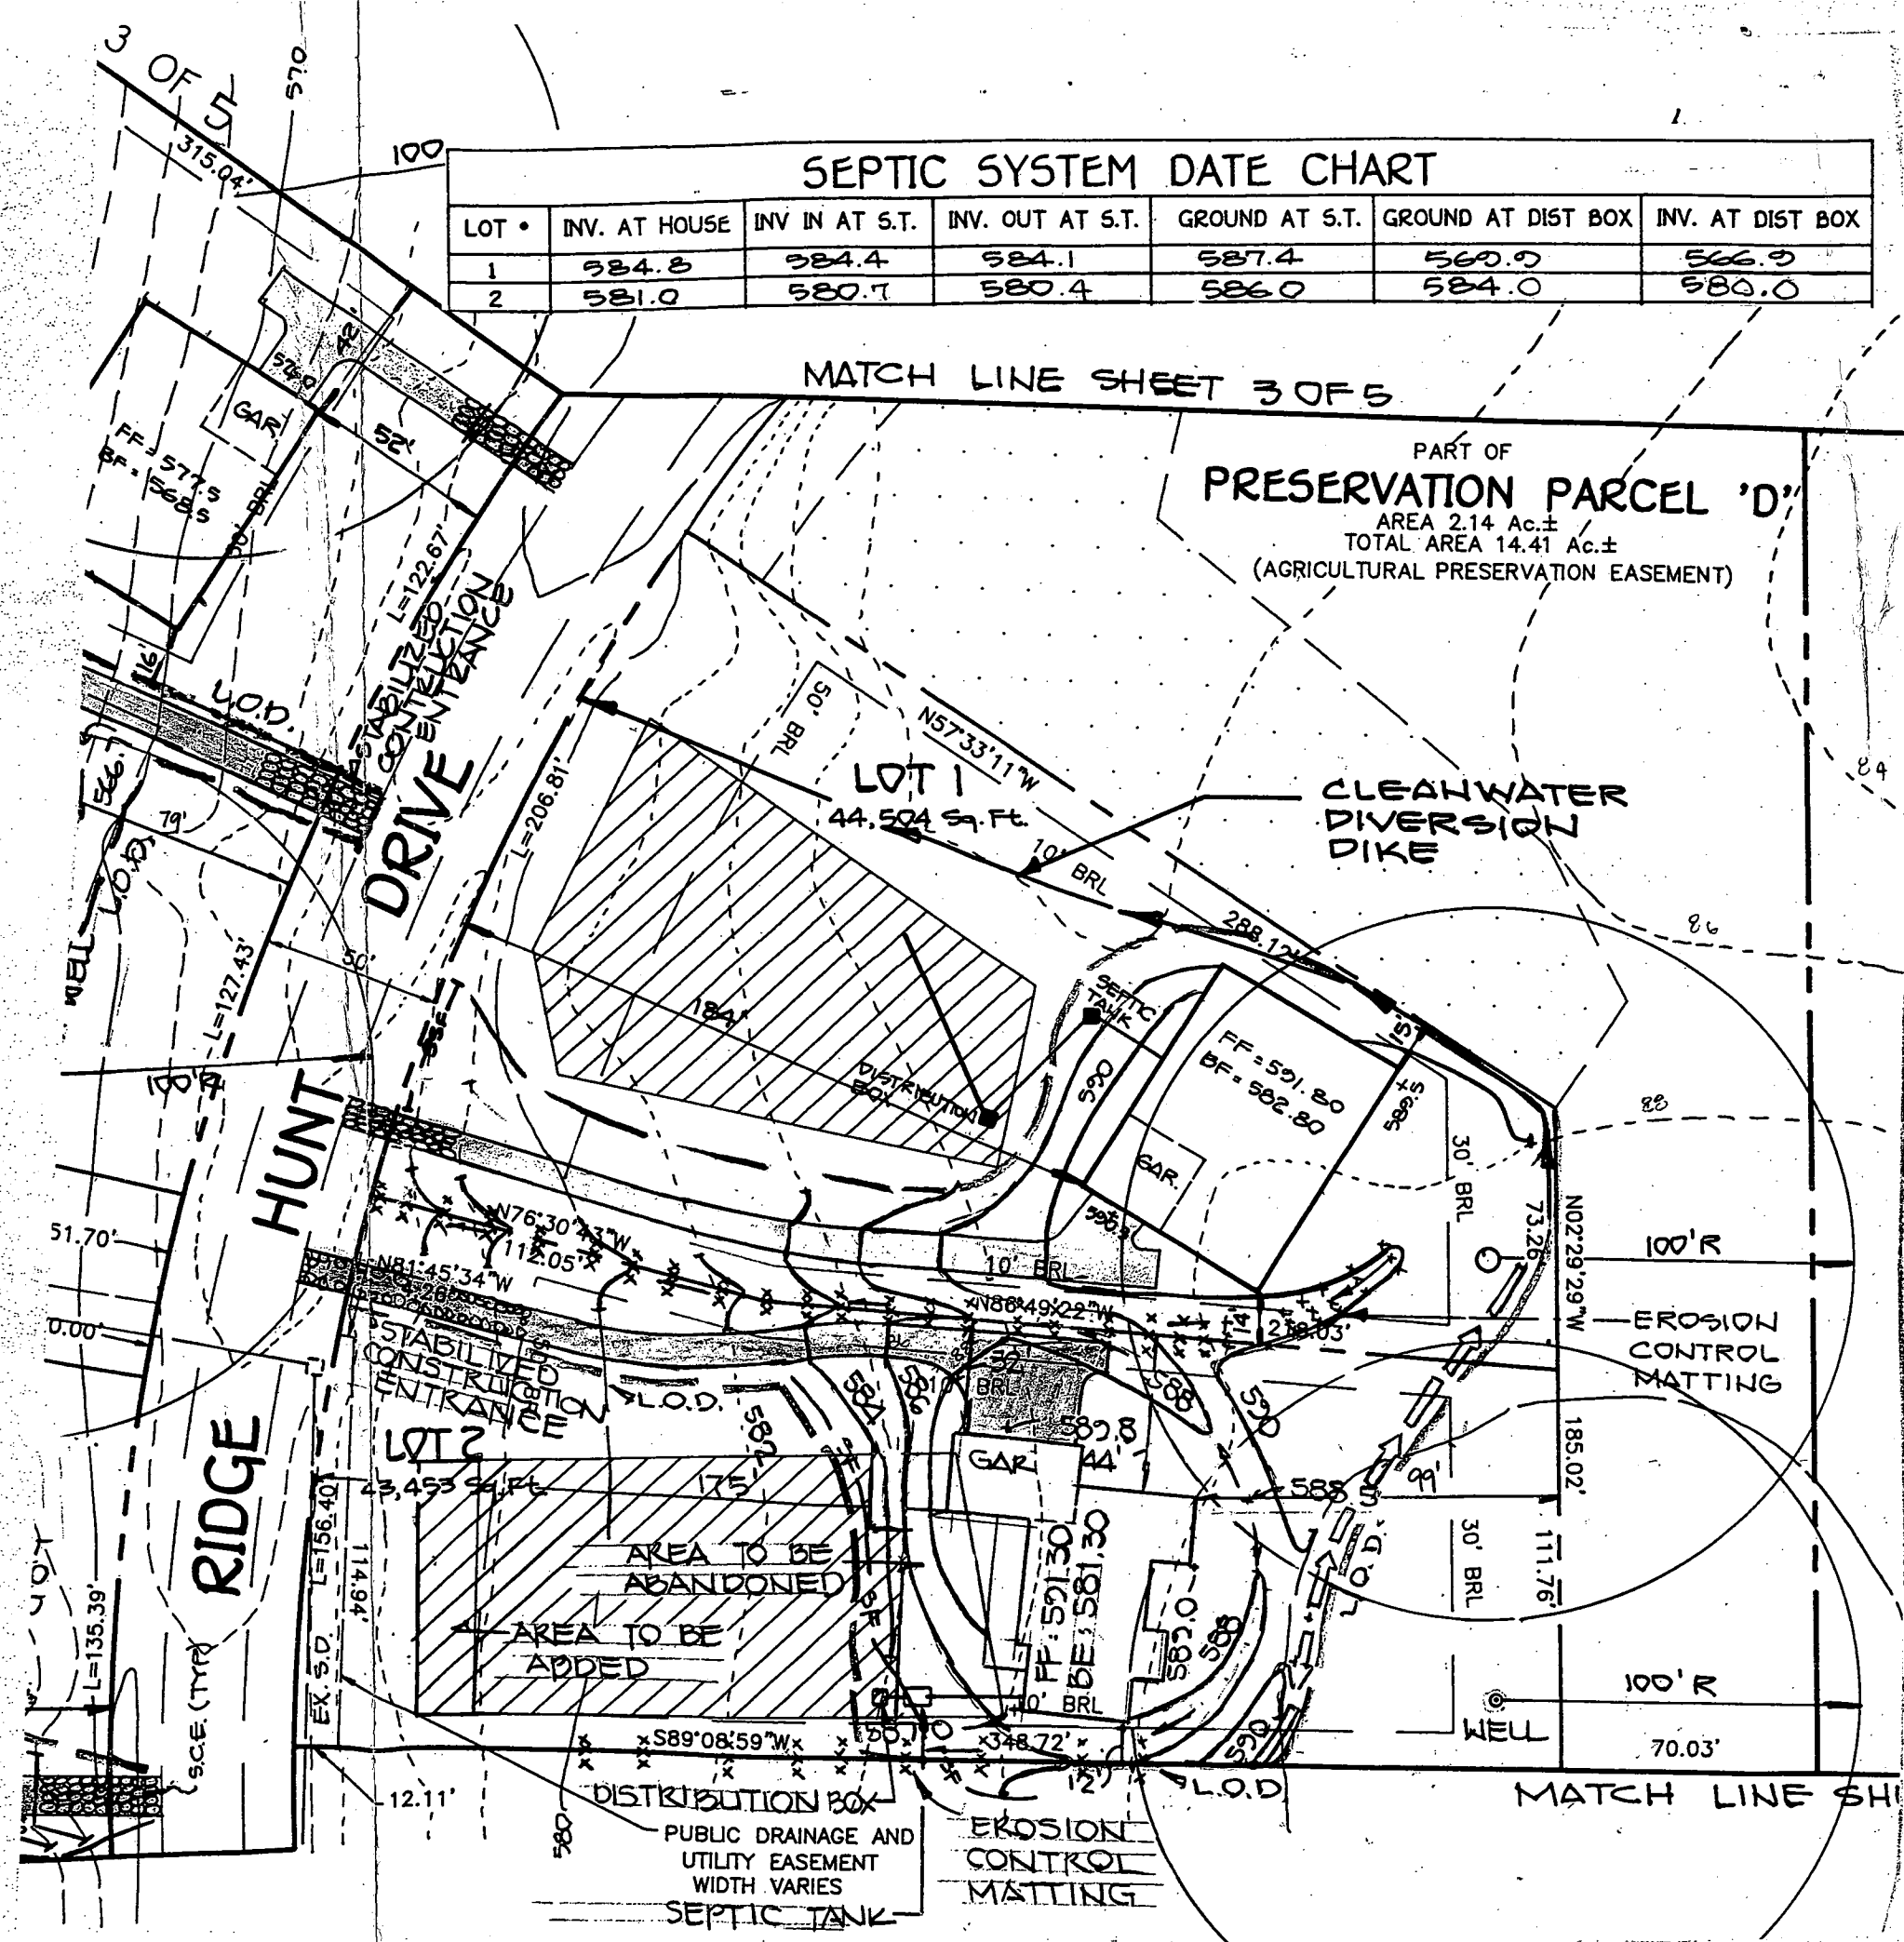

NOTES:

PREPARED FOR THE BENEFIT OF THE CLIENT SIGNING THE HOUSE LOCATION SURVEY APPROVAL FORM
 IS REQUIRED BY A LENDER OR TITLE INSURANCE COMPANY OR ITS AGENTS IN CONNECTION WITH THE
 TRANSFER, FINANCING OR RE-FINANCING. UNLESS INDICATED AS BEING A BOUNDARY SURVEY, THIS
 INTENDED FOR USE IN THE ESTABLISHMENT OF PROPERTY LINES AND IS NOT TO BE RELIED UPON FOR
 ESTABLISHMENT OR LOCATIONS OF FENCES, GARAGES, BUILDINGS OR OTHER EXISTING OR FUTURE IMPROVEMENTS.
 RESULT, THIS PLAT DOES NOT PROVIDE FOR ACCURATE IDENTIFICATION OF PROPERTY LINE, BUT SUCH
 IDENTIFICATION MAY NOT BE REQUIRED FOR THE TRANSFER OF TITLE OR SECURING FINANCING OR RE-FINANCING.
 THE PROPERTY IS SHOWN IN ZONE C ON THE NATIONAL FLOOD INSURANCE PROGRAM FLOOD INSURANCE
 MAP OF HOWARD COUNTY, MARYLAND, COMMUNITY PANEL No. 2400440000 B, EFFECTIVE
DEC. 4, 1986.
 OFFSETS FROM BUILDING LINE TO PROPERTY LINE AS SHOWN ON THE PLAT HEREON ARE TO AN ACCURACY OF 1'
 PLUS OR MINUS (±).

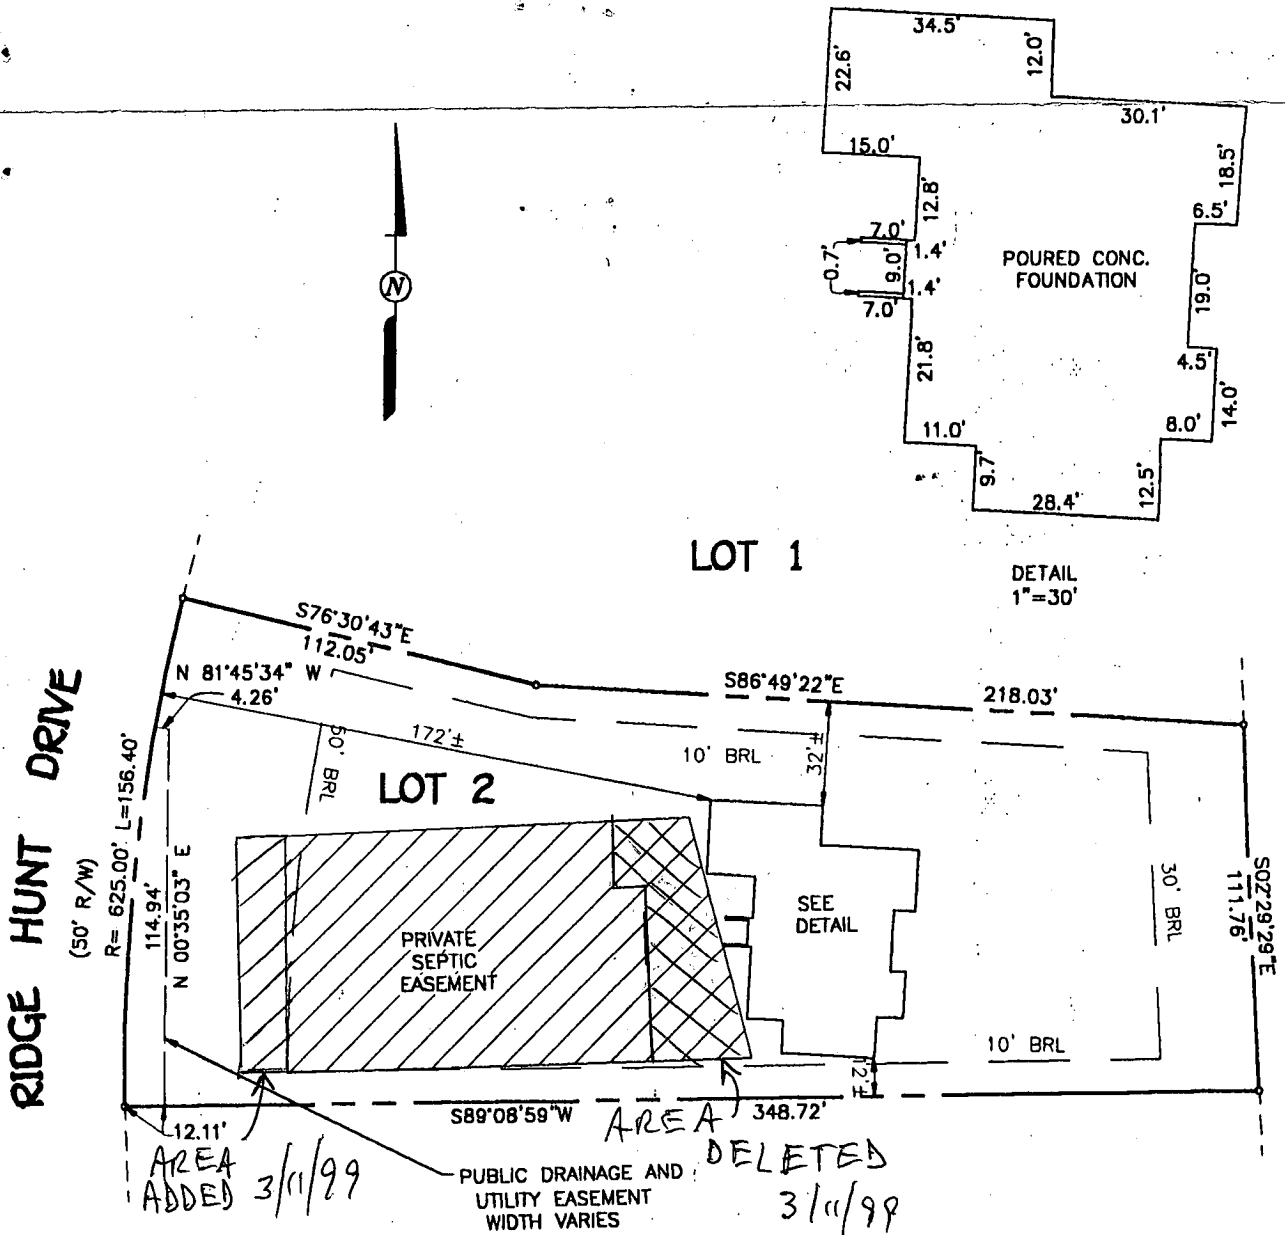

LOT 2
RIDGE VIEW HUNT
 LOTS 1-28 AND PRESERVATION
 PARCELS A THRU F
 FOURTH ELECTION DISTRICT
 HOWARD COUNTY, MARYLAND
 PLAT REF. 13010

FISHER, COLLINS & CARTER, INC.
 CIVIL ENGINEERING CONSULTANTS & LAND SURVEYORS

CENTENNIAL SQUARE OFFICE PARK - 10272 BALTIMORE NATIONAL PIKE
 ELLICOTT CITY, MARYLAND 21042
 (410) 461 - 2055



PROFESSIONAL LAND SURVEYOR
 REG. #10763

**HOUSE LOCATION
 DRAWING**

FOUNDATION LOCATION: 7/20/99
 FINAL LOCATION: _____
 BOUNDARY SURVEY: _____

SCALE: 1"=60'
 DATE: 7/21/99
 DRAWN BY: T.P.F.
 CHECKED BY: C.C.
 PROJECT No.: 61253