

PERMIT

SEWAGE DISPOSAL SYSTEM

DEPARTMENT OF HEALTH AND MENTAL HYGIENE

P 512728

A 50463-A

DISTRICT _____

DATE 9/27/1999

DATE SYSTEM APPROVED 4/2/99

INSPECTOR ALM

HOWARD COUNTY HEALTH DEPARTMENT

BUREAU OF ENVIRONMENTAL HEALTH

~~XXXXXX~~ 410-313-2640

#360486

INDEXED

Walter King Plumbing & Heating

IS PERMITTED TO INSTALL ☒ ALTER _____

ADDRESS 6305 King's Court, Frederick, Maryland 21703 PHONE 301-831-4070

SUBDIVISION Riggs Meadow LOT 30 ROAD 1909 Sycamore Spring Court

PROPERTY OWNER Ryan Homes LYONS

ADDRESS _____ BUILDING PERMIT SIGNED

SEPTIC TANK CAPACITY 1250 GALLONS AND RETURNED
731-03-800143356-16 POUL

NUMBER OF BEDROOMS 4

180 SQUARE FEET PER BEDROOM

LINEAR FEET OF TRENCH REQUIRED 240

TRENCHES - Trench to be 3 feet wide. Inlet 3.0 feet below original grade. Bottom maximum depth 5.0 feet below original grade. Effective area begins at 3.0 feet below original grade. 2.0 feet of stone below distribution pipe.

LOCATION - Place distribution box 160 feet from front (152.05') lot line and 30 feet off the left (375.99') lot line as viewed from Sycamore Spring Court. Install trenches on contour toward right lot line.

NOTES - No trench to exceed 100 feet in length. Provide 6" - 8" diameter cleanout and cap to grade or above on septic tank. 9/20/99 Looks O.K. (BB)

PLANS APPROVED BY Ronald J. Pinkley DATE 8-30-1999

COVER NO WORK UNTIL INSPECTED AND APPROVED

NEITHER THE HOWARD COUNTY COUNCIL NOR THE HEALTH DEPARTMENT IS RESPONSIBLE FOR THE SUCCESSFUL OPERATION OF ANY SYSTEM

NOTE: CLEANOUT REQUIRED EVERY 70 FEET OF SEWER LINE AND/OR AT 90° SWEEPS IN LINES FROM HOUSE TO DRAIN FIELDS. 90° ELBOWS NOT ACCEPTABLE

NOTE: ALL PARTS OF SEPTIC SYSTEMS (I.E. TANK, DISTRIBUTION BOX, TRENCHES) TO BE 100 FEET FROM WELL (UNLESS OTHERWISE SPECIFICALLY AUTHORIZED)

NOTE: IF DEEP TRENCH(ES) ARE USED CALL FOR INSPECTION BEFORE AND AFTER PLACING GRAVEL IN TRENCH(ES)

NOTE: NO DRY WELL SHALL EXCEED 15 FOOT IN DIAMETER NO ABSORPTION TRENCH TO EXCEED 100 FEET IN LENGTH

NOTE: ALL PIPE FROM HOUSE TO SEPTIC TANK MUST BE CAST IRON OR SCHEDULE 35/40 PVC OR ABS

PERMIT VOID AFTER TWO YEARS


NOTE: INSTALL STAND PIPE ON SEPTIC TANK AND DRY WELL STAND PIPES MUST BE 6 INCHES IN DIAMETER CAST IRON, CONCRETE OR TERRA COTTA OR PVA OR ABS ACCEPTED. IF TOP OF SEPTIC TANK IS DEEPER THAN 3 FEET, MANHOLE TO GRADE REQUIRED.

NOTE: DISTRIBUTION BOXES MUST HAVE BAFFLES

*INSTALLER IS RESPONSIBLE FOR OBTAINING FINAL APPROVAL ON THIS PERMIT

B00119837
8/24/99 SFD

50463A

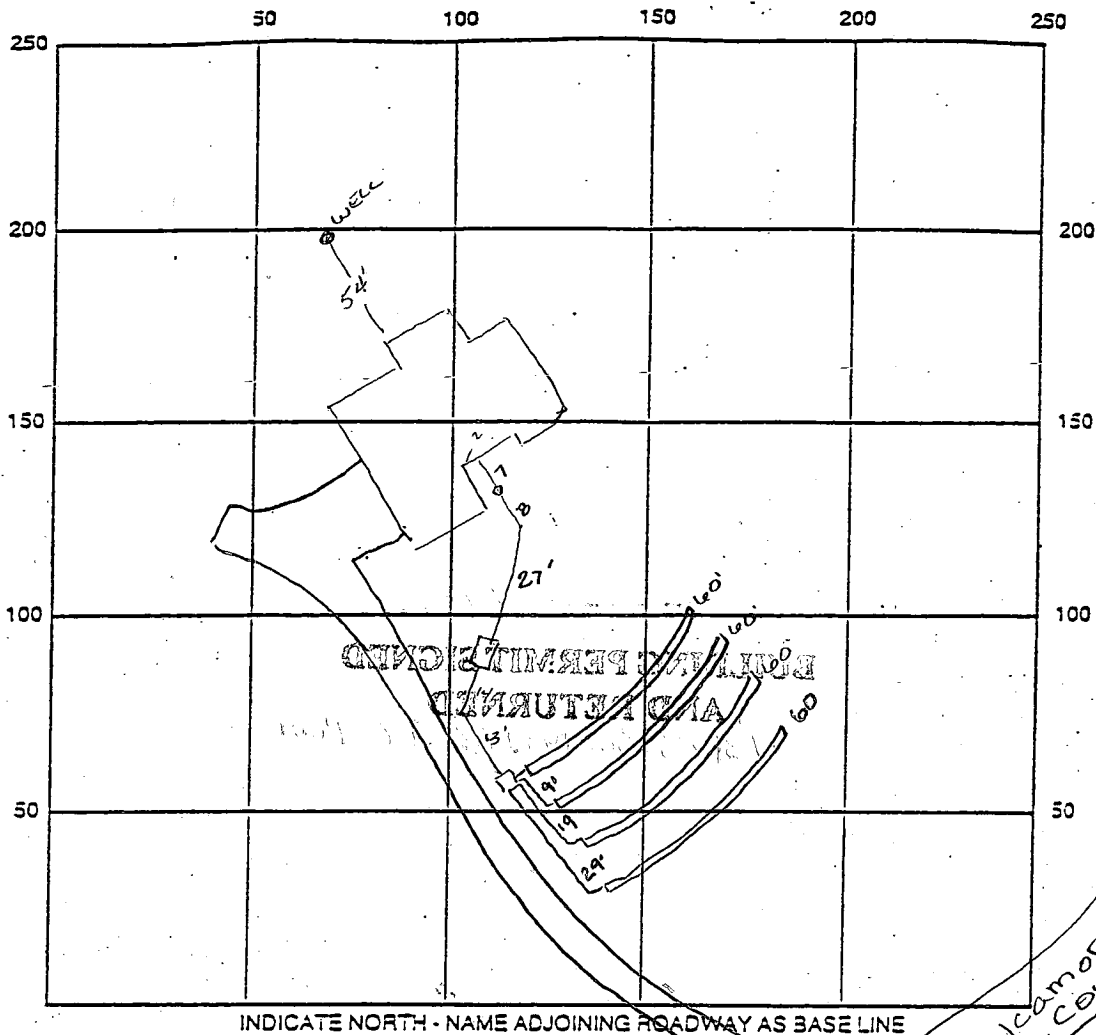

SEPTIC TANK LEVEL 1250 gal

CLEANOUTS OK @ house @ on ST

DISTRIBUTION BOX LEVEL OK baffle is in

DRAIN FIELD/TITLE DEPTH 5.0 FT.

TRENCH WIDTH 3.0 FT.

INLET DEPTH 3.0 FT.

EFFECTIVE GRAVEL DEPTH 2.0 FT.

TOTAL LENGTH 240 FT.

NUMBER OF TRENCHES 4

ONE SIDEWALL/BOTTOM AREA 720 SQ. FT.

DRYWALL INSIDE DIAMETER — FT.

EFFECTIVE DEPTH BELOW INLET 2.0 FT.

ABSORBENT AREA — SQ. FT.

REMARKS: 11/2/99 OK to cover all work final

DATE SYSTEM APPROVED 11/2/99

INSPECTOR A m c m c l l

FROM AUGUST 15
 ER ACRE OF ANNUAL RYE
 CH AUGUST 14, SEED
 5/1000 SQ FT). FOR
 OTECT SITE BY
 W MULCH AND SEED AS
 TO 90 LBS/1000 SQ FT)
 SEEDING. ANCHOR
 ANCHORING TOOL OR
 SIFIED ASPHALT
 GALLONS PER ACRE

IFICATIONS FOR S
 ODS NOT COVERED.

ARATION

OF SOIL BY RAKING,
 G, IF NOT PREVIOUSLY

ATIONS, USE ON OF

OMITIC LIMESTONE
 10-10-10 FERTILIZER
 ROW OR DISC INTO
 SEEDING, APPLY 400
 ZER (9 LBS/1000 SQ

LOMITIC LIMESTONE
 CRE 10-10-10
 EEDING. HARROW OR

30 AND AUGUST 1
 4 LBS/1000 SQ FT)
 ER ACRE (.05
 PER OCTOBER
 1) 2 TONS PER ACRE
 AS POSSIBLE IN THE
 LBS PER ACRE
 S PER ACRE OF WELL

90 LBS/1000 SQ FT)
 SEEDING. ANCHOR
 ANCHORING TOOL OR
 TIED ASPHALT ON
 ALLONS PER ACRE

NEEDED REPAIRS.

OTES

TO THE HOWARD COUNTY
 NT CONTROL DIVISION PRIOR

TO BE INSTALLED ACCORDING
 IN CONFORMANCE WITH THE
 FOR SOIL EROSION AND SEDIMENT

BANCE, PERMANENT OR
 WITHIN: A) 7 CALENDAR DAYS
 ES, DIKES, PERIMETER SLOPES
 AS TO ALL OTHER DISTURBED

NCED AND WARNING SIGNS POSTED
 OL. 1, CHAPTER 12, OF THE
 SE

THE TIME PERIOD SPECIFIED
 STANDARDS AND SPECIFICATIONS
 PERMANENT SEEDINGS (SEC. 51)
 ND MULCHING (SEC. 52).
 N ONLY BE DONE WHEN
 R PROPER GERMINATION AND

AIN IN PLACE AND ARE TO BE
 SSION FOR THEIR REMOVAL HAS
 VMENT CONTROL INSPECTOR.

0.98	ACRES
0.47	ACRES
0.13	ACRES
0.34	ACRES

- ii. Topsoil must be free of plants or plant parts such as grass, nutsedge, poison ivy, thistle, or others as specified.
- iii. Where the subsoil is either highly acidic or composed of heavy clays, ground limestone shall be spread at the rate of 4-8 tons/acre (200-400 pounds per 1,000 square feet) prior to the placement of topsoil. Lime shall be distributed uniformly over designated areas and worked into the soil in conjunction with tillage operations as described in the following procedures. Place topsoil (if required) and apply soil amendments as specified in 20.0 Vegetative Stabilization - Section I - Vegetative Stabilization Methods and Materials.

- 5. When two sections of
- 6. Maintenance shall be develop in the silt
- 7. Filter cloth shall be top and mid section
- Tensile Streng
- Tensile Modu
- Flow Rate
- Filtering Effi

Approved Septic System Plan Howard County Health Department

Total linear feet of trench required 240 feet



Width of trench(es) 3.0 feet

Depth of trench(es) 5.0 feet

Depth of stone required below distribution pipe 2.0 feet

Signature

Date

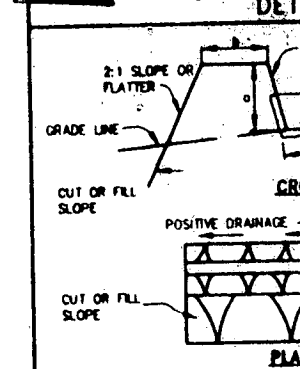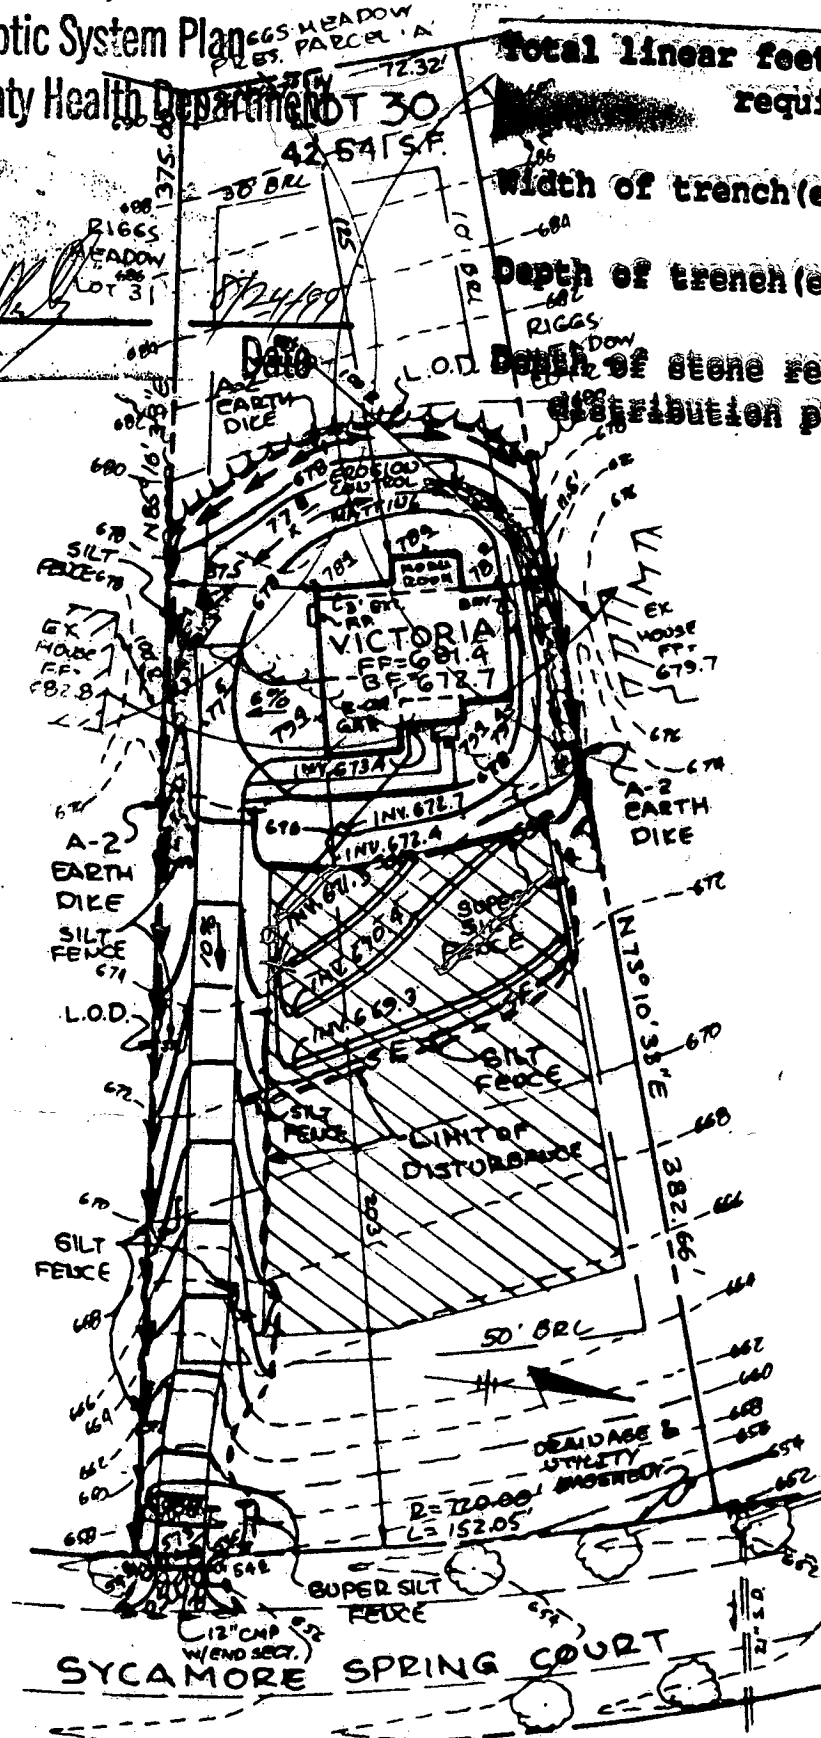

1. Seed and cover with straw
2. Seed and cover with Erosion
3. 4" - 7" stones or recycled
1. All temporary earth dikes
2. Runoff diverted from a dle
3. Runoff diverted from an u
4. All trees, brush, stumps, c
5. The dike shall be excavat
6. Fill shall be compacted b
7. All earth removed and no
8. Inspection and mainten

U.S. DEPARTMENT OF AGRICUL
 SOIL CONSERVATION SERVICE

- i. When topsoiling, main
- Grade Stabilization Str
- ii. Grades on the areas to
- albeit 4" - 8" higher
- iii. Topsoil shall be uniform
- thickness of 4". Spre
- proceed with a minimu
- resulting from topsoil
- of depressions or wat
- iv. Topsoil shall not be p
- the subsoil is excess
- grading and seedbe

PLAN

APPLICATION

PERCOLATION TESTING

50463A
A 002608

P _____

DISTRICT 4B

DATE 10/24/94

HOWARD COUNTY HEALTH DEPARTMENT
BUREAU OF ENVIRONMENTAL HEALTH

3525 H ELLICOTT MILLS DRIVE/ELLICOTT CITY, MARYLAND 21043
TELEPHONE 313-2840

TO: THE COUNTY HEALTH OFFICER
ELLICOTT CITY, MARYLAND

I HEREBY APPLY FOR THE NECESSARY TEST PRIOR TO APPLICATION FOR PERMIT TO CONSTRUCT (OR RECONSTRUCT) A SEWAGE DISPOSAL SYSTEM.

PROPERTY OWNER Amelia Riggs c/o SDC Group, Inc. RYAN HINES

ADDRESS 8480 Balt. Nat. Pike Suite 417
P.O. Box 417 Ellicott City Md 21043 PHONE 465-6105

AGENT OR PROSPECTIVE BUYER _____

ADDRESS _____ PHONE 301

PROPERTY LOCATION:

SUBDIVISION Riggs Property LOT NO. 29

ROAD AND DESCRIPTION Located @ SW Corner of the intersection of Roxbury
Mill Road (Rte 97) & Frederick Road (Rte 144)

TAX MAP 8 & 14 PARCEL # 96 DOB. PERMIT SIGNED
AND RETURNED 8-24-99
Serial # 129837

SIZE OF LOT _____ TYPE BLDG. SFD - 4 BDRM
(SINGLE FAMILY DWELLING OR COMMERCIAL)

THE SYSTEM INSTALLED UNDER THIS APPLICATION IS ACCEPTABLE ONLY UNTIL PUBLIC FACILITIES BECOME AVAILABLE. I FULLY UNDERSTAND THE
FEE CONNECTED WITH THE FILING OF THIS PERC TEST APPLICATION IS NON-REFUNDABLE UNDER ANY CIRCUMSTANCES. I ALSO AGREE TO
COMPLY WITH ALL M.O.S.H.A. REQUIREMENTS IN TESTING THIS LOT. Juanita R. Mader V.P.
(SIGNATURE OF APPLICANT)

APPROVED BY _____ FOR _____ DATE _____

DISAPPROVED BY _____ FOR _____ DATE _____

HOLD PENDING FURTHER TESTS _____

REASONS FOR REJECTION OR HOLDING _____

PERCOLATION TEST PLAT/PRELIMINARY PLAT - TITLE OR I.D. # _____ DATE _____

SITE DEVELOPMENT PLAN/FINAL PLAT - TITLE OR I.D. # _____ DATE _____

THIS IS NOT A PERMIT

COUNTY #

SOIL PROFILE

472

orange
red brn
silum
100% frags

zone of
40% brown
rock silum

red brn
w/ yellow
splotches

darker
red
silum
100% frags

455

bright
orange
silum

50%
frags
orange
silum


red
brn
silum
w/
blu
rocks

471

orange
brown
clay

mottling
below
clay
layer

pink
silum
very
friable
and
dry

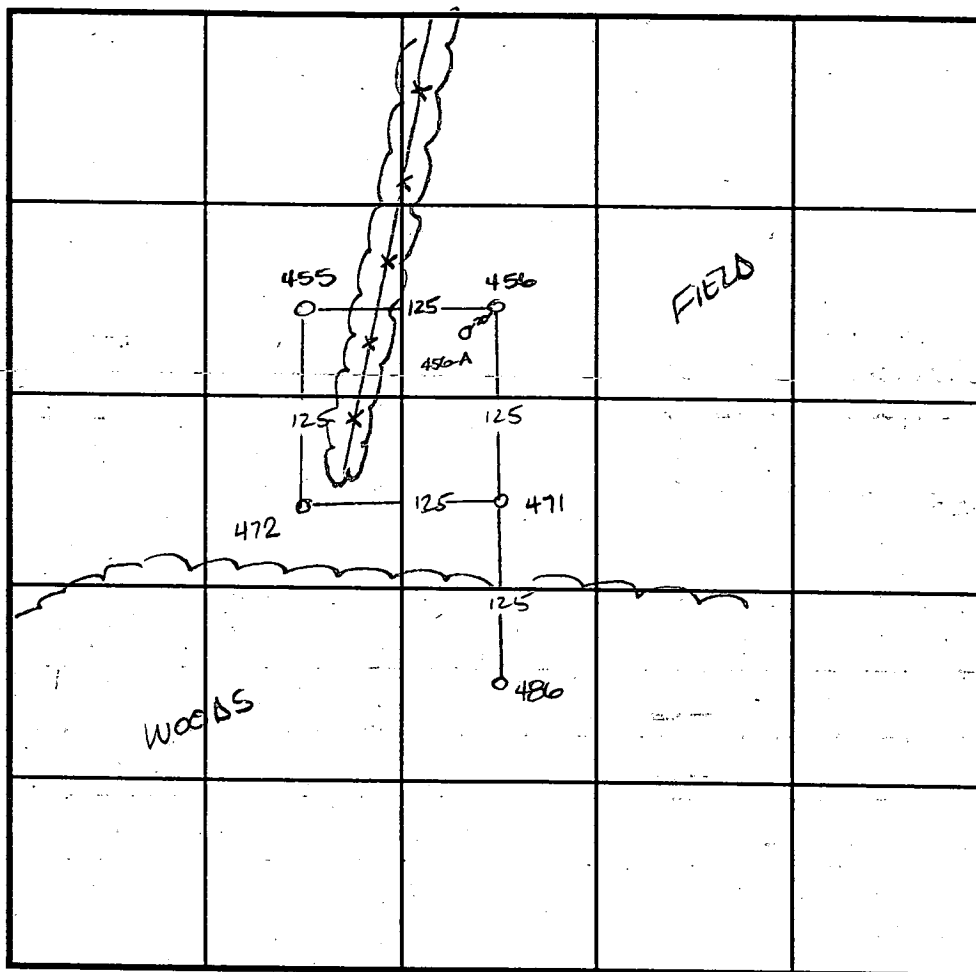

INDICATE NORTH - NAME ADJOINING ROADWAY AS BASE LINE.

SOIL PROFILE

486

bright
orange
red
silum

1st
orange
silum
very
friable
w/
good
structure

456-A

dark
red
silum

pink
matrix
color
30%
small
brags

DATE	TEST NO.	DEPTH	PRE-WET		TEST - 1" DROP		TIME
			START	STOP	START	STOP	
11-15-94	472	Visual	to 12.0	- sce	profile		OK
	455	3.5 VII	5:42	5:43 ³⁰	5:43 ³⁰	5:46 ³⁰	3mn
11-3-94	456	4.5 5.0 % rock					F
	471	4.5 VII	8:58	9:02	9:02	9:08 ³⁰	6 1/2 min
	486	5.0 VII	5:45	5:46	5:46	5:48	2min
11-30-95	456-A	Visual	12'	- sce	profile		OK

REMARKS

TYPE OF SOIL

TESTED BY

Amy McMillen

ALSO PRESENT

TRENCH DESIGN DATA: AVERAGE PERCOLATION TIME

TRENCH WIDTH

INLET DEPTH

MAXIMUM BOTTOM DEPTH

SQ. FT./BEDROOM

9347		SEQUENCE NO. (MDE USE ONLY)	STATE OF MARYLAND WELL COMPLETION REPORT FILL IN THIS FORM COMPLETELY PLEASE PRINT OR TYPE		THIS REPORT MUST BE SUBMITTED WITHIN 45 DAYS AFTER WELL IS COMPLETED.	
1 2 3 6 (THIS NUMBER IS TO BE PUNCHED IN COLS. 3-6 ON ALL CARDS)		DATE WELL COMPLETED MM DD YY 7 15 97		Depth of Well 22 385 26 (TO NEAREST FOOT)		COUNTY NUMBER
ST/CO. USE ONLY DATE Received MM DD YY 8 13		PERMIT NO. FROM "PERMIT TO DRILL WELL" Ho-94-1113		28 29 30 31 32 33 34 35 36 37		
OWNER SDC		last name		first name		
STREET OR RFD SCENIC DRIVE		TOWN COOKSVILLE		SECTION LOT 30		
SUBDIVISION RIGGS PROPERTY		SECTION		LOT		
WELL LOG Not required for driven wells		GROUTING RECORD WELL HAS BEEN GROUTED (Circle Appropriate Box) TYPE OF GROUTING MATERIAL (Circle one) CEMENT (CM) BENTONITE CLAY (BC) NO. OF BAGS 6 NO. OF POUNDS 564 GALLONS OF WATER 36 DEPTH OF GROUT SEAL (to nearest foot) from 0 ft. to 19 ft. (enter 0 if from surface)		PUMPING TEST HOURS PUMPED (nearest hour) 6 PUMPING RATE (gal. per min.) 2.4 METHOD USED TO MEASURE PUMPING RATE Bucket WATER LEVEL (distance from land surface) BEFORE PUMPING 64 ft. WHEN PUMPING 343 ft. TYPE OF PUMP USED (for test) A air P piston T turbine C centrifugal R rotary O other (describe below) J jet S submersible		
STATE THE KIND OF FORMATIONS PENETRATED, THEIR COLOR, DEPTH, THICKNESS AND IF WATER BEARING		CASING RECORD casing types insert appropriate code below MAIN CASING TYPE ST 6 21 OTHER CASING (if used) diameter inch depth (feet) from to		PUMP INSTALLED DRILLER WILL INSTALL PUMP (CIRCLE) (YES or NO) YES (NO) IF DRILLER INSTALLS PUMP, THIS SECTION MUST BE COMPLETED FOR ALL WELLS. TYPE OF PUMP INSTALLED PLACE (A,C,J,P,R,S,T,O) IN BOX 29 CAPACITY: GALLONS PER MINUTE (to nearest gallon) 31 35 PUMP HORSE POWER 37 41 PUMP COLUMN LENGTH (nearest ft.) 43 47 CASING HEIGHT (circle appropriate box and enter casing height) + above LAND SURFACE - below 1 (nearest foot)		
DESCRIPTION (Use additional sheets if needed)		SCREEN RECORD screen type or open hole (insert appropriate code below) ST BR HO STEEL BRASS OPEN HOLE PL PLASTIC OTHER		LOCATION OF WELL ON LOT SHOW PERMANENT STRUCTURE SUCH AS BUILDING, SEPTIC TANKS, AND /OR LANDMARKS AND INDICATE NOT LESS THAN TWO DISTANCES (MEASUREMENTS TO WELL) See attached well locations.		
Brown Shale 0 15'		DEPTH (nearest ft.) HO 20 385				
Gray Mica Rock 15 385		E A C H C A S I N G 1 2 3 76				
1 dry well 480'		SLOT SIZE 1 2 3				
Filled in with cement + drilling materials		DIAMETER OF SCREEN (NEAREST INCH) 56 60				
NUMBER OF UNSUCCESSFUL WELLS: 1		GRAVEL PACK IF WELL DRILLED WAS FLOWING WELL INSERT F IN BOX 68				
WELL HYDROFRACTURED yes (Y) no (N)		MDE USE ONLY (NOT TO BE FILLED IN BY DRILLER) T (E.R.O.S.) W Q				
CIRCLE APPROPRIATE LETTER A A WELL WAS ABANDONED AND SEALED WHEN THIS WELL WAS COMPLETED E ELECTRIC LOG OBTAINED P TEST WELL CONVERTED TO PRODUCTION WELL		TELESCOPE CASING LOG INDICATOR OTHER DATA				
I HEREBY CERTIFY THAT THIS WELL HAS BEEN CONSTRUCTED IN ACCORDANCE WITH COMAR 26.04.04 "WELL CONSTRUCTION" AND IN CONFORMANCE WITH ALL CONDITIONS STATED IN THE ABOVE CAPTIONED PERMIT, AND THAT THE INFORMATION PRESENTED HEREIN IS ACCURATE AND COMPLETE TO THE BEST OF MY KNOWLEDGE.		SITE SUPERVISOR (sign. of driller or journeyman responsible for sitework if different from permittee)				
DRILLERS LIC. NO. 1 MS DO24		DRILLERS SIGNATURE (MUST MATCH SIGNATURE ON APPLICATION)				
LIC. NO. 1 M D						

EMERGENCY/TEMP NO. IF ANY

8	1	7466	SEQUENCE NO. (MDE USE ONLY)	STATE OF MARYLAND PERMIT TO DRILL WELL please print or type	STATE PERMIT NUMBER
(THIS NUMBER IS TO BE PUNCHED IN COLS. 3-6 ON ALL CARDS)			<div style="border: 1px solid black; padding: 5px; display: inline-block;"> HO-94-11113 <small>70 fill in this form completely 78</small> </div>		

OWNER INFORMATION

Date Received (APA) 033197

15 Last Name SOC Owner First Name ELLICOTT

36 Street or RFD CITYMD1047 55

70 State 72 Zip 76

DRILLER INFORMATION

CIRCLE: MSD/MGD/MWD MSD

Driller's Name Joseph L. Mayne 77 License No. 80 024

Firm Name Joseph L. Mayne Well Drilling

Address 5512 Ridge Rd. Mt Airy 21771

Signature Joseph L. Mayne Date 3/31/97

WELL INFORMATION

APPROX. PUMPING RATE (GAL. PER MIN.) 5

AVERAGE DAILY QUANTITY NEEDED (GAL. PER DAY) 500

USE FOR WATER (CIRCLE APPROPRIATE BOX)

☒ D HOME (SINGLE OR DOUBLE HOUSEHOLD UNIT ONLY)

☐ F FARMING (LIVESTOCK WATERING & AGRICULTURAL IRRIGATION)

☐ I INDUSTRIAL, COMMERCIAL, STATE AND FEDERAL GOV. OTHER (REQUIRES APPROPRIATION PERMIT)

☐ P PUBLIC OR PRIVATE WATER COMPANY (REQUIRES APPROPRIATION PERMIT AND STATE HEALTH DEPARTMENT APPROVAL)

☐ T TEST, OBSERVATION, MONITORING (MAY REQUIRE APPROPRIATION PERMIT)

APPROXIMATE DEPTH OF WELL 200 FEET

APPROXIMATE DIAMETER OF WELL 6 INCH

METHOD OF DRILLING (circle one)

BORED (or Augered) JETTED Jetted & DRIVEN

AIR-ROTARY AIR-PERCussion ROTARY (Hydraulic Rotary)

CABLE REVerse-ROTary Drive-POINT

other _____

REPLACEMENT OR DEEPEMED WELLS (CIRCLE APPROPRIATE BOX)

☒ N THIS WELL WILL NOT REPLACE AN EXISTING WELL

☐ Y THIS WELL WILL REPLACE A WELL THAT WILL BE ABANDONED AND SEALED

☐ S THIS WELL WILL REPLACE A WELL THAT WILL BE USED AS A STANDBY-CONTACT LOCAL APPROVING AUTHORITY FOR POLICY ON STANDBY WELLS

☐ D THIS WELL WILL DEEPEMED AN EXISTING WELL

PERMIT NUMBER OF WELL TO BE REPLACED OR DEEPEMED (IF AVAILABLE) 41 _____ 52

Not to be filled in by driller (MDE OR COUNTY USE ONLY)

APPROX. PERMIT NUMBER _____

FORCE AM INITIALS IN BOX PERMIT No. HO-94-11113

SPECIAL CONDITIONS

NOTE - APPROVING AUTHORITIES SHOULD USE SEPARATE SHEET IF NEEDED -

LOCATION OF WELL

8 COUNTY HOWARD 21

23 SUBDIVISION RIGGS PROPERTY 42

SECTION 44 LOT 30 50

52 NEAREST TOWN COOKSVILLE 71

MILES FROM TOWN (enter 0 if in town) 1 MI 73 76 77 78

DIRECTION OF WELL FROM TOWN (CIRCLE BOX)

S

NEAR WHAT ROAD Scenic Dr. 11 30

ON WHICH SIDE OF ROAD (CIRCLE APPROPRIATE BOX) WEST NORTH SOUTH EAST

DISTANCE FROM ROAD 210 ENTER FT OR MI FT 34 37 38 39

TAX MAP: _____ BLK: _____ PARCEL: _____

NOT TO BE FILLED IN BY DRILLER HEALTH DEPARTMENT APPROVAL

Howard 13- COUNTY NAME COUNTY NO.

DATE ISSUED 042297 INSERT S 41

CO SIGNATURE Ann M. Miller EXP. DATE 04/21/98

NORTH GRID 540000 EAST GRID 0792000

SHOW MAJOR FEATURES OF BOX & LOCATE WELL WITH AN X

SOURCES OF DRILLING WATER

- Well
-
-

WRITE THE BOX NUMBER FROM THE MAP HERE

7902

53040

DRAW A SKETCH BELOW SHOWING LOCATION OF WELL IN RELATION TO NEARBY TOWNS AND ROADS AND GIVE DISTANCE FROM WELL TO NEAREST ROAD JUNCTION

7-15-97

Grout 11:00


Scenic Dr.

Meadowcroft

COOKSVILLE

SYCAMORE SPRING

MD 97

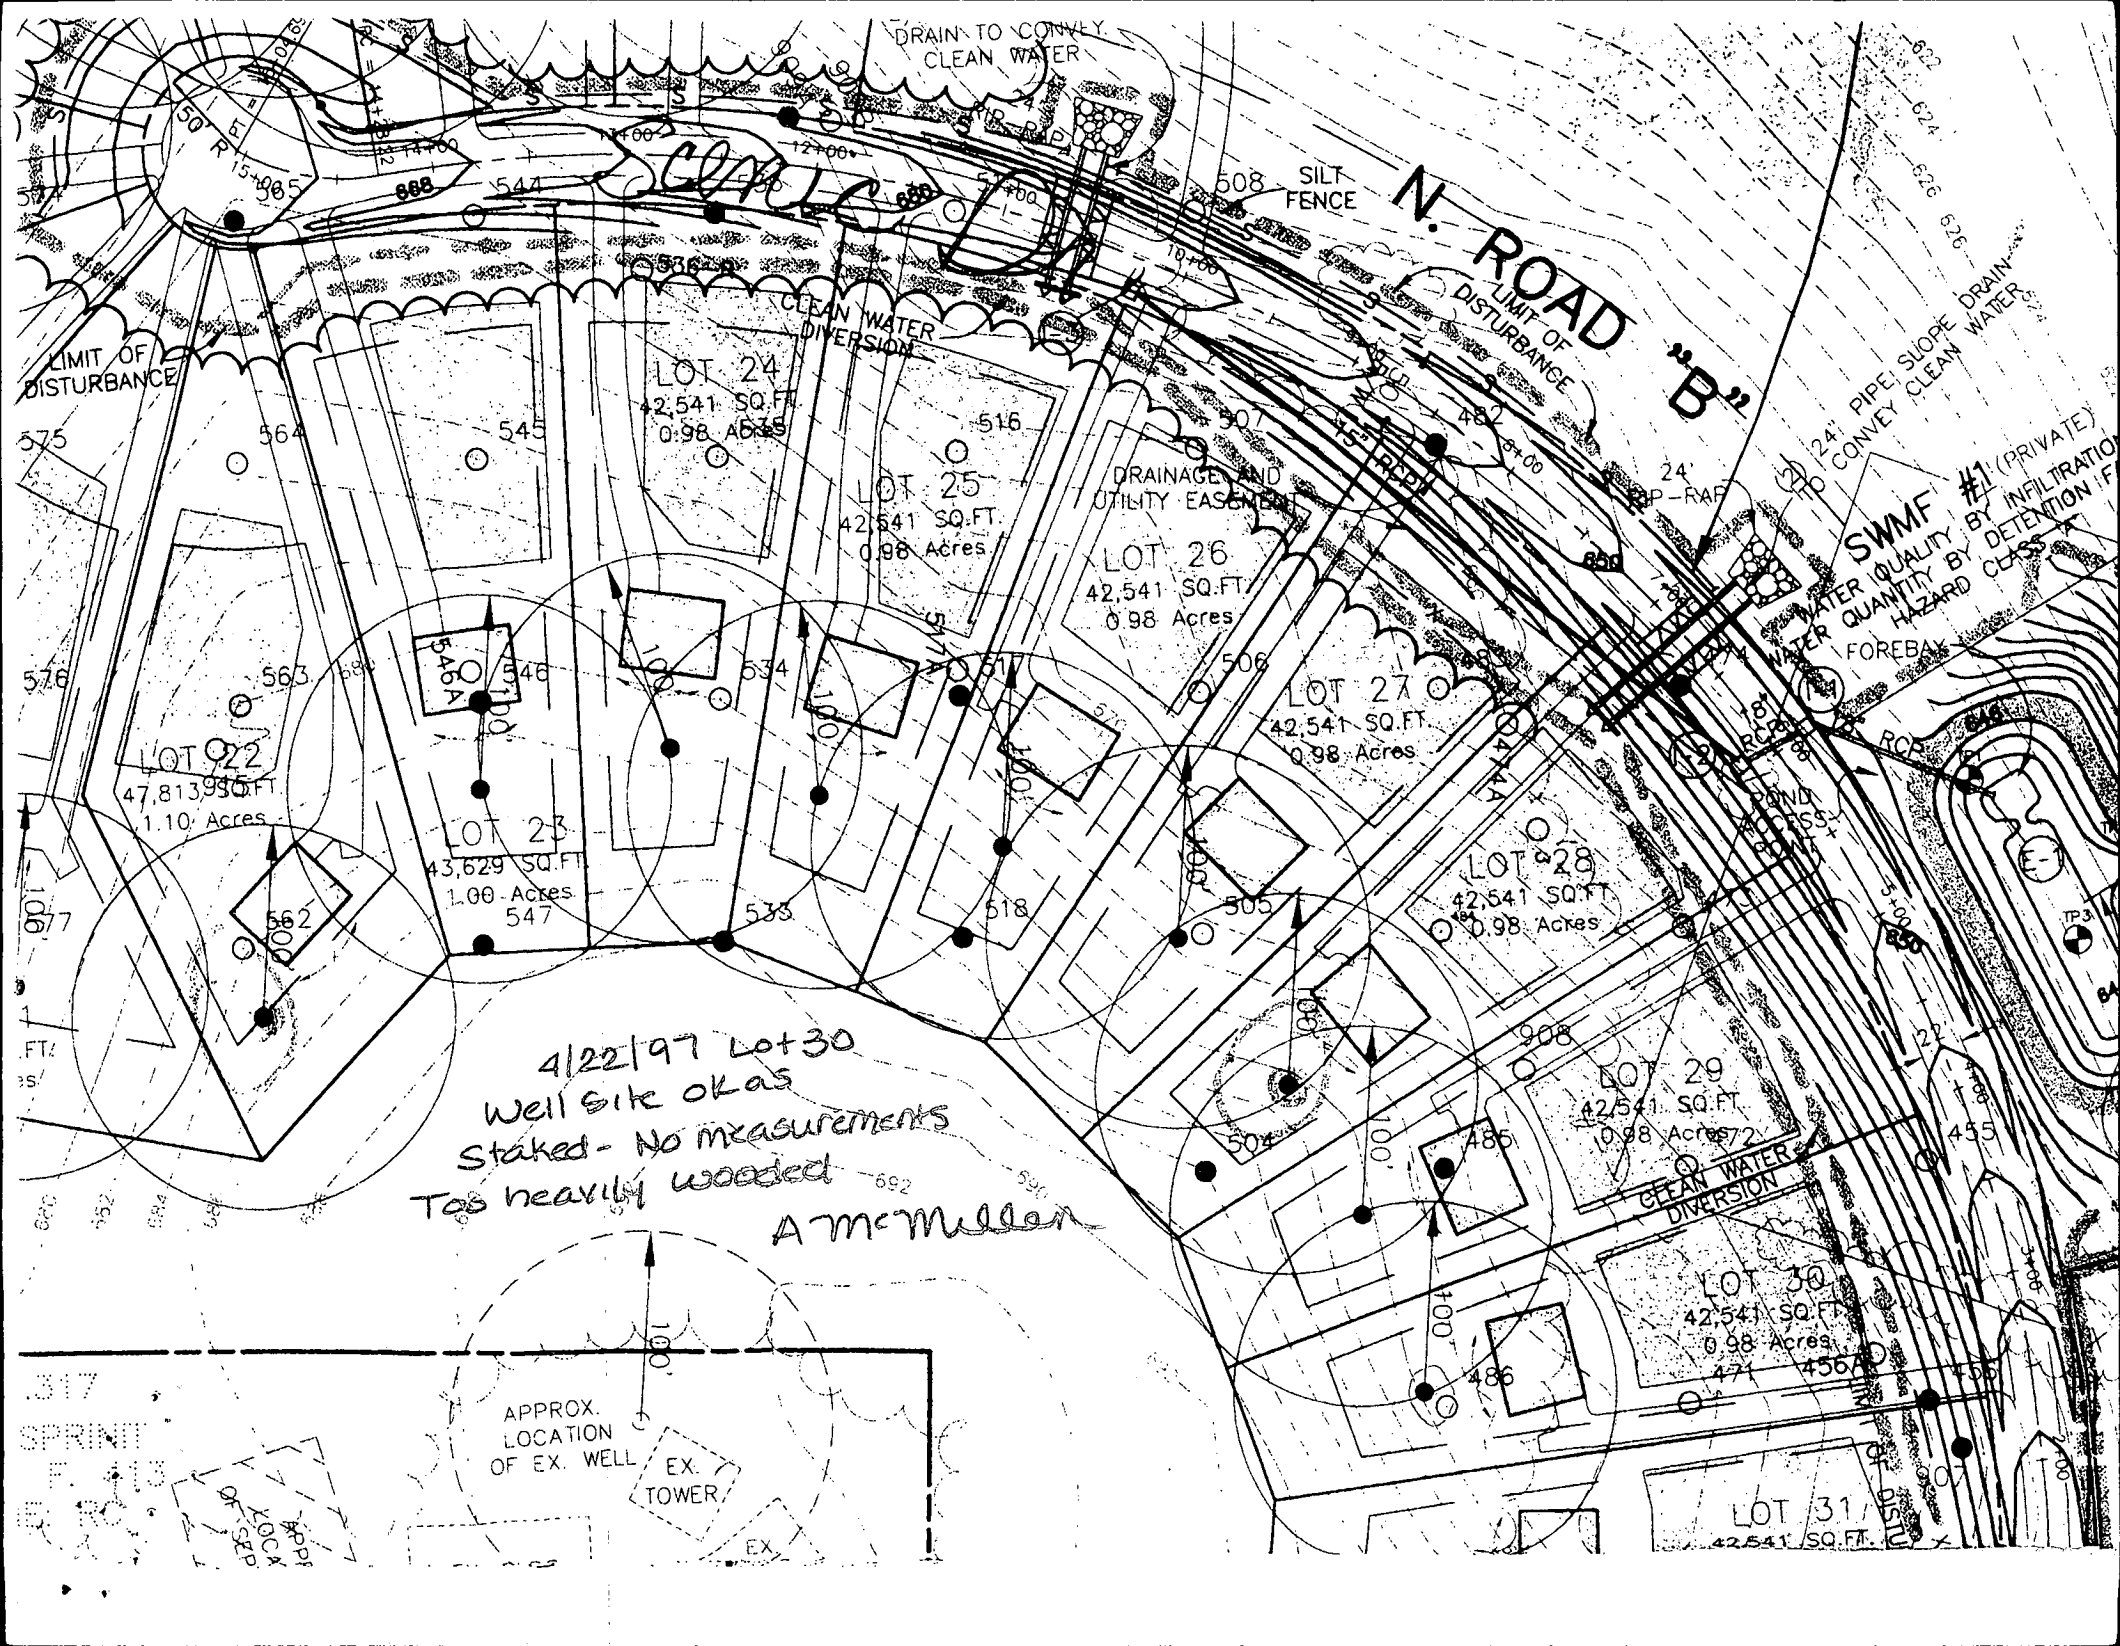

DRAIN TO CONVEY CLEAN WATER

SILT FENCE

N. ROAD "B"

24" PIPE SLOPE DRAIN TO CONVEY CLEAN WATER

SWMF #1 (PRIVATE)
WATER QUALITY BY INFILTRATION
WATER QUANTITY BY DETENTION
HAZARD CLASS

LIMIT OF DISTURBANCE

CLEAN WATER DIVERSION

DRAINAGE AND UTILITY EASEMENT

LOT 24
42,541 SQ. FT.
0.98 Acres

LOT 25
42,541 SQ. FT.
0.98 Acres

LOT 26
42,541 SQ. FT.
0.98 Acres

LOT 27
42,541 SQ. FT.
0.98 Acres

LOT 28
42,541 SQ. FT.
0.98 Acres

LOT 29
42,541 SQ. FT.
0.98 Acres

LOT 30
42,541 SQ. FT.
0.98 Acres

LOT 31
42,541 SQ. FT.
0.98 Acres

LOT 22
47,813 SQ. FT.
1.10 Acres

LOT 23
43,629 SQ. FT.
1.00 Acres

4/22/97 Lot 30
Well site OK as
Staked - No measurements
Too heavily wooded
A McMullen

APPROX. LOCATION OF EX. WELL

EX. TOWER

317
SPRINT
F. 413
E. RC

APPROX. LOCATION OF EX. WELL

1. Sand and gravel
 2. Rock and boulders
 3. 4" - 7" stone
 4. All temporary on Dept. directions
 5. Small directed drains
 6. Small directed stabilized areas
 7. All trees, brush, and disposal of
 8. The site shall be to meet the civil irregularities with
 9. Fill shall be compacted
 10. All earth removed and boulders will
 11. inspection and in
- U.S. DEPARTMENT OF
HOL. SURVEILLANCE


Lyon
1909 Sycamore
HO Co. map

B00143356

Village of
Sycamore
Enviro. Dept

42,541 S.F.

7/31/03
proposed
pool on
SRK

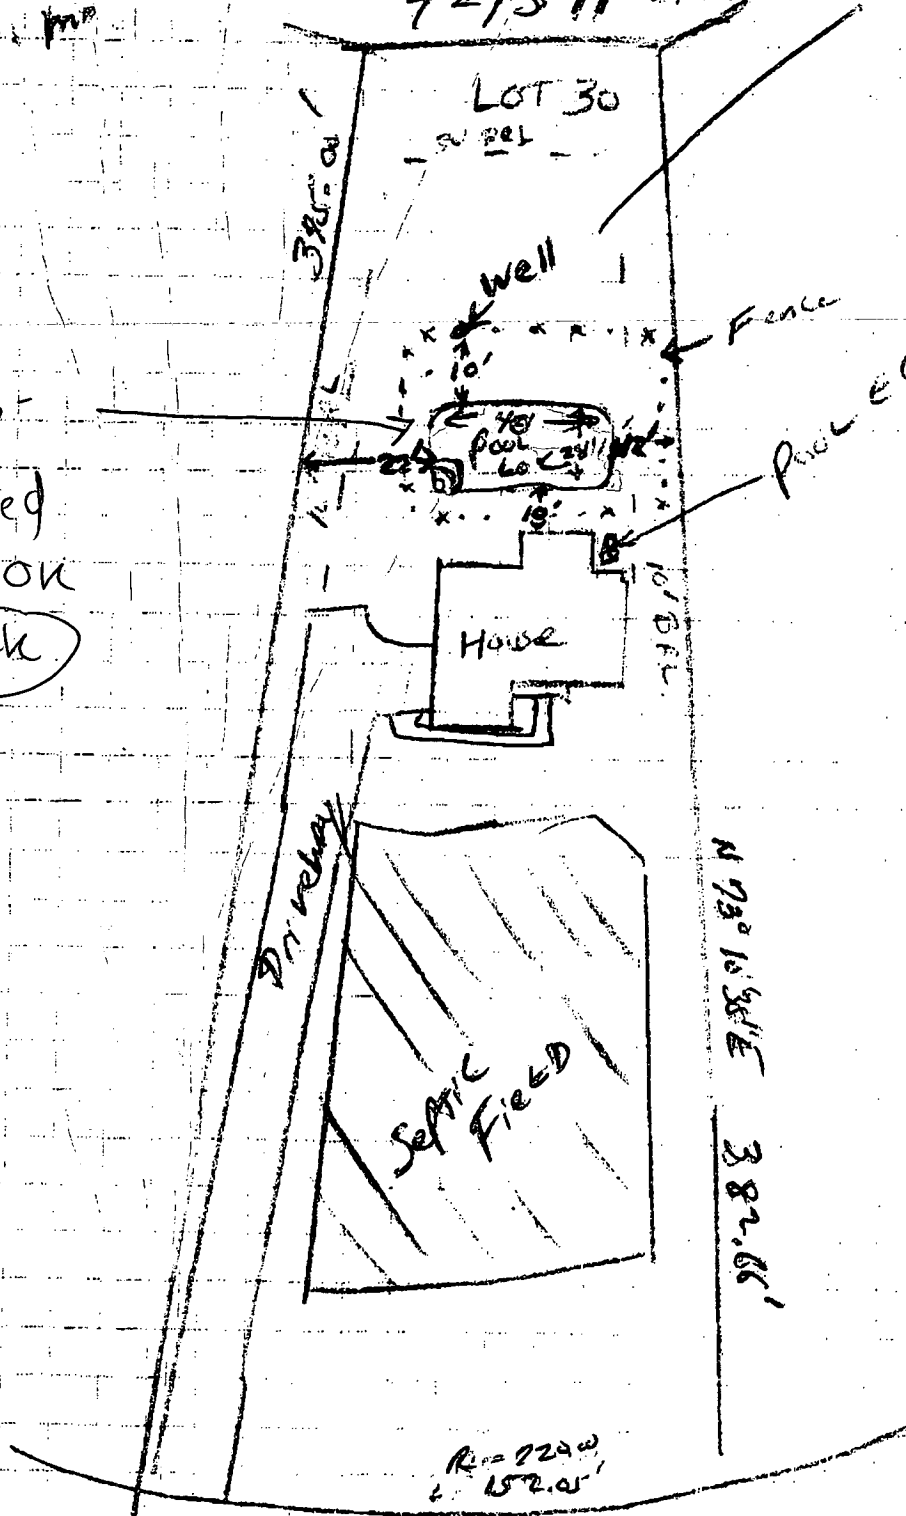

Pool 40' x 22'
Shape
T.B.D.
By Contract
Not for
Habitat,
Fence for
pool,
Dr. Filler
Lumber,
Bond
spc.

Sycamore Spring Drive

Rights in road
Lot 30

DO NOT DISCARD


July 7, 2003

Tom and Heather Lyons
1909 Sycamore Spring Court
Cooksville, MD 21723
(410) 489-9044

Steve,

I spoke with you last week about getting approval for the distance of our well to be reduced from the standard 30ft to a proposed minimum of 10ft. I have enclosed several drawings from our pool contractor. The well will be located behind a retaining wall and no chemicals or sprays will be used at or near the well site.

Thank You,

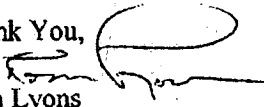
Tom Lyons

7/7/03 = Proposed ^{10'} setback is adequate,
30' well to pool setback is not in
COMAR. - (SRK)