

PERMIT

SEWAGE DISPOSAL SYSTEM

MARYLAND STATE DEPARTMENT OF HEALTH

HOWARD COUNTY

ELLICOTT CITY

DISTRICT 4

DATE 6/24/68

INDEXED
04-326598

app. 7-9-68 A50776C

P 13681

A 13438

Herman Sirk

IS PERMITTED TO INSTALL X ALTER

ADDRESS Annapolis Rock Road, Woodbine, Md. PHONE HU 9-4724

A SEWAGE DISPOSAL SYSTEM LOCATED AT

SUBDIVISION ~~Spring Meadow Road~~ ROAD 2105 Rt. 97 LOT 4

PROPERTY OWNER Wathington Ridgely

ADDRESS

SPECIFICATIONS - 3 bedrooms

DRAIN FIELD DEPTH FEET, BOTTOM AREA SQ. FT.

SEEPAGE PITS ABSORBENT SIDE-WALL AREA SQ. FT.

SEPTIC TANK CAPACITY 750 GALLONS

FOR GARBAGE GRINDER, INCREASE DISPOSAL AREA 22% & TANK CAPACITY 50%.

OTHER NO BASEMENT TOILET CAN BE INSTALLED. D.W.M.

Tile field - Use 3 trenches - 3 ft. wide - 50 ft. long and 5 ft. deep - use 2 ft.

of gravel under distributor pipe. Begin trenches 40 ft. in front of house.

Trenches to run parallel with driveway and be in area between 60 ft. and 90 ft.

from edge of driveway. * Call for inspection of trenches before gravel is installed.

PERMIT VOID AFTER THREE YEARS.

PLANS APPROVED BY D. W. Monaghan DATE 4/2/68

FILL SEPTIC TANK AND DISTRIBUTION BOX WITH WATER BEFORE CALLING FOR AN INSPECTION. COVER NO WORK UNTIL INSPECTED AND APPROVED.


NEITHER THE HOWARD COUNTY COMMISSIONERS NOR THE HEALTH DEPARTMENT IS RESPONSIBLE FOR THE SUCCESSFUL OPERATION OF ANY SYSTEM.

**NOTIFY THE HEALTH DEPARTMENT 48 HOURS
BEFORE EXCAVATIONS ARE TO BE BACK FILLED.**

A50776C
13438

150
2
0

450

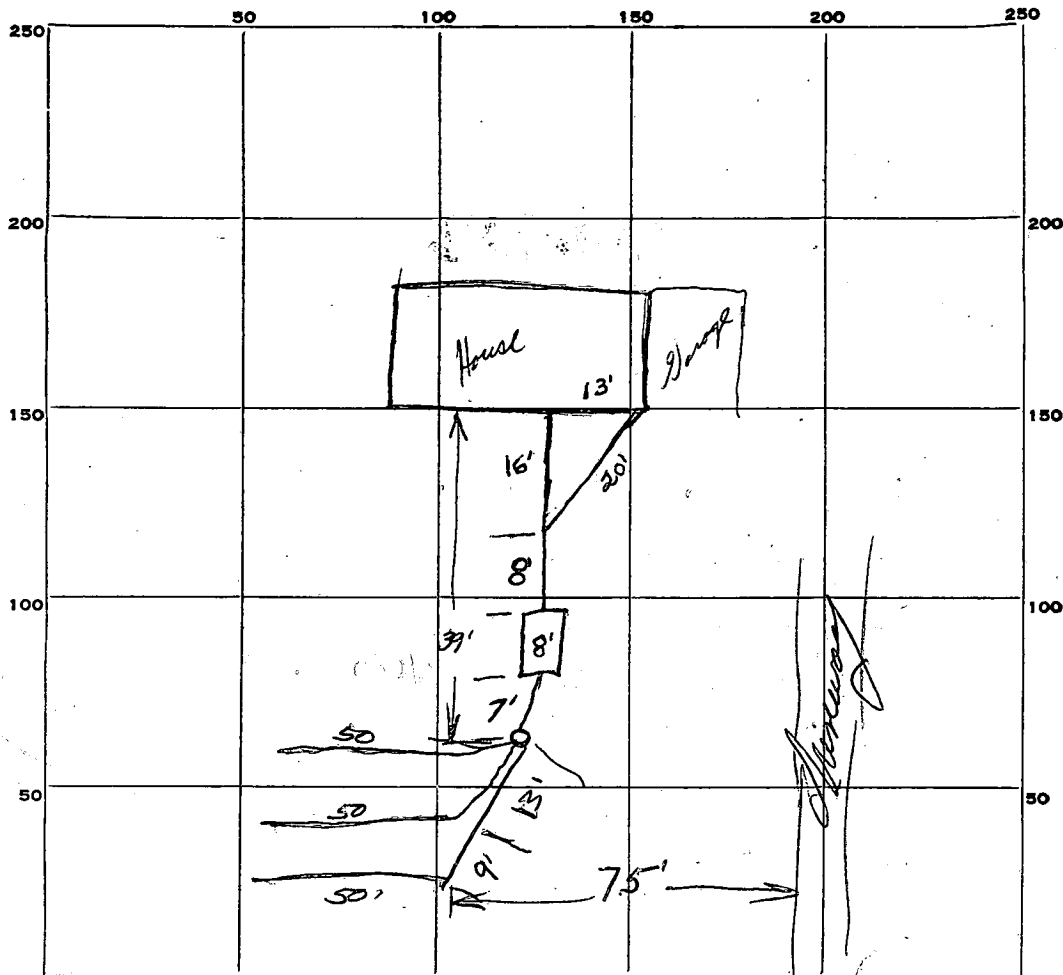

INDICATE NORTH. - NAME ADJOINING ROADWAY AS BASE LINE.

Route 99.

PERMIT CARD ☒

SEPTIC TANK, LEVEL OK CLEANOUTS OK

DISTRIBUTION BOX, LEVEL OK (baffle skewed to lowest trench)

TILE FIELD, DEPTH 5 to 5 1/2 FT. TRENCH WIDTH 3 FT.

GRAVEL DEPTH 3 ft IN. TOTAL LENGTH 150 FT.

NUMBER OF TRENCHES 3 TOTAL BOTTOM AREA 450

SEEPAGE PITS, INSIDE DIAMETER _____ FT. DEPTH BELOW INLET _____ FT.

ABSORBENT AREA _____ SQ. FT.

REMARKS 7/9/68 - trenches 5 to 5 1/2 ft deep - 2 ft gravel under
pipes - giving 600 additional sq ft of side small area

DATE SYSTEM APPROVED 7/9/68 INSPECTOR Steve M. Long

APPLICATION

A 13438

P _____

SEWAGE DISPOSAL TESTING

MARYLAND STATE DEPARTMENT OF HEALTH

HOWARD COUNTY

ELLICOTT CITY

4/2/68 - no basement toilet can be
installed here

DISTRICT 4

DATE 3/5/68

Septic Tank - 750 gal.

Tell Field - in 3 trenches 3 ft wide - 50 ft long and 5 ft
deep - in 2 ft of 7 inch inside diameter pipe.

Begin Trenches 40 ft in front of house. Trenches to run
parallel with driveway and be 60 ft apart
90 ft from edge of driveway.

TO: THE COUNTY HEALTH OFFICER:
ELLICOTT CITY, MARYLAND

with 10' separation of trenches before gravel is
installed.

I, HEREBY, APPLY FOR THE NECESSARY TESTS IN ORDER TO CONSTRUCT (OR RECONSTRUCT) A SEWAGE
DISPOSAL SYSTEM.

PROPERTY OWNER Worthington B. Ridgely

ADDRESS Cooksville, Maryland PHONE HU 9-4546

PROPERTY LOCATION:

SUBDIVISION _____ LOT NO. _____

ROAD AND DESCRIPTION Rt. 97 - 1/2 mile so. of blinking light at Rt. 97 & Rt. 144
left hand side of drive way

OCCUPANT _____ PHONE _____

PERSON TO CONSTRUCT SYSTEM _____

ADDRESS _____ PHONE _____

SIZE OF LOT 250 acres TYPE BLDG. 3

(Single Family Dwllg.)

IF NOT SINGLE RESIDENCE DESCRIBE _____

SIGNATURE OF APPLICANT Worthington Ridgely

APPROVED BY Donald W. Monney FOR Tell Fields (deep) DATE 4-2-68

(KIND OF SYSTEM)


REJECTED BY _____ FOR _____ DATE _____

(KIND OF SYSTEM)

HOLD PENDING FURTHER TESTS _____ DATE _____

REASONS FOR REJECTION OR HOLDING _____

THIS IS NOT A PERMIT

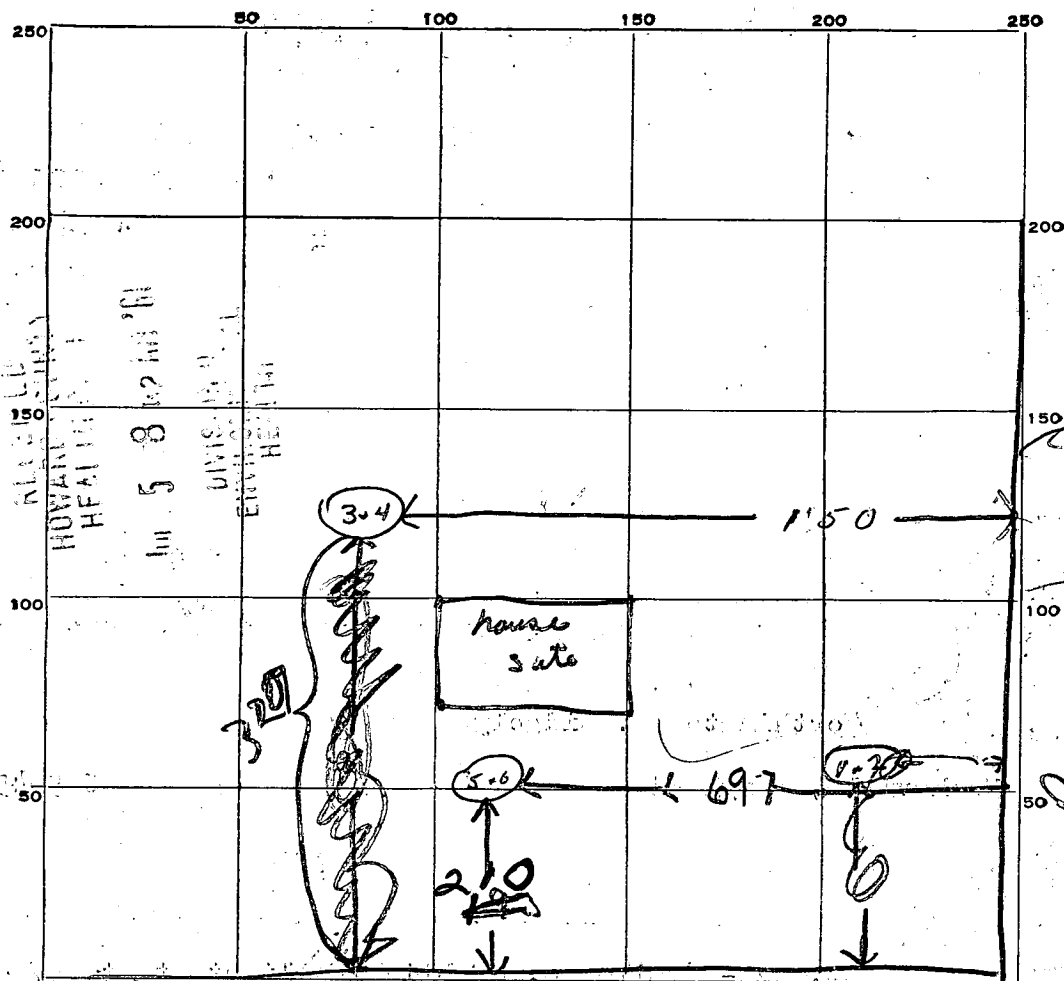

~~to Cooksville~~ Route 97

DATE	TEST NO.	DEPTH	PRE-WET		TEST - 1" DROP		TIME
			START	STOP	START	STOP	
4/2/68	1	12 ft.	10 ²⁹	} stop test - 5 pump perc			
	2	4 1/2	10 ³⁴				
	3	11 ft.	10 ⁴⁸	11 ⁰⁰	11 ⁰⁰	11 ²⁵	25 min
	4	10 ft.	10 ⁵³	10 ⁵⁹	10 ⁵⁹	11 ¹⁷	18 min
	5	11 ft.	11 ⁰⁴	11 ¹⁵	11 ¹⁵	11 ⁴⁰	25 min
	6	4 1/2	11 ⁰⁷	11 ⁰⁸	11 ⁰⁸	11 ¹⁷	9 min

SOIL AUGER FINDING

TESTED BY.

REMARKS

APPLICATION MUST BE SUBMITTED AND PERMIT RECEIVED BEFORE DRILLING IS STARTED.

State Office Building
ANNAPOLIS, MARYLAND 21401

DEPARTMENT OF
WATER RESOURCES

APPLICATION FOR PERMIT TO DRILL WELL

No. 2124

Owner John Ridgley
Street or R. F. D. Cooksville
Post Office RT 97
Quantity of Water to be Produced 5 Gallons Per Minute
Total Quantity Needed For Use 500 Gallons Per Day
Use for Water House
Approximate Depth of Well (feet) 100
Method of Drilling to be used Rotary
Is this a Replacement Well? Yes - No
If YES, indicate date abandoned well is to be sealed: _____
and by whom: _____

PERMIT TO DRILL WELL
(Not To Be Filled In By Driller)

Well Permit No. HO-68-W-248

Samples of Cuttings Required by Department: ☒ Yes ☐ No
Owner Requires Permit to Appropriate Water: ☒ Yes ☐ No
Owner Has Permit to Appropriate Water: ☒ Yes ☐ No

Appropriation Permit No. _____

The applicant is herewith granted a permit to drill this well subject to the conditions stipulated.

Paul W. McKee may 6-12-68
Director Date

THIS PERMIT IS NOT TRANSFERABLE
WITHOUT WRITTEN PERMISSION FROM THE DEPARTMENT
Special conditions that must be observed:

Health Department Approval of Application

Howard

County Department of Health

or ☐ State Department of Health


Approved by J. Fumelle

Title Sanitarian III

Date 6/10/68

Driller L. J. Easterday License Number 72
Street or R. F. D. mt air
Post Office mt air
Date June 7
Location of Well County Howard
Subdivision _____
Section _____ Lot _____
Nearest Town Cooksville
Distance from Town 1 mile
Direction from Town South
Description of Location of Well
(This information MUST BE ACCURATE and should be definite enough to permit locating well on a county map).
Near what road RT 97
On which side of road ✓
(North, East, South, West)
Distance from road 500 ft

Draw a sketch below showing location of well in relation to nearby towns, roads and streams with north in the direction of the arrow, and give distance from well to nearest road junction or stream crossing shown on the sketch. Distances may be approximate, but must be indicated.

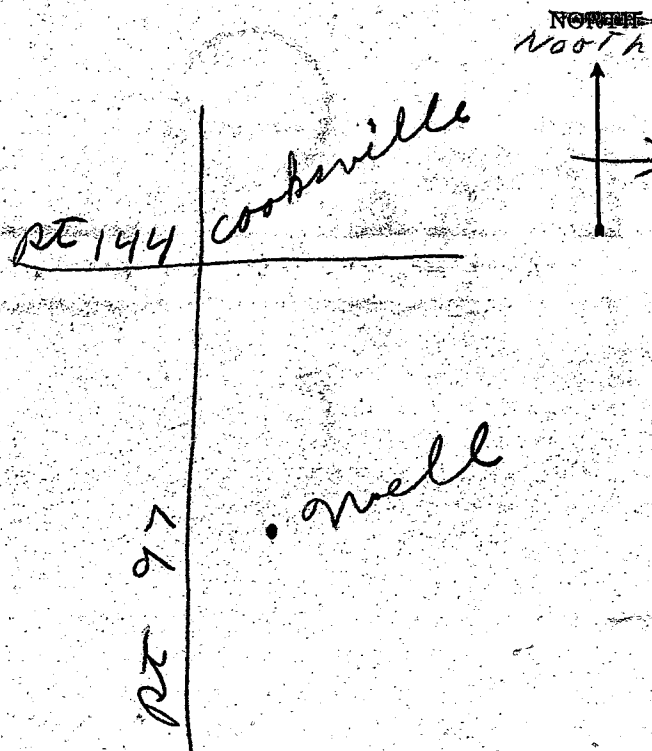

THIS REPORT
MUST BE SUBMITTED
WITHIN 30 DAYS
AFTER COMPLETION
OF THE WELL

WELL COMPLETION REPORT

WELL DESCRIPTION

A WELL LOG

State the kind of formations penetrated, their color, their depth, their thickness, and if water-bearing

B CASING AND SCREEN RECORD

State the kind and size and position of casing, liner, shoe, screen, and other accessories (if no casing used, give diameter of well).

FEET
from ___ to ___

DIAM.
(inches)

FEET
from ___ to ___

Top Soil
Sandy
Sand Rock
Heavy Rock

0-3
3-55'
55-80
80-200

Steel

6 1/4 ID

0-63

water 80 + 160

Permit Number HO-68-W-248

Owner John Ridgely

Address Croftsville

Subdivision _____

Section _____ Lot _____

County Permit Number _____

PUMPING TEST

Hours Pumped 1 hr.

Type of Pump Used sur

Pumping Rate 200 GPM

Gallons per Minute _____

WATER LEVEL

(Distance from land surface to water)

Before Pumping 40 Ft.

When Pumping 200 Ft.

APPEARANCE OF WATER

Clear _____ Cloudy _____

Taste _____

Odor _____

Height of Casing Above Land

Surface 2 above Ft.

PUMP INSTALLED

Type _____

Capacity _____


Gallons per Minute _____

Gallons per Hour _____

Pump Column Length _____ Ft.

LOCATION OF WELL ON LOT

Show permanent structures such as building(s), septic tank, and/or other landmarks and indicate not less than 2 distances (measurements) to well.

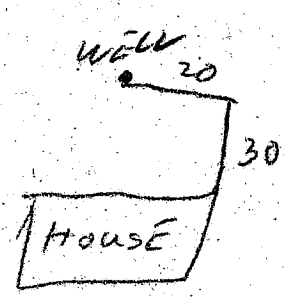

DATE
WELL WAS
COMPLETED

I hereby affirm that this report contains no willful misrepresentations or falsifications and that information given in this report is true, accurate and complete to the best of my knowledge and belief.

George F. Easterday Well Driller

7-8-68

Well Driller License No.: 77

NORTH

97

SPRING MEADOW FARM
PROP. LOT 1
1.00 AC.
PLAT #95-78

AND 9590



R=4527.80 L=213.96

GARY W. RIDGELY
2017/658
HERBERT WAYNE W.
RIDGELY

425.32

125.67

N78°51'17"W

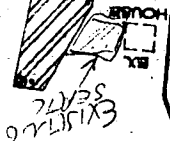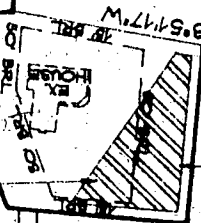

10,000 SQ. FT.
SEPTIC AREA
FOR RESIDUE

EX
BARN

10,000 SQ. FT.
SEPTIC AREA

578°49'05"E
214.50

S87°24'05"E 552.73

W.W.B. RIDGELY III AND STEPHEN R. RIDGELY
2017/674

N26°49'08"E

777.72

N28°29'18"E 249.22

N74°53'39"E

46

20' PRIVATE
ACCESS EASEMENT
OVER EX. DRIVE
FOR LOTS 1 AND 2

SPRING MEADOW FARM
PROP. LOT 2
1.00 AC.
PLAT #96-38