

6/1/94
ASAP
#12,30

PERMIT

SEWAGE DISPOSAL SYSTEM

DEPARTMENT OF HEALTH AND MENTAL HYGIENE

HOWARD COUNTY HEALTH DEPARTMENT

BUREAU OF ENVIRONMENTAL HEALTH

~~461-9933~~ 313-2640

INDEXED

P 50067

A REPAIR

DISTRICT _____

DATE 6/6/94

DATE SYSTEM APPROVED 6/1/94

INSPECTOR C.B. H

Jenkins Brothers

IS PERMITTED TO INSTALL _____ ALTER X

ADDRESS 7670 Smith's Private Road, Sykesville, Maryland 21784 PHONE 461-9282

SUBDIVISION _____ LOT 3 ROAD 630 River Road

PROPERTY OWNER Codd
630 River Road

ADDRESS _____

SEPTIC TANK CAPACITY _____ GALLONS (Existing)

NUMBER OF BEDROOMS 3

120 SQUARE FEET PER BEDROOM +(old dry well)

LINEAR FEET OF TRENCH REQUIRED 60'

REPAIR - PURPOSE - SEPTIC SYSTEM HAS FAILED - DRYWELL IS FULL. Trench 4 1/2' x 6' x 23'

Call for inspection when ground is opened so sanitarian can recommend repair. -5/31/94

off dry well with new trench
Trench 2 1/2' wide, 10 1/2' deep, 6" of stone under pipe
60' Long; 360 sq. ft. plus old dry well

PLANS APPROVED BY C.B.H. for C.W. in field DATE 6/1/94

COVER NO WORK UNTIL INSPECTED AND APPROVED

NEITHER THE HOWARD COUNTY COUNCIL NOR THE HEALTH DEPARTMENT IS RESPONSIBLE FOR THE SUCCESSFUL OPERATION OF ANY SYSTEM

NOTE: CLEANOUT REQUIRED EVERY 70 FEET OF SEWER LINE AND/OR AT 90° SWEEPS IN LINES FROM HOUSE TO DRAIN FIELDS, 90° ELBOWS NOT ACCEPTABLE.

NOTE: ALL PARTS OF SEPTIC SYSTEMS (I.E. TANK, DISTRIBUTION BOX TRENCHES) TO BE 100 FEET FROM WELL (UNLESS OTHERWISE SPECIFICALLY AUTHORIZED)

NOTE: IF DEEP TRENCH(ES) ARE USED CALL FOR INSPECTION BEFORE AND AFTER PLACING GRAVEL IN TRENCH(ES)

NOTE: NO DRY WELL SHALL EXCEED 15 FOOT IN DIAMETER NO ABSORPTION TRENCH TO EXCEED 100 FEET IN LENGTH

NOTE: ALL PIPE FROM HOUSE TO SEPTIC TANK MUST BE CAST IRON OR SCHEDULE 35/40 PVC OR ABS


PERMIT VOID AFTER TWO YEARS

NOTE: INSTALL STAND PIPE ON SEPTIC TANK AND DRY WELL STAND PIPES MUST BE 6 INCHES IN DIAMETER CAST IRON. CONCRETE OR TERRA COTTA OR PVA OR ABS ACCEPTED. IF TOP OF SEPTIC TANK IS DEEPER THAN 3 FEET. MANHOLE TO GRADE REQUIRED.

NOTE: DISTRIBUTION BOXES MUST HAVE BAFFLES

***INSTALLER IS RESPONSIBLE FOR OBTAINING FINAL APPROVAL ON THIS PERMIT**

R 50067

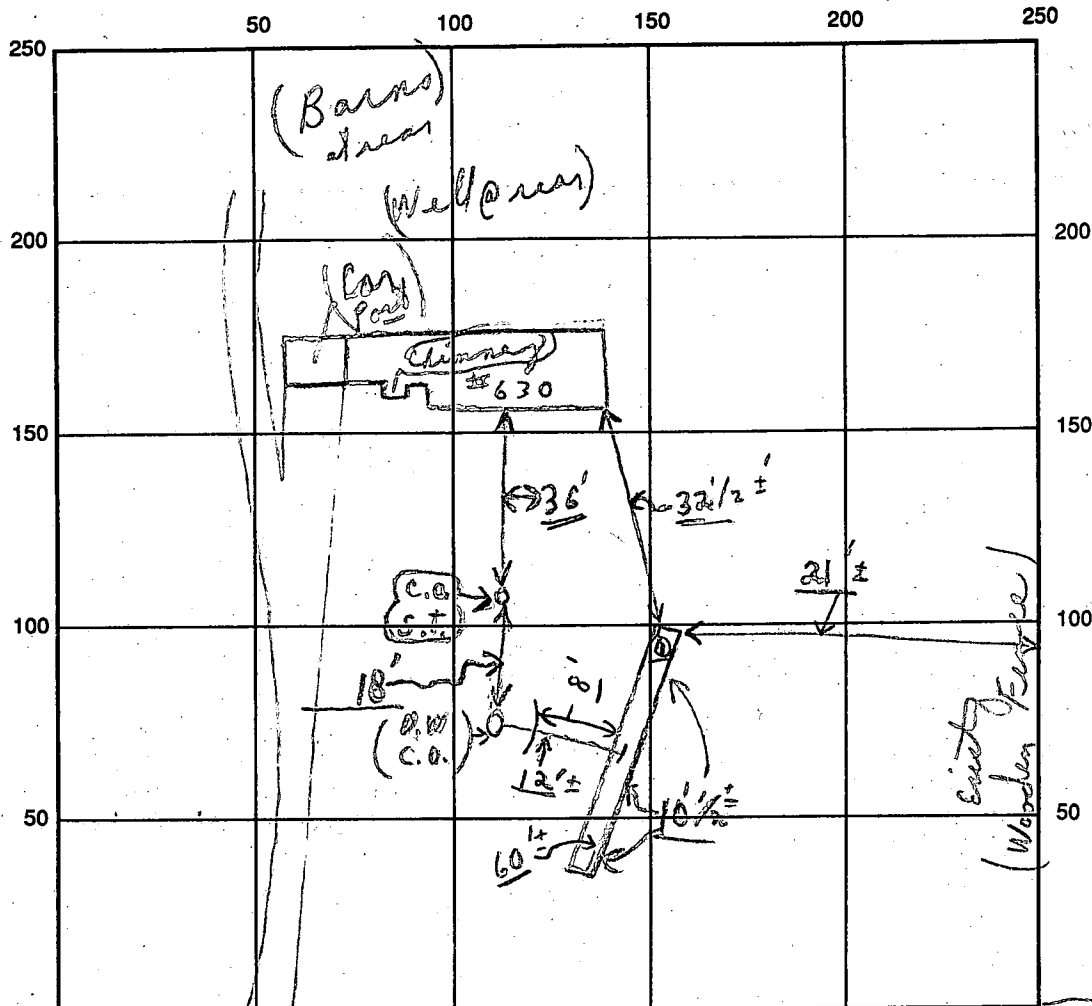

INDICATE NORTH - NAME ADJOINING ROADWAY AS BASE LINE

SEPTIC TANK LEVEL Existing CLEANOUTS Existing / P.W.
 DISTRIBUTION BOX LEVEL Note - (Main) - existing dry well
 DRAIN FIELD/TITLE DEPTH 10 1/2 FT. TRENCH WIDTH 2 1/2 FT. INLET DEPTH 4 1/2 FT.
 EFFECTIVE GRAVEL DEPTH 6 FT. TOTAL LENGTH 60 FT.
 NUMBER OF TRENCHES 1 ONE SIDEWALL / ~~BOTTOM~~ AREA 360 SQ. FT. (plus old dry well)
 DRYWALL INSIDE DIAMETER — FT. EFFECTIVE DEPTH BELOW INLET — FT.
 ABSORBENT AREA 360 SQ. FT. (plus old dry well)

REMARKS: 6/1/94 OK for above in trench - only. C.B.
P.M. - Final - OK to cover all work. C.B.

DATE SYSTEM APPROVED 6/1/94 INSPECTOR Charles Bryan Stricker

APPLICATION

PERCOLATION TESTING

A 49345

P _____

HOWARD COUNTY HEALTH DEPARTMENT
BUREAU OF ENVIRONMENTAL HEALTH
3525-H ELLICOTT MILLS DRIVE/ELLICOTT CITY, MARYLAND 21043
TELEPHONE: 313-2640

PREVIEW OK
PROPOSED SUBD.
OCCUPIED RESIDUE PARCEL
9 25 REPAIR FEB ONLY,
(CW)

DISTRICT _____

DATE 6/8/93

TO: THE COUNTY HEALTH OFFICER
ELLICOTT CITY, MARYLAND

I HEREBY APPLY FOR THE NECESSARY TEST PRIOR TO APPLICATION FOR PERMIT TO CONSTRUCT (OR RECONSTRUCT) A SEWAGE DISPOSAL SYSTEM.

PROPERTY OWNER Mr. William T. CODD & WIFE

ADDRESS 630 RIVER ROAD SYKESVILLE PHONE _____

MD. 21784

AGENT OR PROSPECTIVE BUYER FISHER COLLINS and Carter INC. c/o Zach Fisch

ADDRESS 4171 Baltimore national pike PHONE 461-2855

ELLICOTT CITY MD. 21042

PROPERTY LOCATION:

SUBDIVISION CODD PROPERTY LOT NO. 3 (EXISTING HOUSE)

ROAD AND DESCRIPTION 630 RIVER ROAD [Note Repair 6/1/94]

TAX MAP 4 PARCEL # 11

SIZE OF LOT 3.11 AC. ± TYPE BLDG. S.F.D.
(SINGLE FAMILY DWELLING OR COMMERCIAL)

THE SYSTEM INSTALLED UNDER THIS APPLICATION IS ACCEPTABLE ONLY UNTIL PUBLIC FACILITIES BECOME AVAILABLE. I FULLY UNDERSTAND THE

FEE CONNECTED WITH THE FILING OF THIS PERC TEST APPLICATION IS NON-REFUNDABLE UNDER ANY CIRCUMSTANCES. I ALSO AGREE TO

COMPLY WITH ALL M.O.S.H.A. REQUIREMENTS IN TESTING THIS LOT. Zacharin Y. Fisch (agent)

(SIGNATURE OF APPLICANT)

APPROVED BY (already) -> Existing home & system of 1/2 inch hole 7/20/93 FOR _____ DATE _____

DISAPPROVED BY _____ FOR _____ DATE _____

HOLD PENDING FURTHER TESTS _____

REASONS FOR REJECTION OR HOLDING Revised perc plat 7/20/93 C.B.

PERCOLATION TEST PLAT/PRELIMINARY PLAT - TITLE OR I.D. # _____ DATE _____

SITE DEVELOPMENT PLAN/FINAL PLAT - TITLE OR I.D. # _____ DATE _____

THIS IS NOT A PERMIT

A49345

COUNTY #

LOT #3

SOIL PROFILE

Hole ①

0' to 5'

Clay

5' to

Sandy
Loam

14'

to

bottom

Hole ②

0' to 1'

Clay

to

bottom


Hole ③

0' to

Clay

to

bottom

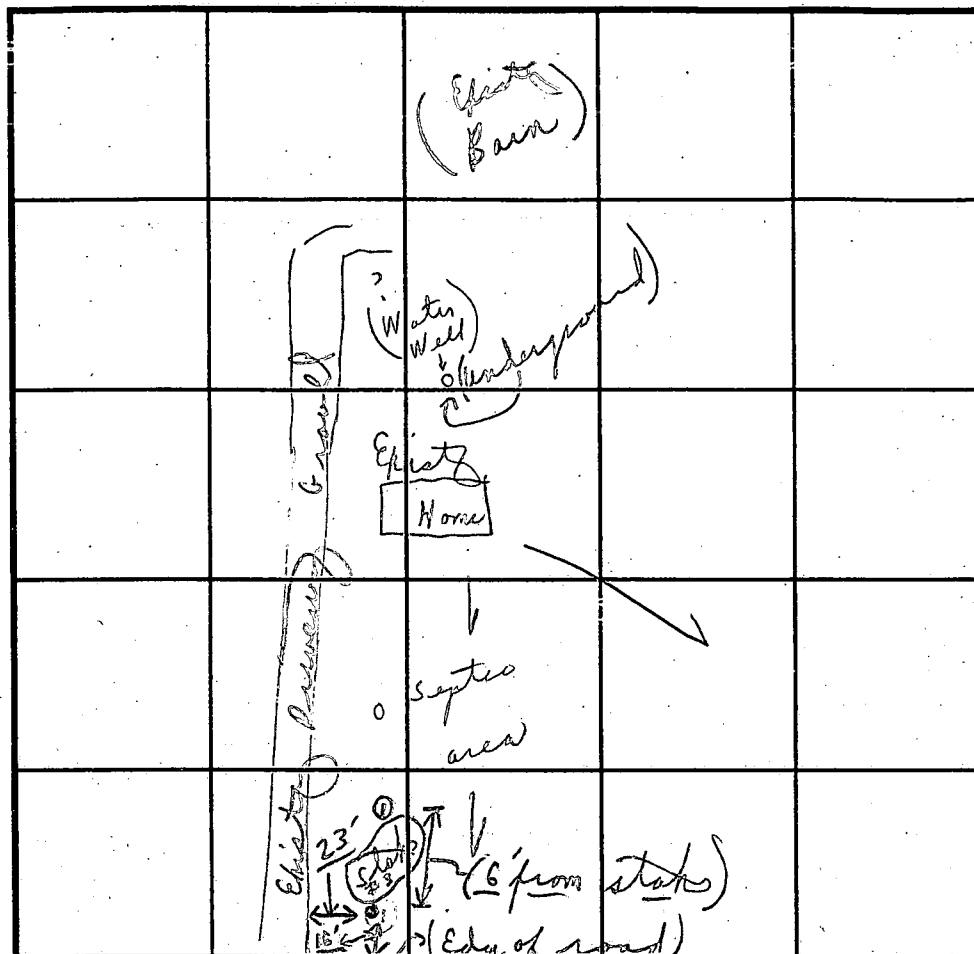

INDICATE NORTH - NAME ADJOINING ROADWAY AS BASE LINE.

River Road

DATE	TEST NO.	DEPTH	PRE-WET		TEST - 1" DROP		TIME
			START	STOP	START	STOP	
7/20/93	1	14'					
		dry	0' - 5' Clay (Loam Reddish)				
	2	N/A					
	3	dry					
	4	N/A					
	5	dry					
	6	N/A					
	7	dry					

REMARKS Visual test in front lawn (Hole 1) VisualTYPE OF SOIL Loam below clayTESTED BY C.B.D. ALSO PRESENT O. KetterTRENCH DESIGN DATA: AVERAGE PERCOLATION TIME TRENCH WIDTH INLET DEPTH MAXIMUM BOTTOM DEPTH SQ. FT./BEDROOM (Existing system - no problem)
or check

SOIL PROFILE

Hole ④


0' to 1'

Clay

to

bottom

Fence

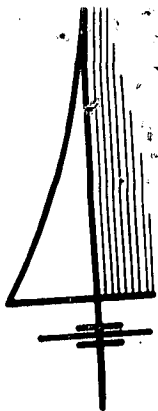

PROPERTY OF
LAURETTE E. METTEE
BOYD N. METTEE
1008/683

N46°54'57"W
83.69'

EX DWELLING

EX DWELLING

RIVER

425.00'

475

804.00'



F/R 4

LOT #1
140,406#
(3.22 AC.)

#630
EX DWELLING
TO REMAIN

EX WELL


EX DRIVEWAY

LOT #3
135,316#
(3.11 AC.)

EX BARN
TO REMAIN

EX FENCE

EX FENCE TO BE
RELOCATED

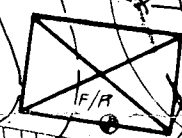

LOT #2
151,663#
(3.48 AC.)

N19°19'00"E
905.70'

E81°3,500
N55°3,000

PROPERTY OF
DARLENE WISNIEWSKI
RICHARD WISNIEWSKI
972/649

W-783-3396
#-374-5403

Our copy
does not have H.O. sig
on it

PROPERTY OF
SHIRLEY O'HALL
FRANCIS O'HALL
848/510