

PERMIT

SEWAGE DISPOSAL SYSTEM

DEPARTMENT OF HEALTH AND MENTAL HYGIENE

P 50068

A REPAIR

DISTRICT _____

DATE 06/06/94

HOWARD COUNTY HEALTH DEPARTMENT

BUREAU OF ENVIRONMENTAL HEALTH

XX461993XX 313-2640

DATE SYSTEM APPROVED _____

INSPECTOR _____

INDEXED

351316

A Company Home Improvement Contractors IS PERMITTED TO INSTALL _____ ALTER ☒ X

ADDRESS 4415 Falls Road, Baltimore, Maryland 21211-1225 PHONE 235-4010

SUBDIVISION _____ LOT _____ ROAD 4888 Ten Oaks Road

PROPERTY OWNER Mr. and Mrs. Lee Grant

ADDRESS 4888 Ten Oaks Road
Dayton, Maryland 21036

SEPTIC TANK CAPACITY _____ GALLONS

NUMBER OF BEDROOMS _____

_____ SQUARE FEET PER BEDROOM

LINEAR FEET OF TRENCH REQUIRED _____

REPAIR - PURPOSE - NEEDS REPAIR TO PROVIDE SEPTIC CAPACITY FOR TWO UNITS. (BUILDING PERMIT 54007)

Call for inspection when ground is opened so sanitarian can recommend repair. 06/06/94

6/23/94 NO REPAIR INSTALLATION THIS DATE ONLY TESTING
FOR ESTABLISHMENT OF REPAIR AREA MR

6/29/94 SEE FAX THIS DATE FOR DEFINITION OF SEPTIC
REPAIR AREA NO TESTS/OTHER WORK DONE ON THIS PERMIT
MR

PLANS APPROVED BY _____ DATE _____

COVER NO WORK UNTIL INSPECTED AND APPROVED

NEITHER THE HOWARD COUNTY COUNCIL NOR THE HEALTH DEPARTMENT IS RESPONSIBLE FOR THE SUCCESSFUL OPERATION OF ANY SYSTEM

NOTE: CLEANOUT REQUIRED EVERY 70 FEET OF SEWER LINE AND/OR AT 90° SWEEPS IN LINES FROM HOUSE TO DRAIN FIELDS, 90° ELBOWS NOT ACCEPTABLE.

NOTE: ALL PARTS OF SEPTIC SYSTEMS (I.E. TANK, DISTRIBUTION BOX TRENCHES) TO BE 100 FEET FROM WELL (UNLESS OTHERWISE SPECIFICALLY AUTHORIZED)

NOTE: IF DEEP TRENCH(ES) ARE USED CALL FOR INSPECTION BEFORE AND AFTER PLACING GRAVEL IN TRENCH(ES)

NOTE: NO DRY WELL SHALL EXCEED 15 FOOT IN DIAMETER NO ABSORPTION TRENCH TO EXCEED 100 FEET IN LENGTH

NOTE: ALL PIPE FROM HOUSE TO SEPTIC TANK MUST BE CAST IRON OR SCHEDULE 35/40 PVC OR ABS

PERMIT VOID AFTER TWO YEARS

NOTE: INSTALL STAND PIPE ON SEPTIC TANK AND DRY WELL STAND PIPES MUST BE 6 INCHES IN DIAMETER CAST IRON. CONCRETE OR TERRA COTTA OR PVA OR ABS ACCEPTED. IF TOP OF SEPTIC TANK IS DEEPER THAN 3 FEET. MANHOLE TO GRADE REQUIRED.

NOTE: DISTRIBUTION BOXES MUST HAVE BAFFLES

*INSTALLER IS RESPONSIBLE FOR OBTAINING FINAL APPROVAL ON THIS PERMIT

HD-260(6-90)

*CALL 461-9933 FOR INSPECTION OF SEPTIC SYSTEM.

50068

	50	100	150	200	250
250					
200					200
150					150
100					100
50					50

INDICATE NORTH - NAME ADJOINING ROADWAY AS BASE LINE

SEPTIC TANK LEVEL _____ CLEANOUTS _____

DISTRIBUTION BOX LEVEL _____

DRAIN FIELD/TITLE DEPTH _____ FT. TRENCH WIDTH _____ FT. INLET DEPTH _____ FT.

EFFECTIVE GRAVEL DEPTH _____ FT. TOTAL LENGTH _____ FT.

NUMBER OF TRENCHES _____ ONE SIDEWALL/BOTTOM AREA _____ SQ. FT.

DRYWALL INSIDE DIAMETER _____ FT. EFFECTIVE DEPTH BELOW INLET _____ FT.

ABSORBENT AREA _____ SQ. FT.

REMARKS: _____

DATE SYSTEM APPROVED _____ INSPECTOR _____

6-23-94
10:00am

APPLICATION

PERCOLATION TESTING

A Repair
P _____

HOWARD COUNTY HEALTH DEPARTMENT
BUREAU OF ENVIRONMENTAL HEALTH
3525-H ELLICOTT MILLS DRIVE/ELLICOTT CITY, MARYLAND 21043
TELEPHONE: 313-2640

DISTRICT _____
DATE _____

TO: THE COUNTY HEALTH OFFICER
ELLICOTT CITY, MARYLAND

I HEREBY APPLY FOR THE NECESSARY TEST PRIOR TO APPLICATION FOR PERMIT TO CONSTRUCT (OR RECONSTRUCT) A SEWAGE DISPOSAL SYSTEM.

PROPERTY OWNER Lee Grant

ADDRESS 4888 Ten Oaks Road PHONE 531-2514

AGENT OR PROSPECTIVE BUYER same Dayton 21036

ADDRESS _____ PHONE _____

PROPERTY LOCATION:

BLDG. PERMIT SIGNED
AND RETURNED 6/29/94
Serial # 54707 - addition

SUBDIVISION _____ LOT NO. _____

ROAD AND DESCRIPTION 4888 Ten Oaks Road

TAX MAP _____ PARCEL # _____

SIZE OF LOT _____

2 bdrm SFD w/ Apartment
TYPE BLDG. _____
(SINGLE FAMILY DWELLING OR COMMERCIAL)
Existing older home
+ water well
+ septic

THE SYSTEM INSTALLED UNDER THIS APPLICATION IS ACCEPTABLE ONLY UNTIL PUBLIC FACILITIES BECOME AVAILABLE. I FULLY UNDERSTAND THE
FEE CONNECTED WITH THE FILING OF THIS PERC TEST APPLICATION IS NON-REFUNDABLE UNDER ANY CIRCUMSTANCES. I ALSO AGREE TO
COMPLY WITH ALL M.O.S.H.A. REQUIREMENTS IN TESTING THIS LOT.

(SIGNATURE OF APPLICANT)

APPROVED BY _____ FOR _____ DATE _____

DISAPPROVED BY _____ FOR _____ DATE _____

HOLD PENDING FURTHER TESTS _____

REASONS FOR REJECTION OR HOLDING _____

PERCOLATION TEST PLAT/PRELIMINARY PLAT - TITLE OR I.D. # _____ DATE _____

SITE DEVELOPMENT PLAN/FINAL PLAT - TITLE OR I.D. # _____ DATE _____

THIS IS NOT A PERMIT

Repair
COUNTY #

WOODS T T Fence


Woods + Kean Property Line

SOIL PROFILE #

0' Hole ①

SOIL PROFILE

0' Hole #4

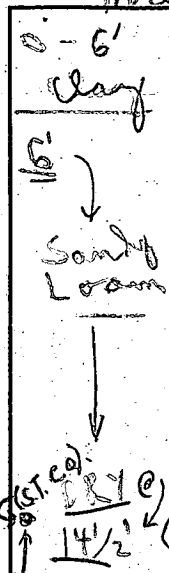

Pay to order

0-7'
Clay


LOG M

DRY, C

0'-4'-8" ←
Clay
— — —
4'-8" —

LOAM

Dr. J. C. ...

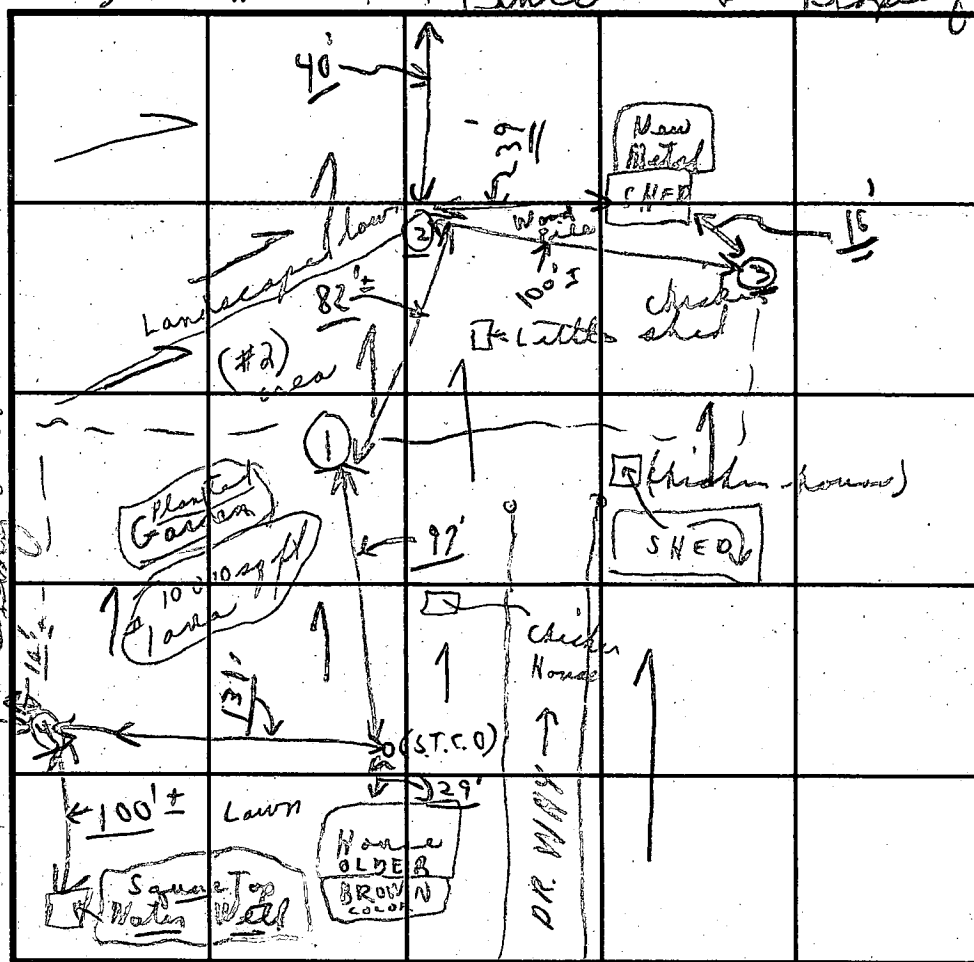

INDICATE NORTH - NAME ADJOINING ROADWAY AS BASE LINE

TEN OAKS ROAD

DATE	TEST NO.	DEPTH	PRE-WET		TEST - 1" DROP		TIME
			START	STOP	START	STOP	
6/23/94 Thursday	(1)	6' → 14½'	10:00 0'-6' Clay	10:02	10:02	10:04	2 min
	(2)	(1) 5½' → 13'	10:13 0'-9" 7½'-13' Clay Loam	10:18	10:18 Dist. effn. Dirt, yellow	10:36	Lower X's
(Lowest)	(3)	4'-8" → 12'	10:27 0'-4'-8" 4'-8"-12' Clay	10:29	10:29	10:32	3 min
Hwy 101	(4)	6½' → 11½'	11:20 0'-6' 6'-11½' Clay Loam	11:22	11:22	11:25	3 min
	(20)	→ 7' →	Light loam starts no test (Hole cover)				

REMARKS

TYPE OF SOIL

TESTED BY

TRENCH DESIGN DATA: AVERAGE PERCOLATION TIME

INLET DEPTH,

MAXIMUM BOTTOM DEPTH

ALSO PRESENT

TRENCH WIDTH

7/BEDROOM

REMARKS	6/23	(28)	10:44	10:57	10:57	11:XX	3/4" (11.20)
---------	------	------	-------	-------	-------	-------	--------------

TYPE OF SOIL Loam below clay in all holes - no water


TESTED BY CIB ALSO PRESENT Arnold

TRENCH DESIGN DATA: AVERAGE PERCOLATION TIME 3 min TRENCH WIDTH 3'

INLET DEPTH 5'; MAXIMUM BOTTOM DEPTH 7'; SQ. FT./BEDROOM $\frac{180}{11} = 16.36$ *Cunningham*

SHALLOW ONLY

(Worked around garden + yard + bldgs.) 6/23/94

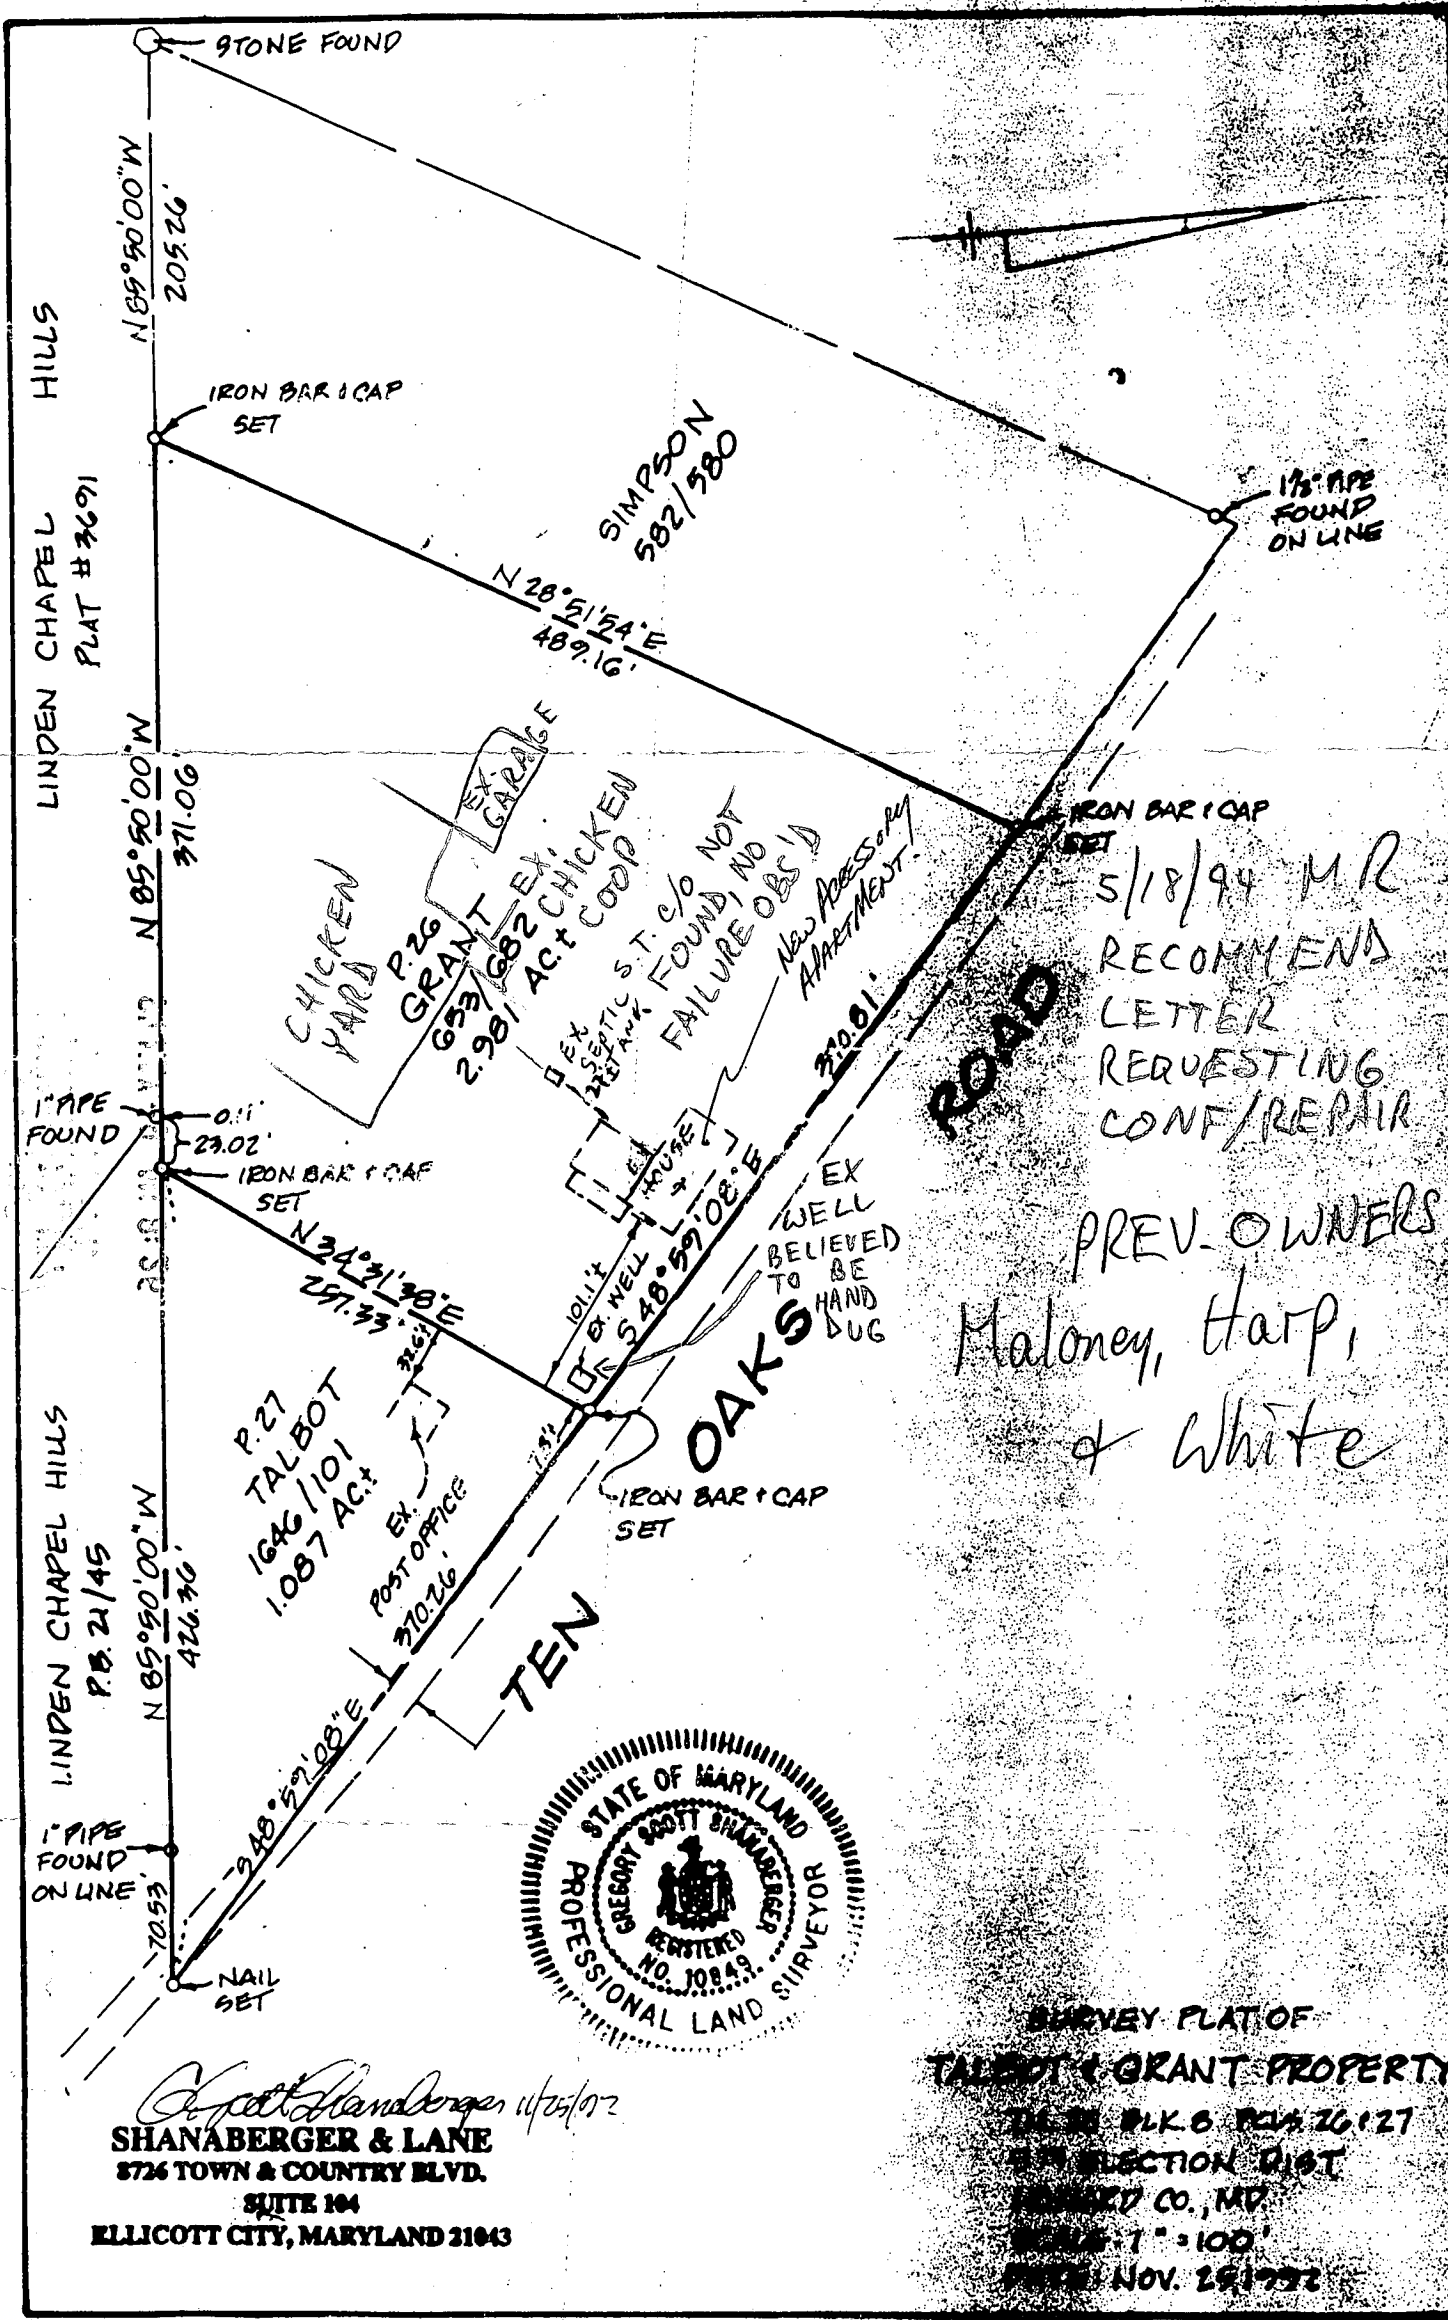

5/18/94 MR
RECOMMENDS
LETTER
REQUESTING
CONF/REPAIR

PREV. OWNERS
Maloney, Harp,
& White



Gregory Scott Shanaberger 11/29/92
SHANABERGER & LANE
8726 TOWN & COUNTRY BLVD.
SUITE 104
ELLCOTT CITY, MARYLAND 21043

SURVEY PLAT OF
TALBOT & GRANT PROPERTY
DEED BLK 6 PAGES 26 & 27
2ND ELECTION DIST
PRINCE GEORGES CO., MD
SCALE 1" = 100'
DATE NOV. 29, 1992

FAX TRANSMITTAL

FROM:

"A" Company Home Improvements
4415 Falls Road
Baltimore, MD 21211-1225
410-235-4010, 1-800-673-9074
fax=410-889-4816

TO: MARK RIFKIN
BUREAU OF ENVIRONMENTAL HEALTH

RE: GRANT RESIDENCE BLDG PERMIT #54007
4888 TEN OAKS RD DAYTON MD 21036

THE FOLLOWING FAX IS A SKETCH OF THE "SEPTIC REPAIR" AREAS
PER THE TEST/INSPECTION IN THE MORNING OF 23 JUNE 1994.

IT HAS BEEN SIGNED BY THE OWNER AND THE CONTRACTOR OF RECORD
FOR BUILDING PERMIT #54007.


THIS BEING DONE AND NOW SUBMITTED PER INSTRUCTIONS BY THE
INSPECTOR, B. STREAKER R.S.

THANK YOU

JIM CUNNINGHAM
OFFICE MANAGER

TOTAL NUMBER OF PAGES
INCLUDING COVER PAGE = 2

SKETCH ACCEPTED FOR ESTABLISHMENT
OF SUFFICIENT SEPTIC REPAIR AREA
TO SUPPORT BP 54007; OK TO SIGN BP
MR 6/29/94

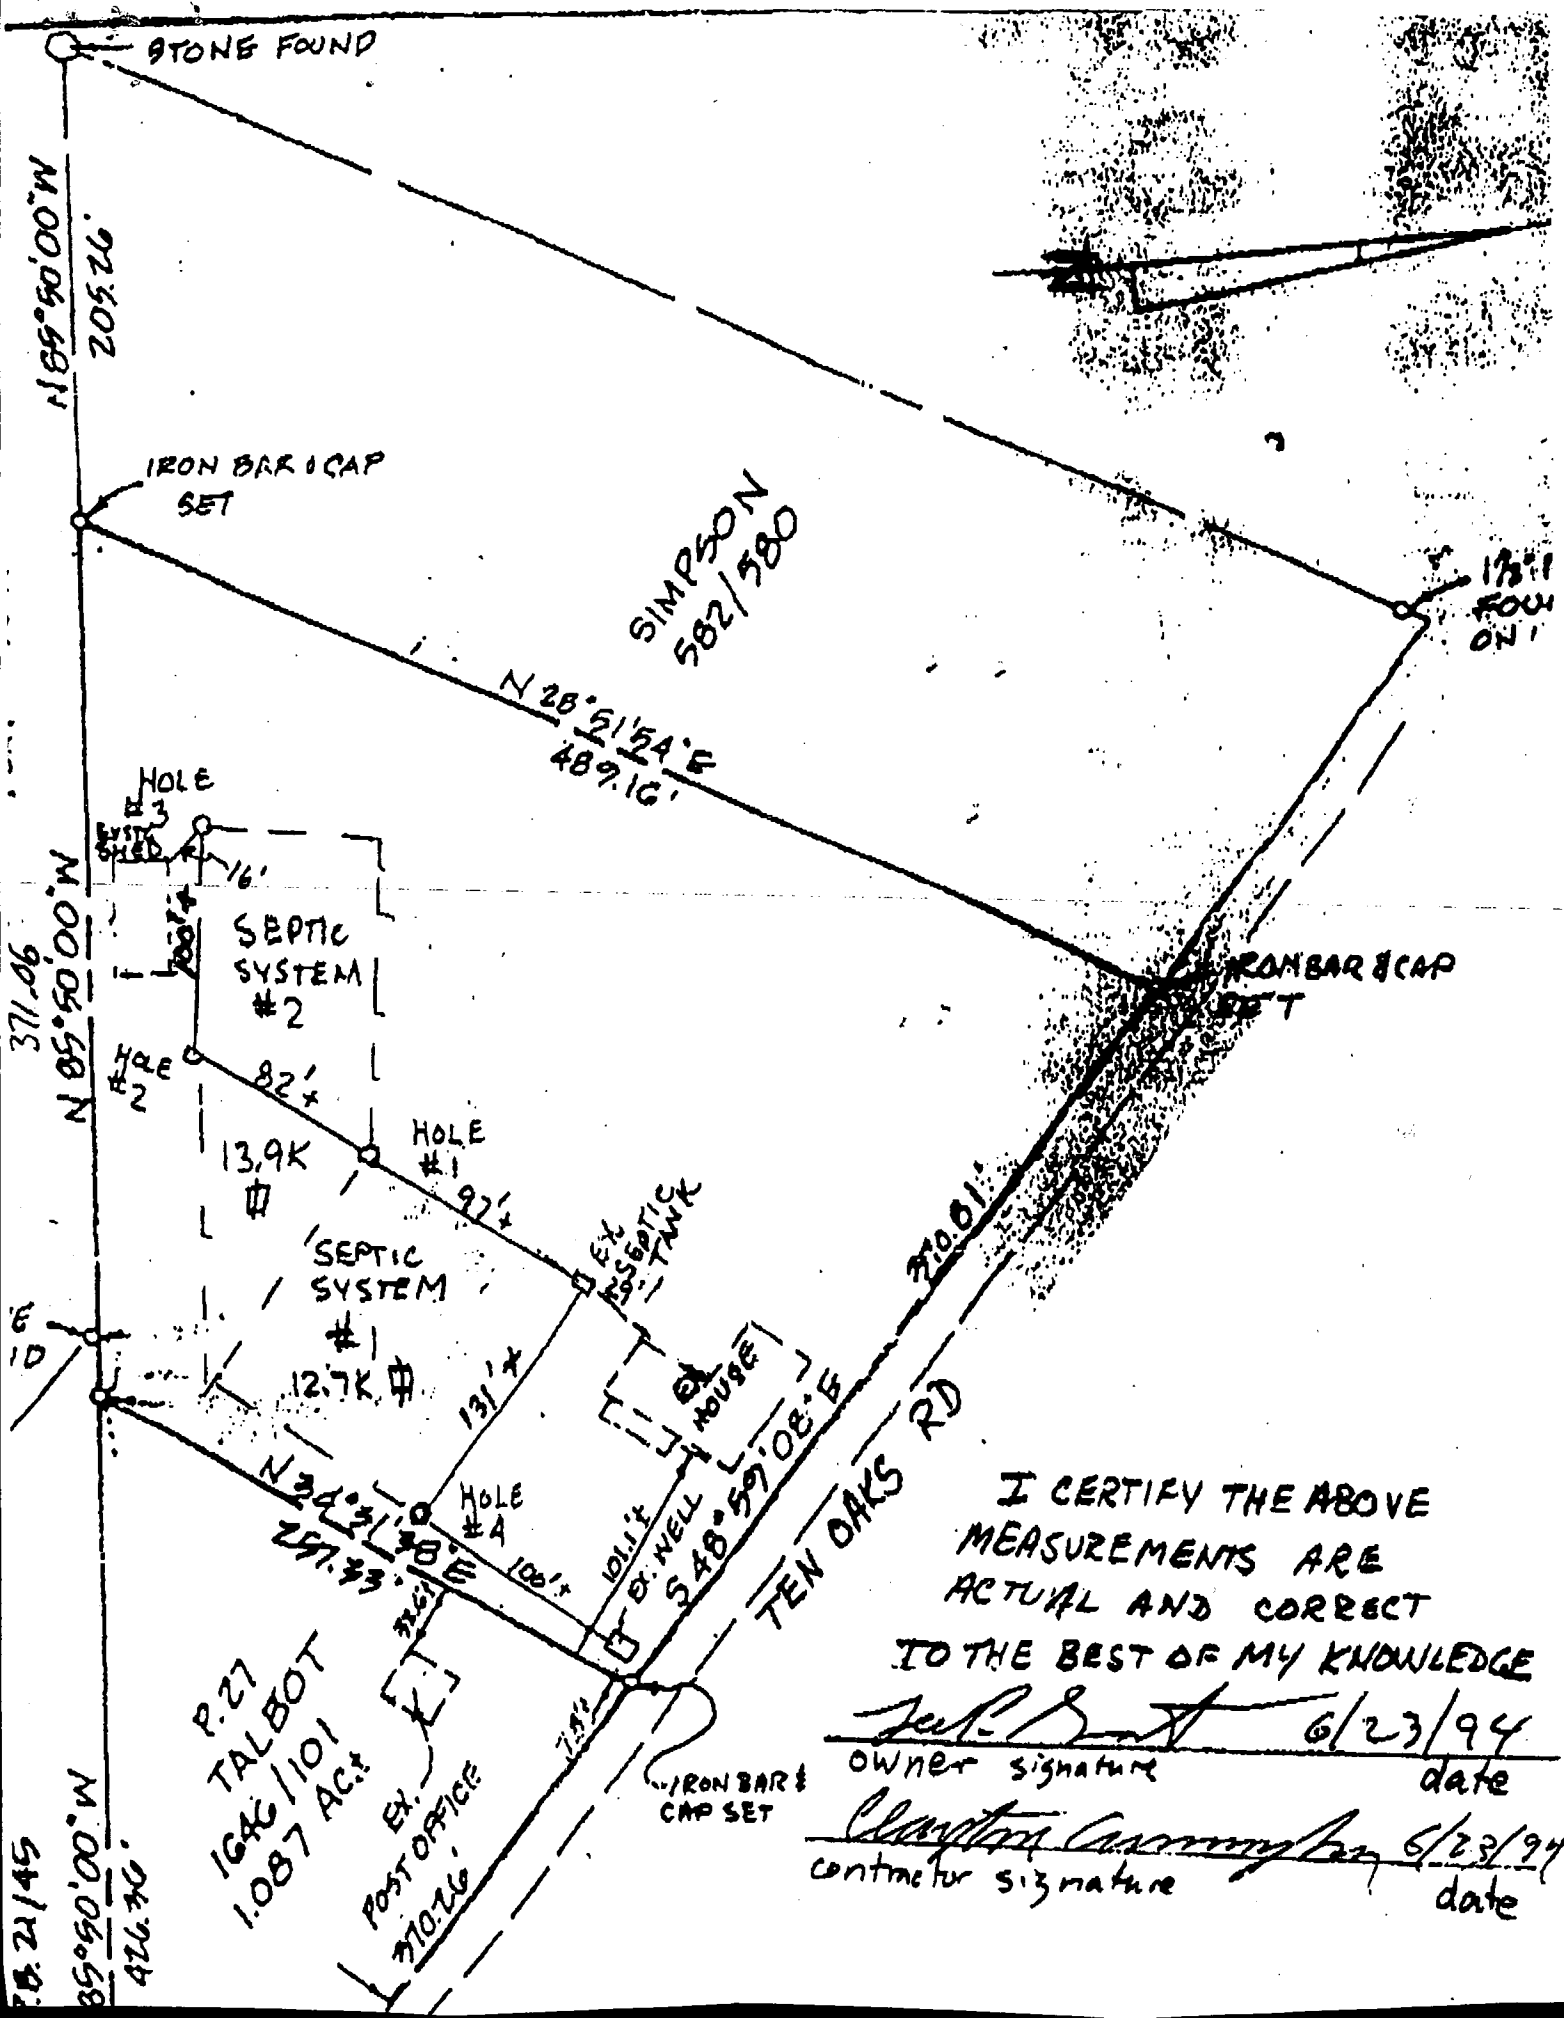

I CERTIFY THE ABOVE
MEASUREMENTS ARE
ACTUAL AND CORRECT
TO THE BEST OF MY KNOWLEDGE

John R. Smith 6/23/94
owner signature date

Clayton Cunningham 6/23/94
contractor signature date

LINDEN CHAPEL
PLAT # 3691

N 85° 50' 00" W
371.06'

N 85° 20' 20" W
205.20'

IRON BAR CAP
SET

REPAIR
AREA

P. 26
GRANT
653/682
2.981 AC±

EX GAR.

SIMPSON
582/586

4870

S.T. 4/0

V

75' ±
MR
3rd
SITE
OK

80'

AS DRILLED
11/26/96
90' ±

2ND
WELLSITE
OR MR
11/20/96
14 GPM 11/25/96

SHEEP
EX BARN
GARAGE

370.81'

GARDEN

IRON BAR

SET

N 24° 21' 08" E

257.33'

0.11'

23.02'

1" PIPE
FOUND

EX. S.T. 6/0

30'

DRY

11/20/96

15'

7.8'

EX. WELL

101.1'

EX. HOUSE

EX. SEPTIC
TANK

1004

85'

Well

EX. WELL

S 48° 59' 08" E

WSI OK MR 11/6/96

OAKS

ROAD

IRON BAR CAP
SET

IRON BAR CAP
SET

C1 7891
SEQUENCE NO. (MDE USE ONLY)
(THIS NUMBER IS TO BE PUNCHED IN COLS. 3-6 ON ALL CARDS)

STATE OF MARYLAND
WELL COMPLETION REPORT
FILL IN THIS FORM COMPLETELY
PLEASE PRINT OR TYPE

THIS REPORT MUST BE SUBMITTED WITHIN 45 DAYS AFTER WELL IS COMPLETED.
COUNTY NUMBER P 50068

ST/CO USE ONLY: DATE Received: 120696
DATE WELL COMPLETED: 112696
Depth of Well: 360 (TO NEAREST FOOT)
PERMIT NO. FROM "PERMIT TO DRILL WELL": H0-94-0991

OWNER: GRANT LEE
STREET OR RFD: 7888 TEN OAKS RD
SUBDIVISION: TAX MAP 28 C108 P26
TOWN: DAYTON
SECTION: LOT:

WELL LOG
Not required for driven wells
STATE THE KIND OF FORMATIONS PENETRATED, THEIR COLOR, DEPTH, THICKNESS AND IF WATER BEARING.
DESCRIPTION (Use additional sheets if needed) FEET FROM TO check if water bearing
Sand 0 43
Gray Mica Rock 43 360
2 dry wells 640' 460' filled in with cement + drilling materials


GROUTING RECORD
WELL HAS BEEN GROUTED (Circle Appropriate Box) YES (Y) NO (N)
TYPE OF GROUTING MATERIAL (Circle one) CEMENT (CM) BENTONITE CLAY (BC)
NO. OF BAGS 45 46 136 NO. OF POUNDS 45 46 136
GALLONS OF WATER 87
DEPTH OF GROUT SEAL (to nearest foot) from 0 ft. to 44 ft.
CASING RECORD
casing types insert appropriate code below
MAIN CASING TYPE PL Nominal diameter top (main) casing (nearest inch) 6 Total depth of main casing (nearest foot) 47
OTHER CASING (if used) diameter inch depth (feet) from to
SCREEN RECORD
screen type or open hole insert appropriate code below
STEEL (ST) BRASS (BR) OPEN HOLE (HO)
BRONZE (PL) PLASTIC (OT) OTHER (OT)



PUMPING TEST
HOURS PUMPED (nearest hour) 6
PUMPING RATE (gal. per min.) 3
METHOD USED TO MEASURE PUMPING RATE Air
WATER LEVEL (distance from land surface) BEFORE PUMPING 48 ft. WHEN PUMPING 290 ft.
TYPE OF PUMP USED (for test) A air P piston T turbine C centrifugal R rotary O other (describe below) J jet S submersible

PUMP INSTALLED
DRILLER WILL INSTALL PUMP (YES or NO) YES (Y) NO (N)
IF DRILLER INSTALLS PUMP, THIS SECTION MUST BE COMPLETED FOR ALL WELLS.
TYPE OF PUMP INSTALLED PLACE (A,C,J,P,R,S,T,O) IN BOX 29
CAPACITY: GALLONS PER MINUTE (to nearest gallon) 31 35
PUMP HORSE POWER 37 41
PUMP COLUMN LENGTH (nearest ft.) 43 47
CASING HEIGHT (circle appropriate box and enter casing height) + above - below LAND SURFACE 2 (nearest foot)

NUMBER OF UNSUCCESSFUL WELLS: 2
WELL HYDROFRACTURED YES (Y) NO (N)
CIRCLE APPROPRIATE LETTER
A A WELL WAS ABANDONED AND SEALED WHEN THIS WELL WAS COMPLETED
E ELECTRIC LOG OBTAINED
P TEST WELL CONVERTED TO PRODUCTION WELL
I HEREBY CERTIFY THAT THIS WELL HAS BEEN CONSTRUCTED IN ACCORDANCE WITH COMAR 26.04.04 "WELL CONSTRUCTION" AND IN CONFORMANCE WITH ALL CONDITIONS STATED IN THE ABOVE CAPTIONED PERMIT, AND THAT THE INFORMATION PRESENTED HEREIN IS ACCURATE AND COMPLETE TO THE BEST OF MY KNOWLEDGE.
TYPE: MWD/MSD/MGD 24
DRILLERS LIC. NO. 24
DRILLERS SIGNATURE Joseph L. Mayne
LIC. NO. 27
SITE SUPERVISOR (sign. of driller or journeyman responsible for sitework if different from permittee) Barry M. Mayne

DEPTH (nearest ft.) 1 2 3 4 5 6 7 8 9 10 11 12 13 14 15 16 17 18 19 20 21 22 23 24 25 26 27 28 29 30 31 32 33 34 35 36 37 38 39 40 41 42 43 44 45 46 47 48 49 50 51
SLOT SIZE 1 2 3 DIAMETER OF SCREEN (NEAREST INCH) 56 60
GRAVEL PACK IF WELL DRILLED WAS FLOWING WELL INSERT F IN BOX 68
MDE USE ONLY (NOT TO BE FILLED IN BY DRILLER) (E.R.O.S.) T W Q 70 72 74 75 76
TELESCOPE CASING LOG INDICATOR OTHER DATA

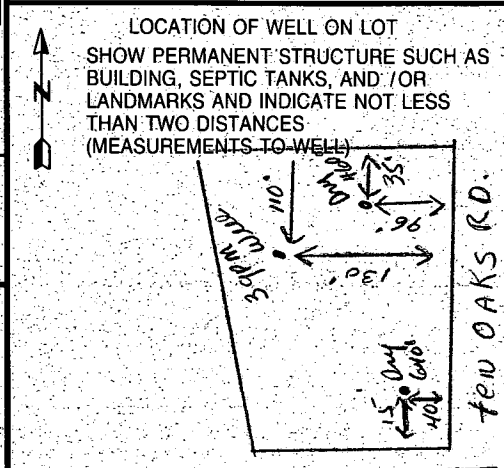

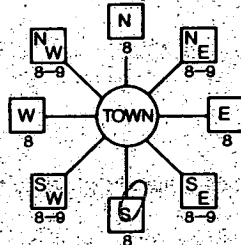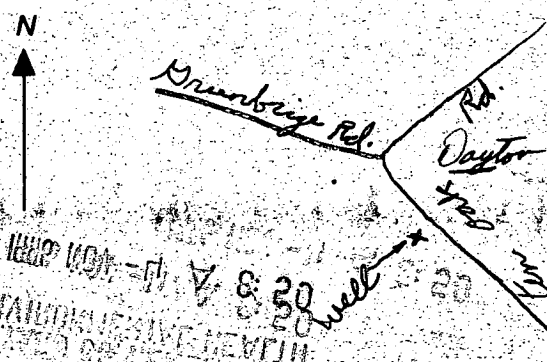B 1 1 2 3 4 5 6 4813 (THIS NUMBER IS TO BE PUNCHED IN COLS. 3-6 ON ALL CARDS)	SEQUENCE NO (MDE USE ONLY)	STATE OF MARYLAND PERMIT TO DRILL WELL please print or type	STATE PERMIT NUMBER H0-94-0991 70 fill in this form completely 79
Date Received (APA) 1/10/90 OWNER INFORMATION 15 Last Name GRANT 34 Owner P. First Name LEE 36 Street or RFD 4888 TEN OAKS RD 55 57 Town DAYTON 70 State 72 MD Zip 76 21036		B 3 LOCATION OF WELL 8 COUNTY HOWARD 21 23 SUBDIVISION DAYTON 42 SECTION 48 46 LOT 48 50 TAX MAP 28 GRID 8 52 NEAREST TOWN DAYTON 71 MILES FROM TOWN (enter 0 if in town) 0 73 MI 76 77 78	
DRILLER INFORMATION CIRCLE: MSD/MGD/MWD Driller's Name Joseph L. Mayne 77 License No. 80 24 Firm Name Joseph L. Mayne Well Drilling Address 5512 Ridge Rd. Mt. Airy, Md. 21771 Signature Joseph L. Mayne 11/1/96 Date		B 4 1 2 DIRECTION OF WELL FROM TOWN (CIRCLE BOX)  NEAR WHAT ROAD 4888 ten oaks Road 30 ON WHICH SIDE OF ROAD (CIRCLE APPROPRIATE BOX) NORTH ☒ WEST ☐ EAST ☐ SOUTH ☐ 34 40 37 DISTANCE FROM ROAD ENTER FT OR MI FT 38 39 TAX MAP: _____ BLK: _____ PARCEL 26	
B 2 WELL INFORMATION APPROX. PUMPING RATE (GAL PER MIN.) 5 8 12 AVERAGE DAILY QUANTITY NEEDED (GAL PER DAY) 500 14 20		NOT TO BE FILLED IN BY DRILLER HEALTH DEPARTMENT APPROVAL Howard P 50068 COUNTY NAME _____ COUNTY NO. _____ STATE SIGNATURE _____ INSERT S ☐ DATE ISSUED 1/1/89 Mark Reffin (CW) 11/17/97 43 NORTH GRID 511000 55 48 CO SIGNATURE _____ EXP DATE _____ 57 EAST GRID 0804000 63	
USE FOR WATER (CIRCLE APPROPRIATE BOX) ☒ HOME (SINGLE OR DOUBLE HOUSEHOLD UNIT ONLY) ☐ FARMING (LIVESTOCK WATERING & AGRICULTURAL IRRIGATION) ☐ INDUSTRIAL, COMMERCIAL, STATE AND FEDERAL GOV. OTHER (REQUIRES APPROPRIATION PERMIT) ☐ PUBLIC OR PRIVATE WATER COMPANY (REQUIRES APPROPRIATION PERMIT AND STATE HEALTH DEPARTMENT APPROVAL) ☐ TEST, OBSERVATION, MONITORING (MAY REQUIRE APPROPRIATION PERMIT)		SHOW MAJOR FEATURES OF BOX & LOCATE WELL WITH AN X SOURCES OF DRILLING WATER 1. WELL 2. 3. WRITE THE BOX NUMBER FROM THE MAP HERE E 804 N 510 000 000	
APPROXIMATE DEPTH OF WELL 300 24 28 FEET APPROXIMATE DIAMETER OF WELL 6 INCH NEAREST		11/26/96 9:30 GROUT COMPLETED TAG ON WELL LOCATION AS SHOWN APPROVED	
METHOD OF DRILLING (circle one) BORED (or Augered) ☒ JETTED ☐ Jetted & DRIVEN ☐ 30 AIR-ROTARY ☒ AIR-PERCussion ☐ ROTARY (Hydraulic Rotary) ☐ 37 CABLE ☐ REVERSE-ROTARY ☐ DRIVE-POINT ☐ other _____		DRAW A SKETCH BELOW SHOWING LOCATION OF WELL IN RELATION TO NEARBY TOWNS AND ROADS AND GIVE DISTANCE FROM WELL TO NEAREST ROAD JUNCTION 	
REPLACEMENT OR DEEPEMED WELLS (CIRCLE APPROPRIATE BOX) ☐ N THIS WELL WILL NOT REPLACE AN EXISTING WELL ☐ Y THIS WELL WILL REPLACE A WELL THAT WILL BE ABANDONED AND SEALED 39 ☒ S THIS WELL WILL REPLACE A WELL THAT WILL BE USED AS A STANDBY-CONTACT LOCAL APPROVING AUTHORITY FOR POLICY ON STANDBY WELLS ☐ D THIS WELL WILL DEEPEN AN EXISTING WELL PERMIT NUMBER OF WELL TO BE REPLACED OR DEEPEMED (IF AVAILABLE) 41 _____ 52		Not to be filled in by driller (MDE OR COUNTY USE ONLY) APPROX. PERMIT NUMBER _____ 54 63 FORCE HR WRITE INITIALS IN BOX 67 68 PERMIT No. H0-94-0991 70 71 72 73 74 75 76 77 78 79	
SPECIAL CONDITIONS NOTE - APPROVING AUTHORITIES SHOULD USE SEPARATE SHEET IF NEEDED			