

PERMIT

SEWAGE DISPOSAL SYSTEM

DEPARTMENT OF HEALTH AND MENTAL HYGIENE

HOWARD COUNTY HEALTH DEPARTMENT

BUREAU OF ENVIRONMENTAL HEALTH

~~NEW YORK~~

313-2640

INDEXED

P 50405
A 17968
A REPAIR

DISTRICT 5th

DATE 11/18/94

DATE SYSTEM APPROVED 11/21/94

INSPECTOR C.B.A.

Arnold Backhoe & Septic Service

IS PERMITTED TO INSTALL ALTER X

ADDRESS P. O. Box 15, Woodbine, Maryland 21797 PHONE 795-7873

SUBDIVISION Wm. Contrivance Estates LOT 11 ROAD 8349 Reservoir Road

PROPERTY OWNER Stephen Frank

ADDRESS _____

SEPTIC TANK CAPACITY 1250 GALLONS

NUMBER OF BEDROOMS 4
or 1250 / Bdn with existing dry well connection
180 SQUARE FEET PER BEDROOM

LINEAR FEET OF TRENCH REQUIRED 63

REPAIR - PURPOSE - SEPTIC SYSTEM HAS FAILED. (DRYWELL FULL)

Call for inspection when ground is opened so sanitarian can recommend repair. 11/10/94

Install one Trench 63 ft long, 2 ft wide, 10 ft bottom, inlet @ 2 ft, 8 ft of stone, 11.
connected to existing dry well. Install Trench on contour begin @ 10 ft below A on higher
11/21/94 CBA

PLANS APPROVED BY See above please and back DATE 11/21/94

COVER NO WORK UNTIL INSPECTED AND APPROVED

NEITHER THE HOWARD COUNTY COUNCIL NOR THE HEALTH DEPARTMENT IS RESPONSIBLE FOR THE SUCCESSFUL OPERATION OF ANY SYSTEM

NOTE: CLEANOUT REQUIRED EVERY 70 FEET OF SEWER LINE AND/OR AT 90° SWEEPS IN LINES FROM HOUSE TO DRAIN FIELDS, 90° ELBOWS NOT ACCEPTABLE.

NOTE: ALL PARTS OF SEPTIC SYSTEMS (I.E. TANK, DISTRIBUTION BOX TRENCHES) TO BE 100 FEET FROM WELL (UNLESS OTHERWISE SPECIFICALLY AUTHORIZED)

NOTE: IF DEEP TRENCH(ES) ARE USED CALL FOR INSPECTION BEFORE AND AFTER PLACING GRAVEL IN TRENCH(ES)

NOTE: NO DRY WELL SHALL EXCEED 15 FOOT IN DIAMETER NO ABSORPTION TRENCH TO EXCEED 100 FEET IN LENGTH

NOTE: ALL PIPE FROM HOUSE TO SEPTIC TANK MUST BE CAST IRON OR SCHEDULE 35/40 PVC OR ABS

PERMIT VOID AFTER TWO YEARS

NOTE: INSTALL STAND PIPE ON SEPTIC TANK AND DRY WELL STAND PIPES MUST BE 6 INCHES IN DIAMETER CAST IRON. CONCRETE OR TERRA COTTA OR PVA OR ABS ACCEPTED. IF TOP OF SEPTIC TANK IS DEEPER THAN 3 FEET. MANHOLE TO GRADE REQUIRED.

NOTE: DISTRIBUTION BOXES MUST HAVE BAFFLES

*INSTALLER IS RESPONSIBLE FOR OBTAINING FINAL APPROVAL ON THIS PERMIT

HD-260(6-90)

*CALL 461-9933 FOR INSPECTION OF SEPTIC SYSTEM.

P 50405

PERMIT

SEWAGE DISPOSAL SYSTEM

MARYLAND STATE DEPARTMENT OF HEALTH

HOWARD COUNTY

ELLICOTT CITY

DISTRICT 5

DATE 9/8/75

INDEXED

Neale & Neale

IS PERMITTED TO INSTALL X ALTER

ADDRESS 2106 Arcola Avenue, Silver Spring, Md. 20902

PHONE 8-949-1547

A SEWAGE DISPOSAL SYSTEM LOCATED AT

SUBDIVISION Williams Contrivance Estates

ROAD 8349 Reservoir

LOT 11

PROPERTY OWNER Neale & Neale

ADDRESS 2106 Arcola Ave., Silver Spring, Md. 20902

SPECIFICATIONS - 4 bedrooms

DRAIN FIELD _____ DEPTH _____ FEET, BOTTOM AREA _____ SQ. FT.

SEEPAGE PITS _____ ABSORBENT SIDE-WALL AREA _____ SQ. FT.

SEPTIC TANK CAPACITY 1,200 GALLONS

FOR GARBAGE GRINDER, INCREASE DISPOSAL AREA 22% & TANK CAPACITY 50%.

OTHER Dry well - 480 sq. ft. of absorbent sidewall area to be no deeper than

3 ft. below original grade. Max. depth permitted for dry well is 10½ ft., below original
grade. Locate dry well 125 ft. from front lot line and 10 ft. from left side line as seen
from road.

NOTE: ALL PIPE FROM HOUSE TO DISPOSAL AREA MUST BE CAST IRON.

PERMIT VOID AFTER THREE YEARS.

NOTE: INSTALL STAND PIPES ON SEPTIC TANK AND DRY WELL. STAND PIPES MUST BE 6" IN DIA.,

PLANS APPROVED BY Robert V. Torre DATE 12/5/73

CONCRETE, CAST IRON OR TERRA COTTA ACCEPTABLE.

FILL SEPTIC TANK AND DISTRIBUTION BOX WITH WATER BEFORE CALLING FOR AN INSPECTION. COVER NO WORK UNTIL INSPECTED AND APPROVED.

NEITHER THE HOWARD COUNTY COMMISSIONERS NOR THE HEALTH DEPARTMENT IS RESPONSIBLE FOR THE SUCCESSFUL OPERATION OF ANY SYSTEM.


OK to use as an alternate: Dry well & Trench

D.W. : 10'x10', inv. @ 3', max depth 10½', with 7½' of stone

Trench: 5' buffer; trench 2' wide, 25' long, 10½' deep with 7½' stone

R.M. 9/8/75

17968

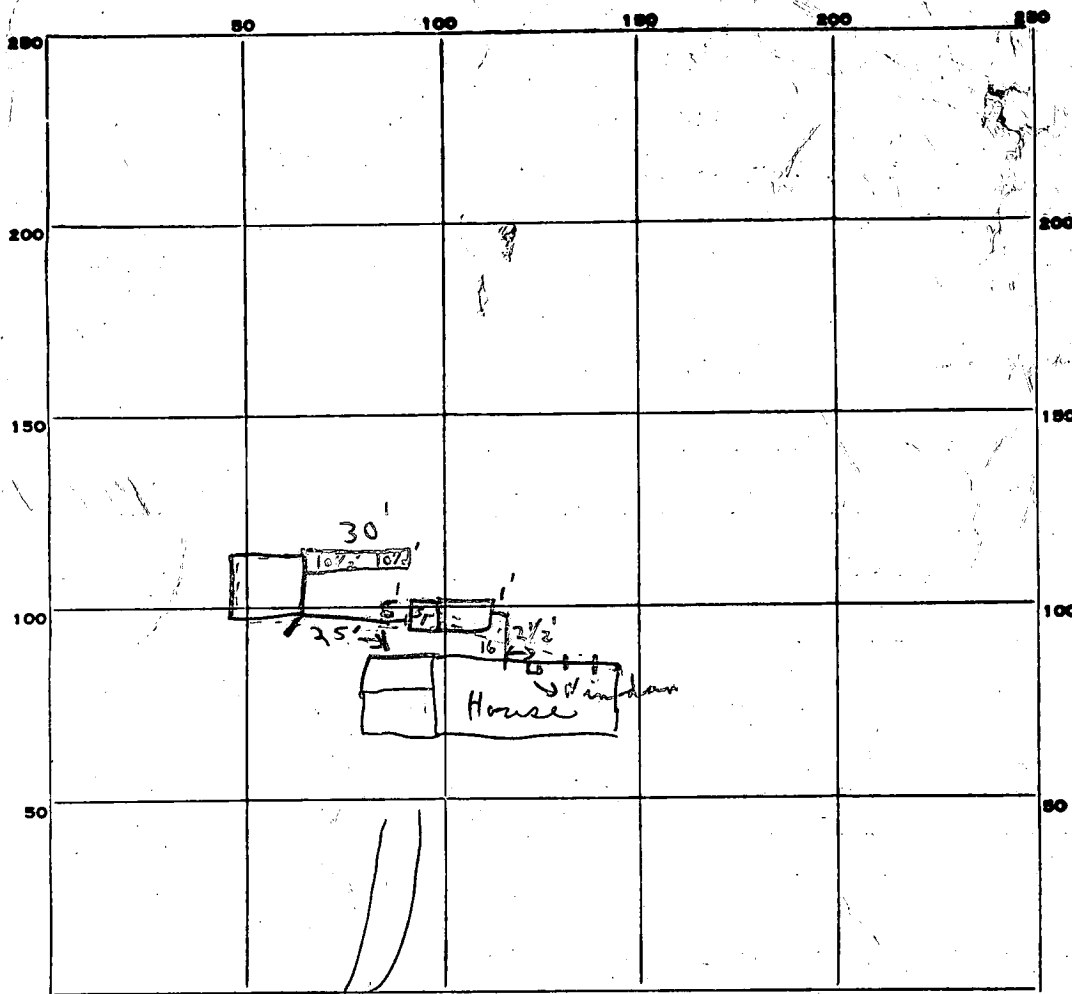

PERMIT CARD

② Not seen ① Not seen

SEPTIC TANK, LEVEL

ok

CLEANOUTS

S.T.
No (1+2)

D.W.
No (1+2)

DISTRIBUTION BOX, LEVEL

TILE FIELD, DEPTH _____ FT. TRENCH WIDTH _____ FT.

GRAVEL DEPTH 7.5' IN. TOTAL LENGTH 30 FT.

① 225.0

NUMBER OF TRENCHES 1 TOTAL BOTTOM AREA _____

outside perimeter

②

inlet 3 1/2'

SEEPAGE PITS, INSIDE DIAMETER _____ FT. DEPTH BELOW INLET 7.5' FT.

ABSORBENT AREA + SQ. FT.

REMARKS

9/10/75 ① Checked note extended trench 5' ms.

luffin - Trench now 30'; sh'd for gravel.

② Trench gravel to 3' from top - ok to cover C.B.D.

all except drywell & cleanouts for Septic Tank & Dry Well!

Hold for call on drywell ok to cross all

but drywell - no lid on dry well - all pipe connected from

here to D. Well & D. Well to T. to house

DATE SYSTEM APPROVED

2/76

INSPECTOR

see attached letter

R.M.

PRELIMINARY

APPLICATION

A 17968

SEWAGE DISPOSAL TESTING

P _____

STATE OF MARYLAND - DEPARTMENT OF HEALTH AND MENTAL HYGIENE

HOWARD COUNTY HEALTH DEPARTMENT
ENVIRONMENTAL HEALTH SERVICESP. O. BOX 476, ELLICOTT CITY, MARYLAND 21043
TELEPHONE: 465-5000, EXT. 356

DISTRICT 5th

DATE 2/20/73

*Septic Tank - 1200
Dry Well - 500 sq. ft.
of absorbent sidewalk area to
no deeper than 3 ft. below original grade.
Max. depth permitted for dry well is 10 1/2 ft.
below original grade. Locate dry well
125 ft. from front lot line and 10 ft from
left side line as seen from Rd.*

TO: THE COUNTY HEALTH OFFICER
ELLICOTT CITY, MARYLANDI, HEREBY, APPLY FOR THE NECESSARY TEST IN ORDER TO CONSTRUCT (OR RECONSTRUCT) A SEWAGE
DISPOSAL SYSTEM.PROPERTY OWNER C. Ellsworth Iager, et. al.ADDRESS Route 216, Fulton, Md. PHONE 725-2074

PROPERTY LOCATION:

SUBDIVISION Williams Contrivance Estates LOT NO. 11ROAD AND DESCRIPTION Reservoir RoadSIZE OF LOT 43,600 sq. ft. TYPE BLDG. 4 or 5 bedrooms

NUMBER OF BEDROOMS


IF NOT SINGLE RESIDENCE DESCRIBE _____

THE SYSTEM INSTALLED UNDER THIS APPLICATION IS ACCEPTABLE ONLY UNTIL PUBLIC
FACILITIES BECOME AVAILABLE.SIGNATURE OF APPLICANT /s/ C. Ellsworth IagerAPPROVED BY Robert V. Tane FOR Dry Well DATE 2/21/73
(KIND OF SYSTEM)REJECTED BY _____ FOR _____ DATE _____
(KIND OF SYSTEM)

HOLD PENDING FURTHER TESTS _____ DATE _____

REASONS FOR REJECTION OR HOLDING Reala & Reala, Inc.2106 Arcolar Ave.Silver Spring, Md.
20902BLDG. PERMIT SIGNED
AND RETURNED 2/21/73

THIS IS NOT A PERMIT

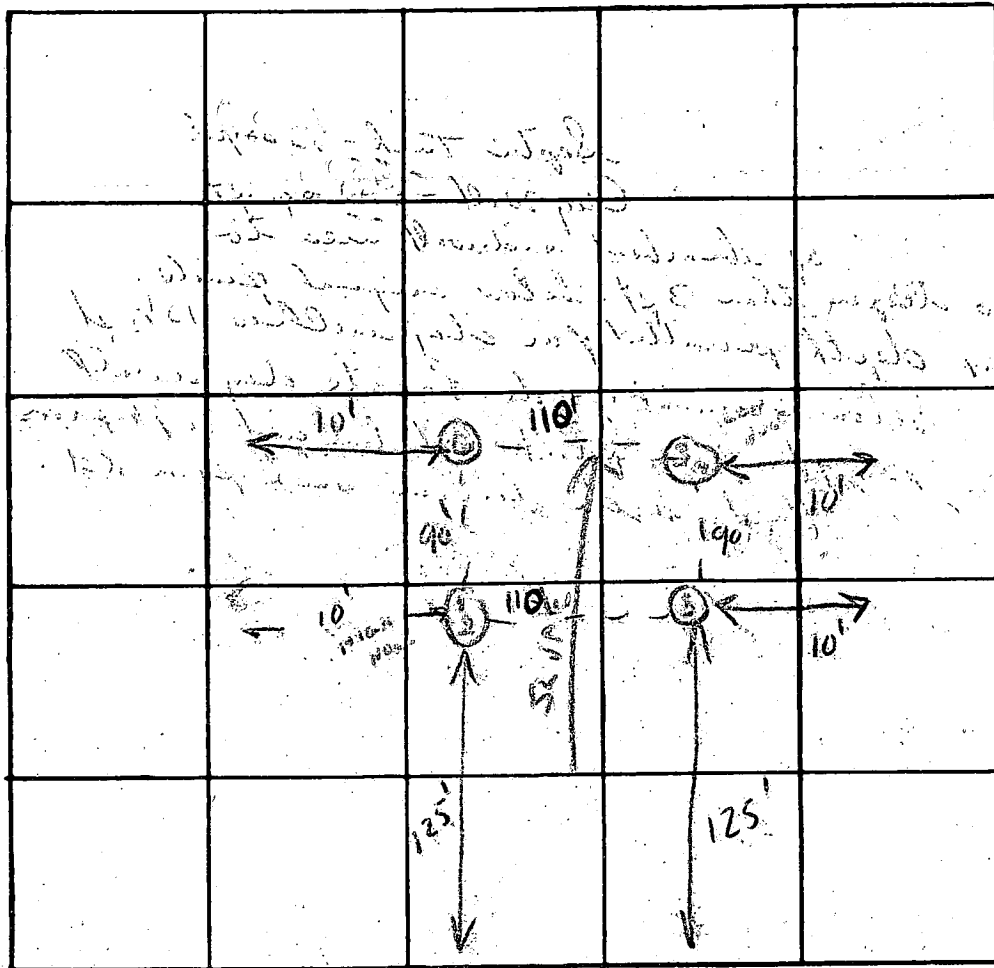

INDICATE NORTH. - NAME ADJOINING ROADWAY AS BASE LINE.

DATE	TEST NO.	DEPTH	PRE-WET		TEST - 1" DROP		TIME
			START	STOP	START	STOP	
	1	3 1/2 ft	10:18	10:23	10:23	10:30	7 min
	2	10 1/2 ft	10:18	10:21	10:21	10:26	5 min
	3	10 ft	10:20	10:23	10:23	10:30	7 min
	4	4 1/2 ft	10:20			10:23	3 min
1-2-4-1	5	10 ft	Same	Same			
	6	10 ft	Same	Same			

REMARKS

TYPE OF SOIL

TESTED BY

ALSO PRESENT:

Locations Certified/REC3

PRELIMINARY

APPLICATION

A 17968

SEWAGE DISPOSAL TESTING

P _____

STATE OF MARYLAND - DEPARTMENT OF HEALTH AND MENTAL HYGIENE

HOWARD COUNTY HEALTH DEPARTMENT
ENVIRONMENTAL HEALTH SERVICESP. O. BOX 476, ELLICOTT CITY, MARYLAND 21043
TELEPHONE: 465-8000, EXT. 356

DISTRICT 5th

DATE 2/20/73

*Septic Tank - 1500 gal
Dry Well - 500 sq. ft.
of abundant sidewalk area to
no deeper than 3 ft. below original grade.
Max. depth permitted for dry well is 10 1/2 ft.
below original grade. Locate dry well
125 ft. from front lot line and 10 ft. from
left side line, as seen from Rd.*

TO: THE COUNTY HEALTH OFFICER
ELLICOTT CITY, MARYLANDI, HEREBY, APPLY FOR THE NECESSARY TEST IN ORDER TO CONSTRUCT (OR RECONSTRUCT) A SEWAGE
DISPOSAL SYSTEM.

PROPERTY OWNER C. Ellsworth Iager, et. al.

ADDRESS Route 216, Fulton, Md. PHONE 725-2074

PROPERTY LOCATION:

SUBDIVISION Williams Contrivance Estates LOT NO. 11

ROAD AND DESCRIPTION Reservoir Road

SIZE OF LOT 43,600 sq. ft. TYPE BLDG. 4 or 5 bedrooms
NUMBER OF BEDROOMS


IF NOT SINGLE RESIDENCE DESCRIBE _____

THE SYSTEM INSTALLED UNDER THIS APPLICATION IS ACCEPTABLE ONLY UNTIL PUBLIC
FACILITIES BECOME AVAILABLE.SIGNATURE OF APPLICANT *C/S/ C. Ellsworth Iager*APPROVED BY *Robert V. Turner* FOR *Dry Well* DATE *12/5/73*
(KIND OF SYSTEM)REJECTED BY _____ FOR _____ DATE _____
(KIND OF SYSTEM)

HOLD PENDING FURTHER TESTS _____ DATE _____

REASONS FOR REJECTION OR HOLDING _____

THIS IS NOT A PERMIT

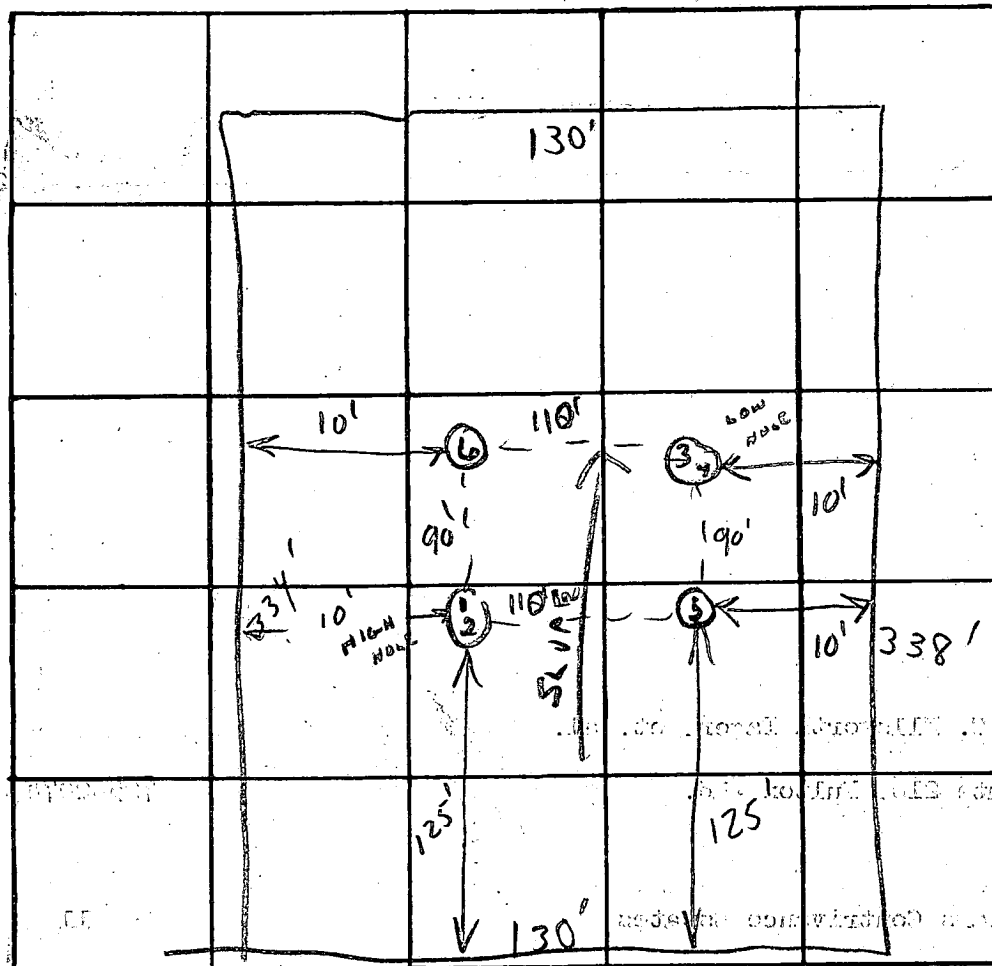

INDICATE NORTH. - NAME ADJOINING ROADWAY AS BASE LINE

K₂

Lab #11

[illegible]

REMARKS

TYPE OF SOIL

TESTED BY

ALSO PRESENT:

Certified holes by Engineer

Locations Certified/REB

Any time 6m
shut 3 1/2 ft

DRILLER: OBTAIN HEALTH DEPT. APPROVAL AND RETURN ALL PARTS OF THIS FORM INTACT TO THE WATER RESOURCES ADMINISTRATION.

EMERGENCY NO. (If any) -

R21814

DNR-131 (7/73)

B 1 0250		SEQUENCE NO. (WRA USE ONLY)		STATE OF MARYLAND WATER RESOURCES ADMINISTRATION TAWES STATE OFFICE BLDG., ANNAPOLIS, MARYLAND 21401 APPLICATION FOR PERMIT TO DRILL WELL		WRA PERMIT NUMBER	
1 2 3 (SEQ. NO.) 6 (THIS NUMBER IS TO BE PUNCHED IN COLS. 3-6 ON ALL CARDS)						FILL IN THIS FORM COMPLETELY	

DATE RECEIVED (WRA USE ONLY) 9/17/75 2 PM		OWNER X NEBLE + NEBLE INC COL 15 LAST NAME		FIRST NAME		COL. 24	
STREET OR RFD X 2106 ARCOLA AVE COL 36		ADDRESS 8349 RESERVOIR RD COL. 56					
POST OFFICE X SILVER SPRINGS MD 20902 COL 67		FULTON, MD COL. 76					

B 1 CONTINUED		DRILLER INFORMATION	
1 2 3 (SEQ. NO.) 6			
DATE 8/14/75		LICENSE NUMBER 251 77 80	
FIRST NAME Arthur P. Edmondson		LAST NAME Edmondson	
SIGNATURE Arthur P. Edmondson			

B 2		WELL INFORMATION	
1 2 3 (SEQ. NO.) 6			
MAXIMUM PUMPING RATE (GALLONS PER MINUTE) 6 8 12			
AVERAGE DAILY QUANTITY NEEDED (GALLONS PER DAY) 450 14 20			
USE FOR WATER (CIRCLE APPROPRIATE BOX)			
☒ D HOME (SINGLE OR DOUBLE HOUSEHOLD UNIT ONLY)			
☐ F FARMING, AGRICULTURE, IRRIGATION			
☐ I INDUSTRIAL, COMMERCIAL, STATE AND FEDERAL GOVERNMENT.			
☐ M MUNICIPAL WATER SUPPLY			
☐ P PRIVATE WATER COMPANY		MUST HAVE STATE HEALTH DEPT. APPROVAL	
☐ T TEST			

APPROXIMATE DEPTH OF WELL 100 24 28 FEET	
APPROXIMATE DIAMETER OF WELL 6 (NEAREST INCH)	

METHOD OF DRILLING USED (CIRCLE APPROPRIATE METHOD)	
☒ BORED (OR AUGERED) ☐ JETTED ☐ DRIVEN	
80-87 ☒ AIR-ROTARY ☐ AIR-PERCUSSION ☐ ROTARY (HYDRAULIC ROTARY)	
☒ CABLE ☐ REVERSE-ROTARY ☐ DRIVE-POINT	
OTHER (DESCRIBE)	


REPLACEMENT OR DEEPENEED WELLS (CIRCLE APPROPRIATE BOX)	
☒ N THIS WELL WILL NOT REPLACE AN EXISTING WELL	
☐ Y THIS WELL WILL REPLACE A WELL THAT WILL BE ABANDONED AND SEALED	
☐ S THIS WELL WILL REPLACE A WELL THAT WILL BE USED AS A STANDBY	
☐ D THIS WELL WILL DEEPEEN AN EXISTING WELL PERMIT NUMBER OF WELL TO BE REPLACED OR DEEPENEED (IF AVAILABLE)	

NOT TO BE FILLED IN BY DRILLER (WRA USE ONLY)	
APPROPRIATION PERMIT NUMBER	
ENGINEER REVIEW DISTRICT NO.	
FORCE	
WRITE INITIALS IN BOX	
CONDITIONS	

B 4 CONTINUED		HEALTH DEPARTMENT APPROVAL	
1 2 3 (SEQ. NO.) 6			
STATE HEALTH (CIRCLE BOX) MO. DAY YR. 20 07 5		HOWARD COUNTY NAME W21999 COUNTY NO.	
DATE		APPROVED	

B 3		LOCATION OF WELL	
1 2 3 (SEQ. NO.) 6			
COUNTY Howard (DO NOT ABBREVIATE COUNTY NAME)			
SUBDIVISION X WILLIAMS CONTRIBANCE ESTABLISHMENT 23 42			
SECTION X 6 44 46		LOT X 11 48 50	
NEAREST TOWN Scaggsville 62			
MILES FROM TOWN (ENTER 0 IF IN TOWN) 3 73 76 77 78			
B 4		DIRECTION FROM TOWN (CIRCLE APPROPRIATE BOX)	
1 2 3 (SEQ. NO.) 6			
☐ N NORTH ☐ E EAST ☐ NE NORTHEAST ☐ SE SOUTHEAST			
☐ S SOUTH ☐ W WEST ☒ NW NORTHWEST ☐ SW SOUTHWEST			
NEAR WHAT ROAD RT. 216 11 30			
ON WHICH SIDE OF ROAD (CIRCLE APPROPRIATE BOX) N 32 ☒ S 32 ☐ E 32 ☐ W 32			
DISTANCE FROM ROAD (ENTER DISTANCE AND CIRCLE APPROPRIATE BOX) 34 2 37 38 39			

DRAW A SKETCH BELOW SHOWING LOCATION OF WELL IN RELATION TO NEARBY ROADS AND STREAMS WITH NORTH IN THE DIRECTION OF THE ARROW, AND GIVE DISTANCE FROM WELL TO NEAREST ROAD JUNCTION OR STREAM CROSSING SHOWN ON SKETCH. ALSO SHOW, BY MEANS OF AN "X", THE WELL LOCATION IN THE BOX AREA AND THE BOX NUMBER FROM THE WELL LOCATION MAP.

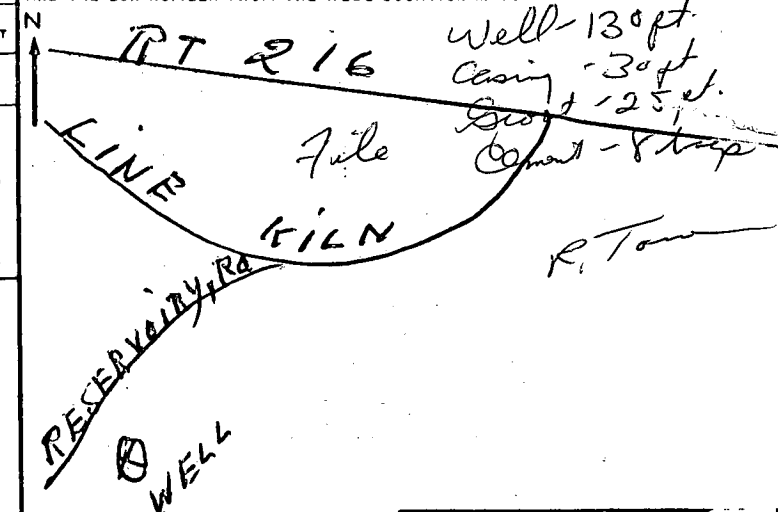

BOX NUMBER		E 320		N 470	
NORTH COORDINATE		50 51 52 53 54 55			
EAST COORDINATE		57 58 59 60 61 62 63			
ELEVATION AT WELL HEAD (FEET)					

C 1 7319 (THIS NUMBER IS TO BE PUNCHED IN COLS. 3-6 ON ALL CARDS)	SEQUENCE NO. (WRA USE ONLY)	STATE OF MARYLAND WATER RESOURCES ADMINISTRATION TAWES STATE OFFICE BLDG ANNAPOLIS, MD. 21401 WELL COMPLETION REPORT	THIS REPORT MUST BE SUBMITTED WITHIN 30 DAYS AFTER WELL COMPLETION FILL IN THIS FORM COMPLETELY COUNTY NUMBER
DATE RECEIVED (WRA USE ONLY)	DATE WELL COMPLETED <u>9/16/75</u>	DEPTH OF WELL <u>120</u> 22 (TO NEAREST FOOT) 26	PERMIT NO. FROM "PERMIT TO DRILL WELL" <u>HO-13-1123</u> 28 29 30 31 32 33 34 35 36 37
OWNER <u>Neale & Neale Inc.</u> LAST NAME		FIRST NAME <u>Williams Construction Est.</u>	
STREET OR RFD <u>2106 Arcola Ave.</u>		POST OFFICE <u>Silver Spring MD.</u>	

WELL LOG STATE THE KIND OF FORMATIONS PENETRATED, THEIR COLOR, DEPTH, THICKNESS AND IF WATER BEARING <table border="1" style="width:100%; border-collapse: collapse;"> <tr> <th rowspan="2">DESCRIPTION (USE ADDITIONAL SHEETS IF NECESSARY)</th> <th colspan="2">FEET</th> <th rowspan="2">CHECK IF WATER BEARING</th> </tr> <tr> <th>FROM</th> <th>TO</th> </tr> <tr> <td rowspan="2" style="text-align: center; vertical-align: middle;"> 30 FT OF DIRT 90 FT OF GRAY ROCK </td> <td></td> <td></td> <td></td> </tr> <tr> <td></td> <td></td> <td></td> </tr> </table>	DESCRIPTION (USE ADDITIONAL SHEETS IF NECESSARY)	FEET		CHECK IF WATER BEARING	FROM	TO	30 FT OF DIRT 90 FT OF GRAY ROCK							GROUTING RECORD YES ☒ NO ☐ WELL HAS BEEN GROUTED (CIRCLE APPROPRIATE BOX) TYPE OF GROUTING MATERIAL (CIRCLE BOX) CEMENT ☒ BENTONITE CLAY ☐ NO. OF BAGS <u>9</u> NO. OF POUNDS <u>900</u> GALLONS OF WATER <u>70</u> DEPTH OF GROUT SEAL (TO NEAREST FOOT) FROM <u>0</u> FT. TO <u>28</u> FT. (ENTER 0 IF FROM SURFACE)	C 3 1 2 3 (SEQ. NO.) 6 PUMPING TEST HOURS PUMPED (TO NEAREST HOUR) <u>2</u> PUMPING RATE (GALLONS PER MINUTE TO NEAREST GALLON) <u>14</u> METHOD USED TO MEASURE PUMPING RATE <u>Sand pump</u> WATER LEVEL: (DISTANCE FROM LAND SURFACE) BEFORE PUMPING <u>40</u> (NEAREST FOOT) WHEN PUMPING <u>80</u> (NEAREST FOOT) TYPE OF PUMPED USED (CIRCLE APPROPRIATE BOX) (FOR PUMPING TEST) A AIR 27 P PISTON 27 T TURBINE 27 C CENTRIFUGAL 27 R ROTARY 27 O OTHER (DESCRIBE BELOW) 27 J JET 27 S SUBMERSIBLE 27
DESCRIPTION (USE ADDITIONAL SHEETS IF NECESSARY)		FEET			CHECK IF WATER BEARING										
	FROM	TO													
30 FT OF DIRT 90 FT OF GRAY ROCK															
CIRCLING APPROPRIATE BOXES ☐ A WELL WAS ABANDONED AND SEALED WHEN THIS WELL WAS COMPLETED ☐ E ELECTRIC LOG OBTAINED ☐ P TEST WELL CONVERTED TO PRODUCTION WELL I HEREBY CERTIFY THAT I HAVE COMPLIED WITH ALL CONDITIONS STATED ON THE ABOVE-CAPTIONED "PERMIT TO DRILL WELL", AND THAT INFORMATION CONTAINED IN THIS REPORT IS TRUE, ACCURATE, AND COMPLETE TO THE BEST OF MY KNOWLEDGE, INFORMATION AND BELIEF. DRILLERS NAME <u>Arthur P. Edmondson</u> (PLEASE PRINT) SIGNATURE <u>Arthur P. Edmondson</u>	CASING RECORD INSERT APPROPRIATE CODE BELOW S STEEL C CONCRETE P PLASTIC O OTHER MAIN CASING TYPE NOMINAL DIAMETER TOP (MAIN) CASING (NEAREST INCH) TOTAL DEPTH OF MAIN CASING (NEAREST FOOT) OTHER CASING (IF USED) DIAMETER (INCH) DEPTH (FEET) FROM TO SCREEN RECORD INSERT APPROPRIATE CODE BELOW S STEEL BR BRASS OR BRONZE HO OPEN HOLE P PLASTIC O OTHER C 2 1 2 3 (SEQ. NO.) 6 DEPTH (NEAREST WHOLE FOOT) 1 <u>110</u> FROM <u>30</u> TO <u>90</u> 2 <u>30</u> TO <u>90</u> 3 <u>30</u> TO <u>90</u> SLOT SIZE 1. <u>30</u> 2. <u>30</u> 3. <u>30</u> DIAMETER OF SCREEN <u>56</u> (NEAREST INCH) FROM <u>56</u> TO <u>60</u> GRAVEL PACK <u>56</u> TO <u>60</u> IF WELL DRILLED WAS A FLOWING WELL CIRCLE BOX <u>68</u> F WRA USE ONLY (NOT TO BE FILLED IN BY DRILLER) T 70 LOG INDICATOR 72 W Q 74 75 76 OTHER DATA AVAILABLE	PUMP INSTALLED TYPE OF PUMP (WRITE APPROPRIATE LETTER IN BOX - SEE ABOVE: A, C, J, P, R, S, T, O) DRILLER WILL INSTALL PUMP (CIRCLE APPROPRIATE BOX) YES ☐ NO ☒ CAPACITY: GALLONS PER MINUTE (TO NEAREST GALLON) <u>31</u> TO <u>35</u> PUMP HORSE POWER <u>37</u> TO <u>41</u> PUMP COLUMN LENGTH (NEAREST FOOT) <u>43</u> TO <u>47</u> CASING HEIGHT (CIRCLE APPROPRIATE BOX AND ENTER CASING HEIGHT) (+) ABOVE LAND SURFACE (NEAREST FOOT) (-) BELOW <u>2</u> (NEAREST FOOT) LOCATION OF WELL ON LOT SHOW PERMANENT STRUCTURE SUCH AS BUILDINGS, SEPTIC TANKS, AND/OR OTHER LAND MARKS AND INDICATE NOT LESS THAN TWO DISTANCES (MEASUREMENTS TO WELL) <u>RESERVATORY RD</u> <u>WELL</u>													

B 1 0250		SEQUENCE NO. (WRA USE ONLY)	STATE OF MARYLAND WATER RESOURCES ADMINISTRATION TAWES STATE OFFICE BLDG., ANNAPOLIS, MARYLAND 21401 APPLICATION FOR PERMIT TO DRILL WELL		WRA PERMIT NUMBER 10-34-402
1 2 3 (SEQ. NO.) 6 (THIS NUMBER IS TO BE PUNCHED IN COLS. 3-6 ON ALL CARDS)		FILL IN THIS FORM COMPLETELY			

DATE RECEIVED (WRA USE ONLY)	OWNER <u>NEALE & NEALE INC</u> COL 15 LAST NAME FIRST NAME COL. 34
STREET OR RFD <u>2106 BRADLEY AVE</u> COL 36	66 BRADLEY AVE 9347 COL. 55
POST OFFICE <u>SILVER SPRING MD 20910</u> COL 57	COL. 76

B 1 CONTINUED		DRILLER INFORMATION	
1 2 3 (SEQ. NO.) 6	DATE <u>9/11/75</u>	LICENSE NUMBER <u>281</u> 77 80	
FIRST NAME <u>William B</u>		DRILLER <u>William B</u>	LAST NAME <u>Thompson</u>
SIGNATURE <u>William B Thompson</u>			

B 2		WELL INFORMATION	
1 2 3 (SEQ. NO.) 6	MAXIMUM PUMPING RATE (GALLONS PER MINUTE) <u>6</u> 8 12		
AVERAGE DAILY QUANTITY NEEDED (GALLONS PER DAY) <u>150</u> 14 20			

USE FOR WATER (CIRCLE APPROPRIATE BOX)	
☒ HOME (SINGLE OR DOUBLE HOUSEHOLD UNIT ONLY)	
☐ FARMING, AGRICULTURE, IRRIGATION	
☐ INDUSTRIAL, COMMERCIAL, STATE AND FEDERAL GOVERNMENT.	
☐ MUNICIPAL WATER SUPPLY	MUST HAVE STATE HEALTH DEPT. APPROVAL
☐ PRIVATE WATER COMPANY	
☐ TEST	

APPROXIMATE DEPTH OF WELL	<u>100</u> FEET 24 28
---------------------------	--------------------------

APPROXIMATE DIAMETER OF WELL	<u>6</u> (NEAREST INCH)
------------------------------	-------------------------

METHOD OF DRILLING USED (CIRCLE APPROPRIATE METHOD)	
☒ BORED (OR AUGERED)	☐ JETTED ☐ DRIVEN
☒ AIR-ROTARY	☐ AIR-PERCUSSION ☐ ROTARY (HYDRAULIC ROTARY)
☒ CABLE	☐ REVERSE-ROTARY ☐ DRIVE-POINT
OTHER (DESCRIBE)	

REPLACEMENT OR DEEPEINED WELLS (CIRCLE APPROPRIATE BOX)	
☒ THIS WELL WILL NOT REPLACE AN EXISTING WELL	
☐ THIS WELL WILL REPLACE A WELL THAT WILL BE ABANDONED AND SEALED	
☐ THIS WELL WILL REPLACE A WELL THAT WILL BE USED AS A STANDBY	
☐ THIS WELL WILL DEEPEIN AN EXISTING WELL PERMIT NUMBER OF WELL TO BE REPLACED OR DEEPEINED (IF AVAILABLE)	

NOT TO BE FILLED IN BY DRILLER (WRA USE ONLY)	
APPROPRIATION PERMIT NUMBER <u>54</u>	ENGINEER REVIEW DISTRICT NO. <u>63</u>
FORCE <u>67</u>	WRITE INITIALS IN BOX <u>68</u>
CONDITIONS <u>70</u>	<u>71</u> <u>72</u> <u>73</u> <u>74</u> <u>75</u> <u>76</u> <u>77</u> <u>78</u> <u>79</u>

B 4 CONTINUED		HEALTH DEPARTMENT APPROVAL	
1 2 3 (SEQ. NO.) 6	STATE HEALTH (CIRCLE BOX) <u>S</u>	COUNTY NAME <u>HOWARD</u>	COUNTY NO. <u>21000</u>
DATE <u>9/20/75</u>	APPROVED BY <u>Donald M. Morgan</u>		


B 5		SPECIAL CONDITIONS 8-63 (WRA USE ONLY)	
1 2 3 (SEQ. NO.) 6			

B 3		LOCATION OF WELL	
1 2 3 (SEQ. NO.) 6	COUNTY <u>Howard</u> (DO NOT ABBREVIATE COUNTY NAME)	21	
SUBDIVISION <u>11 Williams</u>		42	
SECTION <u>44</u>		46	LOT <u>48</u> 50
NEAREST TOWN <u>Croftville</u>		71	
MILES FROM TOWN (ENTER 0 IF IN TOWN) <u>3</u>		76 77 78	

B 4		DIRECTION FROM TOWN (CIRCLE APPROPRIATE BOX)	
1 2 3 (SEQ. NO.) 6	☒ NORTH ☐ EAST ☐ N E NORTHEAST ☐ S E SOUTHEAST		
☒ SOUTH ☐ WEST ☐ N W NORTHWEST ☐ S W SOUTHWEST			
NEAR WHAT ROAD <u>RT 216</u>	NORTH <u>32</u>	SOUTH <u>32</u>	EAST <u>32</u> WEST <u>30</u>
ON WHICH SIDE OF ROAD (CIRCLE APPROPRIATE BOX) ☒ N ☐ S		☐ E ☐ W	
DISTANCE FROM ROAD (ENTER DISTANCE AND CIRCLE APPROPRIATE BOX) <u>34</u>		<u>37</u> <u>38</u> <u>39</u>	

DRAW A SKETCH BELOW SHOWING LOCATION OF WELL IN RELATION TO NEARBY TOWNS, ROADS AND STREAMS WITH NORTH IN THE DIRECTION OF THE ARROW, AND GIVE DISTANCE FROM WELL TO NEAREST ROAD JUNCTION OR STREAM CROSSING SHOWN ON THE SKETCH. ALSO SHOW, BY MEANS OF AN "X", THE WELL LOCATION IN THE BOX BELOW AND THE BOX NUMBER FROM THE WELL LOCATION MAP.

N		RT 216	
LINE		RESERVOIR	
WELL			
BOX NUMBER	E <u>820</u>		
	N <u>170</u>		
NORTH COORDINATE	<u>50</u> <u>51</u> <u>52</u> <u>53</u> <u>54</u> <u>55</u>		
EAST COORDINATE	<u>57</u> <u>58</u> <u>59</u> <u>60</u> <u>61</u> <u>62</u> <u>63</u>		
ELEVATION AT WELL HEAD (FEET)	<u>65</u> <u>66</u> <u>67</u> <u>68</u>		

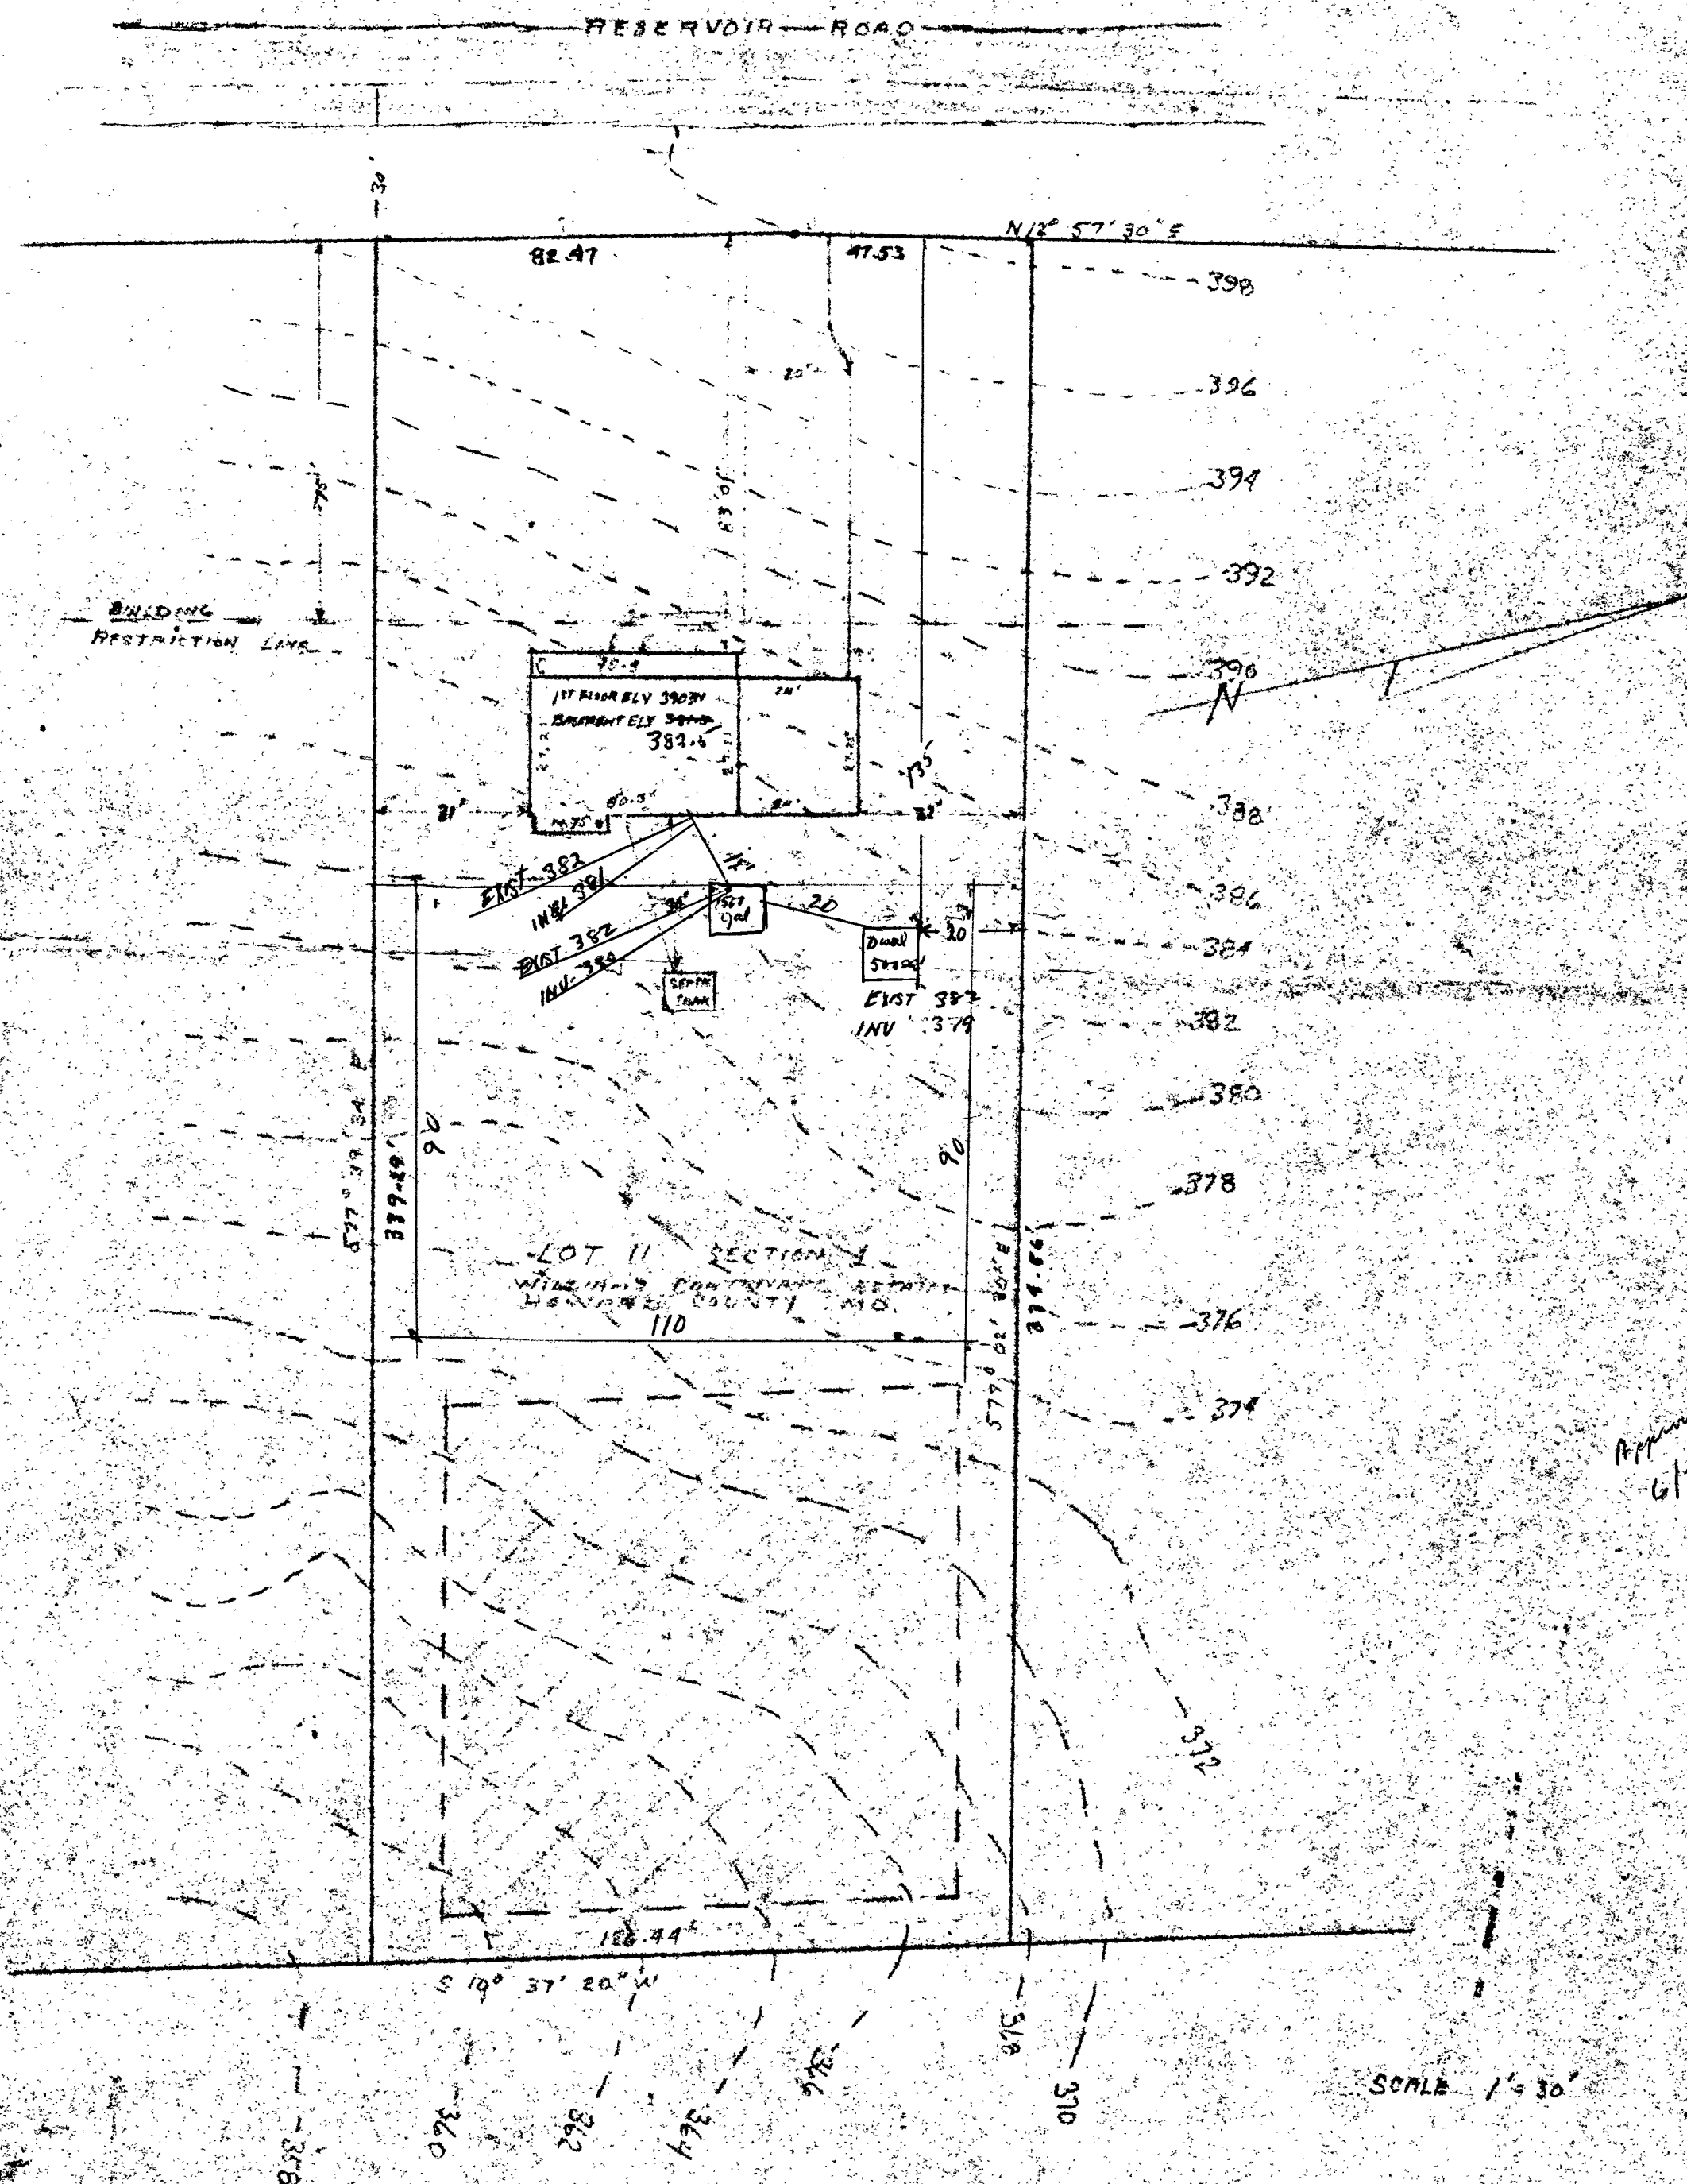

Approved
6/30/75
R.T.

6/30/75 OK'd (R.T.)
by CW

TOPOGRAPHIC SURVEY + HOUSE LOCATION
LOT II WILLIAMS CONTRIVANCE ESTATES
NEALE + NEALE INC
2106 ARCOLA AVE SILVER SPRING MD 20904
PM 949-1547

9/19-1547

I certify the above measurement and elevations are actual & correct for this

6/2/75 *Barbara A. Neal*