

PERMIT

SEWAGE DISPOSAL SYSTEM

DEPARTMENT OF HEALTH AND MENTAL HYGIENE

HOWARD COUNTY HEALTH DEPARTMENT

BUREAU OF ENVIRONMENTAL HEALTH

~~461-9933~~

313-2640

#291154
INDEXED

P 50722

A REPAIR

DISTRICT _____

DATE 6-5-95

DATE SYSTEM APPROVED 6/8/95

INSPECTOR C. Bel

Joseph Tunney Construction

IS PERMITTED TO INSTALL _____ ALTER X

ADDRESS 3697 Altondale Road, Resisterstown, Maryland 21136 PHONE 239-2372

SUBDIVISION _____ LOT _____ ROAD 1900 Woodstock Road

PROPERTY OWNER Mr. and Mrs. William R. Schwarz

ADDRESS 1900 Woodstock Road
Woodstock, Maryland

SEPTIC TANK CAPACITY 1500 GALLONS 1000 (Very septic)

NUMBER OF BEDROOMS 8 (4 for a total in the addition under permit #59614)

SQUARE FEET PER BEDROOM _____

LINEAR FEET OF TRENCH REQUIRED _____

REPAIR - PURPOSE - IN SUPPORT OF BUILDING PERMIT No. 59614 INCREASED IN NUMBER OF BEDROOMS IN ADDITION.

Call for inspection when ground is opened so sanitarian can recommend repair.

{ 11' Trench 83' + long in area of usual hole (#1)
inlet 4' maximum depth 6'; 2' + of stone; 3' width
Run trench toward Woodstock Road }

PLANS APPROVED BY C.B.S. in field for C.W./CBS DATE 6/8/95

COVER NO WORK UNTIL INSPECTED AND APPROVED

NEITHER THE HOWARD COUNTY COUNCIL NOR THE HEALTH DEPARTMENT IS RESPONSIBLE FOR THE SUCCESSFUL OPERATION OF ANY SYSTEM

NOTE: CLEANOUT REQUIRED EVERY 70 FEET OF SEWER LINE AND/OR AT 90° SWEEPS IN LINES FROM HOUSE TO DRAIN FIELDS, 90° ELBOWS NOT ACCEPTABLE.

NOTE: ALL PARTS OF SEPTIC SYSTEMS (I.E. TANK, DISTRIBUTION BOX TRENCHES) TO BE 100 FEET FROM WELL (UNLESS OTHERWISE SPECIFICALLY AUTHORIZED)

NOTE: IF DEEP TRENCH(ES) ARE USED CALL FOR INSPECTION BEFORE AND AFTER PLACING GRAVEL IN TRENCH(ES)

NOTE: NO DRY WELL SHALL EXCEED 15 FOOT IN DIAMETER NO ABSORPTION TRENCH TO EXCEED 100 FEET IN LENGTH

NOTE: ALL PIPE FROM HOUSE TO SEPTIC TANK MUST BE CAST IRON OR SCHEDULE 35/40 PVC OR ABS

PERMIT VOID AFTER TWO YEARS

NOTE: INSTALL STAND PIPE ON SEPTIC TANK AND DRY WELL STAND PIPES MUST BE 6 INCHES IN DIAMETER CAST IRON. CONCRETE OR TERRA COTTA OR PVA OR ABS ACCEPTED. IF TOP OF SEPTIC TANK IS DEEPER THAN 3 FEET. MANHOLE TO GRADE REQUIRED.

NOTE: DISTRIBUTION BOXES MUST HAVE BAFFLES

*INSTALLER IS RESPONSIBLE FOR OBTAINING FINAL APPROVAL ON THIS PERMIT

HD-260(6-90)

*CALL 461-9933 FOR INSPECTION OF SEPTIC SYSTEM.

P 50722



• {Plus old}
system

DATE SYSTEM APPROVED 6/8/95 INSPECTOR Charles Bryan Stueker

5/11/87
PM

PERMIT

SEWAGE DISPOSAL SYSTEM

MARYLAND STATE DEPARTMENT OF HEALTH

P 39250

A REPAIR

DISTRICT _____

HOWARD COUNTY

BUREAU OF ENVIRONMENTAL HEALTH

461-9933

INDEXED
INDEXED

DATE 4/28/87

DATE SYSTEM APPROVED 5/11/87

INSPECTOR C. Williams

Joseph P. Neubauer IS PERMITTED TO INSTALL _____ ALTER X

ADDRESS 5079 Landing Road, Elkridge, Md. 21227 PHONE 744-4153

SUBDIVISION _____ ROAD 1900 Woodstock Road ~~KATIE MCKNICHOLAS~~ LOT _____

PROPERTY OWNER Katie McNicholas

ADDRESS 1900 Woodstock Road

Woodstock, Maryland 21163

IF GARBAGE GRINDER IS USED INCREASE SEPTIC TANK CAPACITY BY 50% AND ABSORPTION AREA BY 22%.

GARBAGE GRINDER? YES _____ NO X

SEPTIC TANK CAPACITY 1000 GALLONS NUMBER OF BEDROOMS 3

REPAIR - REPLACEMENT OF METAL SEPTIC TANK WITH A 1000 GALLON TANK.

PLANS APPROVED BY C. Williams DATE 4/28/87

COVER NO WORK UNTIL INSPECTED AND APPROVED.

NEITHER THE HOWARD COUNTY COUNCIL NOR THE HEALTH DEPARTMENT IS RESPONSIBLE FOR THE SUCCESSFUL OPERATION OF ANY SYSTEM.

NOTE: CLEANOUT REQUIRED EVERY 70 FEET OF SEWER LINE AND/OR AT 90° SWEEPS IN LINES FROM HOUSE TO DRAIN FIELDS.

NOTE: ALL PARTS OF SEPTIC SYSTEMS (I.E., TANK, DISTRIBUTION BOX, TRENCHES) TO BE 100 FEET FROM WELL. (UNLESS OTHERWISE SPECIFICALLY AUTHORIZED)

NOTE: IF DEEP TRENCH(ES) ARE USED CALL FOR INSPECTION BEFORE AND AFTER PLACING GRAVEL IN TRENCH(ES).

NOTE: NO DRY WELL SHALL EXCEED 15 FOOT IN DIAMETER. NO ABSORPTION TRENCH TO EXCEED 100 FEET IN LENGTH.

NOTE: ALL PIPE FROM HOUSE TO SEPTIC TANK MUST BE CAST IRON OR SCHEDULE 40 PVC OR ABS.

PERMIT VOID AFTER TWO YEARS.

NOTE: INSTALL STAND PIPE ON SEPTIC TANK AND DRY WELL. STAND PIPES MUST BE 6 INCHES IN DIAMETER. CAST IRON, CONCRETE OR TERRA COTTA OR PVC OR ABS ACCEPTED. IF TOP OF SEPTIC TANK IS DEEPER THAN 3 FEET, MANHOLE TO GRADE REQUIRED.


NOTE: DISTRIBUTION BOXES MUST HAVE BAFFLES.

***INSTALLER IS RESPONSIBLE FOR OBTAINING FINAL APROVAL ON THIS PERMIT**

*CALL 461-9933 FOR INSPECTION OF SEPTIC SYSTEMS.

EH - 2-1186

P 39250

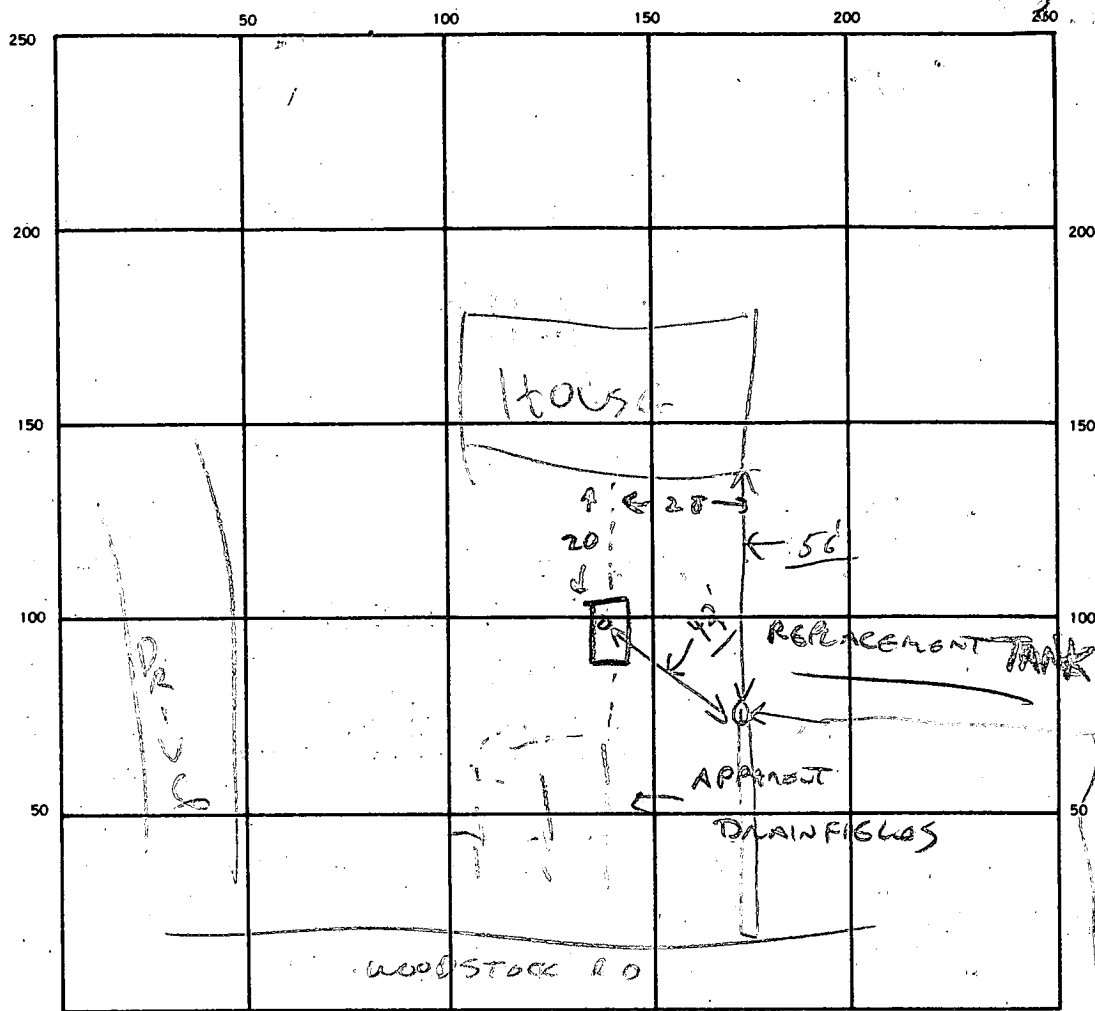

SEPTIC TANK, LEVEL 1000 G CLEANOUTS STV

DISTRIBUTION BOX, LEVEL _____

DRAIN FIELD/TILE FIELD, DEPTH _____ FT. TRENCH WIDTH _____ FT. INLET DEPTH _____ FT.

EFFECTIVE GRAVEL DEPTH _____ FT. TOTAL LENGTH _____ FT.

NUMBER OF TRENCHES _____ ONE SIDEWALL/BOTTOM AREA _____ SQ. FT.

DRYWELL INSIDE DIAMETER _____ FT. EFFECTIVE DEPTH BELOW INLET _____ FT.

ABSORBENT AREA _____ SQ. FT.

REMARKS REPLACED COLLAPSED METAL TANK WITH 1000 G. CONCRETE,
PVC PIPING JOINED TO EXISTING TERRA COTTA,
THE FIELDS APPEAR FUNCTIONAL 5/11/87 CH

DATE SYSTEM APPROVED


5/11/87

INSPECTOR

Chadler

21163.

160.36'

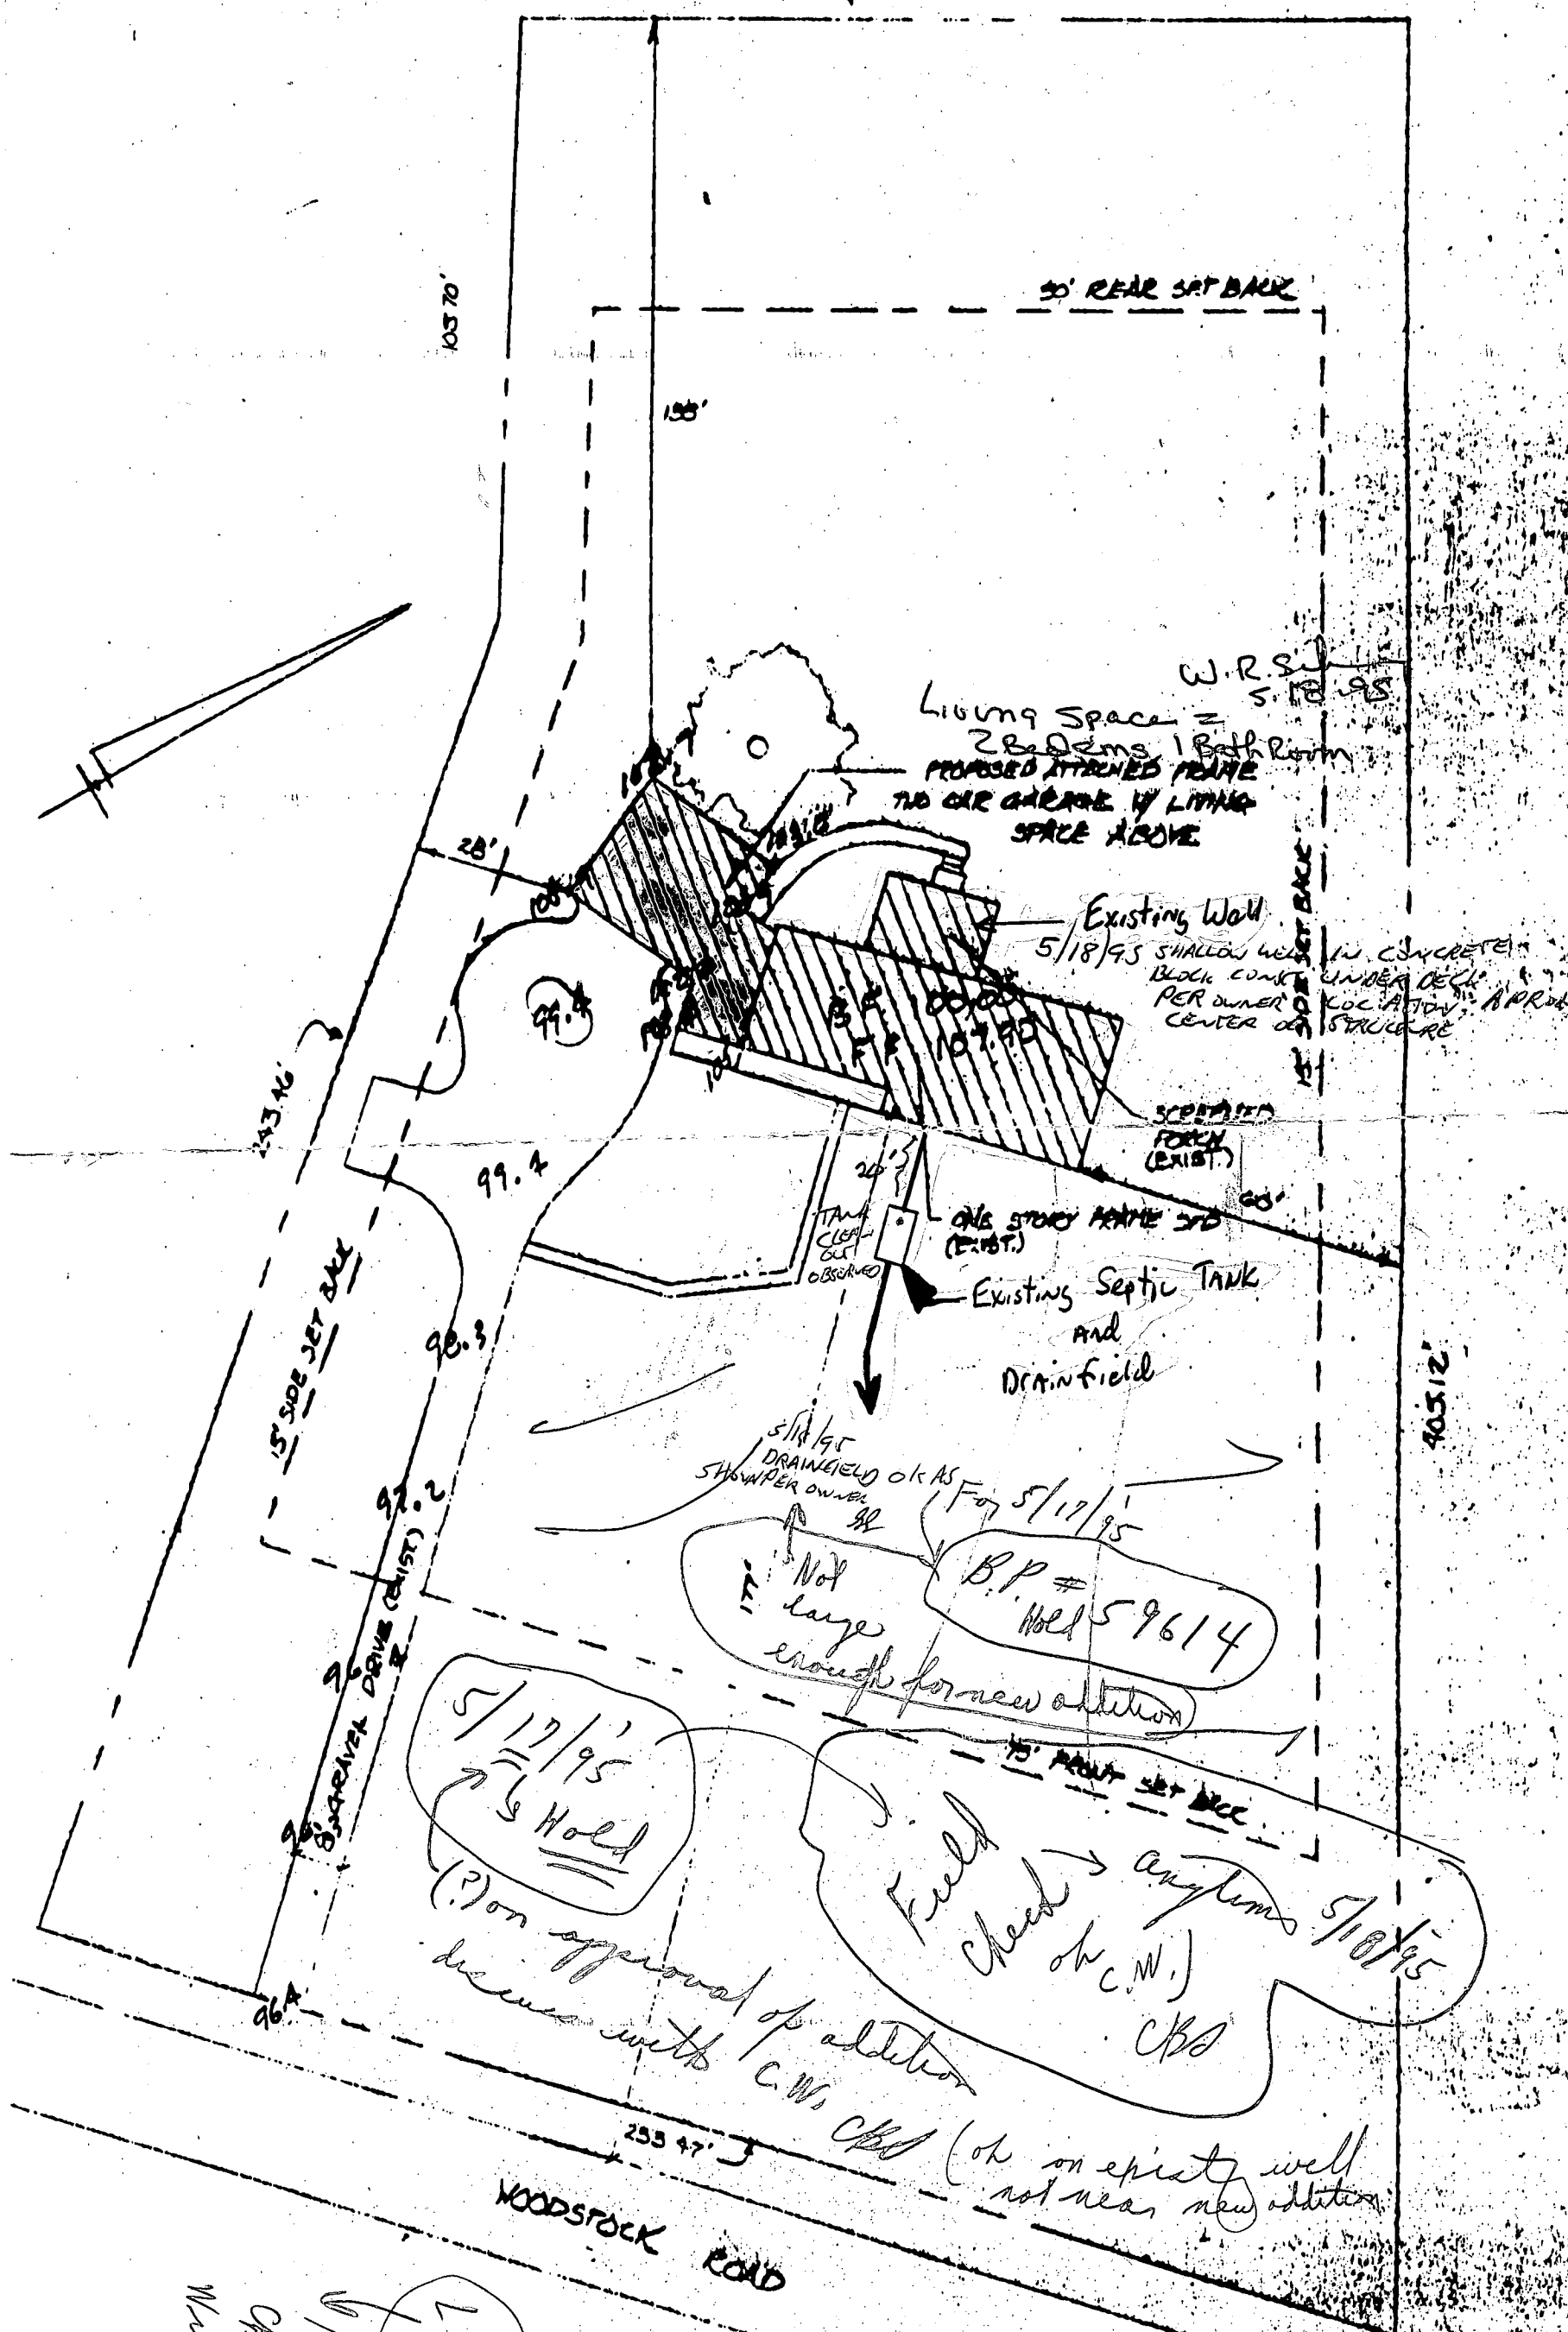

Wad

W. Neel

12/13

MOORE BUILDERS, INC.

1316 Lafayette Avenue, Baltimore, MD 21207

(410) 744-1077

MHIC # 12001

May 25, 1995

Charles B. Streaker, Sr., R.S.
Howard County Bureau of Environmental Health
3525-H Ellicott Mills Drive
Ellicott City, MD 21043

RE: Mr. and Mrs. William Schwarz
1900 Woodstock Road
Serial Number: 59614
Proposed Use: Addition

Dear Mr. Streaker:

This letter is to follow-up our conversation on May 24, 1995. Enclosed please find the floor plan for the proposed renovation at the Schwarz residence.

Currently the residence has three bedrooms, one full bathroom, and one half bathroom. The proposed project will turn one of the existing bedrooms into an enlarged breakfast room. As noted on the drawing, interior renovations to the existing house include a combination study/guest room. This room will primarily be used as a study/home office. The new addition will add two new bedrooms and two full bathrooms to the residence making a total of four bedrooms and three and half baths.

The owners are planning to do further renovations when finances allow which will convert the two existing bedrooms, full bath and half bath into a master suite consisting of a master bedroom and master bathroom, however, this is not part of the current permit application. This renovation will then make the house contain only three full baths. (See attached floor plan for master suite.)

In the event that you determine that the existing septic system must be upgraded, I would request that you approve the building permit application with the condition that upgrades to the septic system be performed. Please provide what upgrades will be required to meet your requirements.

In the event that you have any questions, please feel free to contact me.

Sincerely,

John F. Moore

John F. Moore
President

JFM:mim

1/c to Mr. Schwarz
5/30/95 or 5/31/95
2' stone
83' long; 3' wide only
Don't depend on [unclear]
CW, 4/100
THICK [unclear]