

8/31/95
ASAP 9/1/95
ASAP

PERMIT

SEWAGE DISPOSAL SYSTEM

DEPARTMENT OF HEALTH AND MENTAL HYGIENE

05-357802

HOWARD COUNTY HEALTH DEPARTMENT

BUREAU OF ENVIRONMENTAL HEALTH

461-9933x 313-2640

INDEXED

P 50843

A REPAIR

DISTRICT

DATE 8-25-95

DATE SYSTEM APPROVED 8-1-95

INSPECTOR Am

Alice Wright

IS PERMITTED TO INSTALL ALTER X

ADDRESS 11954 Simpson Road, Clarksville, MD 21029

PHONE 301-797-1337

SUBDIVISION LOT ROAD 11954 Simpson Road

PROPERTY OWNER Alice Wright

ADDRESS

SEPTIC TANK CAPACITY GALLONS

NUMBER OF BEDROOMS 3

125 SQUARE FEET PER BEDROOM

LINEAR FEET OF TRENCH REQUIRED 75

REPAIR - PURPOSE - SEPTIC SYSTEM HAS FAILED.

Call for inspection when ground is opened so sanitarian can recommend repair.

Install one trench off existing drywell, on contour
trench inlet 2.5', bottom 7.5', slope 5'

PLANS APPROVED BY

John K. See

DATE 8/31/95

COVER NO WORK UNTIL INSPECTED AND APPROVED

NEITHER THE HOWARD COUNTY COUNCIL NOR THE HEALTH DEPARTMENT IS RESPONSIBLE FOR THE SUCCESSFUL OPERATION OF ANY SYSTEM

NOTE: CLEANOUT REQUIRED EVERY 70 FEET OF SEWER LINE AND/OR AT 90° SWEEPS IN LINES FROM HOUSE TO DRAIN FIELDS, 90° ELBOWS NOT ACCEPTABLE.

NOTE: ALL PARTS OF SEPTIC SYSTEMS (I.E. TANK, DISTRIBUTION BOX TRENCHES) TO BE 100 FEET FROM WELL (UNLESS OTHERWISE SPECIFICALLY AUTHORIZED)

NOTE: IF DEEP TRENCH(ES) ARE USED CALL FOR INSPECTION BEFORE AND AFTER PLACING GRAVEL IN TRENCH(ES)

NOTE: NO DRY WELL SHALL EXCEED 15 FOOT IN DIAMETER NO ABSORPTION TRENCH TO EXCEED 100 FEET IN LENGTH

NOTE: ALL PIPE FROM HOUSE TO SEPTIC TANK MUST BE CAST IRON OR SCHEDULE 35/40 PVC OR ABS

PERMIT VOID AFTER TWO YEARS

NOTE: INSTALL STAND PIPE ON SEPTIC TANK AND DRY WELL STAND PIPES MUST BE 6 INCHES IN DIAMETER CAST IRON, CONCRETE OR TERRA COTTA OR PVA OR ABS ACCEPTED. IF TOP OF SEPTIC TANK IS DEEPER THAN 3 FEET. MANHOLE TO GRADE REQUIRED.

NOTE: DISTRIBUTION BOXES MUST HAVE BAFFLES

*INSTALLER IS RESPONSIBLE FOR OBTAINING FINAL APPROVAL ON THIS PERMIT


BLDG. PERMIT SIGNED
AND RETURNED 5/13/00

POOL

BLDG. PERMIT SIGNED

AND RETURNED 2/1/01
200128320 GARAGE

P 50843

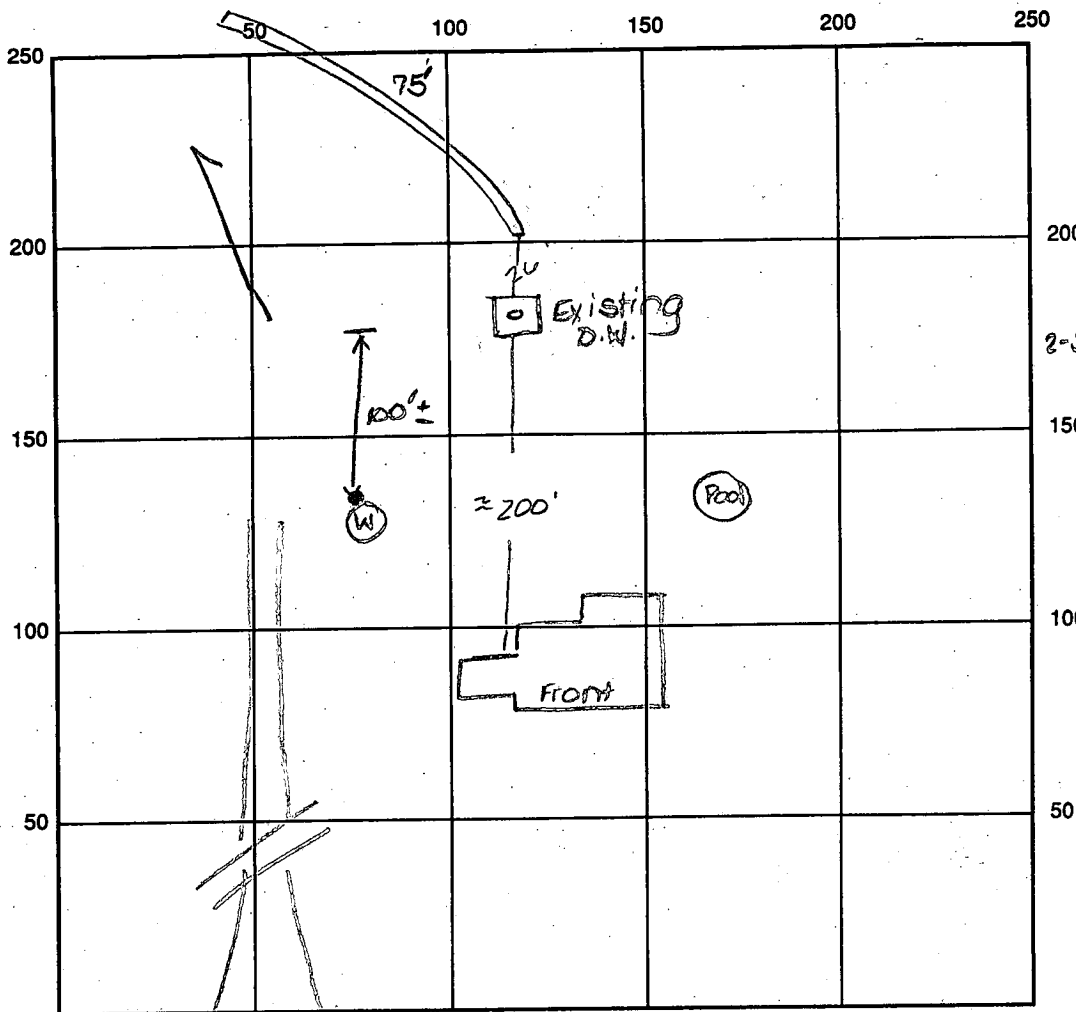

INDICATE NORTH - NAME ADJOINING ROADWAY AS BASE LINE

Simpson Road

SEPTIC TANK LEVEL Existing CLEANOUTS one on d.w., ? on s.t.

DISTRIBUTION BOX LEVEL N/A

DRAIN FIELD/TITLE DEPTH 7.5' FT. TRENCH WIDTH 2 FT. INLET DEPTH 2.5 FT.

EFFECTIVE GRAVEL DEPTH 5" FT. TOTAL LENGTH 75' FT.

NUMBER OF TRENCHES 1 ONE SIDEWALL ~~BOX~~ AREA 375 SQ. FT.

DRYWALL INSIDE DIAMETER Existing FT. EFFECTIVE DEPTH BELOW INLET _____ FT.

ABSORBENT AREA _____ SQ. FT.


REMARKS: 8/31/95 A.M. OK to begin trench at site of perc hole. DKS

8/31/95 P.M. OK to store trench and continue. DKS

9/1/95 OK to cover all work final Au

DATE SYSTEM APPROVED 9-1-95

INSPECTOR Amey McMiller

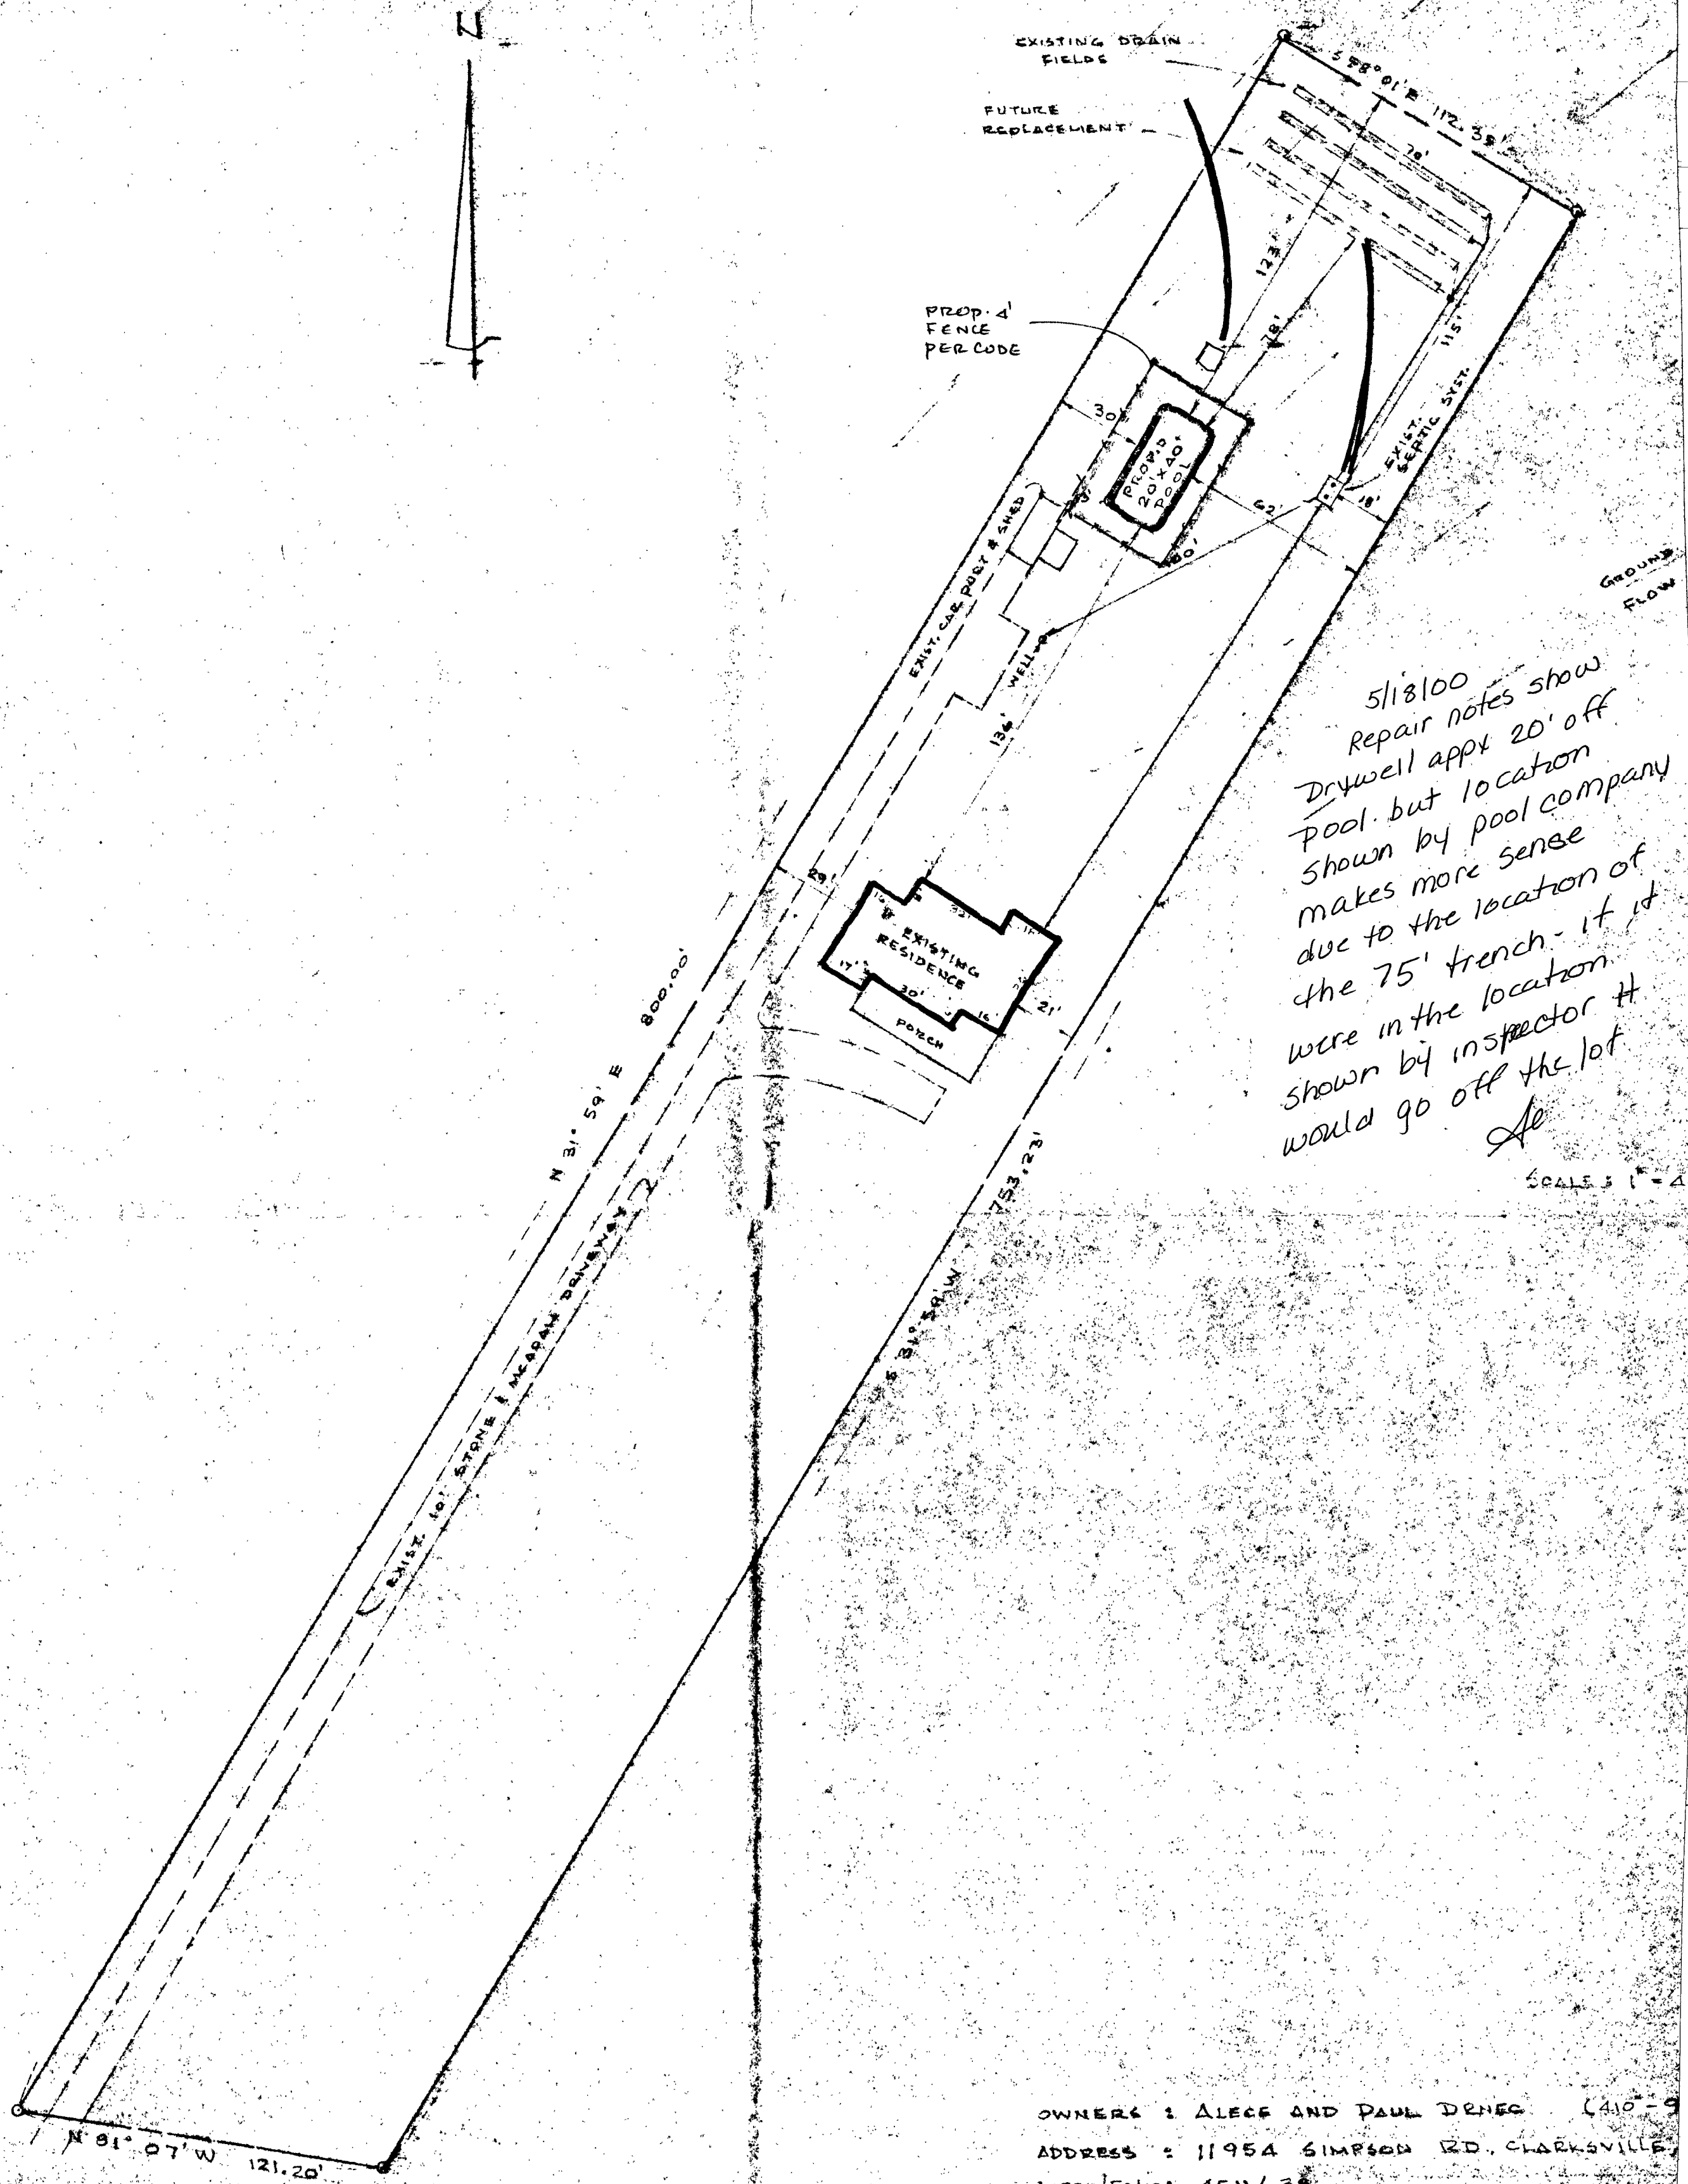


5/18/00
 Repair notes show
 Drywell approx 20' off
 Pool but location
 shown by pool company
 makes more sense
 due to the location of
 the 75' trench - if it
 were in the location
 shown by inspector it
 would go off the lot
 A

SCALE: 1" = 40'

OWNERS : ALECE AND PAUL DRESC (410-9
 ADDRESS : 11954 SIMPSON RD. CLARKSVILLE
 LIBER/FOLIO: 4511/38
 TAX ACCT : 357802
 E.D. : 5
 AREA : 2.0 AC.

5/16/00

127.35'

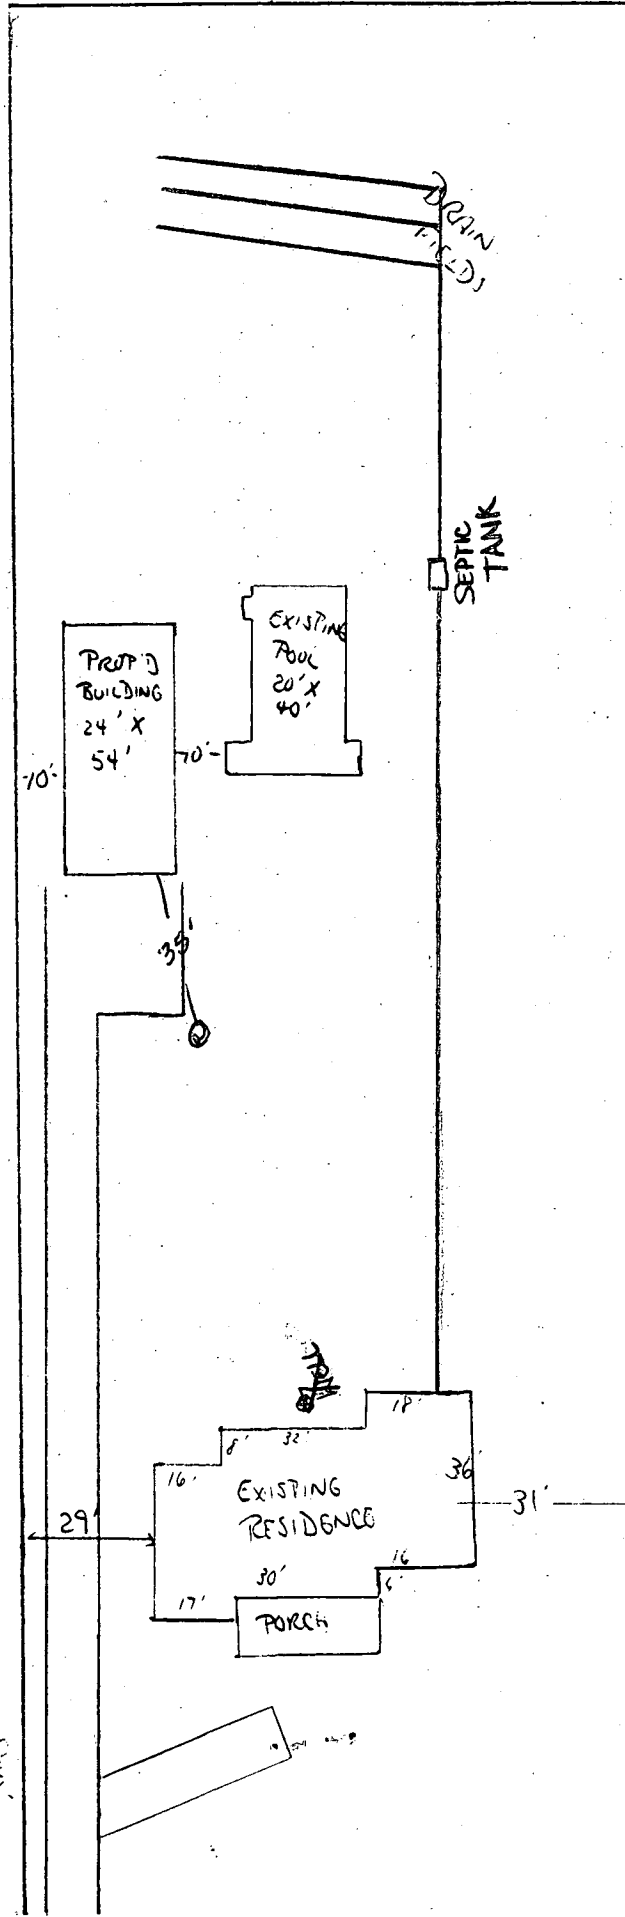

2/8/08
shown garage/storage
building will have
no impact on ex well
or septic. OK to proceed.

[Signature]

16

753.23'