

PERMIT

SEWAGE DISPOSAL SYSTEM

DEPARTMENT OF HEALTH AND MENTAL HYGIENE

INDEXED

03-291257

HOWARD COUNTY HEALTH DEPARTMENT

BUREAU OF ENVIRONMENTAL HEALTH

461-9933 313-2640

P 50914

A Repair

DISTRICT _____

DATE 18-3-95

DATE SYSTEM APPROVED 10/6/95

INSPECTOR GS/DKS

Edward Linsen Meyer Plumbing & Heating IS PERMITTED TO INSTALL ALTER ☒

ADDRESS 9304 Migan Road Randallston, MD 21133 PHONE (410) 922-8172

SUBDIVISION _____ LOT _____ ROAD 1950 Woodstock Road

PROPERTY OWNER Ms. Shirley Merkle

ADDRESS 1950 Woodstock Road
Woodstock, Maryland 21163

SEPTIC TANK CAPACITY 1000 GALLONS

NUMBER OF BEDROOMS 3

SQUARE FEET PER BEDROOM

LINEAR FEET OF TRENCH REQUIRED

REPAIR - PURPOSE TO REPLACE METAL SEPTIC TANK. 10/02/95

Call for inspection when ground is opened and concrete septic tank is in place.

PLANS APPROVED BY _____ DATE _____

COVER NO WORK UNTIL INSPECTED AND APPROVED

NEITHER THE HOWARD COUNTY COUNCIL NOR THE HEALTH DEPARTMENT IS RESPONSIBLE FOR THE SUCCESSFUL OPERATION OF ANY SYSTEM

NOTE: CLEANOUT REQUIRED EVERY 70 FEET OF SEWER LINE AND/OR AT 90° SWEEPS IN LINES FROM HOUSE TO DRAIN FIELDS, 90° ELBOWS NOT ACCEPTABLE.

NOTE: ALL PARTS OF SEPTIC SYSTEMS (I.E. TANK, DISTRIBUTION BOX TRENCHES) TO BE 100 FEET FROM WELL (UNLESS OTHERWISE SPECIFICALLY AUTHORIZED)

NOTE: IF DEEP TRENCH(ES) ARE USED CALL FOR INSPECTION BEFORE AND AFTER PLACING GRAVEL IN TRENCH(ES)

NOTE: NO DRY WELL SHALL EXCEED 15 FOOT IN DIAMETER NO ABSORPTION TRENCH TO EXCEED 100 FEET IN LENGTH

NOTE: ALL PIPE FROM HOUSE TO SEPTIC TANK MUST BE CAST IRON OR SCHEDULE 35/40 PVC OR ABS


PERMIT VOID AFTER TWO YEARS

NOTE: INSTALL STAND PIPE ON SEPTIC TANK AND DRY WELL STAND PIPES MUST BE 6 INCHES IN DIAMETER CAST IRON, CONCRETE OR TERRA COTTA OR PVA OR ABS ACCEPTED. IF TOP OF SEPTIC TANK IS DEEPER THAN 3 FEET, MANHOLE TO GRADE REQUIRED.

NOTE: DISTRIBUTION BOXES MUST HAVE BAFFLES

***INSTALLER IS RESPONSIBLE FOR OBTAINING FINAL APPROVAL ON THIS PERMIT**

P50914

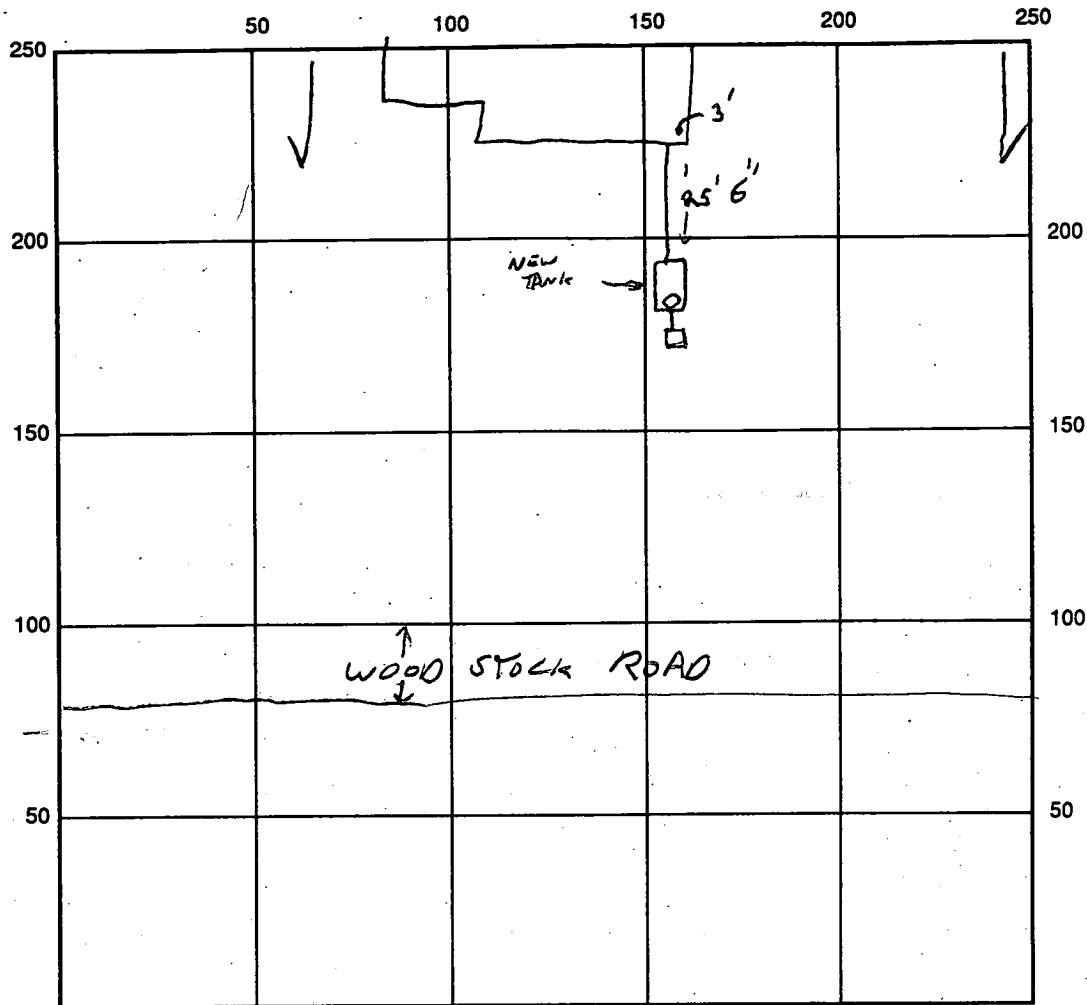

INDICATE NORTH - NAME ADJOINING ROADWAY AS BASE LINE

SEPTIC TANK LEVEL OK - 1500 GAL TANK

CLEANOUTS _____

DISTRIBUTION BOX LEVEL _____

DRAIN FIELD/TITLE DEPTH _____ FT. TRENCH WIDTH _____ FT. INLET DEPTH _____ FT.

EFFECTIVE GRAVEL DEPTH _____ FT. TOTAL LENGTH _____ FT.

NUMBER OF TRENCHES _____ ONE SIDEWALL/BOTTOM AREA _____ SQ. FT.

DRYWALL INSIDE DIAMETER _____ FT. EFFECTIVE DEPTH BELOW INLET _____ FT.

ABSORBENT AREA _____ SQ. FT.

REMARKS: TANK INLET @ 7' BOTTOM OF TANK @ 12' MANHOLE REQUIRED
TO GRADE, INSTALLER WILL DIG BACK TO OLD DRYWELL TRENCH IN ORDER
TO ACHIEVE GRAVITY FLOW, PROBABLE DRUM TRAP CONNECTION PREVIOUSLY.
INSTALLER AGREED TO DOCUMENT CONNECTION TO DRYWELL TANK. 4/DRAWING +
PHOTOS DUE TO CONCERN IN ACHIEVING GRAVITY FLOW, COVER AS COMPLETED
CALL IF FURTHER PROBLEMS ENCOUNTERED

DATE SYSTEM APPROVED 10/6/95 INSPECTOR GS/DS

10/6/95 p.m. verified that contractor will forward
drawing & photos of completed work. DCS

9/15/75
12:00 A.M.
9/16/75

PERMIT

9/15/75
Partial
R.L.

SEWAGE DISPOSAL SYSTEM

P 22121
A

MARYLAND STATE DEPARTMENT OF HEALTH

HOWARD COUNTY

ELLICOTT CITY

INDEXED
File

DISTRICT 2

DATE 9/11/75

Vernon Mathena IS PERMITTED TO INSTALL ALTER ☒

ADDRESS Davis Avenue, Woodstock, Md. PHONE 328-2265

A SEWAGE DISPOSAL SYSTEM LOCATED AT

SUBDIVISION ROAD 1950 Woodstock Road LOT 1st house on left past corner of

PROPERTY OWNER A. Denwood Merkle Woodstock Road & Rt. 99

ADDRESS 1950 Woodstock Road, Woodstock, Md. 21163

SPECIFICATIONS

DRAIN FIELD DEPTH FEET, BOTTOM AREA SQ. FT.

SEEPAGE PITS ABSORBENT SIDE-WALL AREA SQ. FT.

SEPTIC TANK CAPACITY GALLONS

FOR GARBAGE GRINDER, INCREASE DISPOSAL AREA 22% & TANK CAPACITY 50%.

OTHER REPAIR - Call for inspection when ground is opened up so Sanitarian can recommend repair system.


9/15/75 50 ft trench, 10' deep, 7' stone R.M.

PLANS APPROVED BY D. W. Monaghan DATE 9/11/75

FILL SEPTIC TANK AND DISTRIBUTION BOX WITH WATER BEFORE CALLING FOR AN INSPECTION. COVER NO WORK UNTIL INSPECTED AND APPROVED.

NEITHER THE HOWARD COUNTY COMMISSIONERS NOR THE HEALTH DEPARTMENT IS RESPONSIBLE FOR THE SUCCESSFUL OPERATION OF ANY SYSTEM.

222121

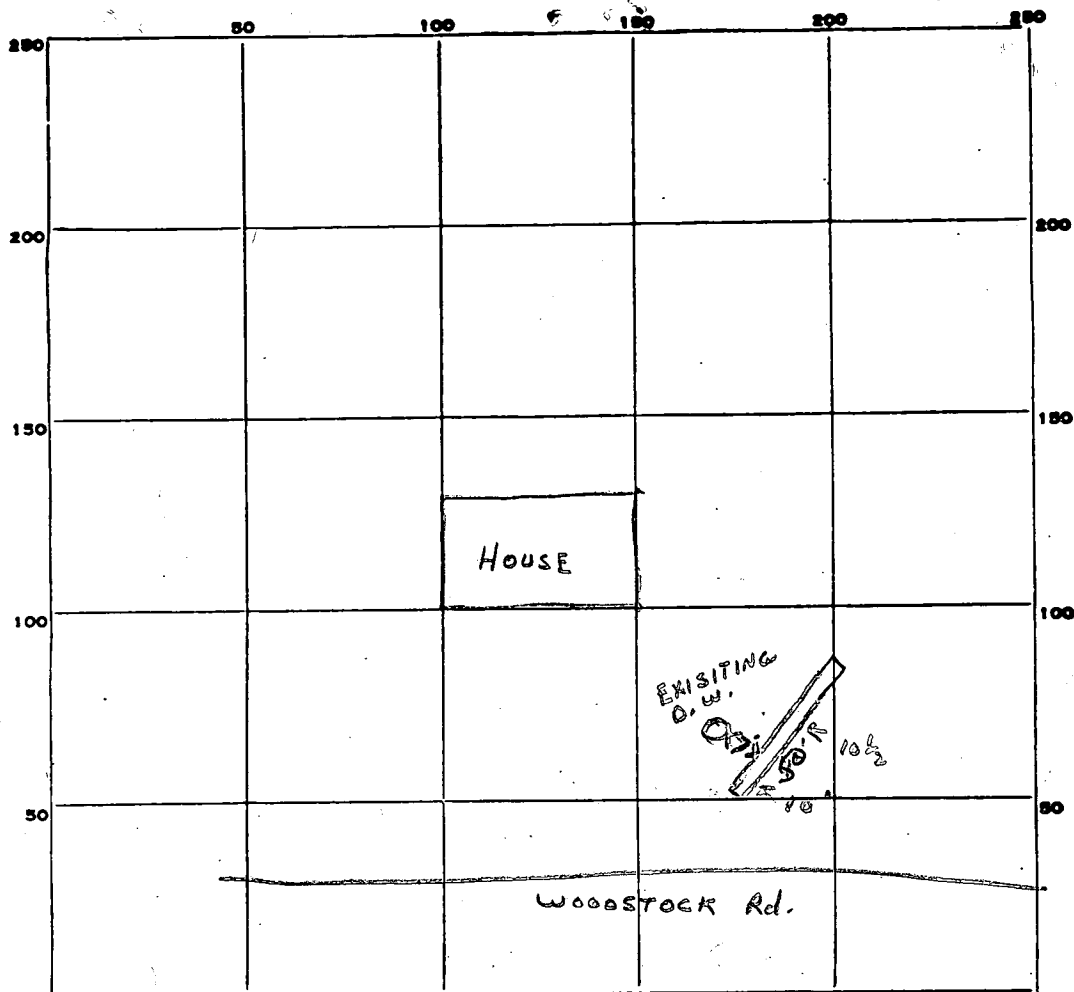

INDICATE NORTH. - NAME ADJOINING ROADWAY AS BASE LINE.

PERMIT CARD Signed

SEPTIC TANK, LEVEL _____

CLEANOUTS _____

DISTRIBUTION BOX, LEVEL _____

TILE FIELD, DEPTH 10-10 1/2 FT. TRENCH WIDTH 2 FT.

GRAVEL DEPTH 7-7 1/2 ft IN: TOTAL LENGTH 50 FT.

NUMBER OF TRENCHES 1 Subsidiary TOTAL BOTTOM AREA 350 ft 375 ft

SEEPAGE PITS, INSIDE DIAMETER _____ FT. DEPTH BELOW INLET _____ FT.

ABSORBENT AREA _____ SQ. FT.

REMARKS 9/15/75 - 40 ft of trench seen. Have
OK to complete trench and install stone

DATE SYSTEM APPROVED 9/16/75

INSPECTOR R. Toney

Edward L. Linsenmeyer

October 6, 1995

REGISTERED PLUMBING AND HEATING


9304 MIGAN ROAD, RANDALLSTOWN, MD 21133

TELEPHONE 922-8172

Septic system repair drawing

1950 Woodstock Rd 21163

Permit # P-50914

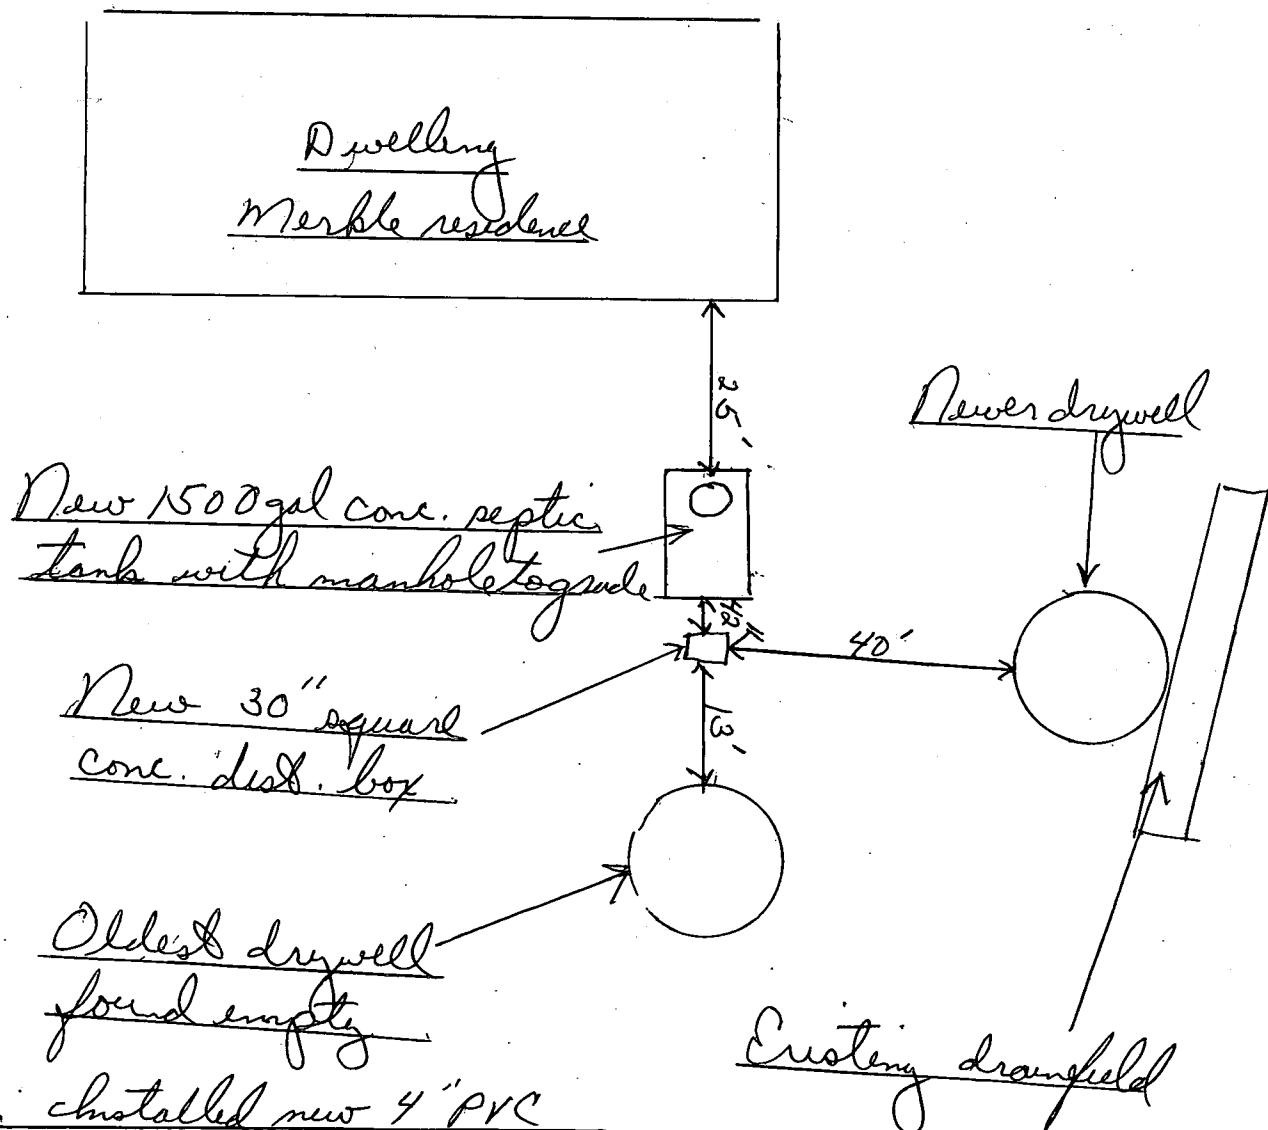

Note: installed new 4" PVC
sched. 40 drain piping from new
tank to new box and to both drywells.

Edward L. Linsenmeyer

REGISTERED PLUMBING AND HEATING

9304 MIGAN ROAD, RANDALLSTOWN, MD 21133

TELEPHONE 922-8172

Allen,

The job went very well. I was able to connect both drywells by gravity with no problem and was able to install the new 4" PVC drain pipe to the newer drywell to above the drywell outlet to newer overflow drainfield. The oldest drywell was completely empty and dry. Enclosed are the pictures and drawing as you requested. If you have any questions please call me at 410-922-8172.

Sincerely,
Edward L. Linsenmeyer

P.S. I did the best that I could with the pictures as it was after dark when we completed the work.

STATE OF MARYLAND

HOWARD COUNTY HEALTH DEPARTMENT

ELLICOTT CITY, MARYLAND

Date

Nov. 7

1958

Name

Garcia & Lidey

Telephone No.

DETAILED LOCATION OF SITE, DEVELOPMENT,
SECTION, ROAD, LOT NO. & ELECTION DISTRICT

Rea Field Rd + Rea Cr. Rd
Deerwood Park

PRIVATE SEWAGE DISPOSAL SYSTEMS

Testing and Inspection

\$

Installation Permit

\$

1.00

Received
Payment

J. Fredericks

00238

TRIPLICATE

THIS RECEIPT IS NOT
A PERMIT AND IT IS
NOT A WARRANTY OF
PERFORMANCE OF
THE SYSTEM THAT
IS INSTALLED

HOWARD COUNTY HEALTH DEPARTMENT

PERMIT-SEWAGE DISPOSAL SYSTEM

INDEXED

Permit No. 00238

District 3

Date 11-7-58

Garrett and Heidi Hideo

is permitted to Install ☐

Alter ☒

a sewage disposal system located: Old Frederick Rd. and Old Court Rd.

Denwood Merkle

Property Owner Denwood Merkle

Address Woodstock

Location above

SPECIFICATIONS:

TILE FIELDS ☐ Length ☐ Width ☐ Depth ☐ Bottom area ☐

SEEPAGE PITS ☐ Number ☐ Inside Diam. ☐ Depth below inlet ☐

Absorbent area ☐

SEPTIC TANK CAPACITY ☐

OTHER: Adding one dry well and distribution box. Merkle has one dry well
supplementing with another.

Fee \$100


PLANS APPROVED BY: Milton M. Beekman,

Fill septic tank and distribution box with water before calling for inspection.

No work is to be covered until inspected and approved.

Neither the Howard County Commissioners nor the Health Department is responsible for the successful operation of any installation.

P. 44238

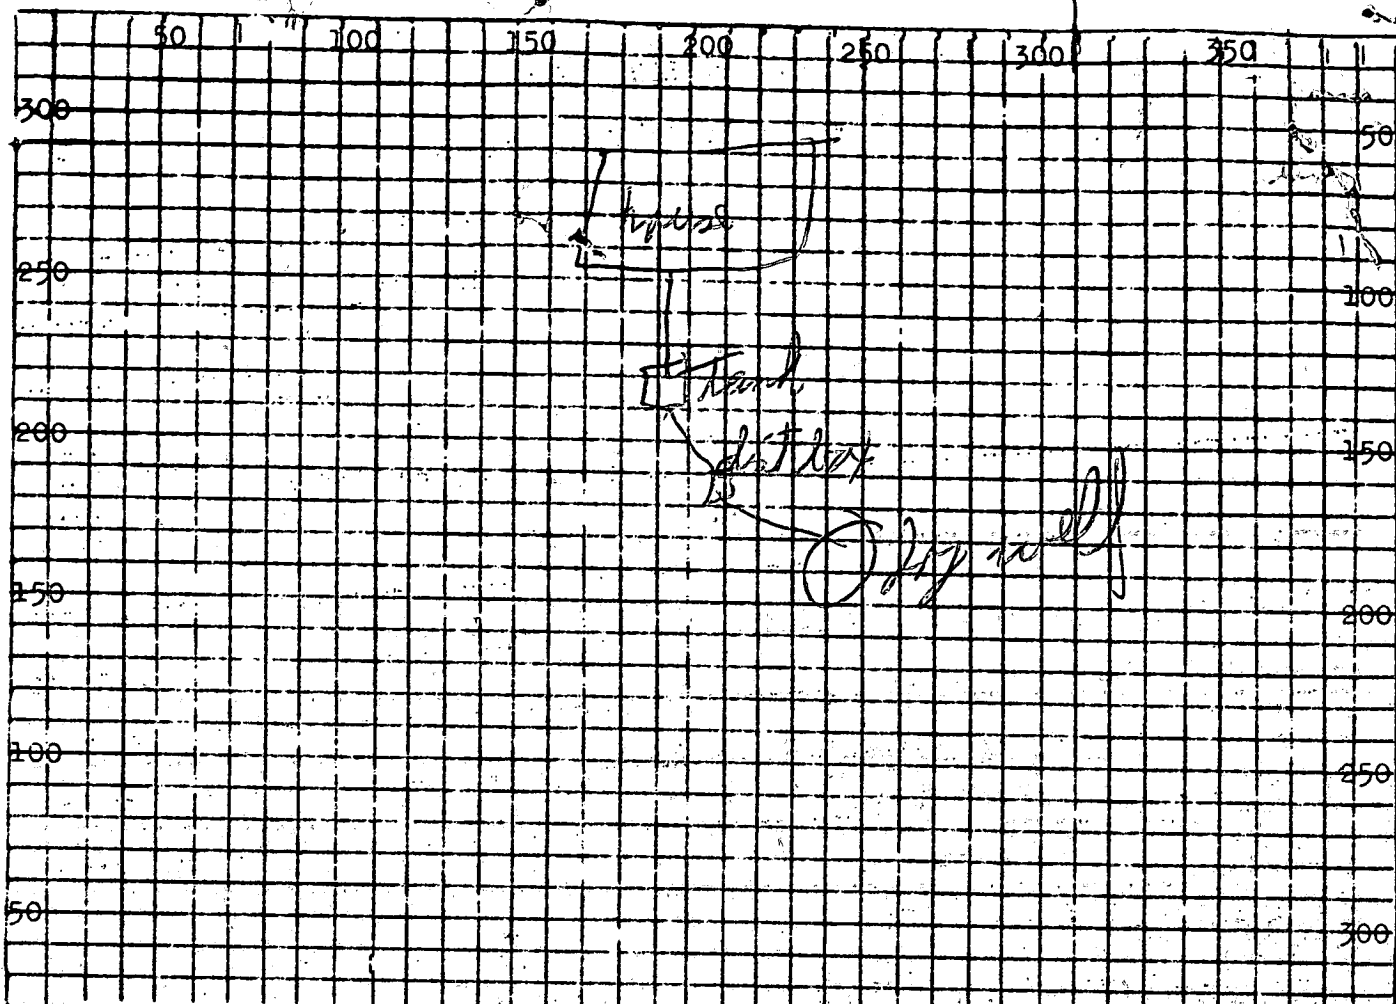

Each square = 10 feet.

Locate system with reference to house and adjoining properties & Perc. Tests.

PERMIT CARD ☐ *NO*

Septic Tank ☒ Distance from Ground Surface ☐ Filled ☐

Level ☐ Cleanouts ☐

Distribution Box: Filled ☐ Level ☐

Tile Field:

Depth of Tile ☐

Width of Trenches ☐

Grade Board ☐

Total Length ☐

Gravel Depth ☐

Fall ☐

No. of Trenches ☐

Backfill on Hand ☐

Seepage Pit:

Inside Diameter ☐

Depth below inlet ☐

Remarks:

*old system - 1 dry well added
to dist. box
system covered*

Date System Approved and
Ready for Covering

11/10/58

Inspector

P/W