

PERMIT

SEWAGE DISPOSAL SYSTEM

DEPARTMENT OF HEALTH AND MENTAL HYGIENE

P 511092

A 56429 CC

DISTRICT 3rd

DATE 11/5/98

DATE SYSTEM APPROVED 12-22-98

INSPECTOR JE

HOWARD COUNTY HEALTH DEPARTMENT

BUREAU OF ENVIRONMENTAL HEALTH

~~XXXXXX~~ 410-313-2640

INDEXED

Lehsac Corporation

IS PERMITTED TO INSTALL X ALTER

ADDRESS 202 Azar Court Baltimore, MD 21227 FAX 410-536-4210 PHONE (410) 242-6888

SUBDIVISION Gaither Hunt LOT 29 ROAD 11021 11020 Steeple Chase Court

PROPERTY OWNER Ryan Homes PAVE & MITZI CHRIST

ADDRESS

SEPTIC TANK CAPACITY 1250 GALLONS

NUMBER OF BEDROOMS 4

180 SQUARE FEET PER BEDROOM

LINEAR FEET OF TRENCH REQUIRED 240

TOP SEAM TANK REQUIRED

NOTE: HOUSE MOVED BACK 10'-15' FROM SITE PLAN

TRENCHES - Trench to be 3 feet wide. Inlet 3 feet below original grade. Bottom maximum depth 5 feet below original grade. Effective area begins at 5 feet below original grade. 2 feet of stone below distribution pipe.

LOCATION - From the junction of the 124.35' and 213.07' lot lines, place the distribution box 65 feet down the 213.01' lot line and 35 feet off that same lot line. Run trenches along contour towards the 213.07' lot line.

NOTES - No trench to exceed 100 feet in length. Provide 6" - 8" diameter cleanout and cap to grade or above on septic tank 11/5/98 DC

PLANS APPROVED BY Glen Savage DATE 10-06-98

COVER NO WORK UNTIL INSPECTED AND APPROVED

NEITHER THE HOWARD COUNTY COUNCIL NOR THE HEALTH DEPARTMENT IS RESPONSIBLE FOR THE SUCCESSFUL OPERATION OF ANY SYSTEM

NOTE: CLEANOUT REQUIRED EVERY 70 FEET OF SEWER LINE AND/OR AT 90° SWEEPS IN LINES FROM HOUSE TO DRAIN FIELDS. 90° ELBOWS NOT ACCEPTABLE

NOTE: ALL PARTS OF SEPTIC SYSTEMS (I.E. TANK, DISTRIBUTION BOX, TRENCHES) TO BE 100 FEET FROM WELL (UNLESS OTHERWISE SPECIFICALLY AUTHORIZED)

NOTE: IF DEEP TRENCH(ES) ARE USED CALL FOR INSPECTION BEFORE AND AFTER PLACING GRAVEL IN TRENCH(ES)

NOTE: NO DRY WELL SHALL EXCEED 15 FOOT IN DIAMETER NO ABSORPTION TRENCH TO EXCEED 100 FEET IN LENGTH

NOTE: ALL PIPE FROM HOUSE TO SEPTIC TANK MUST BE CAST IRON OR SCHEDULE 25/40 PVC OR ABS

PERMIT VOID AFTER TWO YEARS

NOTE: INSTALL STAND PIPE ON SEPTIC TANK AND DRY WELL STAND PIPES MUST BE 6 INCHES IN DIAMETER CAST IRON, CONCRETE OR TERRA COTTA OR PVA OR ABS ACCEPTED. IF TOP OF SEPTIC TANK IS DEEPER THAN 3 FEET, MANHOLE TO GRADE REQUIRED.

NOTE: DISTRIBUTION BOXES MUST HAVE BAFFLES

*INSTALLER IS RESPONSIBLE FOR OBTAINING FINAL APPROVAL ON THIS PERMIT


*CALL 461-9933 FOR INSPECTION OF SEPTIC SYSTEM.

DO NOT PERMIT SIGNED

AND RETURNED 9/26/01

300132492. Construct open wood deck on ~~sewer~~ SFO 38' x 18' w/steps

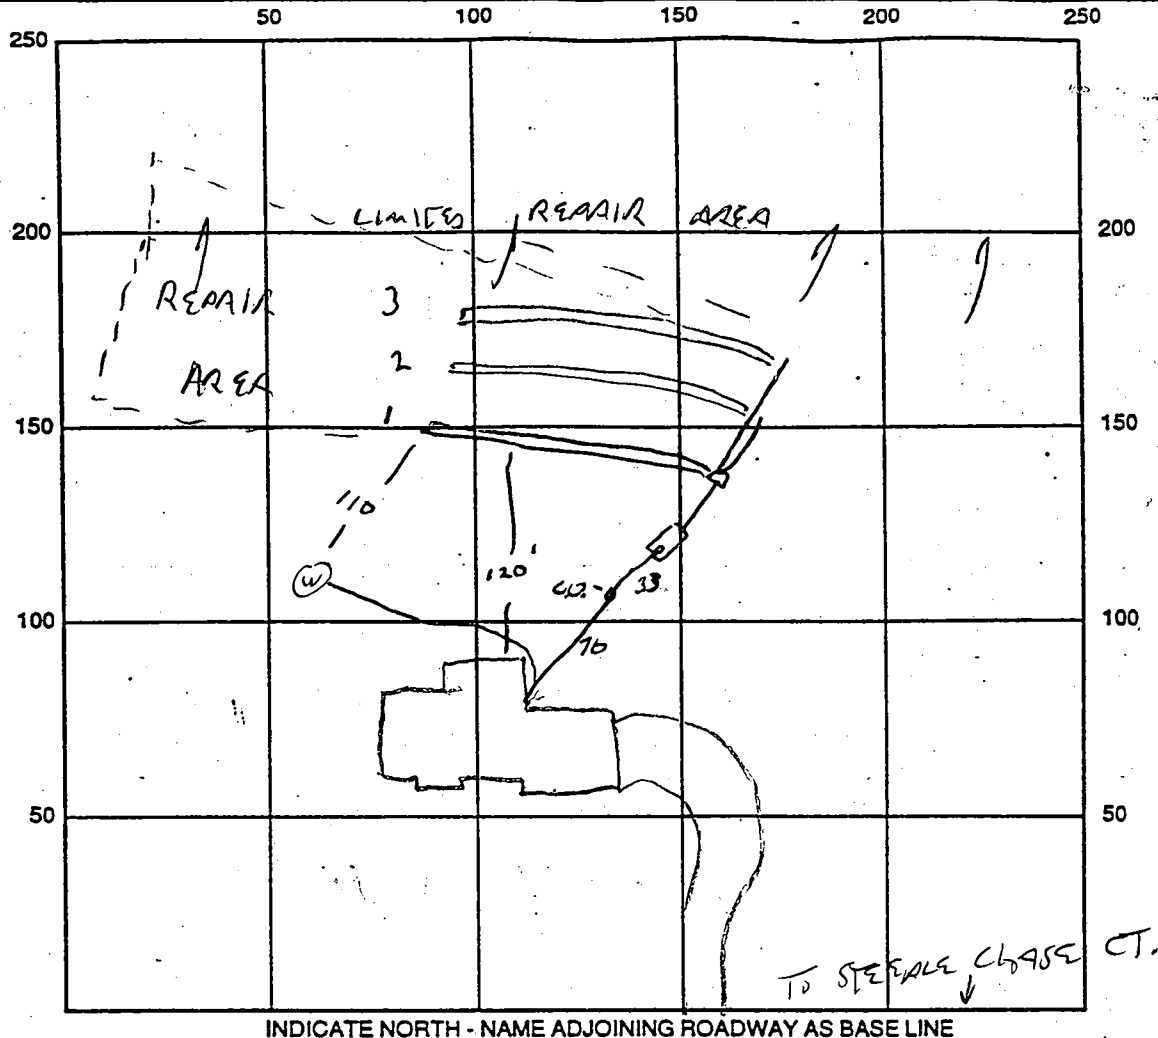156429 CC



SEPTIC TANK LEVEL ok - 1500 GALLON FILLING CLEANOUTS 1 ON 15

DISTRIBUTION BOX LEVEL OK

DRAIN FIELD/TITLE DEPTH 5 FT. TRENCH WIDTH 3 FT. INLET DEPTH 3 FT.

EFFECTIVE GRAVEL DEPTH 42 FT. TOTAL LENGTH 85 ~~86~~ ~~88~~ FT. = 259'

NUMBER OF TRENCHES 3 ONE-SIDEWALL/BOTTOM AREA 777 SQ. FT.

DRYWALL INSIDE DIAMETER 5 FT. EFFECTIVE DEPTH BELOW INLET 5 FT.

ABSORBENT AREA 1 SQ. FT.

REMARKS: 12-22-98 TANK HOLD VERY ROCKY & T, WIND HAS PULLED PAPER BACK IN
A FEW PLACES - REPLACE AND COVER SYSTEM. *ll*

NOTE: 1ST SYSTEM INSTALLED STARTING AT UPPER R.H. CORNER OF
SOA AS SEEN FROM END OF COURT. *JS*

DATE SYSTEM APPROVED 12-22-98 INSPECTOR [Signature]

APPLICATION

PERCOLATION TESTING

A 56429

P _____

HOWARD COUNTY HEALTH DEPARTMENT
BUREAU OF ENVIRONMENTAL HEALTH
3525-H ELLICOTT MILLS DRIVE/ELLICOTT CITY, MARYLAND 21043
TELEPHONE: 313-2640

DISTRICT _____

DATE 4/4/86

TO: THE COUNTY HEALTH OFFICER
ELLICOTT CITY, MARYLAND

I HEREBY APPLY FOR THE NECESSARY TEST PRIOR TO APPLICATION FOR PERMIT TO CONSTRUCT (OR RECONSTRUCT) A SEWAGE DISPOSAL SYSTEM.

PROPERTY OWNER J Thomas Scrivener Ryan Holmes

ADDRESS c/o Land Design & Development PHONE 410 740 5176

AGENT OR PROSPECTIVE BUYER Donald R. Reuter Jr

ADDRESS 10805 Hickory Ridge Rd PHONE _____
21044

PROPERTY LOCATION:

SUBDIVISION _____ LOT NO. 42 29

ROAD AND DESCRIPTION (11020 STEEPLE CHASE COURT)

TAX MAP 29 PARCEL # 21

BLDG. PERMIT SIGNED

~~AND RETURNED~~ 10-6-98
Serial # 1010113841

SIZE OF LOT 1 + Acres TYPE BLDG. SFD - 4 Bdr
(SINGLE FAMILY DWELLING OR COMMERCIAL)

THE SYSTEM INSTALLED UNDER THIS APPLICATION IS ACCEPTABLE ONLY UNTIL PUBLIC FACILITIES BECOME AVAILABLE. I FULLY UNDERSTAND THE FEE CONNECTED WITH THE FILING OF THIS PERC TEST APPLICATION IS NON-REFUNDABLE UNDER ANY CIRCUMSTANCES. I ALSO AGREE TO COMPLY WITH ALL M.O.S.H.A. REQUIREMENTS IN TESTING THIS LOT.

[Signature]
(SIGNATURE OF APPLICANT)

APPROVED BY _____ FOR _____ DATE _____

DISAPPROVED BY _____ FOR _____ DATE _____

HOLD PENDING FURTHER TESTS _____

REASONS FOR REJECTION OR HOLDING _____

PERCOLATION TEST PLAT/PRELIMINARY PLAT - TITLE OR I.D. # _____ DATE _____

SITE DEVELOPMENT PLAN/FINAL PLAT - TITLE OR I.D. # _____ DATE _____

THIS IS NOT A PERMIT

56429

COUNTY #

SOIL PROFILE

TOPSOIL

DARK BROWN /
ORANGE
CLAY LOAM

25'

ROCK

@ 3'

ROCK

7508

TOPSOIL

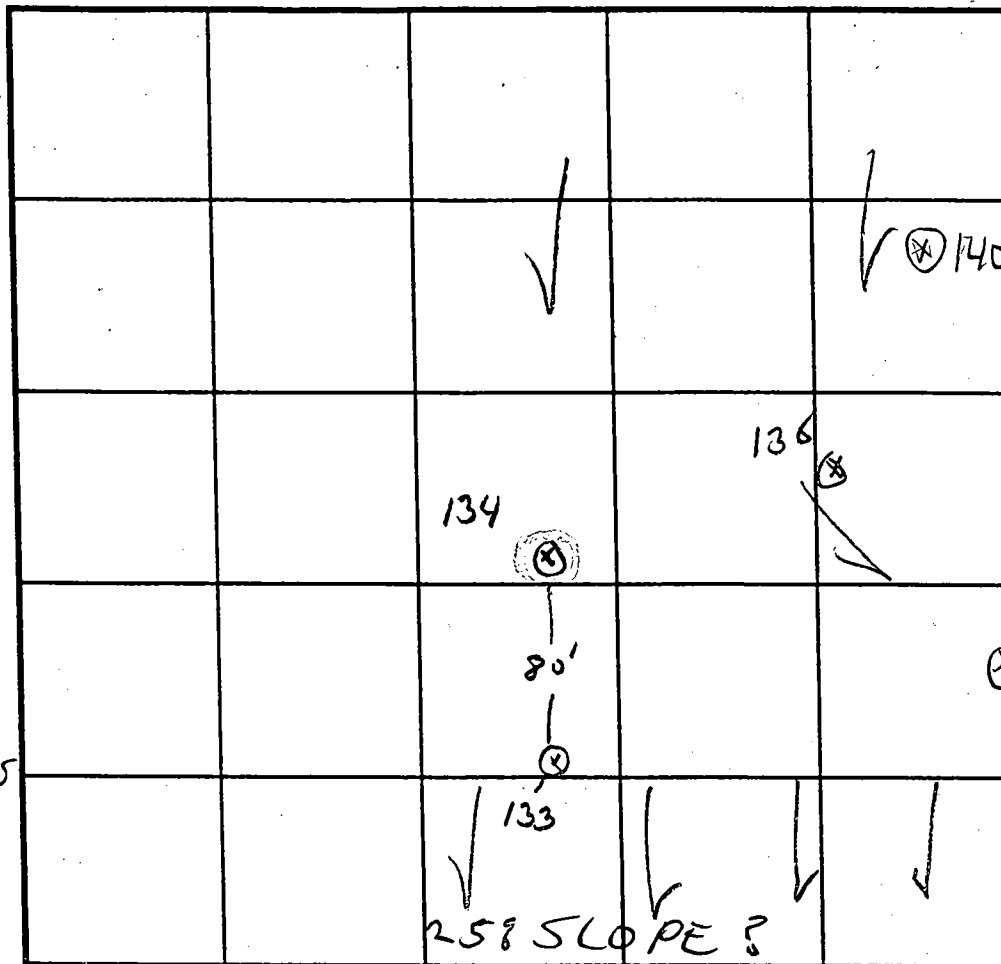
RED BROWN
CLAY LOAMBROWN
COARSE
SANDY
LOAM

208 Rock

ROCK

SOIL PROFILE

TOPSOIL

DARK
BROWN SANDY
CLAY LOAMDARK BROWN
+ MIXED
LIGHT/YELLOW
SANDY HEAVY
COARSE LOAM

INDICATE NORTH - NAME ADJOINING ROADWAY AS BASE LINE.

DATE	TEST NO.	DEPTH	PRE-WET		TEST - 1" DROP		TIME
			START	STOP	START	STOP	
4/4/96	133	4'6" / 9'	11:52	11:59	11:59	12:11	12 MW
X	134	3'6" / 7'	12:02	12:19	12:19	12:48	29 MW
	136	4'6" / 10'6"	12:16	12:17	12:17	12:19	2 MW
	135	4' / 8'	12:28	12:33	12:33	12:40	7 MW

REMARKS COT 29 STAKES NOT SURVEYED

TYPE OF SOIL

TESTED BY G. SAVAGE

ALSO PRESENT DON REUBEN, MIKE

TRENCH DESIGN DATA: AVERAGE PERCOLATION TIME TRENCH WIDTH

INLET DEPTH MAXIMUM BOTTOM DEPTH SQ. FT./BEDROOM

APPLICATION

PERCOLATION TESTING

A 56569

P _____

HOWARD COUNTY HEALTH DEPARTMENT

BUREAU OF ENVIRONMENTAL HEALTH

3525-H ELLICOTT MILLS DRIVE/ELLICOTT CITY, MARYLAND 21043

TELEPHONE: 313-2640

DISTRICT _____

DATE _____

TO: THE COUNTY HEALTH OFFICER
ELLICOTT CITY, MARYLAND

I HEREBY APPLY FOR THE NECESSARY TEST PRIOR TO APPLICATION FOR PERMIT TO CONSTRUCT (OR RECONSTRUCT) A SEWAGE DISPOSAL SYSTEM.

PROPERTY OWNER J Thomas Scrivener

ADDRESS c/o Land Design & Development PHONE 410 740 5176

AGENT OR PROSPECTIVE BUYER Donald R. Renner Jr

ADDRESS 10805 Hickory Ridge Rd PHONE _____
21044

PROPERTY LOCATION:

SUBDIVISION _____ LOT NO. ~~58~~ 29

ROAD AND DESCRIPTION _____

TAX MAP 29 PARCEL # 21

SIZE OF LOT 1 + Acres TYPE BLDG. _____
(SINGLE FAMILY DWELLING OR COMMERCIAL)

THE SYSTEM INSTALLED UNDER THIS APPLICATION IS ACCEPTABLE ONLY UNTIL PUBLIC FACILITIES BECOME AVAILABLE. I FULLY UNDERSTAND THE FEE CONNECTED WITH THE FILING OF THIS PERC TEST APPLICATION IS NON-REFUNDABLE UNDER ANY CIRCUMSTANCES. I ALSO AGREE TO COMPLY WITH ALL M.O.S.H.A. REQUIREMENTS IN TESTING THIS LOT.

Don R Renner Jr
(SIGNATURE OF APPLICANT)

APPROVED BY _____ FOR _____ DATE _____

DISAPPROVED BY _____ FOR _____ DATE _____

HOLD PENDING FURTHER TESTS _____

REASONS FOR REJECTION OR HOLDING _____

PERCOLATION TEST PLAT/PRELIMINARY PLAT - TITLE OR I.D. # _____ DATE _____

SITE DEVELOPMENT PLAN/FINAL PLAT - TITLE OR I.D. # _____ DATE _____

THIS IS NOT A PERMIT

COUNTY #

SOIL PROFILE

0'

1601

TOPSOIL

BROWN
CLAY
LOAM

3

BROWN
SANDY
LOAM
25% QUARTZ
ROCKS
74'
10-25%
GRAVEL
THROUGHOUT

11'

1599

TOPSOIL

REDISH
ORANGE
SANDY
CLAY

315

DARK
ORANGE/
BROWN
SANDY
LOAM

6"-12"

LAYERS
OF ROCK
SANDY
LOAM > 7'

10.5

INDICATE NORTH - NAME ADJOINING ROADWAY AS BASE LINE.

SOIL PROFILE

0'

1602

TOPSOIL

BROWN
CLAY
LOAMTANISH
OLIVE
SILT LOAM

2.5

TAN
SANDY
LOAM
WHITE
Pebbles
w/ORANGE
MOTTLES

6

DRY

11.1

DATE	TEST NO.	DEPTH	PRE-WET		TEST - 1" DROP		TIME
			START	STOP	START	STOP	
1/24/97	LOT 33 1602	11V	6K				
	LOT 31 1601	5.5/11V	11:40	11:42	11:42	11:45	3:11V
X	LOT 30 1600	COVERED AT TIME	WSP. PROB ROCK OR WATER				
	LOT 29 1599	10.5 V	OK				

REMARKS SEE TEST PLAN FOR APPROX. LOCATION

TYPE OF SOIL TEST 1600, IE PART OF PROPOSED

TESTED BY G. SAVAGE

ALSO PRESENT

TRENCH DESIGN DATA: AVERAGE PERCOLATION TIME

TRENCH WIDTH

INLET DEPTH

MAXIMUM BOTTOM DEPTH

SQ. FT/BEDROOM

RUSSELL DEVELOPMENT, LLC
8808 CENTRE PARK DRIVE, SUITE 108
COLUMBIA, MARYLAND 21045
(410) 964-5522 (410) 964-2620

September 16, 1998

Mr. Glen Savage
Howard County
Department of Environmental Health
3525 H Ellicott Mills Dr.
Ellicott City, Maryland 21043

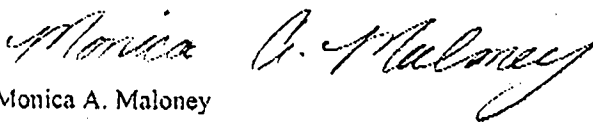
RE: Gaither Hunt Lot's 14 & 29

Dear Mr. Savage,

I am writing this letter to inform you of the status of the above referenced well locations. Per our previous conversations the permits could not be issued until the sediment trap adjacent to Lot 29 and the berm on Lot 14 have been removed. The road construction has been completed and the sediment control features in these areas have been removed so the permits can be issued at this time.

Your prompt attention to this matter would be greatly appreciated. Should you have any questions, comments or require additional information, please do not hesitate to contact me.

Sincerely,


Monica A. Maloney

Enclosures (2)

mam

cc: Michael Barlow

GAITHER AVE LOT 29 12-18-78

STEPPLE CHASE CT

T.C. w/ NORM COLLINS, SUBCONTRACTOR
FOR LEGAL CO.

CONTOUR NOT AS SHOWN

DISREGARD 135' DIST BOX SETBACK FROM
PROP CNG TANK TO BE RH UPPER
CORNER OUTSIDE SDA

INSTALL TRENCH R HAND SIDE BEST
MATCHED TO CONTOUR - MAY BE 3' 80'S
OR VARIED LENGTH depending on
TRANSIT MEASUREMENTS

WELL LINE INSTALLED - OK TO COVER
40 941750 ~~88~~

12-18-98
JH

HOWARD COUNTY HEALTH DEPARTMENT
Bureau of Environmental Health
3525-H Elliott Mills Drive
Baltimore City, MD 21043
461-9935

APPLICATION FOR PITLESS ADAPTER, WELL PUMP AND PRESSURE TANK INSTALLATION

New Installation ☒ Replacement ☐
Receipt # _____
Date _____

Name of Installer Lehsco Corporation Telephone 942-6888

License Number 3344
Certified Well Pump Installer _____ Well Driller _____ Registered Plumber ☒

Name of Property Owner Ryan Homes Telephone (410) 654-0501
Subdivision Gaithers Hunt Lot # 89 Well Tag # HO-94-1750
Site Address 11080 Steple Chase Court

Pump Motor Pitless Adapter
1. Type 1. Horsepower _____ 1. Make _____
a. Deep well jet _____ 2. RPM _____ 2. Model # _____
b. Shallow well jet _____ 3. Voltage _____ 3. Depth _____
c. Submersible ☒ a. 110 _____
2. Make 300221 Puma b. 220 _____
3. Model # 1545-1B-E2
4. Capacity 5 GPM
5. Pump exceeds well capacity Yes _____ No ☒
6. If Yes, is low pressure cutoff switch installed? Yes _____ No _____
7. What methods are used to protect the pump and electrical wiring from vibrations? Torque arrestors _____ Cable guards ☒ Other _____

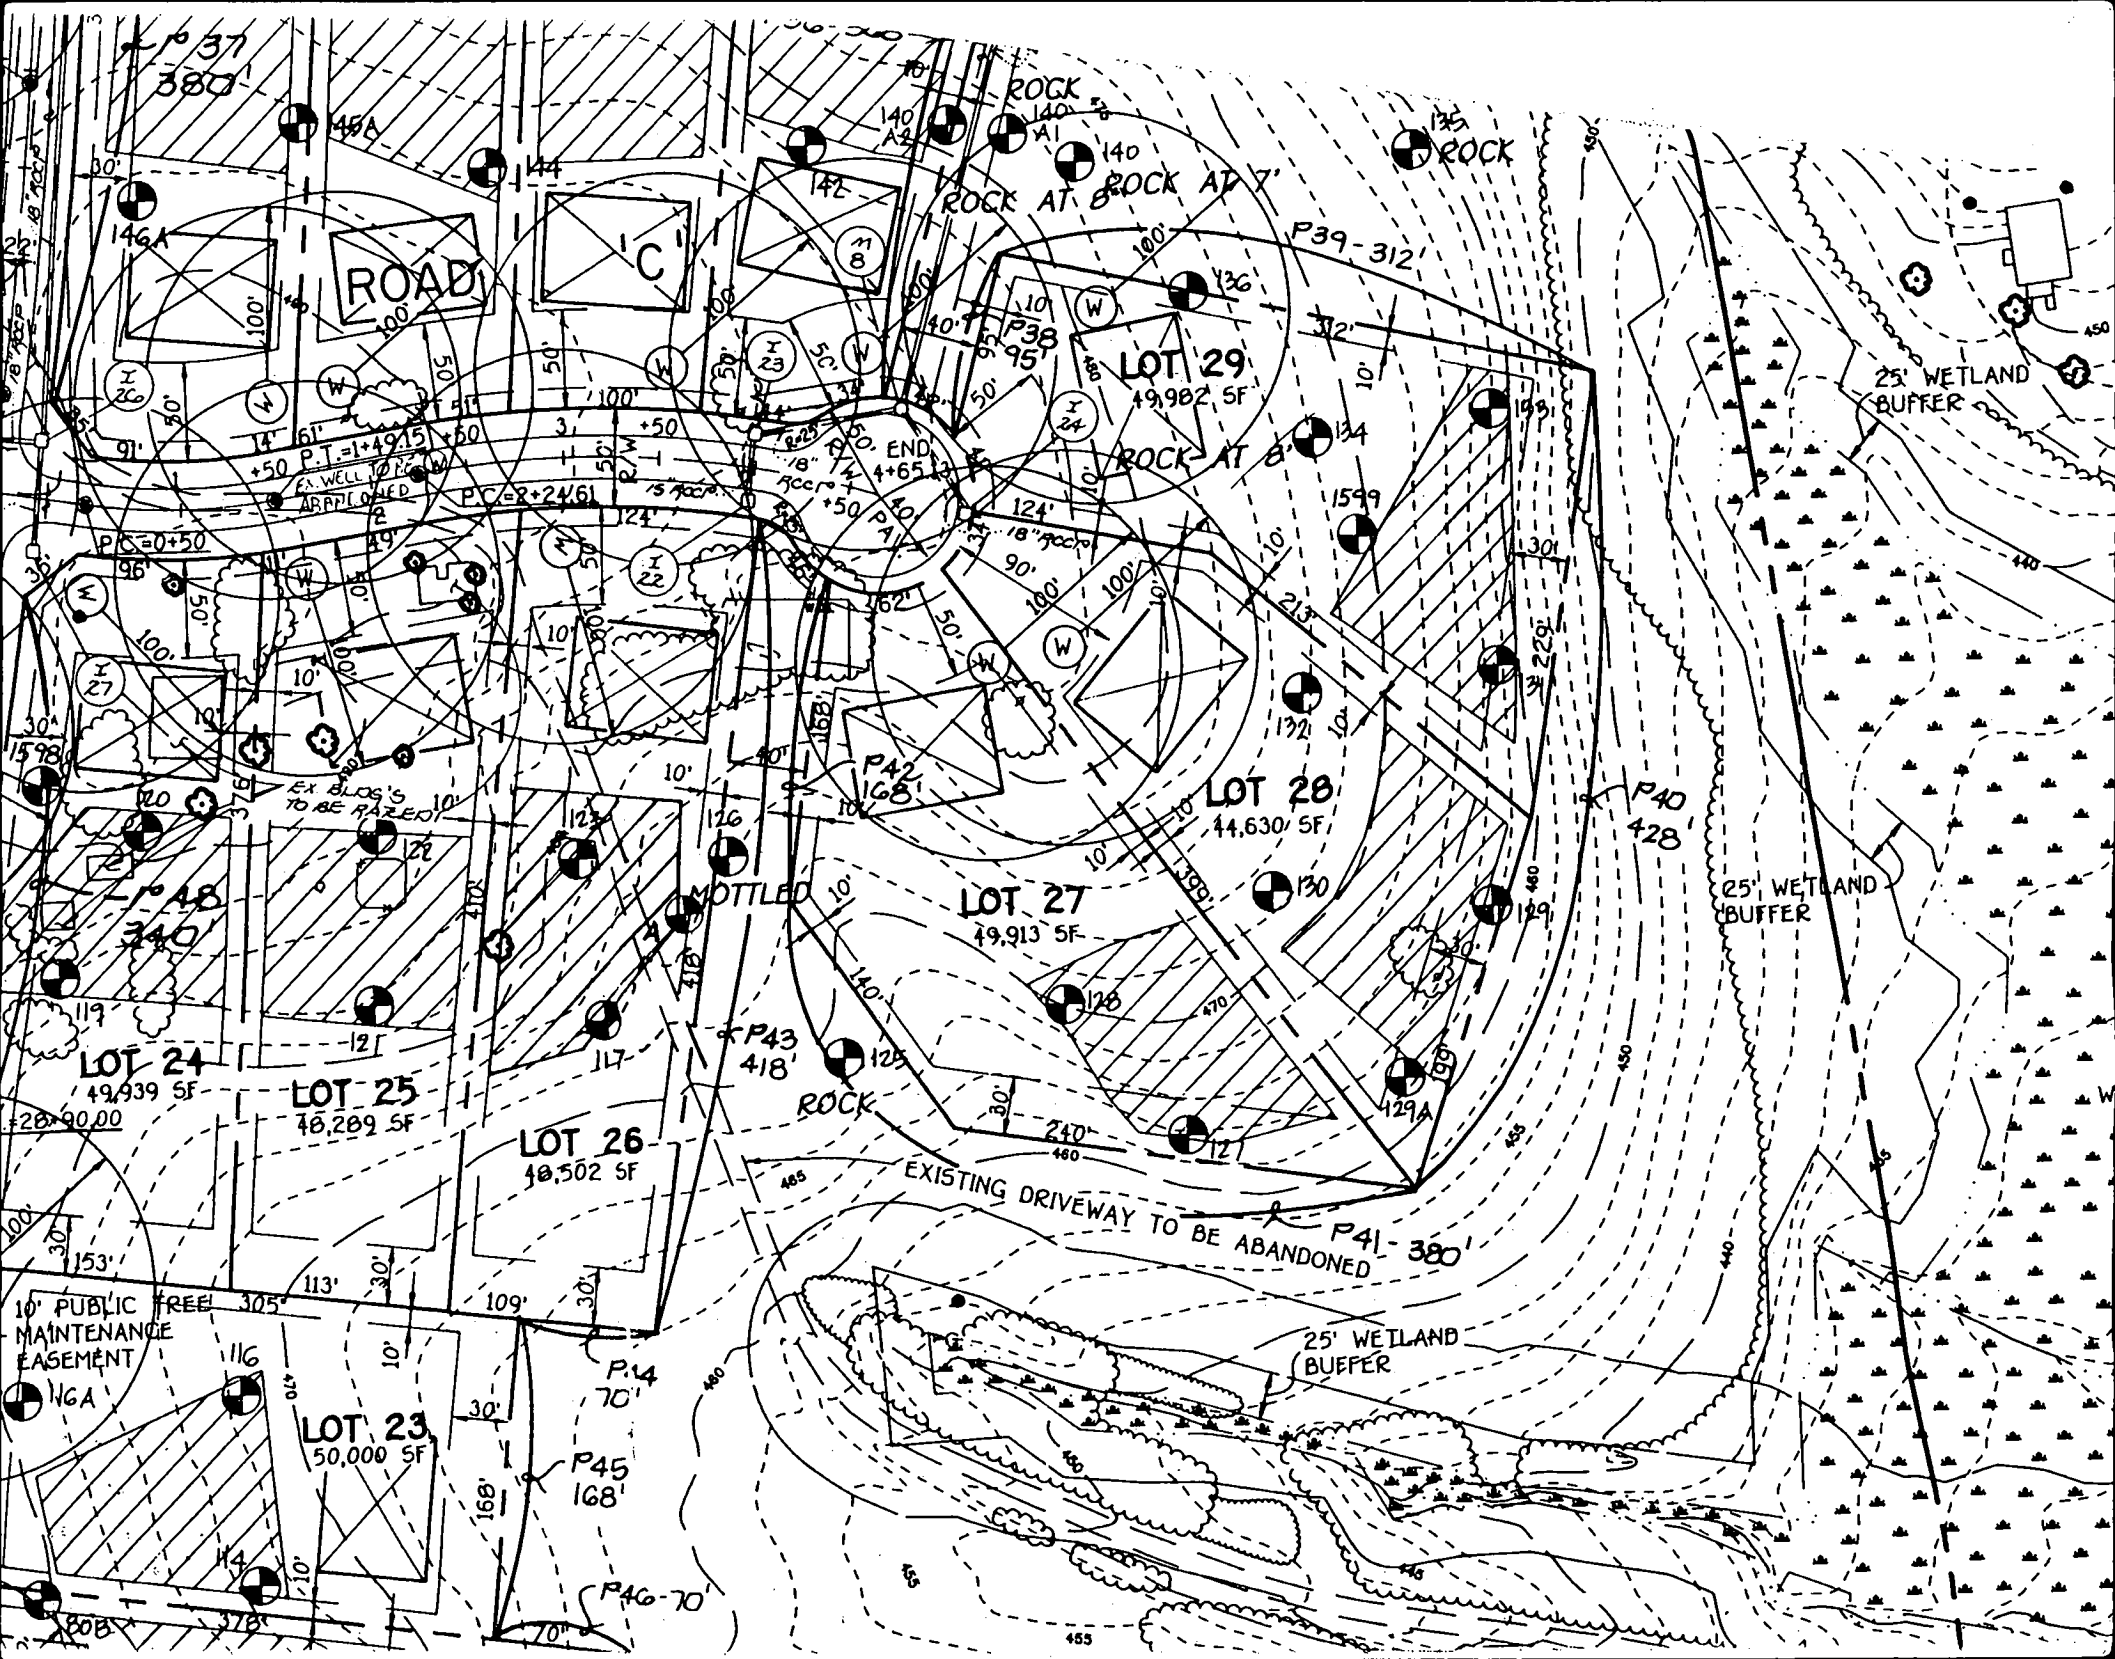
Tank Piping Well data
1. Capacity _____ 1. Type _____ 1. Depth _____ ft.
2. Pressure relief valve? _____ 2. Size _____ 2. Yield _____ GPM
3. NSF and/or BOCA Code approved _____ 3. Static water level _____ ft.
4. Depth of supply line _____ 4. Will water supply be disinfected by installer? _____

I understand that it is my responsibility to notify the Howard County Health Department when the installation is ready for inspection (otherwise this permit is null and void).


All information given above is true to the best of my knowledge.

12/18/98-WPI OK Signature of Applicant: _____
SRH Date: _____
(CS)

Note: A sticker indicating approval/status of the installation will be placed on the well casing at the time of the inspection.



SYMBOL	BEARING & DISTANCE
1	R=50.00'
2	N16°11'03"E
3	N44°37'27"E
4	N20°00'03"W
5	N05°40'05"W
6	N04°19'55"E
7	S05°40'05"E
8	N06°46'15"E
9	S05°40'05"E
10	S60°24'13"E
11	S10°17'44"E
12	S37°56'50"W
13	S46°44'24"E
14	R=25.00'
15	N46°44'24"W
16	S50°40'07"W
17	N62°30'08"W
18	S44°37'27"W
19	S16°11'03"W

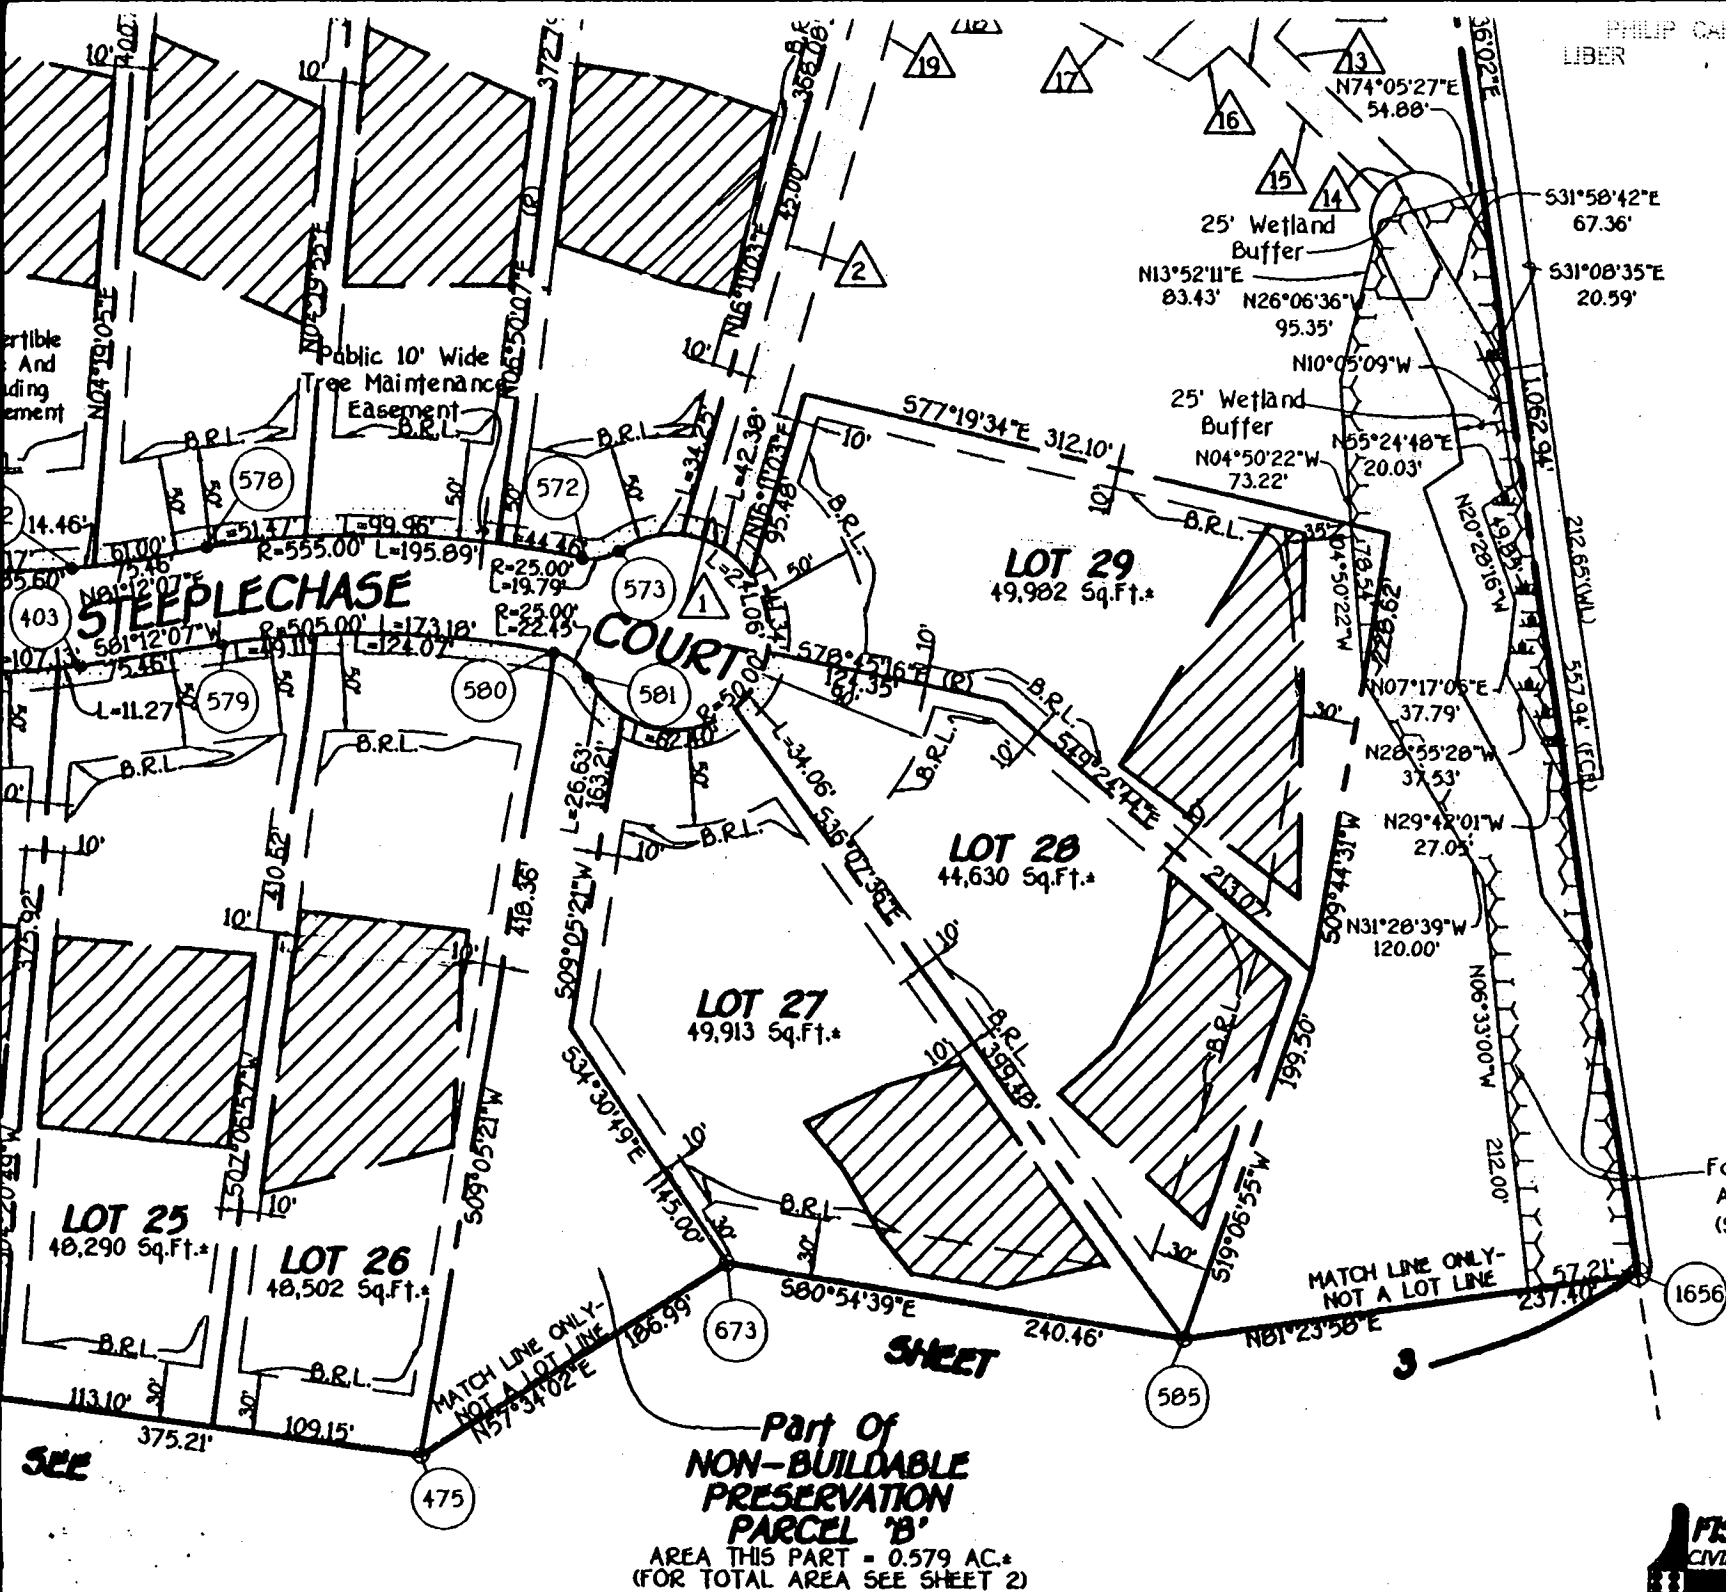

C 1	7021	SEQUENCE NO. (MDE USE ONLY)	STATE OF MARYLAND WELL COMPLETION REPORT FILL IN THIS FORM COMPLETELY PLEASE TYPE		THIS REPORT MUST BE SUBMITTED AFTER WELL IS COMPLETED.	
1 2 3 6					COUNTY NUMBER <u>A 56429CC</u>	
ST/CO USE ONLY: DATE Received MM DD YY 8 / 13	DATE WELL COMPLETED MM DD YY 10 1 98		Depth of Well 22 <u>350</u> 26 (TO NEAREST FOOT)		PERMIT NO. FROM "PERMIT TO DRILL WELL" <u>HO-94-1750</u> 28 29 30 31 32 33 34 35 36 37	

OWNER <u>Russell Development</u>	last name	first name	TOWN
STREET OR RFD			
SUBDIVISION <u>GAither Hunt</u>	SECTION	LOT <u>29</u>	

WELL LOG		
Not required for driven wells		
STATE THE KIND OF FORMATIONS PENETRATED, THEIR COLOR, DEPTH, THICKNESS AND IF WATER BEARING		
DESCRIPTION (Use additional sheets if needed)	FEET FROM TO	check if water bearing
Brown Soil	0 16	
GRAY GRANITE	16 250	
HARD Green GRANITE	250 300	
GRAY GRANITE	300 350	
	33	✓
	98	✓

Dry hole sealed with rock cuttings & cement
Dry hole 0' 800'

GROUTING RECORD		
WELL HAS BEEN GROUTED (Circle Appropriate Box) ☒ Y ☐ N		
TYPE OF GROUTING MATERIAL (Circle one) CEMENT ☒ BENTONITE CLAY ☐		
NO. OF BAGS <u>45</u> NO. OF POUNDS <u>564</u>		
GALLONS OF WATER <u>36</u>		
DEPTH OF GROUT SEAL (to nearest foot) from <u>0</u> ft. to <u>20</u> ft. (enter 0 if from surface)		
CASING RECORD		
casing types insert appropriate code below	☒ ST STEEL	☐ CO CONCRETE
	☐ PL PLASTIC	☐ OT OTHER
MAIN CASING TYPE	Nominal diameter top (main) casing (nearest inch)!	Total depth of main casing (nearest foot)
<u>ST</u>	<u>06</u>	<u>20</u>

OTHER CASING (if used)	
diameter inch	depth (feet) from to

SCREEN RECORD	
screen type or open hole	☒ ST STEEL ☐ BR BRASS ☐ HO OPEN HOLE
(insert appropriate code below)	☐ PL PLASTIC ☐ OT OTHER
DEPTH (nearest ft.)	
<u>HO</u> <u>20</u> <u>350</u>	
1 2 3 100	

NUMBER OF UNSUCCESSFUL WELLS: <u>1</u>
WELL HYDROFRACTURED ☐ YES ☒ NO
CIRCLE APPROPRIATE LETTER A A WELL WAS ABANDONED AND SEALED WHEN THIS WELL WAS COMPLETED E ELECTRIC LOG OBTAINED P TEST WELL CONVERTED TO PRODUCTION WELL
I HEREBY CERTIFY THAT THIS WELL HAS BEEN CONSTRUCTED IN ACCORDANCE WITH COMAR 26.04.04 "WELL CONSTRUCTION" AND IN CONFORMANCE WITH ALL CONDITIONS STATED IN THE ABOVE CAPTIONED PERMIT, AND THAT THE INFORMATION PRESENTED HEREIN IS ACCURATE AND COMPLETE TO THE BEST OF MY KNOWLEDGE.
DRILLERS LIC. NO. <u>MW D 355</u>
DRILLERS SIGNATURE (MUST MATCH SIGNATURE ON APPLICATION) <u>Max S. Jones</u>
LIC. NO. <u>JW D 341</u>
SITE SUPERVISOR (sign. of driller or journeyman responsible for sitework if different from permittee)

PUMPING TEST		
HOURS PUMPED (nearest hour)	<u>6</u>	
PUMPING RATE (gal. per min.)	<u>2.7</u>	
METHOD USED TO MEASURE PUMPING RATE	<u>Waght + Bucket</u>	
WATER LEVEL (distance from land surface)		
BEFORE PUMPING	<u>19</u> ft.	
WHEN PUMPING	<u>173</u> ft.	
TYPE OF PUMP USED (for test)		
☐ A air	☐ P piston	☐ T turbine
☐ C centrifugal	☐ R rotary	☐ O other (describe below)
☐ J jet	☒ S submersible	

PUMP INSTALLED	
DRILLER INSTALLED PUMP (CIRCLE) (YES or NO)	YES ☐ NO ☒
IF DRILLER INSTALLS PUMP, THIS SECTION MUST BE COMPLETED FOR ALL WELLS.	
TYPE OF PUMP INSTALLED PLACE (A,C,J,P,R,S,T,O) IN BOX 29	
CAPACITY: GALLONS PER MINUTE (to nearest gallon)	<u>29</u>
PUMP HORSE POWER	<u>31</u> <u>35</u>
PUMP COLUMN LENGTH (nearest ft.)	<u>37</u> <u>41</u>
CASING HEIGHT (circle appropriate box and enter casing height)	<u>+</u> above
LAND SURFACE	<u>2</u> (nearest foot)

LOCATION OF WELL ON LOT	
SHOW PERMANENT STRUCTURES AND INDICATE NOT LESS THAN TWO DISTANCES (MEASUREMENTS TO WELL)	

VERTICAL LOCATION OF WDM POND

10/1/98 PUMP & GROUT
1ST LOCATION DRY TO
800' & DRILLER MOVED WELL
IN CHAIRMAN'S MOUND AT
USPUNKERS OCEAN VIEW
LOT 15 95' FROM 1ST LOCATION
30' BELOW HOUSE STAKE

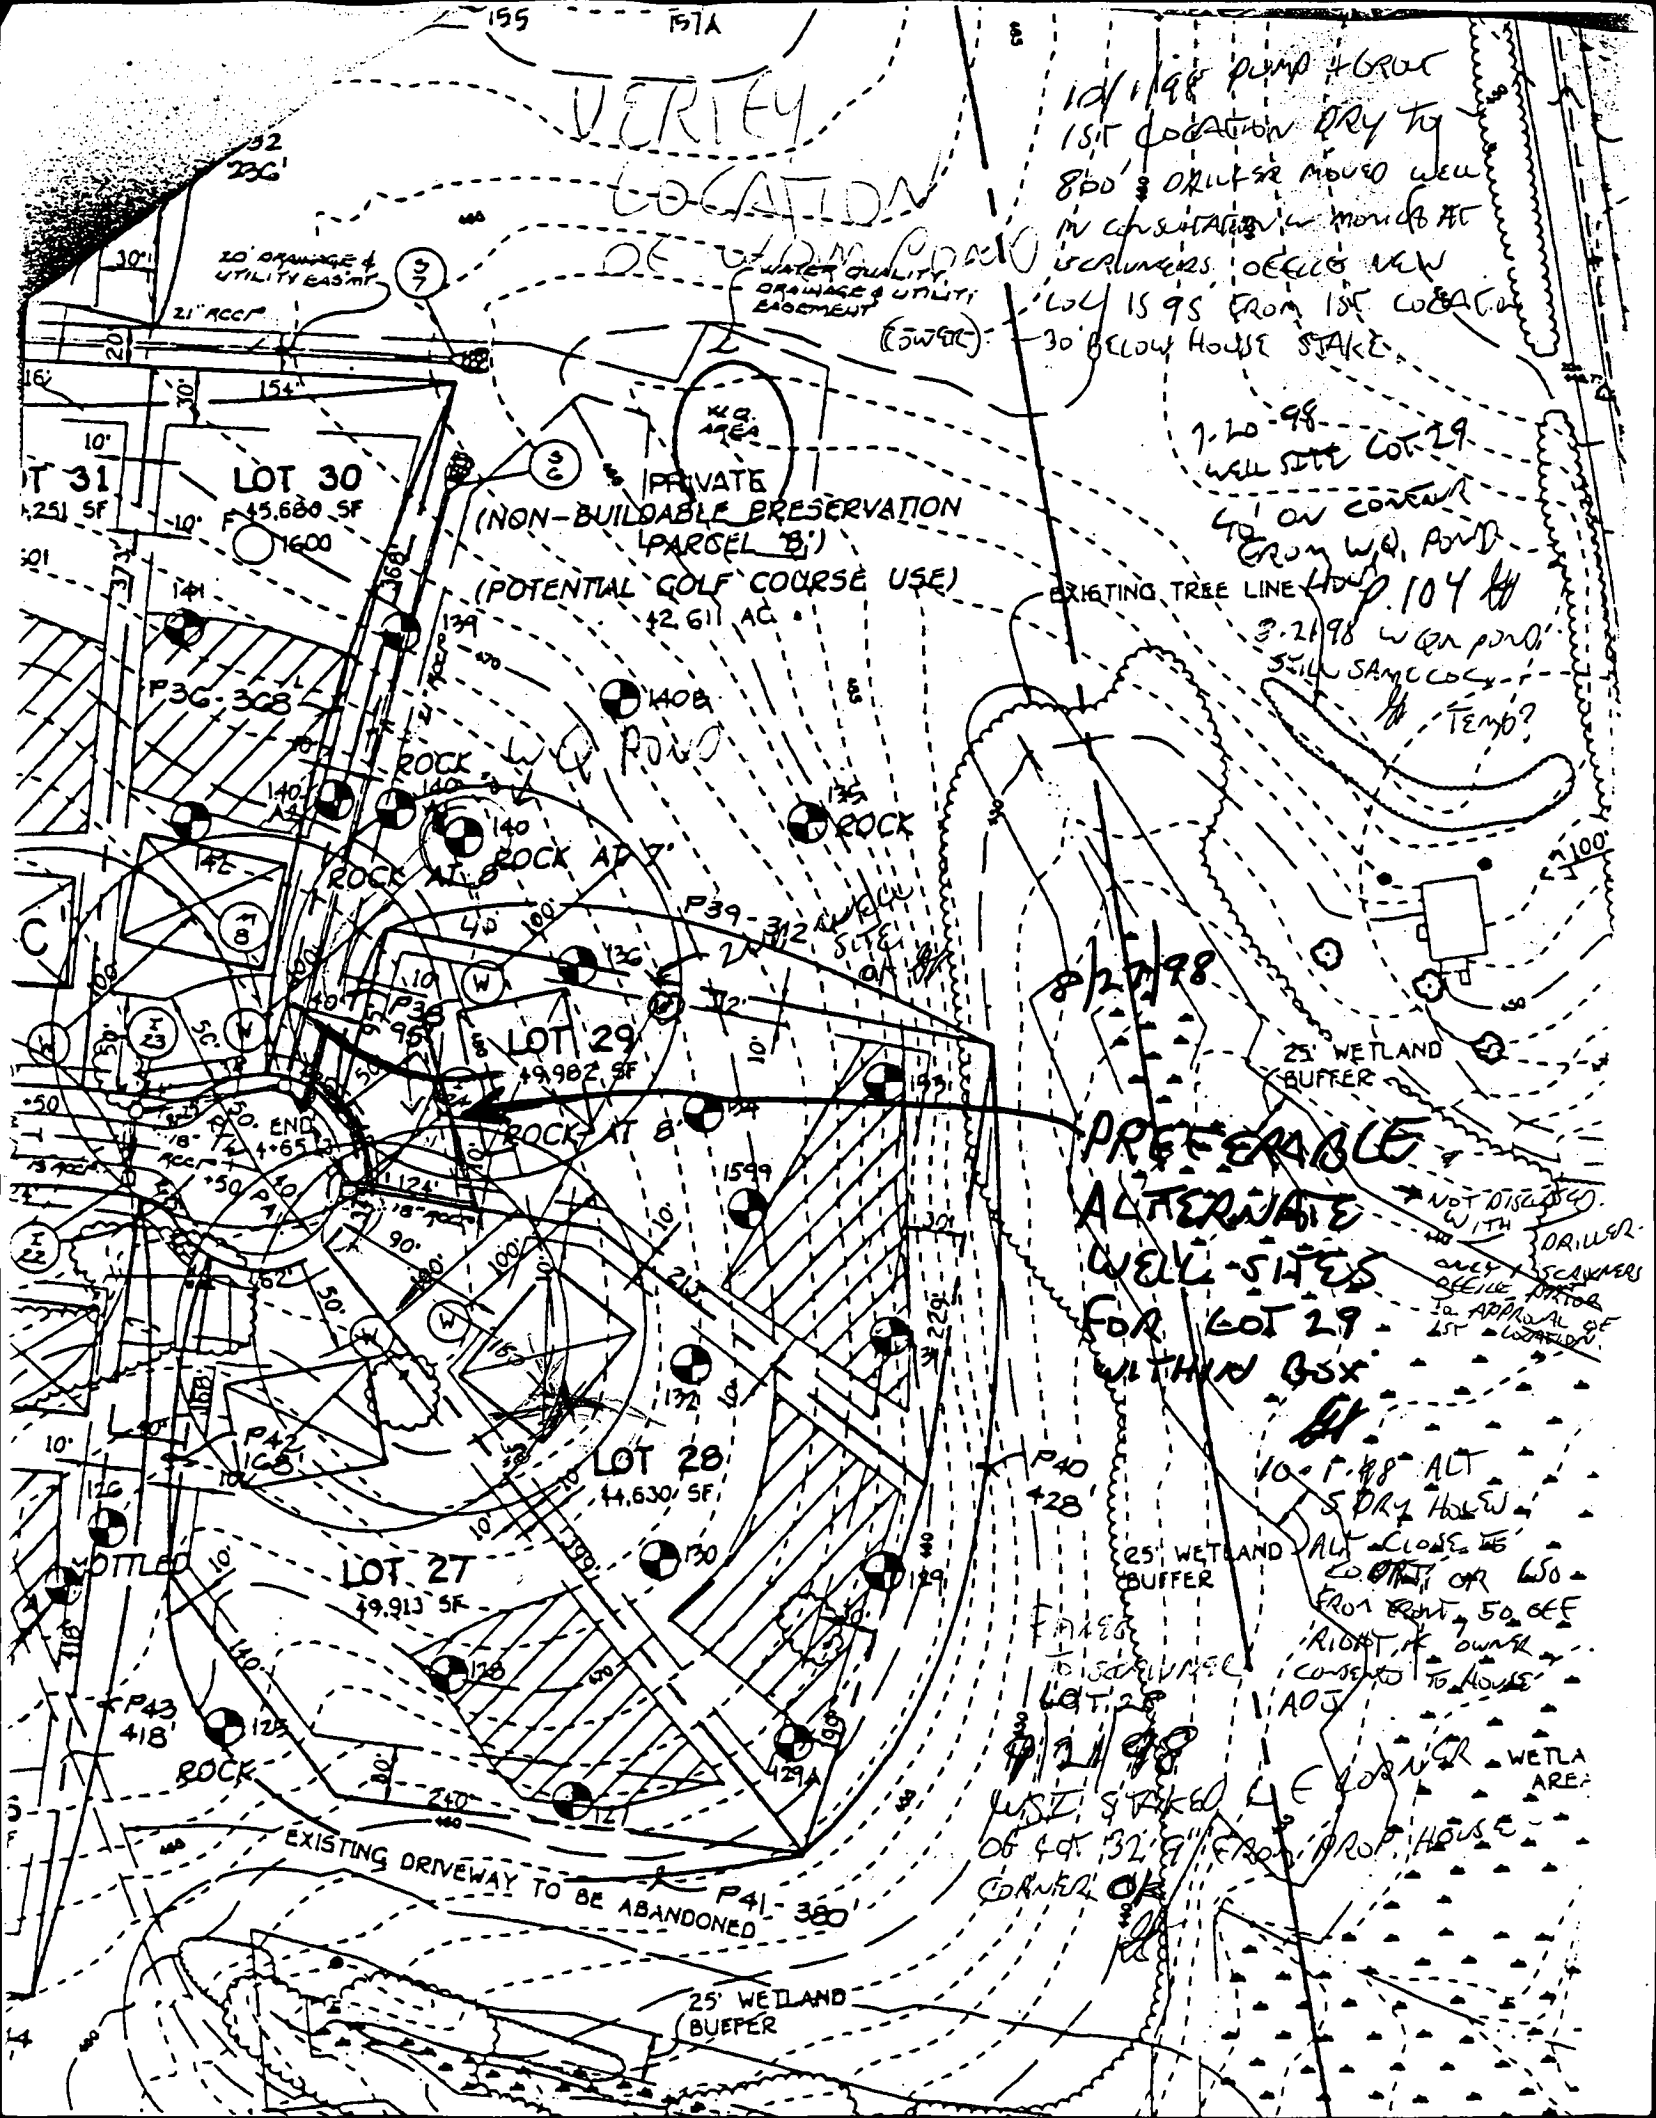
1-20-98
WELL SITE LOT 29
ON CORNER
FROM W.D. ROAD
P. 104
3-21-98 W.D. ROAD
STILL SAME CORNER
TEMP?

8/20/98

PREFERABLE
ALTERNATE
WELL SITES
FOR LOT 29
WITHIN GSX

10-1-98 ALT
5 DRY HOLE
ALT CLOSE TO
CORNER OR 60'
FROM FRONT 50' OFF
RIGHT OF OWNERS
CONSIDERED TO HOUSE
1 AOS

11/1/98
WELL SITED LE CORNER
OF LOT 32 8' FROM PROP. HOUSE
CORNER



Page 1 of 2
Date 8-19-99

Review _____

FIELD DATA SHEET
HOWARD COUNTY WELL YIELD TEST

Well Permit No. HO - 94-1750
Location of property (road) 11021 STEEPLE CHASE CT
Subdivision GAITHER HUNT Lot 29 Block _____ Plat _____ Sec. I
Well Driller MICHAEL BARLOW WELL DRILLING Owner RYAN HOMES / MITZEL

Depth of well 350 FEET
Distance of measuring point (M.P.) above ground _____
Static water level (S.W.L.) below M.P. _____

I. High rate pumping -- reservoir drawdown

Time pump started _____ Pumping rate _____
Total time _____ to reach pumping water level _____ ft. below M.P.

II. Recovery pump test data - observations to be recorded every 15 minutes




TIME (in 15 minute intervals)	WATER LEVEL below M.P.	PUMPING RATE time to fill 5 gallon bucket	FLOW METER READING (if used)	CALCULATED FLOW (gallons per minute)
10:00	23'	3		20
10:15	83'	3		20
10:30	140'	4		15
10:45	205'	4		15
11:00	289'	6		10
11:15	285'	20		3
11:30	285'	20		3
11:45	285'	20		3
12:00	284'	20		3
12:15	284'	20		3
12:30	285'	20		3
12:45	287'	30		2
1:00	287'	30		2
1:15	287'	30		2
1:30	287'	30		2
1:45	287'	30		2
2:00	287'	30		2
2:15	287'	30		2
2:30	288'	30		2
2:45	288'	30		2
3:00	288'	33		1.8
3:15	288'	33		1.8
3:30	288'	33		1.8
3:45	288'	33		1.8

Well Permit No. HO - 94-1750
Location of property (road) 11021 STEEPLECHASE CT.
Subdivision GAITHER HUNT Lot 29 Block Plat Sec. I
Well Driller MICHAEL BARLOW WELL DRILLING Owner RYAN HOMES / MITZEL

Static water level (S.W.L.) below M.P.

Time pump started _____ Pumping rate _____
Total time _____ to reach pumping water level _____ ft. below M.P.

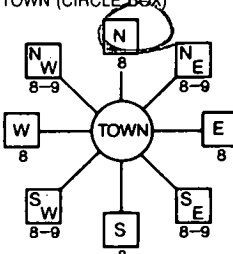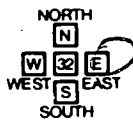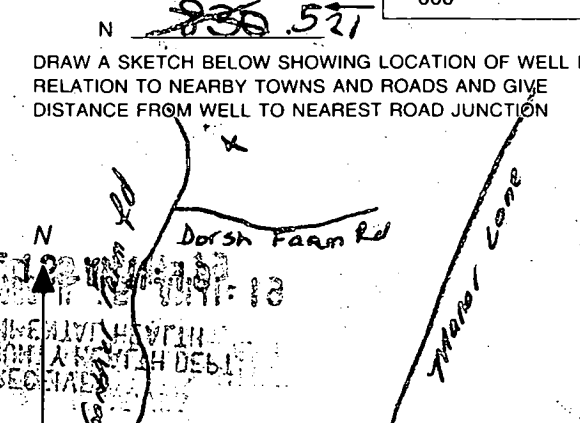[illegible]

B 1 8852	SEQUENCE NO. (MDE USE ONLY)	STATE OF MARYLAND PERMIT TO DRILL WELL please print or type	STATE PERMIT NUMBER H0-94-1750
(THIS NUMBER IS TO BE PUNCHED IN COLS. 3-6 ON ALL CARDS)		fill in this form completely	
OWNER INFORMATION Date Received (APA) _____ 8 MM DD YY 13 RUSSELL DEVELOPMENT LLC 15 Last Name Owner First Name 34 8808 CENTRE PARK DR. SUITE 108 36 Street or RFD 55 COLUMBIA MARYLAND 21045 57 Town 70 State 72 Zip 76		LOCATION OF WELL B 3 8 COUNTY HOWARD 21 23 SUBDIVISION LAITHER HUNT 42 SECTION 1 44 46 LOT 29 48 50 WILDELAKE ELLICOTT CITY 52 NEAREST TOWN 71 MILES FROM TOWN (enter 0 if in town) 4 M 73 76 77 78	
DRILLER INFORMATION MICHAEL BARLOW MWD 355 Driller's Name 76 License No. 81 MICHAEL BARLOW WELL DRILLING, INC. Firm Name 912 FAUN COURT JOPPA, MD 21760 Address 6-17-98 Signature Date		B 4 1 2 DIRECTION OF WELL FROM TOWN (CIRCLE BOX) 	
WELL INFORMATION B 2 1 2 APPROX. PUMPING RATE (GAL. PER MIN.) 5 8 12 AVERAGE DAILY QUANTITY NEEDED (GAL. PER DAY) 500 14 20		NEAR WHAT ROAD STEADMAN CT. 11 30 ON WHICH SIDE OF ROAD (CIRCLE APPROPRIATE BOX)  34 100 37 DISTANCE FROM ROAD FT ENTER FT OR MI 38 39 TAX MAP: 29 BLK: 5 PARCEL 21	
USE FOR WATER (CIRCLE APPROPRIATE BOX) ☒ HOME (SINGLE OR DOUBLE HOUSEHOLD UNIT ONLY) ☐ FARMING (LIVESTOCK WATERING & AGRICULTURAL IRRIGATION) 22 ☐ INDUSTRIAL, COMMERCIAL, STATE AND FEDERAL GOV. OTHER (REQUIRES APPROPRIATION PERMIT) ☐ PUBLIC OR PRIVATE WATER COMPANY (REQUIRES APPROPRIATION PERMIT AND STATE APPROVAL) ☐ TEST, OBSERVATION, MONITORING (MAY REQUIRE APPROPRIATION PERMIT)		NOT TO BE FILLED IN BY DRILLER HEALTH DEPARTMENT APPROVAL HOWARD A 56429CC COUNTY NAME COUNTY NO. STATE SIGNATURE _____ INSERT S → 41 DATE ISSUED 9 22 98 9 22 98 43 MM DD YY 48 CO SIGNATURE EXP. DATE NORTH GRID 521 000 EAST GRID 830 000 50 55 57 63	
APPROXIMATE DEPTH OF WELL 200 FEET 24 28 APPROXIMATE DIAMETER OF WELL 6 INCH NEAREST INCH		SHOW MAJOR FEATURES OF BOX & LOCATE WELL WITH AN X SOURCES OF DRILLING WATER 1. 2. 3. WRITE THE BOX NUMBER FROM THE MAP HERE 830 E 830 N 521 000 000	
METHOD OF DRILLING (circle one) BORED (or Augered) JETTED Jetted & DRIVEN 30 AIR-ROTARY AIR-PERCussion ROTARY (Hydraulic Rotary) 37 CABLE REVERSE-ROTARY Drive-POINT other _____		DRAW A SKETCH BELOW SHOWING LOCATION OF WELL IN RELATION TO NEARBY TOWNS AND ROADS AND GIVE DISTANCE FROM WELL TO NEAREST ROAD JUNCTION 	
REPLACEMENT OR DEEPEMED WELLS (CIRCLE APPROPRIATE BOX) ☒ THIS WELL WILL NOT REPLACE AN EXISTING WELL ☐ THIS WELL WILL REPLACE A WELL THAT WILL BE ABANDONED AND SEALED 39 ☐ THIS WELL WILL REPLACE A WELL THAT WILL BE USED AS A STANDBY-CONTACT LOCAL APPROVING AUTHORITY FOR POLICY ON STANDBY WELLS ☐ THIS WELL WILL DEEPEAN AN EXISTING WELL PERMIT NUMBER OF WELL TO BE REPLACED OR DEEPEMED (IF AVAILABLE) 41 _____		Not to be filled in by driller (MDE OR COUNTY USE ONLY) APPROV. PERMIT NUMBER _____ G A P WRITE INITIALS IN BOX H0-94-1750 FORCE 65 PERMIT No. 70 71 72 73 74 75 76 77 78 79	
SPECIAL CONDITIONS NOTE - APPROVING AUTHORITIES SHOULD USE SEPARATE SHEET IF NEEDED -			

LOCATED BY
CLARK, FINE-ROCK
& SACKETT

[illegible]

Zone C,
MAP of
number
4, 1986.

NON-BUILDABLE
PRESERVATION, PARCEL 'B'

Easement

Forest Conservation

S09°44'31"W

228.62'

LOT 29
43,382 ±

312.10'

Easement - see
Plat No. 13208

BP
CONTRACTOR
REPORTS
TANKS
HERE

WELL
HEAD

31 1/2'

#11021

S.T. LOC } PER
C/O } A56429CC
LOC }

NO IMPACT
FROM DECK

S77°5'34"W

10' BRL

50'

124.35'

N78°45'16"W

N16°11'03"E 35.48'

50.00'
41.34'

Public 10' Wide Tree
Maintenance Easement

LOT 30

STEEPLECHASE
COURT 50'R/W

9/20/07
MLD

DEPARTMENT OF INSPECTIONS, LICENSES AND PERMITS 3430 COURT HOUSE DRIVE ELICOTT CITY, MD 21043 PERMITS (410) 313-2455 INSPECTIONS (410) 313-1810 AUTOMATED INFORMATION (410) 313-3800	HOWARD COUNTY PERMIT APPLICATION	PERMIT NUMBER B-00132492
--	-------------------------------------	-----------------------------

Building Address <u>11021 STEELEDUST CT</u> <u>ELICOTT CITY, MD 21043</u>	Property Owner's Name <u>DAVE MITZEL</u>
Suite/Apt. #: _____ SDP/WP/Petition #: _____	Address <u>11021 STEELEDUST CT</u>
Census Tract <u>6030</u> Subdivision <u>Garth Hunt</u>	City <u>ELICOTT CITY</u> State <u>MD</u> Zip Code <u>21043</u>
Section <u>1</u> Lot <u>29</u>	Home Phone <u>410 715 2198</u> Work Phone <u>466 7876</u>
Tax Map <u>25</u> Parcel <u>21</u> Grid <u>11/17</u>	Applicant's Name & Mailing Address, (if other than stated hereon): <u>ANDREW MENEZ</u> <u>1067 HARBOR CT</u> <u>ELICOTT CITY, MD 21043</u>
Zoning <u>RC-000</u> Map Coordinates <u>11D17</u> Lot size _____	Phone <u>410 751 7500</u> Fax _____
Existing Use <u>SEA</u>	Contractor Company <u>FRONTIER DECK BUILDERS</u>
Proposed Use <u>SEA</u>	Contact Person <u>ANDY MENEZ</u>
Estimated Construction Cost \$ <u>11,000</u>	Address <u>1067 HARBOR CT</u>
Description of Work <u>CONSTRUCT OPEN</u> <u>WOOD DECK ON REAR OF SEA</u> <u>38' x 18' 1/2"</u>	City <u>ELICOTT CITY</u> State <u>MD</u> Zip Code <u>21043</u>
Occupant or Tenant _____	License No. <u>51321</u>
Contact Name _____	Phone <u>410 751 7500</u> Fax _____
Address _____	Engineer or Architect Company _____
City _____ State _____ Zip Code _____	Contact Person _____
Phone _____ Fax _____	Address _____
	City _____ State _____ Zip Code _____
	Phone _____ Fax _____

BUILDING DESCRIPTION - <u>COMMERCIAL</u>		BUILDING DESCRIPTION - <u>RESIDENTIAL</u>	
Building Characteristics	Utilities	Building Characteristics	Utilities
Height: <u>1'-5"</u>	Water Supply: _____ Public _____ Private _____	SF Dwelling ☒ SF Townhouse ☐ Depth _____ Width _____	Water Supply: _____ Public _____ Private _____
No. of stories: _____	Sewage Disposal: _____ Public _____ Private _____	1st floor: _____ 2nd floor: _____ Basement: _____	Sewage Disposal: _____ Public _____ Private _____
Gross area, sq. ft. per floor: <u>630</u>	Electric Yes ☐ No ☐ Gas Yes ☐ No ☐	Finished Basement ☐ Unfinished Basement ☐ Crawl space ☐ Slab on Grade ☐ No. of Bedrooms _____	Electric Yes ☐ No ☐ Gas Yes ☐ No ☐
Use group: _____	Heating System: _____ Electric ☐ Oil ☐ Natural Gas ☐ Propane Gas ☐	Multi-family dwellings: No. of efficiency units: _____ No. of 1 BR units: _____ No. of 2 BR units: _____ No. of 3 BR units: _____	Heating System: _____ Electric ☐ Oil ☐ Natural Gas ☐ Propane Gas ☐
Construction type: _____ Reinforced Concrete _____ Structural Steel _____ Masonry _____ Wood Frame _____	Sprinkler system: N/A ☐ Full _____ Partial _____ Other Suppression _____ # of Heads _____	Other Structure: _____ Dimensions: _____ Footings: _____ Roof: <u>132</u>	Sprinkler system: N/A ☐ NFPA #13D _____ NFPA #13R _____ Other: _____
State Certified Modular _____		State Certified Modular _____ Manufactured Home _____	

THE UNDERSIGNED HEREBY CERTIFIES AND AGREES AS FOLLOWS: (1) THAT HE/SHE IS AUTHORIZED TO MAKE THIS APPLICATION, (2) THAT THE INFORMATION IS CORRECT, (3) THAT HE/SHE WILL COMPLY WITH ALL REQUIREMENTS OF HOWARD COUNTY WHICH ARE APPLICABLE THERE TO, (4) THAT HE/SHE WILL PERFORM AND WORK ON THE ABOVE REFERENCED PROPERTY NOT SPECIFICALLY DESCRIBED IN THIS APPLICATION, (5) THAT HE/SHE GRANTS COUNTY OFFICIALS THE RIGHT TO ENTER UPON THIS PROPERTY FOR THE PURPOSE OF INSPECTING THE WORK PERMITTED AND POSTING NOTICES.

Applicant's Signature _____ Date _____
Print Name ANDY MENEZ
9/21/01

Title/Company _____
Checks payable to: DIRECTOR OF FINANCE OF HOWARD COUNTY
** PLEASE WRITE NEATLY AND LEGIBLY **

FOR OFFICE USE ONLY			
AGENCY	DATE	SIGNATURE APPROVAL	PROPERTY ID: <u>09830</u>
Land Development DPZ			Building
State Highway			Permit Fee
Building Official			Bridge Fee
Dev. Engineering DPZ			Additional Fee
Health			TOTAL FEES
Fire Protection			Sub-total paid
Sediment Control approval required prior to issuance			Balance due
YES ☐ NO ☐			Check
CONTINGENCY CONSTRUCTION START ☐			Validation
ONE STOP SHOP ☐			
Distribution of Copies: _____	White: Building Official	Green: UDD DPZ	Yellow: DED DPZ
			Pink: Health
			Gold: ASHA

11/Forms/PERMIT.FRM
Rev 4/17/00