

10 am C.O. Septic 6/30/00

03-326233

PERMIT

SEWAGE DISPOSAL SYSTEM
HOWARD COUNTY HEALTH DEPARTMENT
BUREAU OF ENVIRONMENTAL HEALTH
410-313-2640

P 513636

A 56429-GG

ISSUE DATE 6/14/2000

APPROVAL DATE 6/30/00

INDEXED

Harfields Equipment IS PERMITTED TO INSTALL x ALTER

ADDRESS 13785 Burntwoods Road, Glenelg, MD 21737 PHONE 301-854-6172

SUBDIVISION Gaither Hunt I LOT NUMBER 33 ADDRESS 11001 Steeplechase Court

PROPERTY OWNER Ryan Homes PROPERTY OWNER'S ADDRESS 11460 Cronridge Drive

OWINGS MILLS, MD 21117

SEPTIC TANK CAPACITY 1250 GALLONS

PUMP CHAMBER CAPACITY GALLONS

NUMBER OF BEDROOMS 4

SQUARE FEET PER BEDROOM 180

LINEAR FEET OF TRENCH REQUIRED 240

TRENCHES: Trenches to be 3 feet wide. Inlet 3 feet below original grade. Bottom maximum depth 5 feet below original grade. 2 feet of stone below distribution box.

LOCATION: Place the distribution box 130 feet down the right lot line and 10 feet off that same lot line. Run trenches along contour towards the left lot line as seen from Steeplechase Court.

PLANS APPROVED Amy McMillen OK 5/4/00 DKS DATE 4/3/2000

PERMIT VOID AFTER 2 YEARS

NOTE: CONTRACTOR RESPONSIBLE FOR SCHEDULING A PRE-CONSTRUCTION INSPECTION FOR ALL INSTALLATIONS

NOTE: TOP OF SEPTIC TANKS ARE TO BE NO DEEPER THAN 3.0 FEET BELOW FINISH GRADE

NOTE: WATERTIGHT SEPTIC TANKS REQUIRED

NOTE: CLEANOUT REQUIRED EVERY 70 FEET OF SEWER LINE AND/OR AT 90° SWEEPS IN LINES FROM HOUSE TO DRAIN FIELDS, 90° ELBOWS ARE NOT ACCEPTABLE

NOTE: ALL PARTS OF SEPTIC SYSTEMS (I.E. TANK, DISTRIBUTION BOX, DRAINFIELDS) TO BE 100 FEET FROM ANY WATER WELL UNLESS OTHERWISE SPECIFICALLY AUTHORIZED

NOTE: NO ABSORPTION TRENCH TO EXCEED 100 FEET IN LENGTH UNLESS SPECIFICALLY AUTHORIZED

NOTE: ALL PIPE FROM HOUSE TO SEPTIC TANK MUST BE CAST IRON OR SCHEDULE 35/40 PVC OR ABS

NOTE: MANHOLE RISERS REQUIRED ON ALL SEPTIC TANKS AND PUMP CHAMBERS

NOTE: DISTRIBUTION BOXES MUST HAVE BAFFLES

NOTE: IF PUMPED SEPTIC SYSTEM REQUIRED, (1) SEPTIC PUMP DETAIL TO BE PROVIDED BY INSTALLER PRIOR TO ISSUANCE OF SEPTIC PERMIT (2) PUMP PERFORMANCE TEST IS NECESSARY PRIOR TO HEALTH DEPARTMENT APPROVAL OF SEPTIC PERMIT


NEITHER THE HOWARD COUNTY COUNCIL NOR THE HEALTH DEPARTMENT IS RESPONSIBLE FOR THE SUCCESSFUL OPERATION OF ANY SYSTEM

PERMITTEE RESPONSIBLE FOR OBTAINING FINAL APPROVAL ON THIS PERMIT

CALL 410-313-2640 FOR INSPECTION OF SEPTIC SYSTEM

AS 6429-GG

NOT TO SCALE

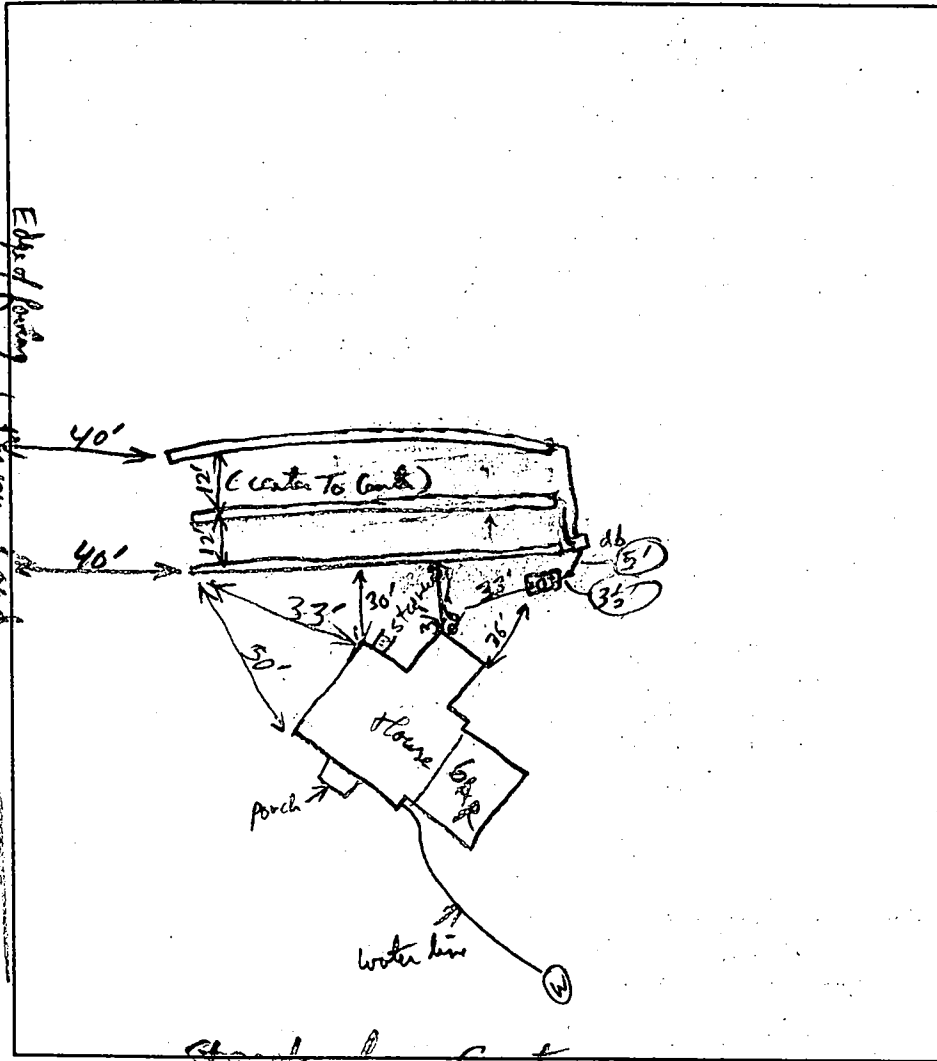

TRENCH DATA

TRENCH WIDTH 3'
TRENCH INLET DEPTH 3'
TRENCH BOTTOM DEPTH 5'
DEPTH OF STONE 2'
NUMBER OF TRENCHES 3
TOTAL TRENCH LENGTH 240'
ABSORBENT AREA 720 sq ft
DISTRIBUTION BOX LEVEL ✓ (near 5')
BAFFLE IN DISTRIBUTION BOX ✓

SEPTIC TANK DATA

SEPTIC TANK 1500 Mid Seamed GALLONS
MANHOLE RISER ✓ yes
6 INCH INSPECTION PORT ✓ yes

PUMP CHAMBER DATA

PUMP CHAMBER NA GALLONS
MANHOLE RISER _____
ALARM _____
PUMP PERFORMANCE TEST _____

PRE-CONSTRUCTION INSPECTION: _____

INSPECTION COMMENTS: House Connection, connecting supply pipes, septic tank, dist. box,
Manhole riser clear out pipe to S.T. (all cemented in place) all OK to cover,
all Trenches OK to cover. R/P 6/30/00

6/30/00 W/Pt - Poles OK, 3' x 4', 2 piece Cap, PVC conduit pipe, pump and OK to cover R/P 6/30/00

INSPECTOR R. P. Rimbly DATE SYSTEM APPROVED 6/30/00

6/30/00 WPI 2pm

HOWARD COUNTY HEALTH DEPARTMENT
Bureau of Environmental Health
3525-N Ellicott Mills Drive
Ellicott City, MD 21043
461-9933

APPLICATION FOR PITLESS ADAPTER, WELL PUMP AND PRESSURE TANK INSTALLATION

New Installation ☒
Replacement ☐

Receipt #
Date 7/17/2000

Name of Installer LEHSAC CORP

Telephone 410 242-6888

License Number 3344

Certified Well Pump Installer ☐ Well Driller ☐ Registered Plumber ☒

Name of Property Owner RYAN

Telephone 410-634-0501

Subdivision Gaithers Hunt Lot # 33

Well Tag # HO-94-1774

Site Address 4001 Steeple Chase Ct 6733

Pump

1. Type

- a. Deep well jet ☐
b. Shallow well jet ☐
c. Submersible ☒

2. Make JAGUZZI

3. Model # T154714A-52

4. Capacity 7 GPM

5. Pump exceeds well capacity Yes ☐ No ☒

6. If Yes, is low pressure cutoff switch installed? Yes ☐ No ☒

7. What methods are used to protect the pump and electrical wiring from vibrations? Torque arrestors ☒ Cable guards ☒ Other ☐

Motor

1. Horsepower 1

2. RPM 3450

3. Voltage 230

a. 110 ☐

b. 220 ☒

Pitless Adapter

1. Make WILKINS

2. Model # 42"

3. Depth 42"

Tank

1. Capacity 86 GAL

2. Pressure relief valve? YES

Piping

1. Type 16016

2. Size 1/2"

3. NSF and/or BOCA Code approved ☒

4. Depth of supply line 42"

Well data

1. Depth 300 ft.

2. Yield 8.5 GPM

3. Static water level 40 ft.

4. Will water supply be disinfected by installer? YES

I understand that it is my responsibility to notify the Howard County Health Department when the installation is ready for inspection (otherwise this permit is null and void).

All information given above is true to the best of my knowledge.

Signature of Applicant: [Signature]

Date: 7/17/2000

Note: A sticker indicating approval/status of the installation will be placed on the well casing at the time of the inspection.

HD-215

10' PUBLIC TREE MAINTENANCE EASEMENT

SEPTIC EASEMENT
Distribution Box
Ex. Grd. 487.8
Inv. 484.8
1250 Gal. Septic Tank
Inv. In 485.2
Inv. Out 484.9

SEPTIC EASEMENT
Distribution Box
Ex. Grd. 486.5
Inv. 483.5
1250 Gal. Septic Tank
Inv. In 482.0
Inv. Out 483.7

SEPTIC EASEMENT
Distribution Box
Ex. Grd. 485.5
Inv. 481.5
1250 Gal. Septic Tank
Inv. In 481.9
Inv. Out 481.0

FOX HAVEN WAY (FUTURE PUBLIC ROAD)

STEEL ECHASE COURT SCE

Post-it® Fax Note 7671

To	Date	# of pages
PAT ORLA	1-12	
Co./Dept BLDG/PERMIT/PLANNING	From T.E.	
Phone # Anthony Hunt	Co. CFS INC.	
Fax # Lot 33	Phone #	
	Fax #	

Signature _____ Date _____

Signature _____

1250 Gal Septic Tank
Inv. In 481.9
Inv. Out 481.0


HIGH GROVE
(REV.)
FF=493.04
928 B=484.30

Post-it® Fax Note	7671	Date	1-12	# of pages	1
To	PAT ORLA	From	T.E.		
Co./Dept.	Bldg/Permit/Brake	Co.	CFS-INC.		
Phone #	Garth HUNT	Phone #			
Fax #	104-33	Fax #			

[illegible]

Date 4/10/98
 Mary Ann Bloom Date 4/2/98
 John Klein Date 4/2/98
 William F. Klein (Owner) Date 4/2/98

RESIDUE
 PROPERTY OF
 CARROLL
 M., FOLIO 35

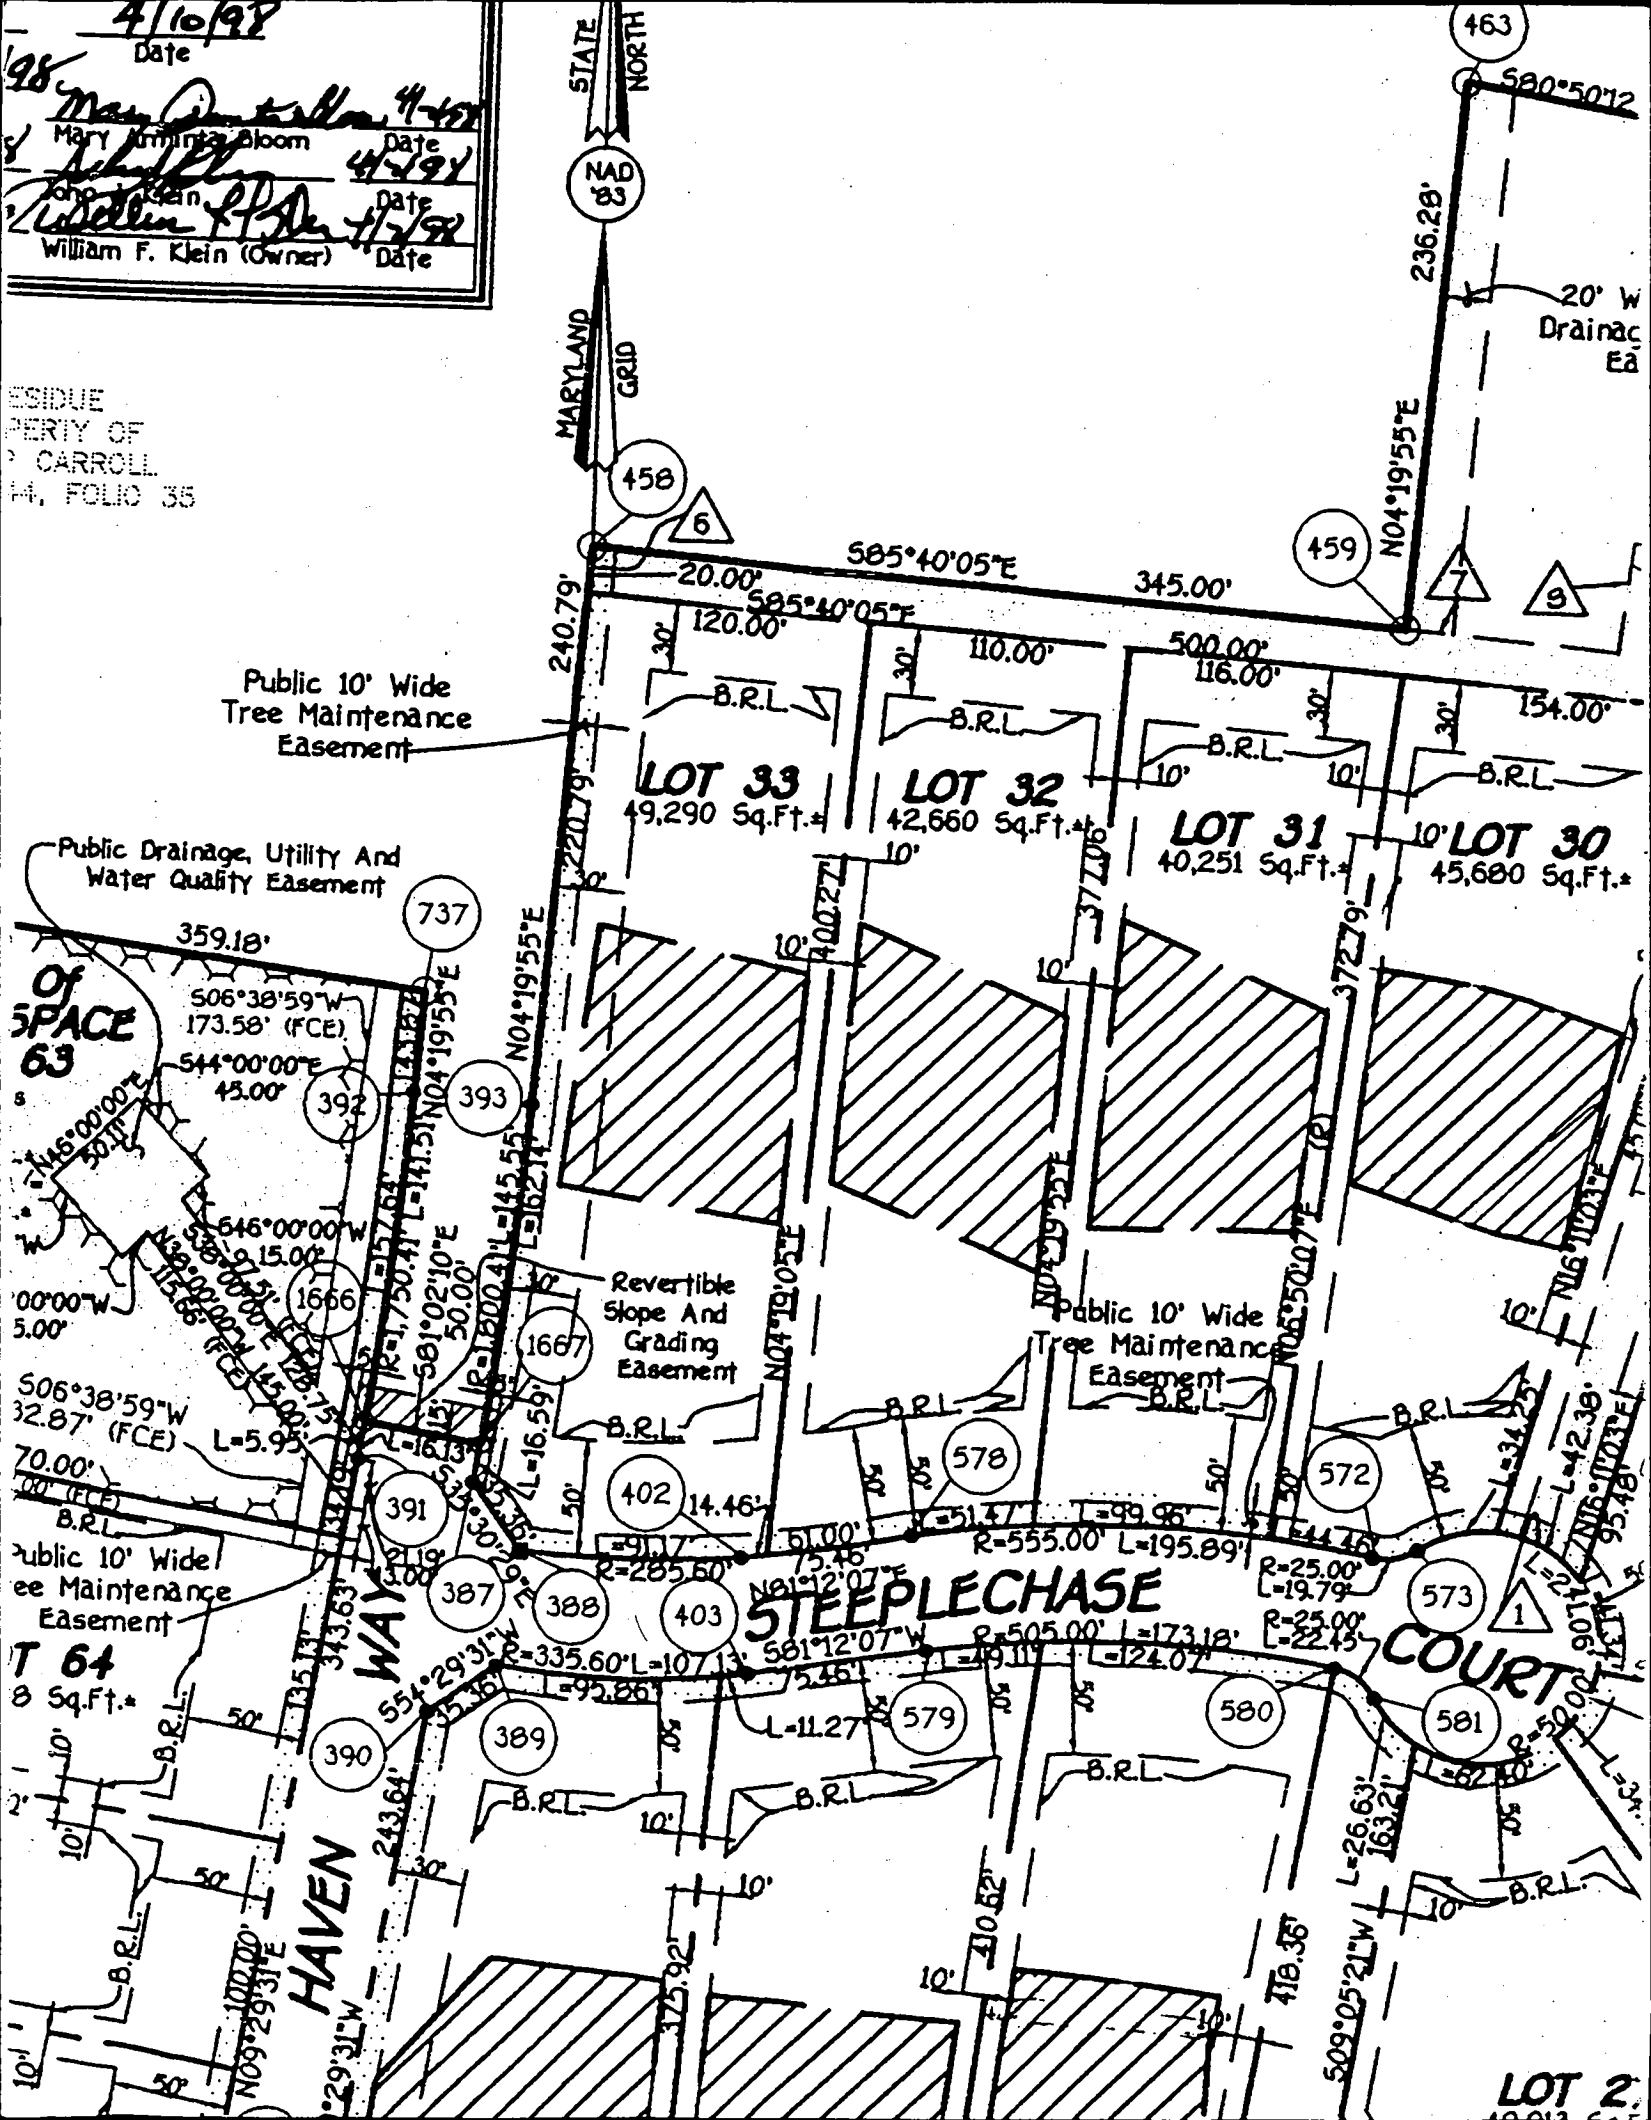

APPLICATION

PERCOLATION TESTING

5642966
A 56569

P _____

HOWARD COUNTY HEALTH DEPARTMENT
BUREAU OF ENVIRONMENTAL HEALTH
3525-H ELLICOTT MILLS DRIVE/ELLICOTT CITY, MARYLAND 21043
TELEPHONE: 313-2640

DISTRICT _____

DATE _____

TO: THE COUNTY HEALTH OFFICER
ELLICOTT CITY, MARYLAND

I HEREBY APPLY FOR THE NECESSARY TEST PRIOR TO APPLICATION FOR PERMIT TO CONSTRUCT (OR RECONSTRUCT) A SEWAGE DISPOSAL SYSTEM.

PROPERTY OWNER J Thomas Scrivener

ADDRESS c/o Land Design & Development PHONE 410 740 5176

AGENT OR PROSPECTIVE BUYER Donald R. Renner Jr

ADDRESS 10805 Hickory Ridge Rd PHONE _____
21044

PROPERTY LOCATION:

SUBDIVISION _____ LOT NO. 29 33

ROAD AND DESCRIPTION _____

TAX MAP 29 PARCEL # 21

SIZE OF LOT 1 + Acres TYPE BLDG. _____
(SINGLE FAMILY DWELLING OR COMMERCIAL)

THE SYSTEM INSTALLED UNDER THIS APPLICATION IS ACCEPTABLE ONLY UNTIL PUBLIC FACILITIES BECOME AVAILABLE. I FULLY UNDERSTAND THE
FEE CONNECTED WITH THE FILING OF THIS PERC TEST APPLICATION IS NON-REFUNDABLE UNDER ANY CIRCUMSTANCES. I ALSO AGREE TO
COMPLY WITH ALL M.O.S.H.A. REQUIREMENTS IN TESTING THIS LOT. [Signature]
(SIGNATURE OF APPLICANT)

APPROVED BY _____ FOR _____ DATE _____

DISAPPROVED BY _____ FOR _____ DATE _____

HOLD PENDING FURTHER TESTS _____

REASONS FOR REJECTION OR HOLDING _____

PERCOLATION TEST PLAT/PRELIMINARY PLAT - TITLE OR I.D. # _____ DATE _____

SITE DEVELOPMENT PLAN/FINAL PLAT - TITLE OR I.D. # _____ DATE _____

THIS IS NOT A PERMIT

COUNTY #

SOIL PROFILE

0'

1601

Topsoil.
Brown
clay
loam
Brown
sandy
loam
25g Quartz
Rocks
74'
10-25g
Gravel
Through

1599

TOPSOIL
REDISH
ORANGE
SANDY
CLAY

OAKS
ORANGE/
BROWN
SANDY
LOAM
6"-12"
LAYERS
OF ROCK
SANDY
LOAM > 7'

		REQUESTED MAKE UP TEST LOCATIONS SEVERAL LOTS		

INDICATE NORTH - NAME ADJOINING ROADWAY AS BASE LINE.

SOIL PROFILE

0

TOP SOIL
BROWN CLAY LOAM
TANISH OLIVE SILT LOAM
TAN SANDY LOAM WHITE PARENTS w/DRAB MOTTLED
DRY

5

6

11.

[illegible]REMARKS SEE TEST PLAN FOR APPROX. LOCATION

TYPE OF SOIL TEST 1600, 15 PART OF PROPOSE

TESTED BY G. SAVAGE

ALSO PRESENT

TRENCH DESIGN DATA: AVERAGE PERCOLATION TIME

TRENCH WIDTH

INLET DEPTH

MAXIMUM BOTTOM DEPTH

SQ. FT./BEDROOM

APPLICATION

PERCOLATION TESTING

A 5642966

P _____

HOWARD COUNTY HEALTH DEPARTMENT
BUREAU OF ENVIRONMENTAL HEALTH
3525-H ELLICOTT MILLS DRIVE/ELLICOTT CITY, MARYLAND 21043
TELEPHONE: 313-2640

DISTRICT _____

DATE 4-12-96

TO: THE COUNTY HEALTH OFFICER
ELLICOTT CITY, MARYLAND

I HEREBY APPLY FOR THE NECESSARY TEST PRIOR TO APPLICATION FOR PERMIT TO CONSTRUCT (OR RECONSTRUCT) A SEWAGE DISPOSAL SYSTEM.

PROPERTY OWNER J Thomas Scrivener

ADDRESS C/o Land Design & Development PHONE 410 740 5176

AGENT OR PROSPECTIVE BUYER Donald R. Reuwer Jr

ADDRESS 10805 Hickory Ridge Rd PHONE _____
21044

PROPERTY LOCATION:

SUBDIVISION _____ LOT NO. 52

ROAD AND DESCRIPTION _____

TAX MAP 29 PARCEL # 21

SIZE OF LOT 1 + Acres TYPE BLDG. _____
(SINGLE FAMILY DWELLING OR COMMERCIAL)

THE SYSTEM INSTALLED UNDER THIS APPLICATION IS ACCEPTABLE ONLY UNTIL PUBLIC FACILITIES BECOME AVAILABLE. I FULLY UNDERSTAND THE
FEE CONNECTED WITH THE FILING OF THIS PERC TEST APPLICATION IS NON-REFUNDABLE UNDER ANY CIRCUMSTANCES. I ALSO AGREE TO
COMPLY WITH ALL M.O.S.H.A. REQUIREMENTS IN TESTING THIS LOT.

[Signature]
(SIGNATURE OF APPLICANT)

APPROVED BY _____ FOR _____ DATE _____

DISAPPROVED BY _____ FOR _____ DATE _____

HOLD PENDING FURTHER TESTS _____

REASONS FOR REJECTION OR HOLDING _____

PERCOLATION TEST PLAT/PRELIMINARY PLAT - TITLE OR I.D. # _____ DATE _____

SITE DEVELOPMENT PLAN/FINAL PLAT - TITLE OR I.D. # _____ DATE _____

THIS IS NOT A PERMIT

A5642966





COUNTY #

FARM ROAD

N. →

SOIL PROFILE

0'

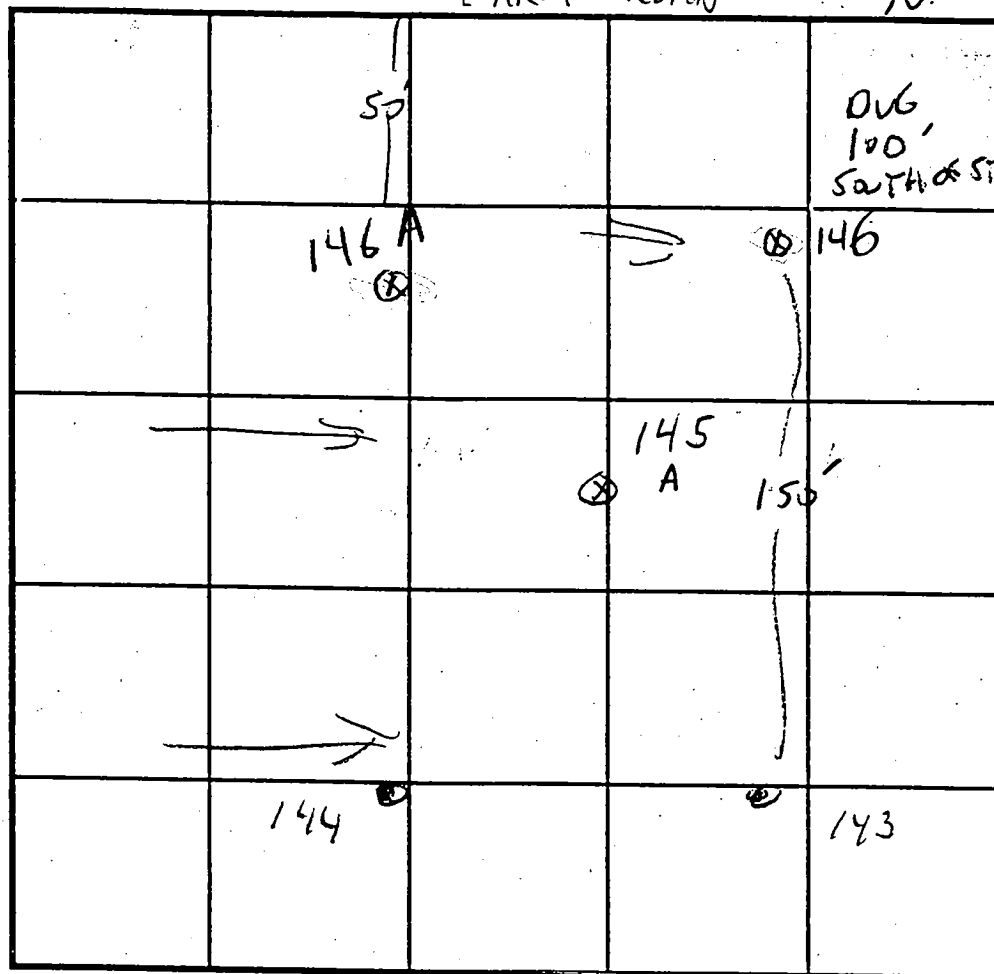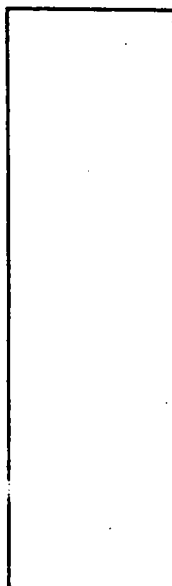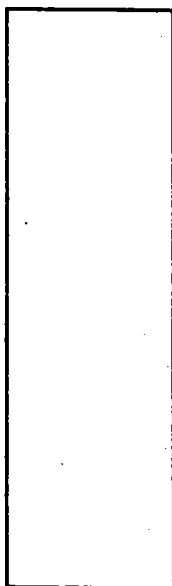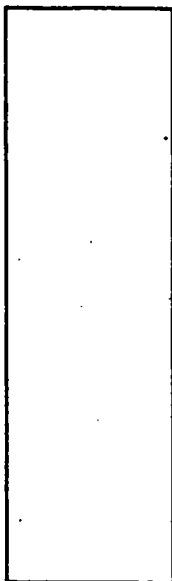

SOIL PROFILE

145A

Topsoil

1' LAYERS
of Brown
+ orange
clay loamBrown
sandy
loam

6

12

INDICATE NORTH - NAME ADJOINING ROADWAY AS BASE LINE.

DATE	TEST NO.	DEPTH	PRE-WET		TEST - 1" DROP		TIME
			START	STOP	START	STOP	
4-12-96	143	5' 6" / 10					9 min
	144	5' 11" / 6					8 min
	146A	5' 12	3:56	3:57			
	146A	5' 11	3:47	3:48	3:48	3:50	2 min
	145A	5' 12	VISUAL				

REMARKS LOT 5.2, ALL HOLES HAVE SIMILAR PROFILE

TYPE OF SOIL

TESTED BY G. SAVAGE

ALSO PRESENT Don Revere, AISC value

TRENCH DESIGN DATA: AVERAGE PERCOLATION TIME TRENCH WIDTH

INLET DEPTH MAXIMUM BOTTOM DEPTH SQ. FT./BEDROOM

C1	321	SEQUENCE NO. (MDE USE ONLY)	STATE OF MARYLAND WELL COMPLETION REPORT FILL IN THIS FORM COMPLETELY PLEASE TYPE		THIS REPORT MUST BE SUBMITTED AFTER WELL IS COMPLETED.	
1	2	3	4	5	COUNTY NUMBER	A5642966
ST/CO USE ONLY DATE Received MM DO YY		DATE WELL COMPLETED MM DO YY		Depth of Well		PERMIT NO. FROM "PERMIT TO DRILL WELL"
8 13		12 16 98		22 300 26 (TO NEAREST FOOT)		HO-99-1579 28 29 30 31 32 33 34 35 36 37

OWNER	RUSSELL DEV	first name	last name
STREET OR RFD	STEERECHASE CT	TOWN	ELLICOTT CITY
SUBDIVISION	GAITHER HUNT	SECTION	1
		LOT	33

WELL LOG Not required for driven wells		
STATE THE KIND OF FORMATIONS PENETRATED, THEIR COLOR, DEPTH, THICKNESS AND IF WATER BEARING		
DESCRIPTION (Use additional sheets if needed)	FEET FROM TO	check if water bearing
Brown Soil	0 25	
Brown Sandstone	25 35	
Gray Granite	35 140	
Green Granite	140 150	
Gray Granite	150 300	
	50 ✓	
	120 ✓	
	150 ✓	

GROUTING RECORD	
WELL HAS BEEN GROUTED (Circle Appropriate Box)	
yes Y	no N
TYPE OF GROUTING MATERIAL (Circle one)	
CEMENT CM	BENTONITE CLAY BC
NO. OF BAGS 45 46 NO. OF POUNDS 45 46	
GALLONS OF WATER 3.0	
DEPTH OF GROUT SEAL (to nearest foot)	
from 0 ft. to 40 ft.	
(enter 0 if from surface)	

CASING RECORD		
casing types insert appropriate code below		
ST STEEL	CO CONCRETE	
PL PLASTIC	OT OTHER	
MAIN CASING TYPE		
ST	06	40
60 61	63 64	66 70
Nominal diameter top (main) casing (nearest inch)		
Total depth of main casing (nearest foot)		

OTHER CASING (if used)	
diameter inch	depth (feet) from to

SCREEN RECORD		
screen type or open hole		
ST STEEL	BR BRASS	HO OPEN HOLE
	PL PLASTIC	OT OTHER

DEPTH (nearest ft.)	
1 2 3 80	40 300

SLOT SIZE	
1 2 3	
DIAMETER OF SCREEN (NEAREST INCH)	
56 60 64 68	

GRAVEL PACK		
IF WELL DRILLED WAS FLOWING WELL INSERT F IN BOX 68		
MDE USE ONLY (NOT TO BE FILLED IN BY DRILLER)		
T (E.R.O.S.)	W Q	
70 72 74 75 76		
TELESCOPE CASING	LOG INDICATOR	OTHER DATA

PUMPING TEST		
HOURS PUMPED (nearest hour) 3		
PUMPING RATE (gal. per min.) 8.5		
METHOD USED TO MEASURE PUMPING RATE watch + bucket		
WATER LEVEL (distance from land surface) 4.5 ft.		
BEFORE PUMPING 34 ft.		
WHEN PUMPING 139 ft.		
TYPE OF PUMP USED (for test)		
A air	P piston	T turbine
C centrifugal	R rotary	O other (describe below)
J jet	S submersible	



PUMP INSTALLED	
DRILLER INSTALLED PUMP (CIRCLE) (YES or NO) YES NO	
IF DRILLER INSTALLS PUMP, THIS SECTION MUST BE COMPLETED FOR ALL WELLS.	
TYPE OF PUMP INSTALLED (PLACE (A,C,J,P,R,S,T,O) IN BOX 29)	
CAPACITY: GALLONS PER MINUTE (to nearest gallon) 31 35	
PUMP HORSE POWER 37 41	
PUMP COLUMN LENGTH (nearest ft.) 43 47	
CASING HEIGHT (circle appropriate box and enter casing height)	
+ above	
LAND SURFACE 2 (nearest foot)	
- below	

LOCATION OF WELL ON LOT	
SHOW PERMANENT STRUCTURES AND INDICATE NOT LESS THAN TWO DISTANCES (MEASUREMENTS TO WELL)	
15'	
25'	

NUMBER OF UNSUCCESSFUL WELLS: 0	
WELL HYDROFRACTURED yes Y no N	
CIRCLE APPROPRIATE LETTER	
A	A WELL WAS ABANDONED AND SEALED WHEN THIS WELL WAS COMPLETED
E	ELECTRIC LOG OBTAINED
P	TEST WELL CONVERTED TO PRODUCTION WELL

I HEREBY CERTIFY THAT THIS WELL HAS BEEN CONSTRUCTED IN ACCORDANCE WITH COMAR 26.04.04 "WELL CONSTRUCTION" AND IN CONFORMANCE WITH ALL CONDITIONS STATED IN THE ABOVE CAPTIONED PERMIT, AND THAT THE INFORMATION PRESENTED HEREIN IS ACCURATE AND COMPLETE TO THE BEST OF MY KNOWLEDGE

DRILLERS LIC. NO. M WD 355	
DRILLERS SIGNATURE	
(MUST MATCH SIGNATURE ON APPLICATION)	
LIC. NO. JW D 341	
Max L. Jones	
SITE SUPERVISOR (sign. of driller or journeyman responsible for sitework if different from permittee)	

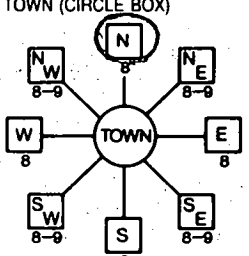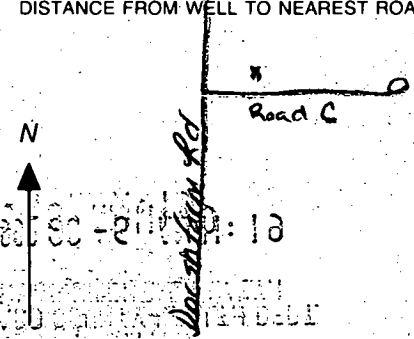B 1 8063 1 2 3 4 5 6	SEQUENCE NO. (MDE USE ONLY)	STATE OF MARYLAND PERMIT TO DRILL WELL please print or type	STATE PERMIT NUMBER H0-94-1779 70 fill in this form completely 79
Date Received (APA) 8 MM DD YY 13 <u>RUSSELL DEVELOPMENT LLC</u> 15 Last Name Owner First Name 34 <u>8808 CENTRE PARK DRIVE Suite 209</u> 36 Street or RFD 55 <u>Columbia MD 21045</u> 57 Town 70 State 72 Zip 76		B 3 LOCATION OF WELL <u>HOWARD</u> 8 COUNTY 21 <u>GATHER HUNT</u> 23 SUBDIVISION 42 SECTION <u>1</u> LOT <u>33</u> 44 46 48 50 <u>ELICOTT CITY</u> 52 NEAREST TOWN 71 MILES FROM TOWN (enter 0 if in town) <u>4</u> 73 76 77 78	
DRILLER INFORMATION <u>MICHAEL BARLOW</u> <u>MWD 355</u> Driller's Name 76 License No. 81 <u>MICHAEL BARLOW Well Drilling Svc Inc</u> Firm Name <u>912 FAWN COURT, JOPPA, MD 21085</u> Address Signature _____ Date _____		B 4 1 2 DIRECTION OF WELL FROM TOWN (CIRCLE BOX)  ON WHICH SIDE OF ROAD (CIRCLE APPROPRIATE BOX)  NEAR WHAT ROAD <u>STEEPLE CHAPEL</u> 11 30 ON WHICH SIDE OF ROAD (CIRCLE APPROPRIATE BOX) DISTANCE FROM ROAD <u>30</u> 34 37 ENTER FT OR MI 38 39 TAX MAP <u>29</u> BLK: <u>11</u> PARCEL <u>322</u>	
WELL INFORMATION B 2 1 2 APPROX. PUMPING RATE (GAL. PER MIN.) <u>5</u> 8 12 AVERAGE DAILY QUANTITY NEEDED (GAL. PER DAY) <u>500</u> 14 20		NOT TO BE FILLED IN BY DRILLER HEALTH DEPARTMENT APPROVAL <u>HOWARD</u> <u>A5642966</u> COUNTY NAME COUNTY NO. STATE SIGNATURE _____ INSERT S → _____ DATE ISSUED <u>10/14/98</u> <u>10/14/99</u> 43 MM DD YY 48 CO SIGNATURE _____ EXP. DATE _____ NORTH GRID <u>520</u> 000 EAST GRID <u>830</u> 000 50 55 57 63	
USE FOR WATER (CIRCLE APPROPRIATE BOX) ☒ DOMESTIC POTABLE SUPPLY & RESIDENTIAL IRRIGATION ☐ FARMING (LIVESTOCK WATERING & AGRICULTURAL IRRIGATION) ☐ INDUSTRIAL, COMMERCIAL, DEWATERING ☐ PUBLIC WATER SUPPLY WELL ☐ TEST, OBSERVATION, MONITORING ☐ GEO-THERMAL		SHOW MAJOR FEATURES OF BOX & LOCATE WELL WITH AN X SOURCES OF DRILLING WATER 1. 2. 3. WRITE THE BOX NUMBER FROM THE MAP HERE E <u>830</u> N <u>520</u> 000 000	
APPROXIMATE DEPTH OF WELL <u>200</u> FEET 24 28 APPROXIMATE DIAMETER OF WELL <u>6'</u> NEAREST INCH		12/16/98 Grout 10:30 X	
METHOD OF DRILLING (circle one) BORED (or Augered) JETTED Jetted & DRIVEN 30 AIR-ROTary <u>AIR-PERCussion</u> ROTARY (Hydraulic Rotary) 37 CABLE REVERSE-ROTary DRIVE-POINT other _____		DRAW A SKETCH BELOW SHOWING LOCATION OF WELL IN RELATION TO NEARBY TOWNS AND ROADS AND GIVE DISTANCE FROM WELL TO NEAREST ROAD JUNCTION 	
REPLACEMENT OR DEEPEMED WELLS (CIRCLE APPROPRIATE BOX) ☒ THIS WELL WILL NOT REPLACE AN EXISTING WELL ☐ THIS WELL WILL REPLACE A WELL THAT WILL BE ABANDONED AND SEALED 39 ☐ THIS WELL WILL REPLACE A WELL THAT WILL BE USED AS A STANDBY-CONTACT LOCAL APPROVING AUTHORITY FOR POLICY ON STANDBY WELLS ☐ THIS WELL WILL DEEPEMED AN EXISTING WELL PERMIT NUMBER OF WELL TO BE REPLACED OR DEEPEMED (IF AVAILABLE) 41 _____ 52 _____		Not to be filled in by driller (MDE OR COUNTY USE ONLY) APPROP. PERMIT NUMBER <u>54</u> G A P PERMIT No. <u>H0-94-1779</u> 70 71 72 73 74 75 76 77 78 79	
SPECIAL CONDITIONS NOTE - APPROVING AUTHORITIES SHOULD USE SEPARATE SHEET IF NEEDED -			

GANTHER HUNT 11-6-98

LOT 33 RYAN 98-009

ATTN

MIKE SHERRER

PROPOSED WELL LOCATION

JOEY @ CFS

ATTN

GLEN SAVAGE

11-12-98

11-12-98

PRELIM OK
ARLEY FIELD WL

11-13-98

WSI OK

10' PUBLIC TREE
MAINTENANCE EASEMENT

S85°40'05"E

120.00'

110.00'

30' BRL

33

49,290 SF

30' BRL

32

42,660 SF

BASEMENTS WILL NOT
SEWER BY GRAVITY
LOTS 32 & 33

FOX HAVEN WAY
(FUTURE
PUBLIC ROAD)

N04°19'55"E

220.79'

L=162.14'

R=1,800'

R=1,800'

SEPTIC
BASEMENT
Distribution Box
Ex Grd 487.8
Inv 484.8
1250 Gal. Septic Tank
Inv In 485.2
Inv Out 484.9

SEPTIC
BASEMENT
Distribution Box
Ex Grd 486.5
Inv 483.5
1250 Gal. Septic Tank
Inv In 484.0
Inv Out 483.7

AVALON

FF 494.11

GA 485.50

GA 485.50

Inv 482.5
FF 493.00
GA 484.90

STEEPLECHASE CC

(PUBLIC ROAD)

GA 485.50

GA 485.50

11-2-48

PLEASE REVIEW Lot
33 Gauthier Hunt
for an alternative
Well Location

THANK YOU

JOEY ECKER @ CFS

PH # 410 381 9500

11.5.98

11.5.98
T.C. w/ JOSEY GCKER

ALTERNATE
CALL SITE

OK ALONG FRONT
OF LOT MAINTAINING
STANDARD SETBACKS
(DISCUSSED) AD

