

3/29/66
Ready

PERMIT

SEWAGE DISPOSAL SYSTEM

MARYLAND STATE DEPARTMENT OF HEALTH

HOWARD COUNTY

INDEXED

ELLICOTT CITY

DISTRICT 3

DATE 3/24/66

P 11626
57634-B
A 11537

Elwood Scaggs IS PERMITTED TO INSTALL ☒ ALTER

ADDRESS Murphy Rd., Laurel, Md. PHONE PA 5-0324

A SEWAGE DISPOSAL SYSTEM LOCATED AT _____

SUBDIVISION _____ ROAD Day LOT _____

PROPERTY OWNER Samuel L. Warfield & Wife

ADDRESS _____

SPECIFICATIONS - 2 bedrooms

DRAIN FIELD _____ DEPTH _____ FEET, BOTTOM AREA _____ SQ. FT.

SEEPAGE PITS _____ ABSORBENT SIDE-WALL AREA _____ SQ. FT.

SEPTIC TANK CAPACITY 750 GALLONS

FOR GARBAGE GRINDER, INCREASE DISPOSAL AREA 22% & TANK CAPACITY 50%.

OTHER Dry well - 300 sq. ft. absorbent sidewall area below inlet pipe.

Inlet pipe no deeper than 4 ft. below grade.


Place dry well about 75 ft. from electric line and about 15 ft. from fence row as shown on application.

PLANS APPROVED BY D. W. Monaghan DATE 3/23/66

FILL SEPTIC TANK AND DISTRIBUTION BOX WITH WATER BEFORE CALLING FOR AN INSPECTION. COVER NO WORK UNTIL INSPECTED AND APPROVED.

NEITHER THE HOWARD COUNTY COMMISSIONERS NOR THE HEALTH DEPARTMENT IS RESPONSIBLE FOR THE SUCCESSFUL OPERATION OF ANY SYSTEM.

A-11537-57634-B

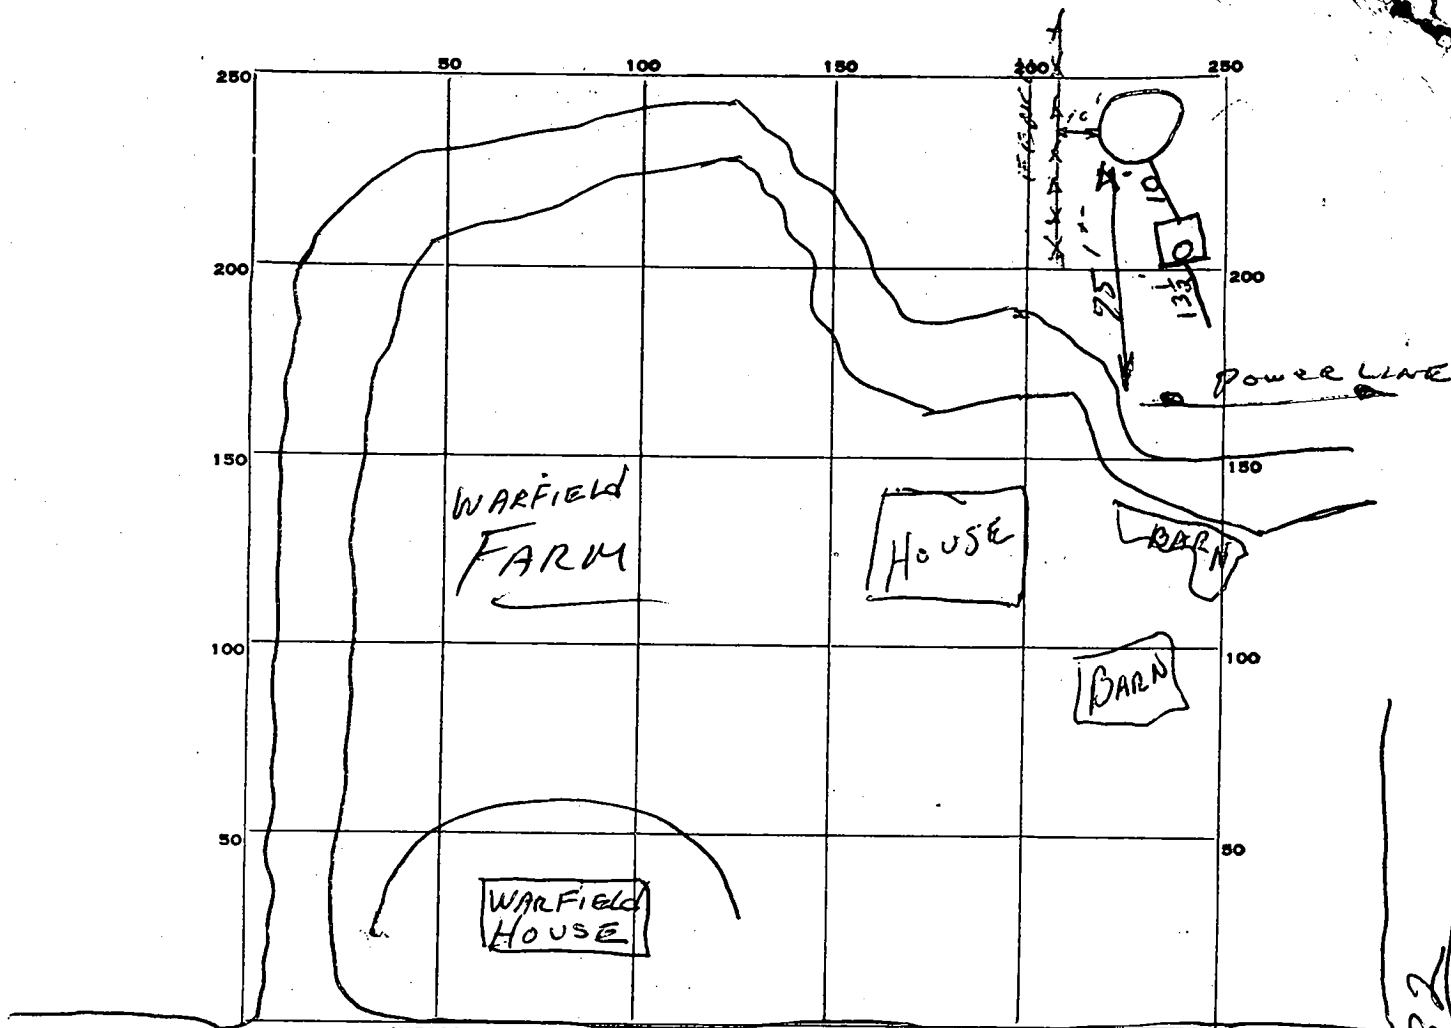

INDICATE NORTH. - NAME ADJOINING ROADWAY AS BASE LINE.

DAY ROAD

PERMIT CARD yes

SEPTIC TANK, LEVEL Concrete 750 gal.

CLEANOUTS 8" Stand pipe

DISTRIBUTION BOX, LEVEL None

TILE FIELD, DEPTH _____ FT. TRENCH WIDTH _____ FT.

GRAVEL DEPTH _____ IN. TOTAL LENGTH _____ FT.

NUMBER OF TRENCHES _____ TOTAL BOTTOM AREA _____

SEEPAGE PITS, INSIDE DIAMETER 12 FT. DEPTH BELOW INLET 9' 2"

ABSORBENT AREA OK SQ. FT.

REMARKS _____

DATE SYSTEM APPROVED

3-29-66

INSPECTOR

J. Hennigan

RT-32

Recorded

APPLICATION

SEWAGE DISPOSAL TESTING

A 11537
P _____

MARYLAND STATE DEPARTMENT OF HEALTH

3/23/66
1 PM

HOWARD COUNTY

ELLICOTT CITY

DISTRICT 3

DATE 3/7/66

*Septic Tank - 750 gal.
Dry Well - 300 sq ft absorbent sidewalk area
below inlet pipe. Inlet pipe no deeper than up
below grade*

*Place Dry Well about 75 ft from electric line
and about 15 ft from fence row as shown
on application*

TO: THE COUNTY HEALTH OFFICER
ELLICOTT CITY, MARYLAND

I, HEREBY, APPLY FOR THE NECESSARY TESTS IN ORDER TO CONSTRUCT (OR RECONSTRUCT) A SEWAGE DISPOSAL SYSTEM.

PROPERTY OWNER Samuel L. Warfield and Wife

ADDRESS Day Road, Sykesville, Maryland PHONE HU9-4406

PROPERTY LOCATION:

SUBDIVISION _____ LOT NO. _____

ROAD AND DESCRIPTION 1 Mile South of Sykesville, West side of Route 32

OCCUPANT _____ PHONE _____

PERSON TO CONSTRUCT SYSTEM _____

ADDRESS _____ PHONE _____

SIZE OF LOT (1/2 acre) 152 acres TYPE BLDG. Mobile Home, 2 Bedroom
NUMBER OF BEDROOMS

IF NOT SINGLE RESIDENCE DESCRIBE _____

SIGNATURE OF APPLICANT Samuel L. Warfield


APPROVED BY W. Monaghan FOR Dry Well DATE 3-23-66
(KIND OF SYSTEM)

REJECTED BY _____ FOR _____ DATE _____
(KIND OF SYSTEM)

HOLD PENDING FURTHER TESTS _____ DATE _____

REASONS FOR REJECTION OR HOLDING _____

THIS IS NOT A PERMIT

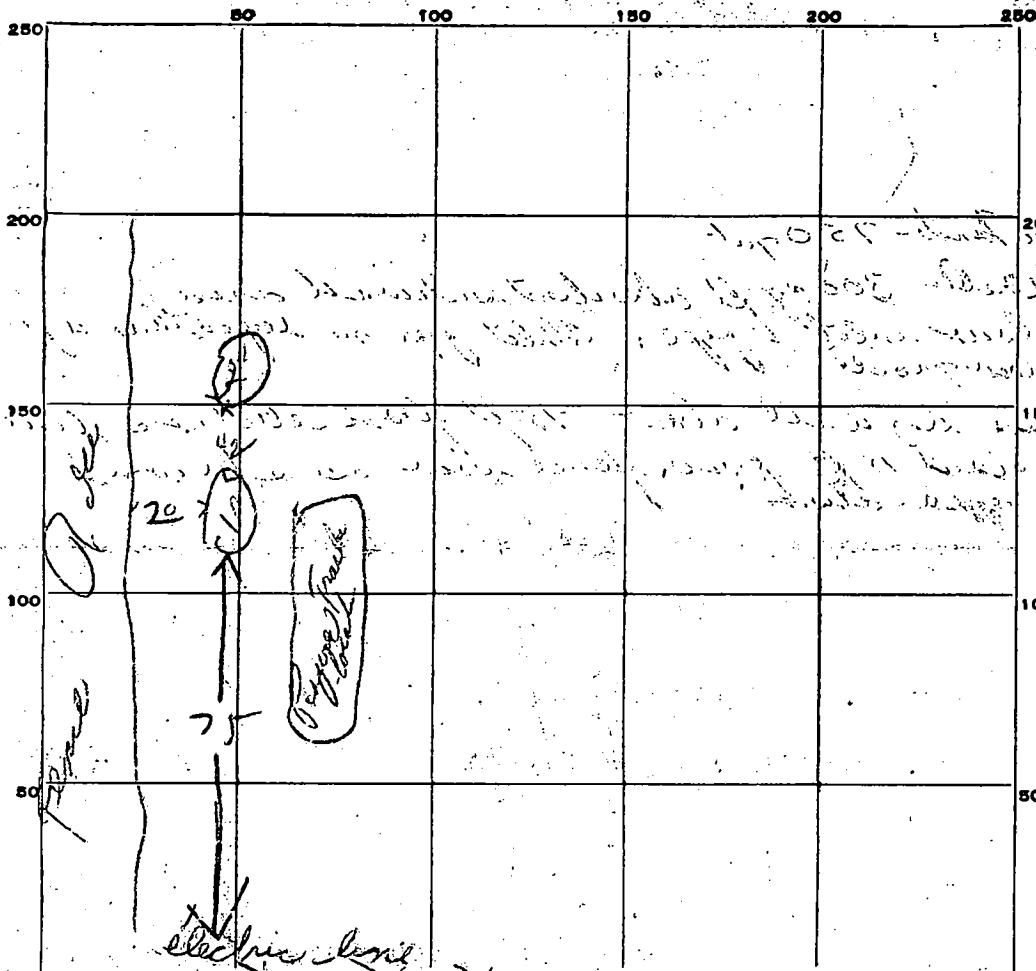

INDICATE NORTH. NAME ADJOINING ROADWAY AS BASE LINE.

Drumway to Pt 32

DATE	TEST NO.	DEPTH	PRE-WET		TEST - 1" DROP		TIME
			START	STOP	START	STOP	
3/23/6	1	9 1/2 ft	40	42	42	46	4 min
	2	4 ft	49	55	55	57	12 min
	3	not tested same by Mr. Sackos & others p. 2					
	4						

SOIL AUGER FINDING

TESTED BY

REMARKS

Drum 5 ft up day - then good sand
Samuel S. W. arfield

Print in triplicate.

Make \$15.00 check payable to:
Howard County Health Dept. - Sanitation

No 5-5000, Rev. 57
Mr. Wier

APPLICATION

SEWAGE DISPOSAL TESTING

MARYLAND STATE DEPARTMENT OF HEALTH

A 11537
P _____

HOWARD COUNTY

ELLICOTT CITY

✓ DISTRICT 3

✓ DATE 3/7/66

MAR 8 - 1966

Sept. 7-750 gal.

*Ry Well - 300 sq ft absorbent sidewall area
below inlet pipe. Inlet pipe no deeper than 4 ft
below rock*

*Pls. Ry Well about 75 ft from electric line
about 15 ft from fence row as shown
on application*

TO: THE COUNTY HEALTH OFFICER
ELLICOTT CITY, MARYLAND

I, HEREBY, APPLY FOR THE NECESSARY TESTS IN ORDER TO CONSTRUCT (OR RECONSTRUCT) A SEWAGE DISPOSAL SYSTEM.

✓ PROPERTY OWNER Samuel L. Warfield and Wife

✓ ADDRESS Day Road, Sykesville, Maryland

PHONE HU9-1406

PROPERTY LOCATION:

SUBDIVISION _____ LOT NO. _____

✓ ROAD AND DESCRIPTION 1 Mile South of Sykesville, West side of Route 32

OCCUPANT _____ PHONE _____

PERSON TO CONSTRUCT SYSTEM _____

ADDRESS _____ PHONE _____

✓ SIZE OF LOT 1 1/2 acre / 15.2 acres TYPE BLDG. Mobile Home, 2 Bedroom
NUMBER OF BEDROOMS _____

IF NOT SINGLE RESIDENCE DESCRIBE _____

✓ SIGNATURE OF APPLICANT Samuel L. Warfield

✓ APPROVED BY Dr. Monaghan

FOR

(KIND OF SYSTEM)

DATE

3-23-66

REJECTED BY _____

FOR

(KIND OF SYSTEM)


DATE

HOLD PENDING FURTHER TESTS _____

DATE

REASONS FOR REJECTION OR HOLDING _____

THIS IS NOT A PERMIT

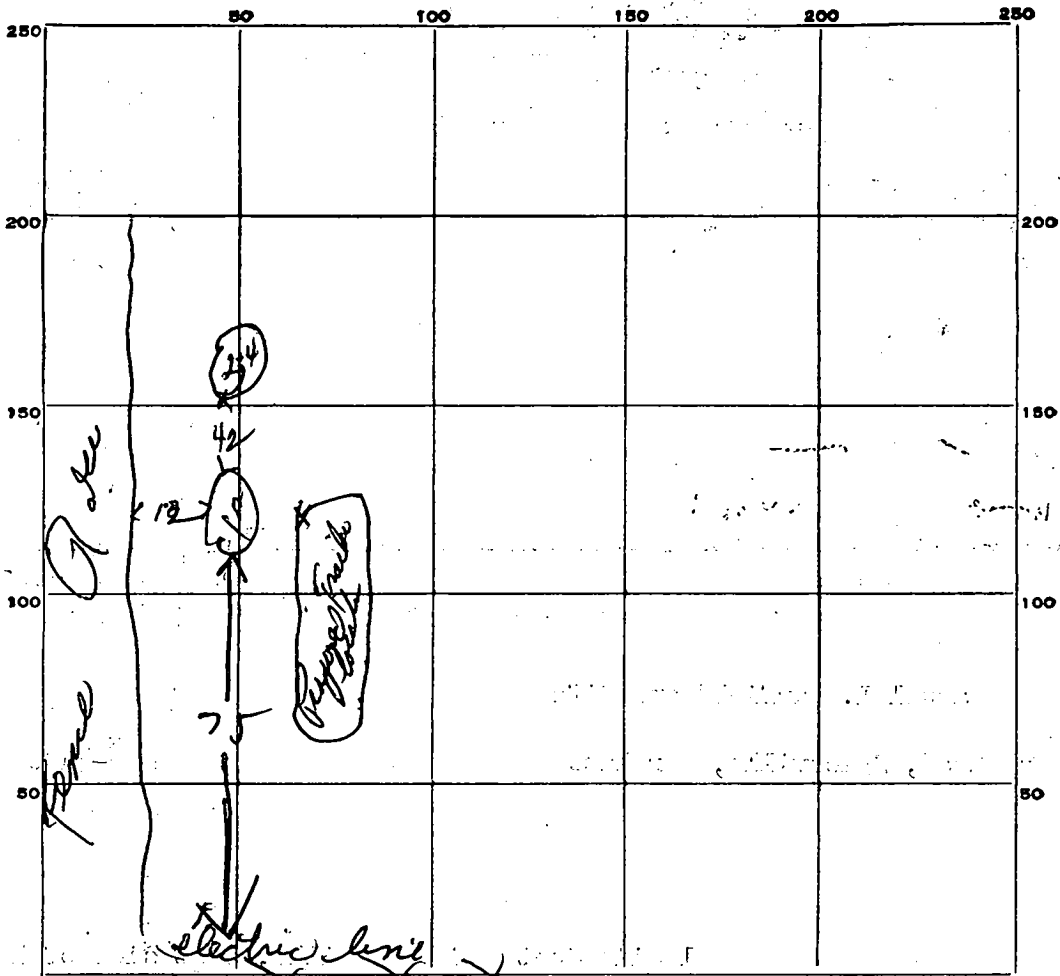

INDICATE NORTH. NAME ADJOINING ROADWAY AS BASE LINE.

Driveway to Rt 32

DATE	TEST NO.	DEPTH	PRE-WET		TEST - 1" DROP		TIME
			START	STOP	START	STOP	
9/23/66	1	9 1/2 ft	1 40	1 42	1 42	1 46	4 min
	2	4 ft	1 49	1 50	1 55	2 07	12 min
	3	not tested same type soil as holes #2					
	4						

SOIL AUGER FINDING first 4 ft clay - then good sand

TESTED BY: DWM

REMARKS: also present - sand & warfield