

4/4/65 - Approved - JH

20464

PERMIT

SEWAGE DISPOSAL SYSTEM

MARYLAND STATE DEPARTMENT OF HEALTH

HOWARD COUNTY

ELLCOTT CITY

DISTRICT 2

DATE 11/1/65

INDEXED

Excavating Contractors, Inc. IS PERMITTED TO INSTALL X ALTER _____

ADDRESS 30 Asher Hill Drive, E. C. PHONE NE 8-5888

A SEWAGE DISPOSAL SYSTEM LOCATED AT _____

SUBDIVISION Turf Valley ROAD 2681 Turf Valley Rd. LOT 13

PROPERTY OWNER Mr. Walter George A. YUN

ADDRESS _____

SPECIFICATIONS - 3 bedrooms

DRAIN FIELD _____ DEPTH _____ FEET. BOTTOM AREA _____ SQ. FT.

SEEPAGE PITS _____ ABSORBENT SUB-WALL AREA _____ SQ. FT.

SEPTIC TANK CAPACITY 750 GALLONS

FOR GARBAGE GRINDER, INCREASE DISPOSAL AREA AND TANK CAPACITY 50%.

OTHER Dry well - 500 sq. ft. sidewalk area below inlet pipe. Inlet pipe must be 4 ft. below grade.

Place dry well 25 to 33 ft. from rear lot line and about 60 ft. from right side of road when facing lot from Turf Valley Rd.

PLANS APPROVED BY D. M. Monaghan DATE 2/3/65

FILL SEPTIC TANK AND DISTRIBUTION BOX WITH WATER BEFORE CALLING FOR AN INSPECTION. COVER NO WORK UNTIL INSPECTED AND APPROVED.

NEITHER THE HOWARD COUNTY COMMISSIONERS NOR THE HEALTH DEPARTMENT IS RESPONSIBLE FOR THE SUCCESSFUL OPERATION OF ANY SYSTEM.

BLOG. PERMIT SIGNED
AND RETURNED 2/3/67
Serial # 67114059
San Room


John PK
BLOG. PERMIT SIGNED
AND RETURNED 10/1/66
Serial # 56014
notre not

A-51088-12

2/5/69

Test when D.W. located
not to be off pipe

5 in of 2" pipe
show - 2" above 4" pipe
D.W. 2" above
4" pipe

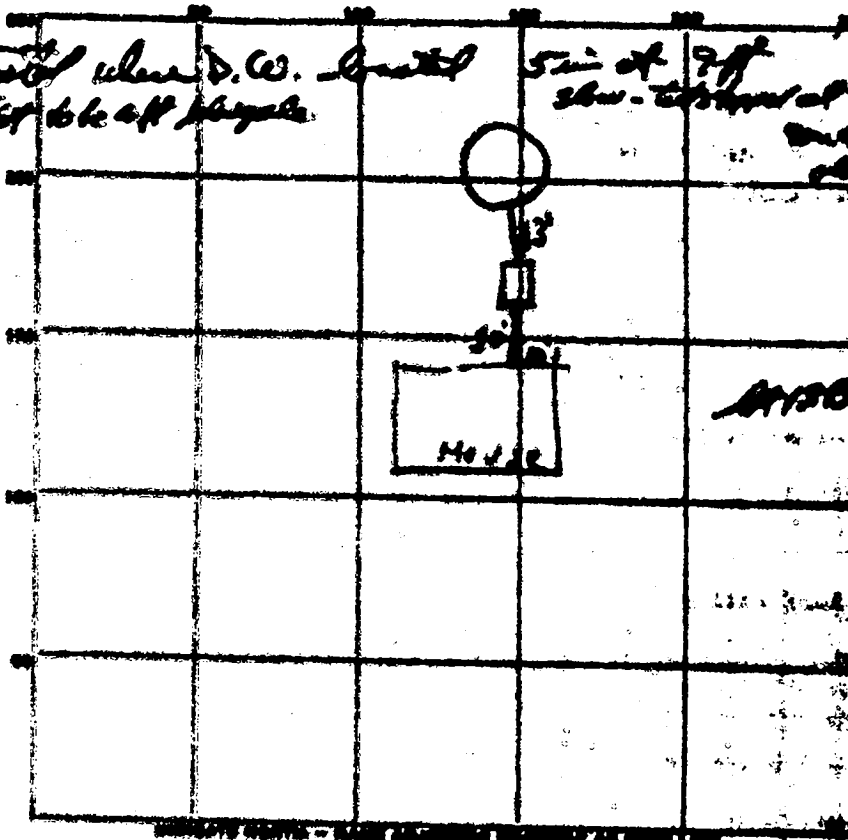

ASD-1

PERMIT CARD OK

SEPTIC TANK LEVEL OK

CLEARANCE OK

DISTRIBUTION MAN. LEVEL _____

THE FIELD, DEPTH _____ FT. TRENCH WIDTH _____ FT.

GRAVEL DEPTH _____ IN. TOTAL LENGTH _____ FT.

NUMBER OF TRENCHES _____ TOTAL BOTTOM AREA _____

SEEPAGE PITS, INSIDE DIAMETER 14 FT. DEPTH BELOW INLET 8 FT.

ABSORBENT AREA 251 SQ. FT.

REMARKS _____

DATE SYSTEM APPROVED

11/9/65

INSPECTOR

H.K. [Signature]

THIS REPORT
MUST BE SUBMITTED
WITHIN 30 DAYS
AFTER COMPLETION
OF THE WELL

WELL COMPLETION REPORT **A-7992**

WELL DESCRIPTION

WELL LOG
State the kind of formations penetrated, their color, their depth, their thickness, and if water-bearing

CASING AND SCREEN RECORD
State the kind and size and position of casing, liner, shoe, screen, and other accessories (if no casing used, give diameter of well).

Permit Number 144-1-1-1
Owner W. H. R. ...
Address ...
Subdivision ...
Section ...

slit
quicksand
sandstone

FEET
0-22
22-46
46-88

Steel 6 1/4

DIAM. (inches)
FEET
0-48

PUMPING TEST
Hours Pumped 2
Type of Pump Used ...
Pumping Rate
Gallons per Minute 10

WATER LEVEL
Distance from land surface to water
Before Pumping 30
While Pumping 42


APPEARANCE OF WATER
Clear ...
Taste ...
Odor ...

Height of Casing Above Ground Surface ...

PUMP INSTALLED
Type ...
Capacity
Gallons per Minute ...
Gallons per Hour ...
Pump Casing Length ...

HO-66-W-210
at 138 S 1

LOCATION OF WELL ON LOT
Show permanent structures such as buildings, septic tank, and/or other landmarks and indicate no less than 2 distances (measurements) to well.

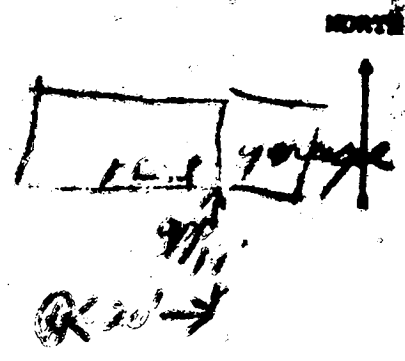

Date Well Was Completed 2/1/66

Well Driller ...
Signature ...

132

TRIPlicate

