

8/12-1pm

8/29/00

8/29/00 10 AM

PERMIT

SEWAGE DISPOSAL SYSTEM

DEPARTMENT OF HEALTH AND MENTAL HYGIENE

P 5/3631

A 58589

DISTRICT _____

DATE 6/13/2000

DATE SYSTEM APPROVED 8/29/00

INSPECTOR TDS

HOWARD COUNTY HEALTH DEPARTMENT

BUREAU OF ENVIRONMENTAL HEALTH

XXXXXXX 410-313-2640

INDEXED

#03331601

SK Backhoe & Septic Service

IS PERMITTED TO INSTALL X ALTER _____

ADDRESS 1220 FSK Highway, Keymar, MD 21757

PHONE 410-775-0562

SUBDIVISION Woodford's Grant III

LOT 6

ROAD 11155 Willow Green Way

PROPERTY OWNER Trinity Builders ROBERT HERMAN

ADDRESS 7320 Grace Drive, Columbia, MD 21044

COMPARTMENTED SEPTIC TANK REQUIRED

SEPTIC TANK CAPACITY 1500 GALLONS

NUMBER OF BEDROOMS 4/5

180 SQUARE FEET PER BEDROOM

LINEAR FEET OF TRENCH REQUIRED 240

PUMPED SEPTIC SYSTEM PROPOSED

INSTALL: - 1-1500 GALLON COMPARTMENTED PUMP CHAMBER REVERSED

NOTES: - Septic pump detail as provided by installer.
- Pump performance test is necessary prior to Health Department approval of pumped septic system.

TRENCHES - Trench to be 3 feet wide. Inlet 3 feet below original grade. Bottom maximum depth 5 feet below original grade. Effective area begins at 3 feet below original grade. 2 feet of stone below distribution pipe.

LOCATION - Place distribution box 10 feet from the right lot line, and 10 feet from the rear lot line. Run trenches along contour toward opposite side of lot.

NOTES - No trench to exceed 100 feet in length. Provide 6" - 8" diameter cleanout and cap to grade or above on septic tank. 3/1/00 O.K. (BB)

BUILDING PERMIT SIGNED

AND RETURNED 8-22-00

BOO138099-ADD BATHROOM

PUBLIC H2O

4-29-00 BOO153398-16 POOL
PLANS APPROVED BY Craig Williams, R.S.

DATE 11-20-1999

COVER NO WORK UNTIL INSPECTED AND APPROVED

NEITHER THE HOWARD COUNTY COUNCIL NOR THE HEALTH DEPARTMENT IS RESPONSIBLE FOR THE SUCCESSFUL OPERATION OF ANY SYSTEM

NOTE: CLEANOUT REQUIRED EVERY 70 FEET OF SEWER LINE AND/OR AT 90° SWEEPS IN LINES FROM HOUSE TO DRAIN FIELDS, 90° ELBOWS NOT ACCEPTABLE.

NOTE: ALL PARTS OF SEPTIC SYSTEMS (I.E. TANK, DISTRIBUTION BOX TRENCHES) TO BE 100 FEET FROM WELL (UNLESS OTHERWISE SPECIFICALLY AUTHORIZED)

NOTE: IF DEEP TRENCH(ES) ARE USED CALL FOR INSPECTION BEFORE AND AFTER PLACING GRAVEL IN TRENCH(ES)

NOTE: NO DRY WELL SHALL EXCEED 15 FOOT IN DIAMETER NO ABSORPTION TRENCH TO EXCEED 100 FEET IN LENGTH

NOTE: ALL PIPE FROM HOUSE TO SEPTIC TANK MUST BE CAST IRON OR SCHEDULE 35/40 PVC OR ABS

PERMIT VOID AFTER TWO YEARS

NOTE: INSTALL STAND PIPE ON SEPTIC TANK AND DRY WELL STAND PIPES MUST BE 6 INCHES IN DIAMETER CAST IRON, CONCRETE OR TERRA COTTA OR PVA OR ABS ACCEPTED. IF TOP OF SEPTIC TANK IS DEEPER THAN 3 FEET, MANHOLE TO GRADE REQUIRED.

NOTE: DISTRIBUTION BOXES MUST HAVE BAFFLES

*INSTALLER IS RESPONSIBLE FOR OBTAINING FINAL APPROVAL ON THIS PERMIT

HD-260(6-90)


*CALL 461-9933 FOR INSPECTION OF SEPTIC SYSTEM.

BUILD PERMIT SIGNED

AND RETURNED 9/20/01

BOO132487. Covered deck 14' x 27' app., attached, wood, open

58589

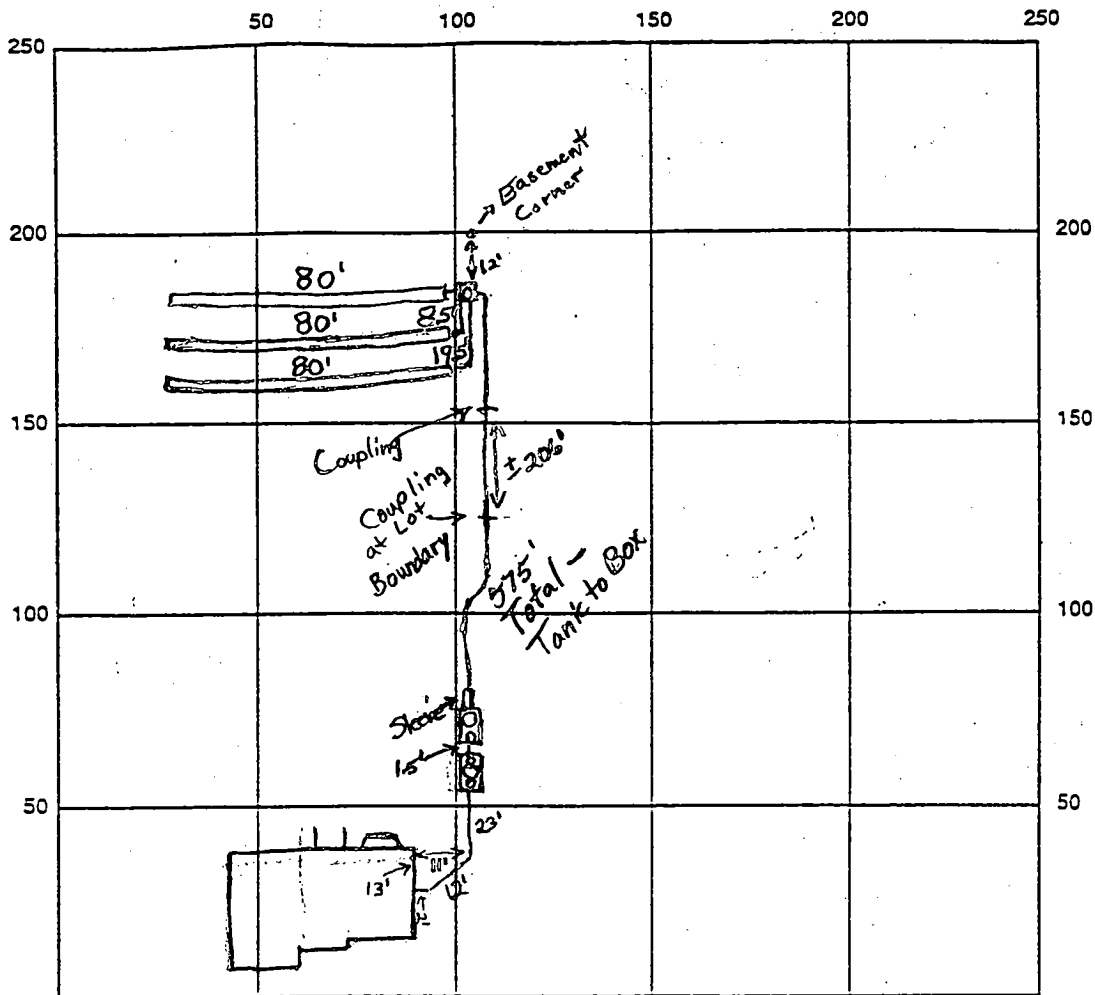

INDICATE NORTH - NAME ADJOINING ROADWAY AS BASE LINE

Willow Green Way

SEPTIC TANK LEVEL 1500 TS, 1500 chamber pump

CLEANOUTS 2 Manhole, 3 6" Inspection Ports

DISTRIBUTION BOX LEVEL OK

DRAIN FIELD/TITLE DEPTH 5.0 FT.

TRENCH WIDTH 3.0 FT.

INLET DEPTH 3.0 FT.

EFFECTIVE GRAVEL DEPTH 2.0 FT.

TOTAL LENGTH 3x80' FT. (240 Total)

NUMBER OF TRENCHES _____

~~ONE SIDEWALK~~ BOTTOM AREA 720 SQ. FT.

DRYWALL INSIDE DIAMETER ✓ FT.

EFFECTIVE DEPTH BELOW INLET ✓ FT.

ABSORBENT AREA ✓ SQ. FT.

REMARKS: 6/14/00 Trenches within staked easement area. House connection made.

O.K. to cover everything. Final approval pending pump and alarm

test (BR)

8/29/00 FINAL INSP - pump performance test OK. DCS

DATE SYSTEM APPROVED

8/29/00

INSPECTOR

DCS

APPLICATION

PERCOLATION TESTING

A 58589

P _____

HOWARD COUNTY HEALTH DEPARTMENT

BUREAU OF ENVIRONMENTAL HEALTH

3525-H ELLICOTT MILLS DRIVE/ELLICOTT CITY, MARYLAND 21043
TELEPHONE: 313-2840

DISTRICT _____

DATE 7/29/97

TO: THE COUNTY HEALTH OFFICER
ELLICOTT CITY, MARYLAND

I HEREBY APPLY FOR THE NECESSARY TEST PRIOR TO APPLICATION FOR PERMIT TO CONSTRUCT (OR RECONSTRUCT) A SEWAGE DISPOSAL SYSTEM.

PROPERTY OWNER L D & D

ADDRESS 10805 Hickory Ridge Rd Suite 215 Col, MD 21047 PHONE 410-740-2600

AGENT OR PROSPECTIVE BUYER LAND DESIGN & DEVELOPMENT

ADDRESS 10805 Hickory Ridge Rd Suite 215 Col, MD 21047 PHONE 410-740-2600

PROPERTY LOCATION:

SUBDIVISION Willow Wood

LOT NO. _____

ROAD AND DESCRIPTION Marriottsville Rd

TAX MAP 10 PARCEL # 293

SIZE OF LOT 1 acre

TYPE BLDG. SFD

(SINGLE FAMILY DWELLING OR COMMERCIAL)

THE SYSTEM INSTALLED UNDER THIS APPLICATION IS ACCEPTABLE ONLY UNTIL PUBLIC FACILITIES BECOME AVAILABLE. I FULLY UNDERSTAND THE FEE CONNECTED WITH THE FILING OF THIS PERC TEST APPLICATION IS NON-REFUNDABLE UNDER ANY CIRCUMSTANCES. I ALSO AGREE TO COMPLY WITH ALL M.O.S.H.A. REQUIREMENTS IN TESTING THIS LOT.

(SIGNATURE OF APPLICANT)

APPROVED BY _____ FOR _____ DATE _____

DISAPPROVED BY _____ FOR _____ DATE _____

HOLD PENDING FURTHER TESTS _____


REASONS FOR REJECTION OR HOLDING _____

PERCOLATION TEST PLAT/PRELIMINARY PLAT - TITLE OR I.D. # _____ DATE _____

SITE DEVELOPMENT PLAN/FINAL PLAT - TITLE OR I.D. # _____ DATE _____

THIS IS NOT A PERMIT

A535P9
COUNTY#

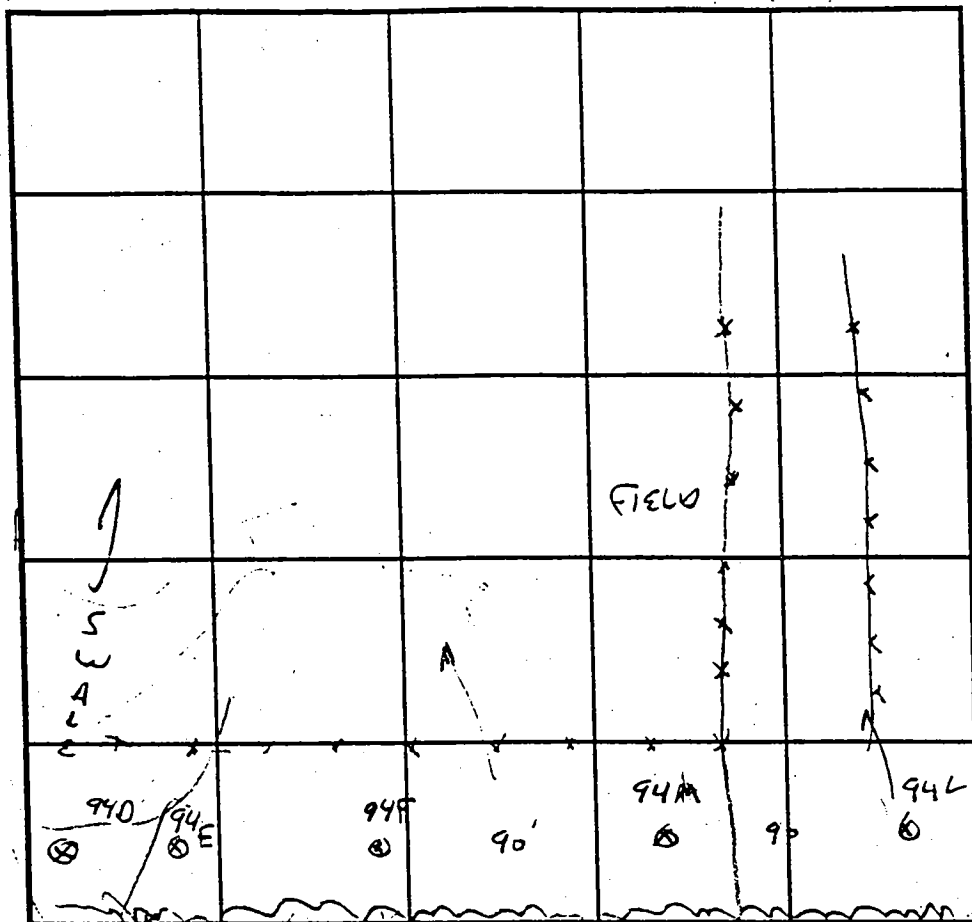

INDICATE NORTH - NAME ADJOINING ROADWAY AS BASE LINE.

SOIL PROFILE
0' 94F
6" TOPSOIL
BROWN
RICH
CLAY LOAM
BROWN
SANDY
MICA
LOAM
15-20%
RATTY
MICA
11'

SOIL PROFILE
0'

94A
BROWN
CLAY LOAM
3 BROWN
SANDY
FINE
MICA
LOAM
7? GREY
BROWN
+ WHITE
SANDY
POWDERY
LOAM
11'

DATE	TEST NO.	DEPTH	PRE-WET		TEST - 1" DROP		TIME
			START	STOP	START	STOP	
8/4/97	94E	3.5' / 11	11:10:30	11:11	11:11	11:12:25	25 SEC
		6	11:13:17	11:13:47		11:14:33	46 SEC
	94M	11V					

REMARKS 2 OF 4

TYPE OF SOIL

TESTED BY G. SAUSAGE ALSO PRESENT MIKE KAUFER, CREW

TRENCH DESIGN DATA: AVERAGE PERCOLATION TIME TRENCH WIDTH

INLET DEPTH MAXIMUM BOTTOM DEPTH SQ. FT./BEDROOM

APPLICATION

PERCOLATION TESTING

A 58589

P _____

HOWARD COUNTY HEALTH DEPARTMENT
BUREAU OF ENVIRONMENTAL HEALTH
3525-H ELLICOTT MILLS DRIVE/ELLICOTT CITY, MARYLAND 21043
TELEPHONE: 313-2640

DISTRICT _____

DATE 7/29/97

TO: THE COUNTY HEALTH OFFICER
ELLICOTT CITY, MARYLAND

I HEREBY APPLY FOR THE NECESSARY TEST PRIOR TO APPLICATION FOR PERMIT TO CONSTRUCT (OR RECONSTRUCT) A SEWAGE DISPOSAL SYSTEM.

PROPERTY OWNER L D & D

ADDRESS 10805 Hickory Ridge Rd Suite 215 Cal, MD 21047 PHONE 410-740-2600

AGENT OR PROSPECTIVE BUYER LAND DESIGN & DEVELOPMENT

ADDRESS 10805 Hickory Ridge Rd Suite 215 Cal, MD 21047 PHONE 410-740-2600

PROPERTY LOCATION:

SUBDIVISION Willow Wood LOT NO. _____

ROAD AND DESCRIPTION Marriottville Rd

TAX MAP 10 PARCEL # 293

SIZE OF LOT 1 acre TYPE BLDG. SFD
(SINGLE FAMILY DWELLING OR COMMERCIAL)

THE SYSTEM INSTALLED UNDER THIS APPLICATION IS ACCEPTABLE ONLY UNTIL PUBLIC FACILITIES BECOME AVAILABLE. I FULLY UNDERSTAND THE FEE CONNECTED WITH THE FILING OF THIS PERC TEST APPLICATION IS NON-REFUNDABLE UNDER ANY CIRCUMSTANCES. I ALSO AGREE TO COMPLY WITH ALL M.O.S.H.A. REQUIREMENTS IN TESTING THIS LOT.

(SIGNATURE OF APPLICANT)

APPROVED BY _____ FOR _____ DATE _____

DISAPPROVED BY _____ FOR _____ DATE _____


HOLD PENDING FURTHER TESTS _____

REASONS FOR REJECTION OR HOLDING _____


PERCOLATION TEST PLAT/PRELIMINARY PLAT - TITLE OR I.D. # _____ DATE _____

SITE DEVELOPMENT PLAN/FINAL PLAT - TITLE OR I.D. # _____ DATE _____

THIS IS NOT A PERMIT

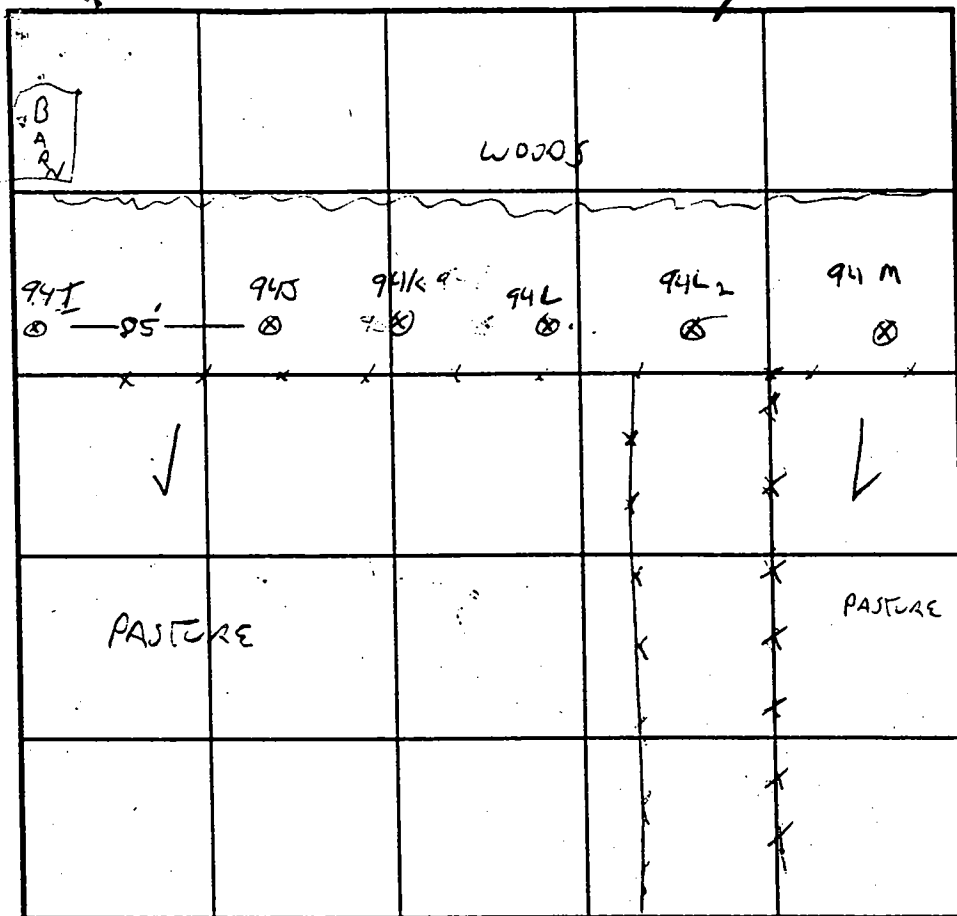

INDICATE NORTH - NAME ADJOINING ROADWAY AS BASE LINE.

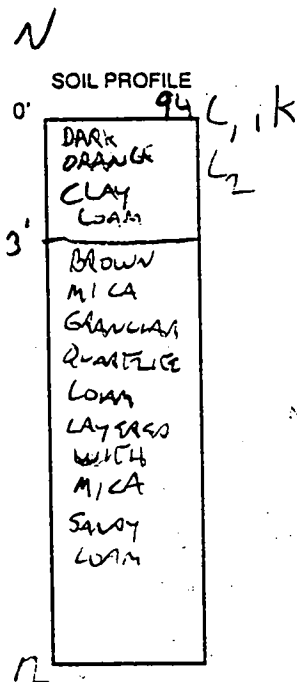

A58589
COUNTY #

SOIL PROFILE

0' BROWN MICACEOUS CLAY LOAM

2-3' BROWN COARSE MICA SANDY LOAM
5' 9' Rock

6' LARGO

94I

1-2'
VEIN OF QUARTZITE
DIAGONALLY THROUGH
TEST HOLE
4'-?

DATE	TEST NO.	DEPTH	PRE-WET		TEST - 1' DROP		TIME
			START	STOP	START	STOP	
9/4/87	94K	4.5/12	12:13:35	12:16:30	12:21	12:24	5 MIN
		6.5	12:17:55	12:17:55	12:18:30	12:19:45	75 SEC
	94M	11V					
	94L2	5/11V	12:31:48	12:32:05	12:32:05	12:32:34	29 SEC
		7	12:33:30	12:34:21	12:34:21	12:35:29	68 SEC
	94J	6'	NOT TESTED		-ROCK		6'


REMARKS 4 OF 4

TYPE OF SOIL EXTREMELY COARSE TEXTURED MICA

TESTED BY G. SAVAGE ALSO PRESENT MILLS KATNER, CREW

TRENCH DESIGN DATA: AVERAGE PERCOLATION TIME TRENCH WIDTH



INLET DEPTH MAXIMUM BOTTOM DEPTH SQ. FT./BEDROOM

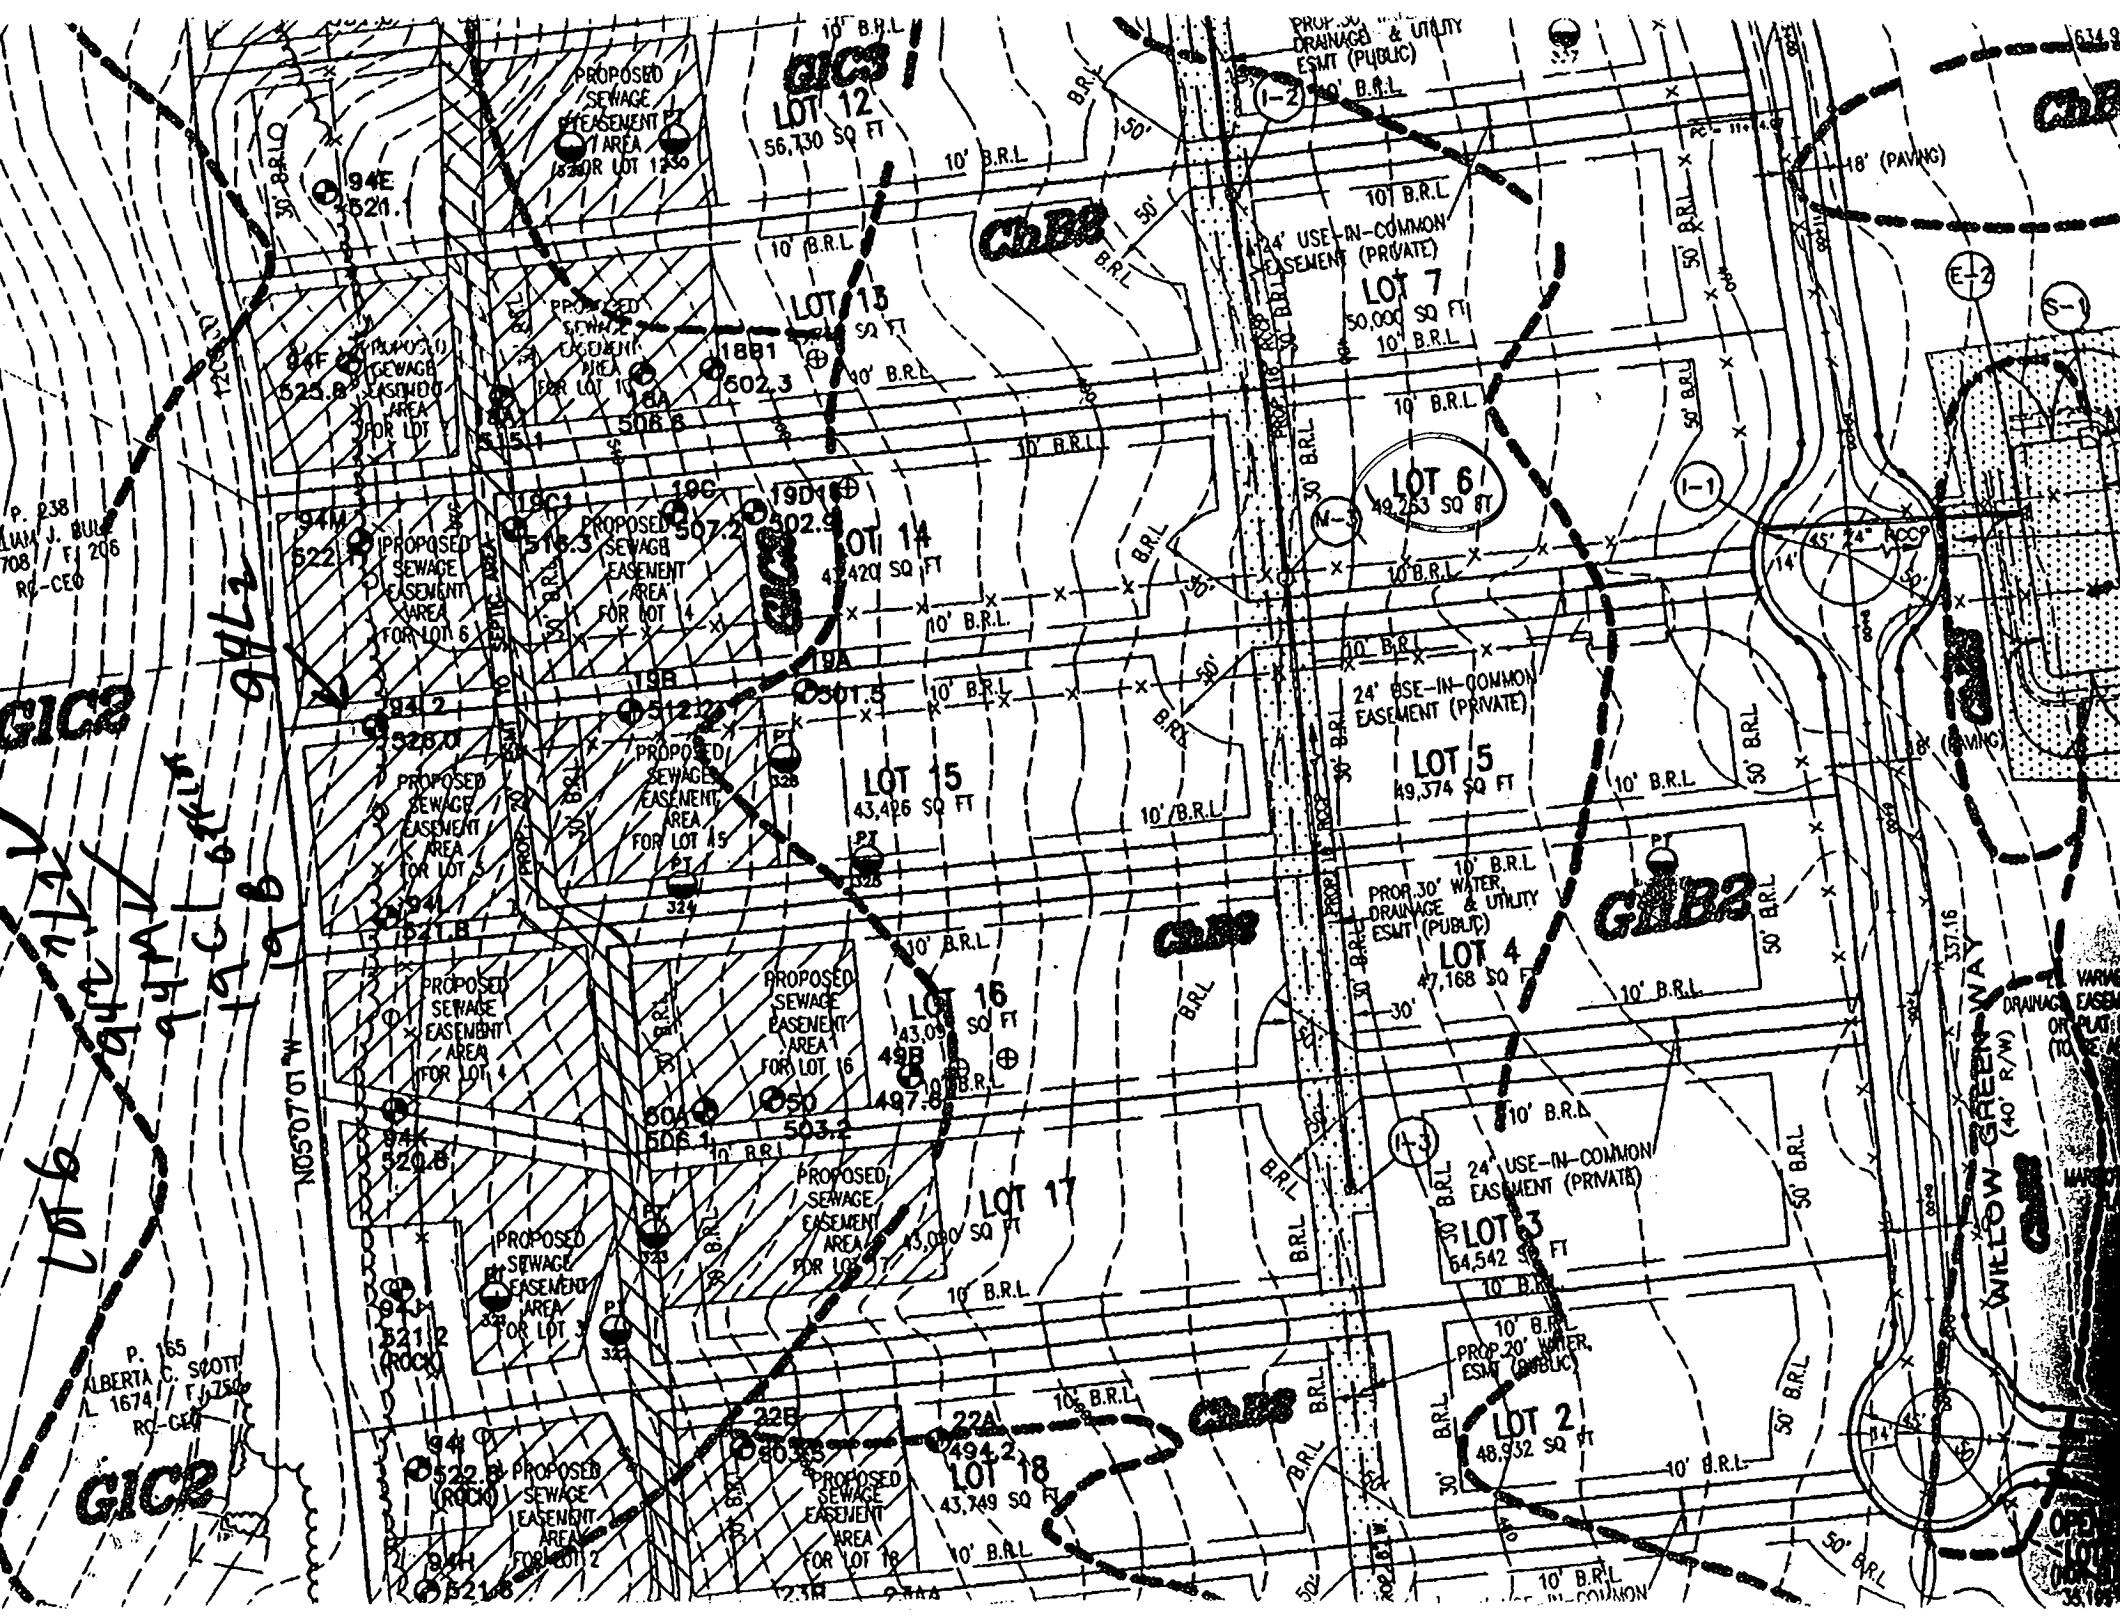

6/13/00
Wall Check O.K.
BB

WILLOW GREEN WAY

MD. STATE GRID MERIDIAN

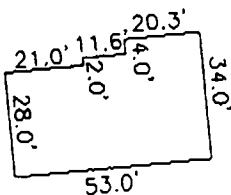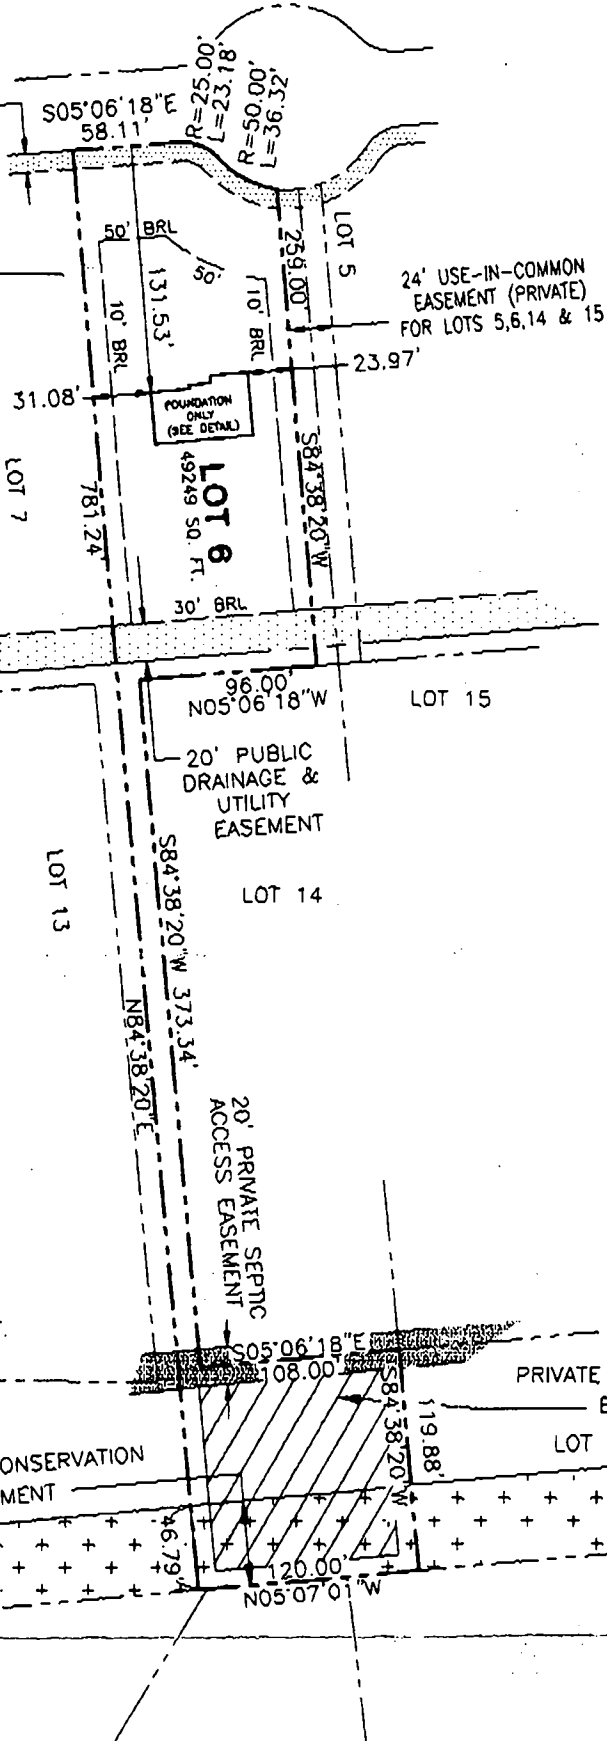PUBLIC 10' TREE
MAINTENANCE
EASEMENTFOUNDATION DETAIL
SCALE 1" = 50'

TOP OF WALL ELEVATION = 480.11 FT.



RECORD REFERENCES

LIBER/FOLIO _____

PLAT BOOK _____

PLAT NO./FOLIO 13801

SCALE 1"=100'

DATE 4/25/2000

WALL CHECK
OF

LOT 6

WOODFORDS GRANT III

HOWARD COUNTY

MARYLAND

VOGEL & ASSOCIATES, INC.

3691 PARK AVE. #101 ELLICOTT CITY, MD 21043

TELEPHONE (410)461-5828 FAX (410)465-3966

I HEREBY CERTIFY THAT THE IMPROVEMENTS ARE LOCATED AS
SHOWN HEREON AND TO THE BEST OF MY KNOWLEDGE AND
BELIEF, THERE ARE NO ENCROACHMENTS EXCEPT AS SHOWN.

Mark C. Martin 4/27/2000
MARK C. MARTIN PROFESSIONAL LAND SURVEYOR NO. 10884

DEPARTMENT OF INSPECTIONS, LICENSES AND PERMITS
3430 COURT HOUSE DRIVE
ELLICOTT CITY, MD 21043
PERMITS (410) 313-2466 INSPECTIONS (410) 313-1810
AUTOMATED INFORMATION (410) 313-3800

HOWARD COUNTY
PERMIT APPLICATION

PERMIT NUMBER
B00122448

Building Address 11155 WILLOW CREEK WAY
MARIOTTSVILLE 21104

Property Owner's Name TRINITY BUILDERS

Suite/Apt. # SDP/WP/Petition #: GP-99-209

Address 7320 GRACE DR

Census Tract 6030 Subdivision WOODFORDS GRANT III

City COLUMBIA State MD Zip Code 21044

Home Phone Work Phone 410-313-8722

Section Area Lot 6

Applicant's Name & Mailing Address, (if other than stated hereon):

Tax Map 10 Parcel 293 Grid 22

Phone Fax 410-313-8731

Zoning RCRLO Map Coordinates 5R12 Lot size 49,249 sq ft

Existing Use VACANT LOT

Contractor Company SAME

Proposed Use S.F.P.

Contact Person

Estimated Construction Cost \$ 100,000

Address

Description of Work CUSION AMESBURY W/
CHANGES - 2 STORY, FULL BSMT,
9R, 2 FB, 1 HB, FP & 60RAGE (4BR)

City State Zip Code

License No. Phone Fax

Occupant or Tenant N/A

Engineer or Architect Company SAME

Contact Name

Contact Person

Address

City State Zip Code

Phone Fax

BUILDING DESCRIPTION - COMMERCIAL

Building Characteristics

Height:

No. of stories:

Gross area, sq. ft. per floor:

Use group:

Construction type:

Reinforced Concrete

Structural Steel

Masonry

Wood Frame

State Certified Modular

Utilities

Water Supply:

Public

Private

Sewage Disposal:

Public

Private

Electric Yes No

Gas Yes No

Heating System:

Electric Oil

Natural Gas

Propane Gas

Sprinkler system: N/A

Full

Partial

Other Suppression

of Heads

BUILDING DESCRIPTION - RESIDENTIAL

Building Characteristics

SF Dwelling SF Townhouse

Depth Width

1st floor:

2nd floor:

Basement:

Finished Basement Unfinished Basement

Crawl space Slab on Grade

No. of Bedrooms 4

Multi-family dwellings:

No. of efficiency units:

No. of 1 BR units:

No. of 2 BR units:

No. of 3 BR units:

Other Structure:

Dimensions:

Footings:

Roof:

State Certified Modular

Manufactured Home

Utilities

Water Supply:

Public

Private

Sewage Disposal:

Public

Private

Electric Yes No

Gas Yes No

Heating System:

Electric Oil

Natural Gas

Propane Gas

Sprinkler system: N/A

NFPA #13D

NFPA #13R

Other:

THE UNDERSIGNED HEREBY CERTIFIES AND AGREES AS FOLLOWS: (1) THAT HE/SHE IS AUTHORIZED TO MAKE THIS APPLICATION; (2) THAT THE INFORMATION IS CORRECT; (3) THAT HE/SHE WILL COMPLY WITH ALL REGULATIONS OF HOWARD COUNTY WHICH ARE APPLICABLE THERE TO; (4) THAT HE/SHE WILL PERFORM NO WORK ON THE ABOVE REFERENCED PROPERTY NOT SPECIFICALLY DESCRIBED IN THIS APPLICATION; (5) THAT HE/SHE GRANTS COUNTY OFFICIALS THE RIGHT TO ENTER ONTO THIS PROPERTY FOR THE PURPOSE OF INSPECTING THE WORK PERMITTED AND POSTING NOTICES.

Sally L. Hodge

Applicant's Signature

V.P. Operations Trinity

Title/Company

SALLY HODGE

Print Name

2/16/00

Date

Checks payable to: DIRECTOR OF FINANCE OF HOWARD COUNTY
** PLEASE WRITE NEATLY AND LEGIBLY. **
FOR OFFICE USE ONLY.

AGENCY

Land Development, E/Z

State Highways

Building Official

Dev. Engineering, D/E

Health

Fire Protection

Is Sediment Control approval required prior to issuance?

YES NO

SIGNATURE APPROVAL

Mark E. Rifkin

DPZ SETBACK INFORMATION

Front:

Rear:

Side:

Side St.:

All minimum setbacks met?

YES NO

Is Entrance Permit required?

YES NO

Historic District?

YES NO

Lot Coverage for New Town Zone

SDP/Red-line approval date

Accepted by

PROPERTY ID# 45020

Filing fee \$ 25

Permit fee \$

Excise tax \$

Sub-total paid \$

Add'l permit fee \$

TOTAL FEES \$

Balance due \$

Check # 7102

Validation # 27805

CONTINGENCY CONSTRUCTION START

ONE STOP SHOP

Distribution of Copies

White: Building Official

Green: LDD, DPZ

Yellow: DED, DPZ

Pink: Health

Gold: SHA

Rev. 10/15/98

Distribution Box
Ex. Ground: 531.5
Inv.: 528.5

NORTH : 1"=50'

24' Use-in-Common Easement
for lots 5,6,14, & 15

LOT 14

LOT 6
49249 SF

LOT 7
480

20' PUBLIC DRAINAGE &
UTILITY EASEMENT

PROPOSED
SEWAGE
EASEMENT
AREA

20' Private Septic
Access Easement

Pump Tank
Ground: 478.5
Inv.: 474.22

1250 Gal. Septic Tank
Ground: 477.5
Inv. In: 474.62
Inv. Out: 474.32

* Basement does not
sewer by gravity.

DECK OK
AS SHOWN
MPC 9/20/01

WILLOW GREEN WAY
(Public Road)

10' Public Tree
Maintenance Easement

W VOGEL &

DEPARTMENT OF INSPECTIONS, LICENSES AND PERMITS 3430 COURT HOUSE DRIVE ELLICOTT CITY, MD 21043 PERMITS (410) 313-2455 INSPECTIONS (410) 313-1810 AUTOMATED INFORMATION (410) 313-3800	HOWARD COUNTY PERMIT APPLICATION	PERMIT NUMBER B001321874
---	-------------------------------------	-----------------------------

Building Address <u>1155 Willow Green Way</u> <u>MARZIOVILLE, MD 21104</u>	Property Owner's Name <u>ROBERT HERMAN</u>
Suite/Apt. #: _____ SDP/WP/Petition #: _____	Address <u>1155 Willow Green Way</u>
Census Tract <u>6037</u> Subdivision <u>Woodlands Forest</u>	City <u>MARZIOVILLE</u> State <u>MD</u> Zip Code <u>21101</u>
Section <u>5</u> Area _____ Lot <u>6</u>	Home Phone <u>410-442-3283</u> Work Phone <u>410-765-2092</u>
Tax Map <u>10</u> Parcel <u>293</u> Grid <u>22</u>	Applicant's Name & Mailing Address, (if other than stated hereon):
Zoning <u>R1D</u> Map Coordinates <u>5812</u> Lot size _____	Phone <u>See Above</u> Fax <u>410-765-7414</u>
Existing Use <u>N/A SINGLE FAMILY DWELLING</u>	Contractor Company <u>See</u>
Proposed Use <u>RECREATIONAL PORCH</u>	Contact Person _____
Estimated Construction Cost \$ <u>5,000</u>	Address _____
Description of Work <u>COVERED DECK 14' x 27' app.</u> <u>ATTACHED, WOOD, OPEN</u>	City _____ State _____ Zip Code _____
Occupant or Tenant <u>Same</u>	License No. _____ Phone _____ Fax _____
Contact Name _____	Engineer or Architect Company _____
Address _____	Contact Person _____
City _____ State _____ Zip Code _____	Address _____
Phone _____ Fax _____	City _____ State _____ Zip Code _____
	Phone _____ Fax _____

BUILDING DESCRIPTION - COMMERCIAL		BUILDING DESCRIPTION - RESIDENTIAL	
Building Characteristics	Utilities	Building Characteristics	Utilities
Height: _____	Water Supply: _____	SF Dwelling ☐ SF Townhouse ☐	Water Supply: _____
No. of stories: _____	Public ☐ Private ☐	Depth _____ Width _____	Public ☒ Private ☐
Gross area, sq. ft. per floor: _____	Sewage Disposal: _____	1st floor: _____	Sewage Disposal: _____
Use group: _____	Public ☐ Private ☐	2nd floor: _____	Public ☐ Private ☒
Construction type: _____	Electric Yes ☐ No ☐	Basement: _____	Electric Yes ☒ No ☐
Reinforced Concrete _____	Gas Yes ☐ No ☐	Finished Basement ☐ Unfinished Basement ☐	Gas Yes ☒ No ☐
Structural Steel _____	Heating System: _____	Crawl space ☐ Slab on Grade ☐	Heating System: _____
Masonry _____	Electric ☐ Oil ☐	No. of Bedrooms <u>378</u>	Electric ☐ Oil ☐
Wood Frame _____	Natural Gas ☐	No. of efficiency units: _____	Natural Gas ☐
State Certified Modular _____	Propane Gas ☐	No. of 1 BR units: _____	Propane Gas ☒
	Sprinkler system: N/A ☐	No. of 2 BR units: _____	Sprinkler system: N/A ☒
	Full _____	No. of 3 BR units: _____	NFPA #13D _____
	Partial _____	Other Structure: _____	NFPA #13R _____
	Other Suppression _____	Dimensions: _____	Other: _____
	# of Heads _____	Footings: _____	
		Roof: _____	
		State Certified Modular _____	
		Manufactured Home _____	

I, THE UNDERSIGNED, HEREBY CERTIFY AND ADOPT AS TRUE THE FOLLOWING: (1) THAT I/WE ARE AUTHORIZED TO MAKE THIS APPLICATION; (2) THAT THE INFORMATION IS CORRECT; (3) THAT I/WE WILL COMPLY WITH ALL REGULATIONS OF HOWARD COUNTY WHICH ARE APPLICABLE THERE TO; (4) THAT I/WE WILL PERFORM NO WORK ON THE ABOVE REFERENCED PROPERTY NOT SPECIFICALLY DESCRIBED IN THIS APPLICATION; (5) THAT I/WE GRANTS COUNTY OFFICIALS THE RIGHT TO ENTER ONTO THIS PROPERTY FOR THE PURPOSE OF INSPECTING THE WORK PERMITTED AND POSTING NOTICES.

Applicant's Signature _____ ROBERT HERMAN
Title/Company _____ Print Name
Date 19 SEPTEMBER 2001

Checks payable to: DIRECTOR OF FINANCE OF HOWARD COUNTY
** PLEASE WRITE NEATLY AND LEGIBLY **

FOR OFFICE USE ONLY			
AGENCY	DATE	SIGNATURE APPROVAL	PROPERTY ID#
Land Development DPZ	9/17/01	[Signature]	1155020
State Highways			
Building Official	9/17/01	[Signature]	
Dev. Engineering DPZ			
Health	9/20/01	[Signature]	
Fire Protection			
Is Sediment Control approval required prior to issuance?	YES ☐ NO ☐	Is Entrance Permit required?	YES ☐ NO ☐
CONTINGENCY CONSTRUCTION START	☐	Historic District	YES ☐ NO ☐
ONE STOP SHOP	☐	Lot Coverage for New Town Zone	YES ☐ NO ☐
Distribution of Copies	White: Building Official	SDP/Reg. line approval	Accepted by [Signature]
	Green: LDD/DPZ		
	Yellow: DED/DPZ		
	Pink: Health		
	Gold: SHA		

