

12/13/73
a.m. if possible

PERMIT

SEWAGE DISPOSAL SYSTEM

MARYLAND STATE DEPARTMENT OF HEALTH

HOWARD COUNTY

Not found

INDEXED

12/13/73
File
H. Z.

P 19032
58905-A
A 15074

ELLICOTT CITY

DISTRICT 3rd

DATE 10/3/73

Roland Barth

IS PERMITTED TO INSTALL ☒ ALTER

ADDRESS Clarksville Pike, Ellicott City, Md. 21043 PHONE 730-8495

A SEWAGE DISPOSAL SYSTEM LOCATED AT

SUBDIVISION 15074 ROAD Triadelphia Road LOT

PROPERTY OWNER F. Omer

ADDRESS

SPECIFICATIONS 3 bedrooms

DRAIN FIELD DEPTH FEET, BOTTOM AREA SQ. FT.

SEEPAGE PITS ABSORBENT SIDE-WALL AREA SQ. FT.

SEPTIC TANK CAPACITY 1000 GALLONS

FOR GARBAGE GRINDER, INCREASE DISPOSAL AREA 22% & TANK CAPACITY 50%.

OTHER DRY WELL - 300 sq. ft. sidewall area below inlet with inlet to be no deeper than 5 1/2 ft. deep and bottom of dry well no deeper than 12 ft. Place the dry well 80 ft. from the front lot line and 165 ft. from the left side of the lot as seen when facing the lot from Triadelphia Road. Fill in the old water well with cement. Triadelphia Road near Carroll Mill Road next to stream.

NOTE: ALL PIPE FROM HOUSE TO DRY WELL MUST BE CAST IRON.

PERMIT VOID AFTER THREE YEARS.


NOTE: INSTALL STAND PIPE ON SEPTIC TANK AND DRY WELL.

PLANS APPROVED BY Raymond Hodges DATE 3/29/73

FILL SEPTIC TANK AND DISTRIBUTION BOX WITH WATER BEFORE CALLING FOR AN INSPECTION. COVER NO WORK UNTIL INSPECTED AND APPROVED.

NEITHER THE HOWARD COUNTY COMMISSIONERS NOR THE HEALTH DEPARTMENT IS RESPONSIBLE FOR THE SUCCESSFUL OPERATION OF ANY SYSTEM.

15074
58905-A

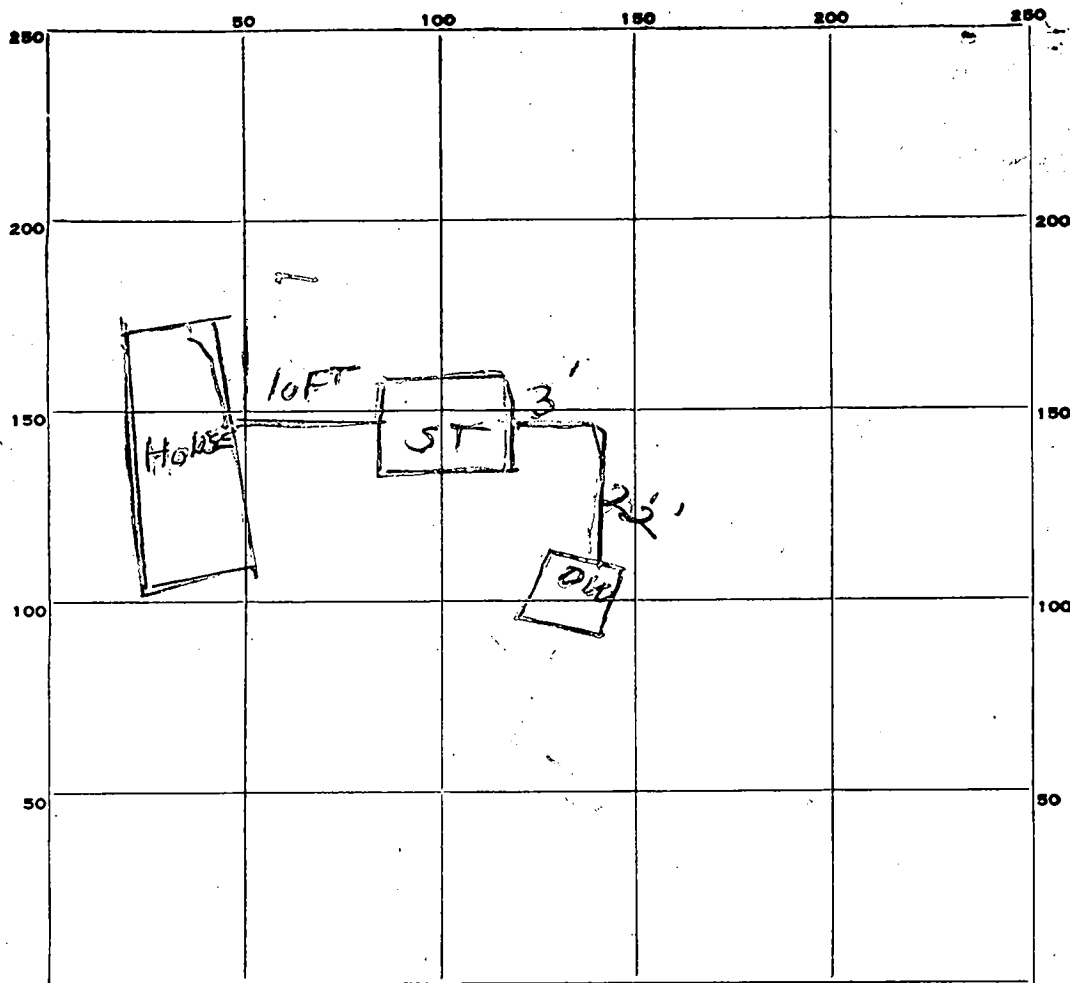

INDICATE NORTH. - NAME ADJOINING ROADWAY AS BASE LINE.

PERMIT CARD OK

SEPTIC TANK, LEVEL ?

CLEANOUTS OK

DISTRIBUTION BOX, LEVEL None

TILE FIELD, DEPTH None FT. TRENCH WIDTH None FT.

GRAVEL DEPTH IN. TOTAL LENGTH FT.

NUMBER OF TRENCHES TOTAL BOTTOM AREA

SEEPAGE PITS, INSIDE DIAMETER Perimeter FT. DEPTH BELOW INLET 6\' FT.

ABSORBENT AREA 377 SQ. FT.

REMARKS

DATE SYSTEM APPROVED 12-13-73

INSPECTOR Harry J. Glen

APPLICATION

SEWAGE DISPOSAL TESTING

MARYLAND STATE DEPARTMENT OF HEALTH

ELLICOTT CITY

HOWARD COUNTY 1000 Gal Tank

DISTRICT 3

DATE 2/2/70

Dry Well - 300 soft sidewalk
area below inlet with inlet to
TIN 5 1/2 F deep on bottom of
NO DEEPER

Dry well no deeper than 12 F
Place the Dry Well 80 FT from the Front
lot line and 165 FT from the
left side of the lot

TO: THE COUNTY HEALTH OFFICER
ELLICOTT CITY, MARYLAND

I, HEREBY, APPLY FOR THE NECESSARY TESTS IN ORDER TO CONSTRUCT (OR RECONSTRUCT) A SEWAGE DISPOSAL SYSTEM.

PROPERTY OWNER

ADDRESS

PHONE 730-5627

PROPERTY LOCATION:

SUBDIVISION

LOT NO.

ROAD AND DESCRIPTION

OCCUPANT

PHONE

PERSON TO CONSTRUCT SYSTEM

ADDRESS

PHONE

SIZE OF LOT

TYPE BLDG.

NUMBER OF BEDROOMS

IF NOT SINGLE RESIDENCE DESCRIBE

SIGNATURE OF APPLICANT

APPROVED BY

FOR

DATE

REJECTED BY

FOR

DATE


HOLD PENDING FURTHER TESTS

DATE

REASONS FOR REJECTION OR HOLDING

Per OK for, house on 9 1/2 ac

THIS IS NOT A PERMIT

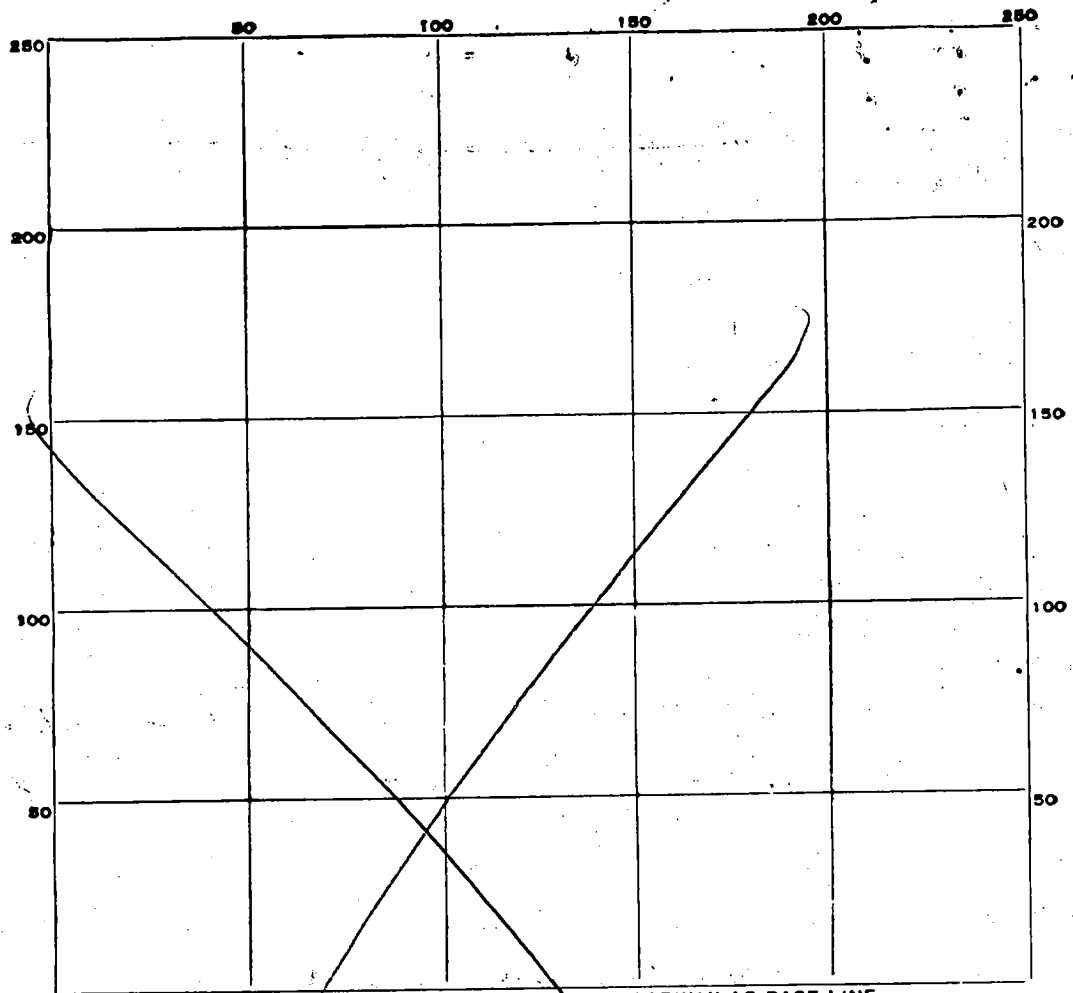

INDICATE NORTH. - NAME ADJOINING ROADWAY AS BASE LINE.

DATE	TEST NO.	DEPTH	PRE-WET		TEST - 1" DROP		TIME
			START	STOP	START	STOP	
2/6/70	9	15 ft.	Water - maple spring				
		10 ft.	Water table				
	6	5 ft.	Water & clay				
	7	5 1/2 ft.	Water & clay				
	8	5 ft.	Water & clay				
	10	" "	" "				

SOIL AUGER FINDING _____

TESTED BY _____

REMARKS _____

Fill out in triplicate.

Make \$15.00, check payable to

Howard County Health Dept. & Sanitation

APPLICATION

SEWAGE DISPOSAL TESTING

MARYLAND STATE DEPARTMENT OF HEALTH

HOWARD COUNTY

ELLICOTT CITY

DISTRICT 3

DATE 2/2/70

TO: THE COUNTY HEALTH OFFICER
ELLICOTT CITY, MARYLAND

I, HEREBY, APPLY FOR THE NECESSARY TESTS IN ORDER TO CONSTRUCT (OR RECONSTRUCT) A SEWAGE DISPOSAL SYSTEM.

PROPERTY OWNER

Edward Hammond Lasfort *Julia R. Lasfort*

ADDRESS 11700 Hammond Road

PHONE 730-5627

PROPERTY LOCATION:

SUBDIVISION

LOT NO.

ROAD AND DESCRIPTION

Tridelpia Road

OCCUPANT

PHONE

PERSON TO CONSTRUCT SYSTEM

P 251016

ADDRESS

PHONE

SIZE OF LOT

9 1/2 acres ±

TYPE BLDG.

none

NUMBER OF BEDROOMS

IF NOT SINGLE RESIDENCE DESCRIBE

SIGNATURE OF APPLICANT

Edward Hammond Lasfort *Julia R. Lasfort*

APPROVED BY

FOR

(KIND OF SYSTEM)

DATE

REJECTED BY

FOR

(KIND OF SYSTEM)

DATE

HOLD PENDING FURTHER TESTS

DATE

REASONS FOR REJECTION OR HOLDING

THIS IS NOT A PERMIT

APPLICATION

SEWAGE DISPOSAL TESTING

MARYLAND STATE DEPARTMENT OF HEALTH

HOWARD COUNTY

ELLICOTT CITY

DISTRICT 3

DATE 2/2/70

TO: THE COUNTY HEALTH OFFICER
ELLICOTT CITY, MARYLAND

I, HEREBY, APPLY FOR THE NECESSARY TESTS IN ORDER TO CONSTRUCT (OR RECONSTRUCT) A SEWAGE DISPOSAL SYSTEM.

PROPERTY OWNER

ADDRESS

PHONE 730 - 5627

PROPERTY LOCATION:

SUBDIVISION

LOT NO.

ROAD AND DESCRIPTION

OCCUPANT

PHONE

PERSON TO CONSTRUCT SYSTEM

ADDRESS

PHONE

SIZE OF LOT

TYPE BLDG

NUMBER OF BEDROOMS

IF NOT SINGLE RESIDENCE DESCRIBE

SIGNATURE OF APPLICANT

APPROVED BY

FOR

(KIND OF SYSTEM)

DATE

REJECTED BY

FOR

(KIND OF SYSTEM)

DATE

HOLD PENDING FURTHER TESTS

DATE

REASONS FOR REJECTION OR HOLDING

THIS IS NOT A PERMIT

APPLICATION

SEWAGE DISPOSAL TESTING

MARYLAND STATE DEPARTMENT OF HEALTH

HOWARD COUNTY

ELLICOTT CITY

DISTRICT 3

DATE 2/2/70

See A 15074

TO: THE COUNTY HEALTH OFFICER
ELLICOTT CITY, MARYLAND

I, HEREBY, APPLY FOR THE NECESSARY TESTS IN ORDER TO CONSTRUCT (OR RECONSTRUCT) A SEWAGE DISPOSAL SYSTEM.

PROPERTY OWNER

ADDRESS

PHONE 730-5627

PROPERTY LOCATION:

SUBDIVISION

LOT NO.

ROAD AND DESCRIPTION

OCCUPANT

PHONE

PERSON TO CONSTRUCT SYSTEM

ADDRESS

PHONE

SIZE OF LOT

TYPE BLDG.

NUMBER OF BEDROOMS

IF NOT SINGLE RESIDENCE DESCRIBE

SIGNATURE OF APPLICANT

APPROVED BY

FOR

(KIND OF SYSTEM)

DATE

REJECTED BY

FOR

(KIND OF SYSTEM)


DATE

HOLD PENDING FURTHER TESTS

DATE

REASONS FOR REJECTION OR HOLDING

THIS IS NOT A PERMIT

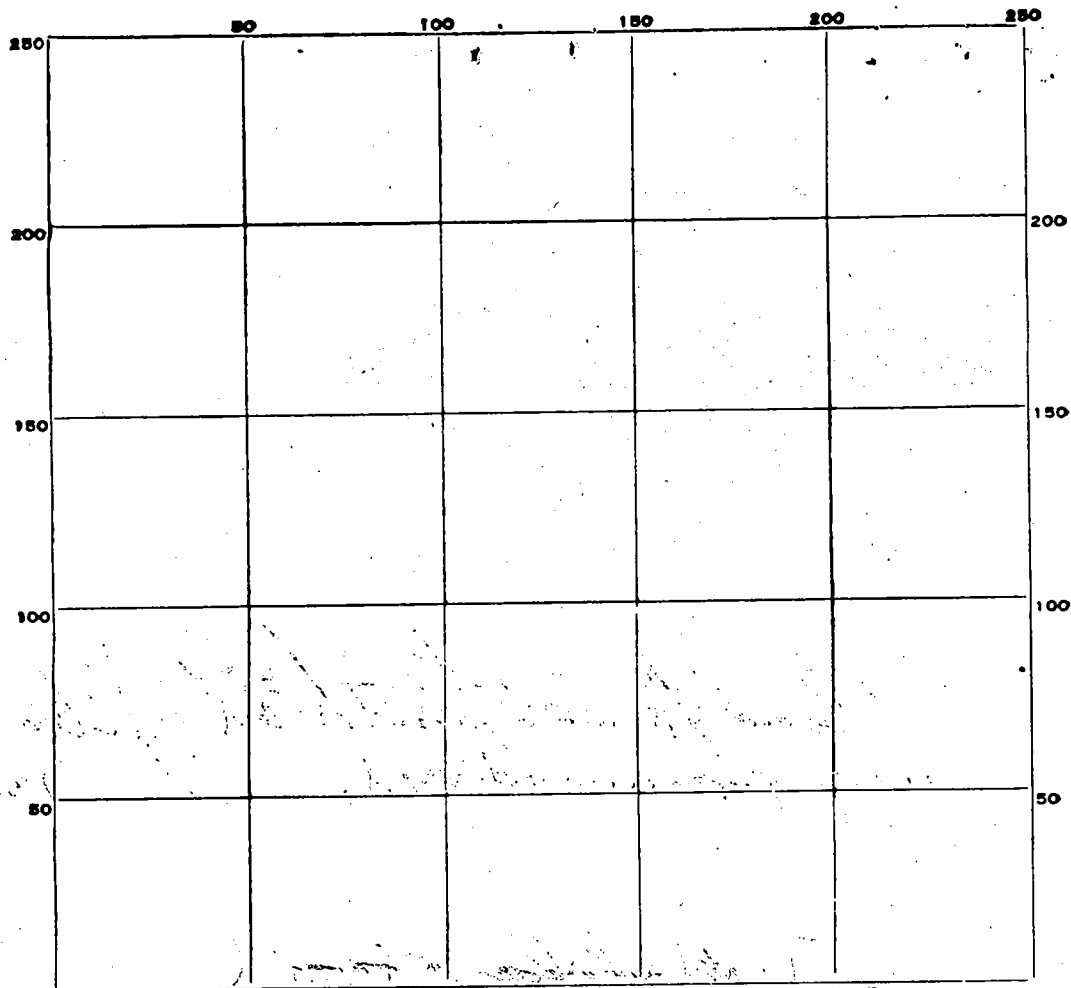

INDICATE NORTH. - NAME ADJOINING ROADWAY AS BASE LINE.

DATE	TEST NO.	DEPTH	PRE-WET		TEST - 1" DROP		TIME
			START	STOP	START	STOP	
3/4/70	1	7 1/2 ft.	9 ⁵⁹	10 ⁰⁰	10 ⁰⁰	10 ⁰²	2 min
	2	12 1/2 ft.	10 ⁰⁰	10 ⁰¹	10 ⁰¹	10 ⁰²	1 min
	3	10 1/2 ft.	10 ⁰⁸	10 ⁰⁹	10 ⁰⁹	10 ¹¹	2 min
2	4	6 1/2 ft.	10 ⁰⁸	No Perc.			
	3A	12 1/2 ft.	Good soil				
	Note No. 3 - Good soil from 7 1/2 to 12 1/2						

SOIL AUGER FINDING

TESTED BY R. Toner

REMARKS

APPLICATION

SEWAGE DISPOSAL TESTING

MARYLAND STATE DEPARTMENT OF HEALTH

HOWARD COUNTY

ELLICOTT CITY

DISTRICT 3

DATE 2/2/70

See A15074

TO: THE COUNTY HEALTH OFFICER
ELLICOTT CITY, MARYLAND

I, HEREBY, APPLY FOR THE NECESSARY TESTS IN ORDER TO CONSTRUCT (OR RECONSTRUCT) A SEWAGE DISPOSAL SYSTEM.

PROPERTY OWNER

ADDRESS

PHONE

PROPERTY LOCATION:

SUBDIVISION

LOT NO.

ROAD AND DESCRIPTION

OCCUPANT

PHONE

PERSON TO CONSTRUCT SYSTEM

ADDRESS

PHONE

SIZE OF LOT

TYPE BLDG.

NUMBER OF BEDROOMS

IF NOT SINGLE RESIDENCE DESCRIBE

SIGNATURE OF APPLICANT

APPROVED BY

FOR

(KIND OF SYSTEM)

DATE

REJECTED BY

FOR

(KIND OF SYSTEM)


DATE

HOLD PENDING FURTHER TESTS

DATE

REASONS FOR REJECTION OR HOLDING

THIS IS NOT A PERMIT

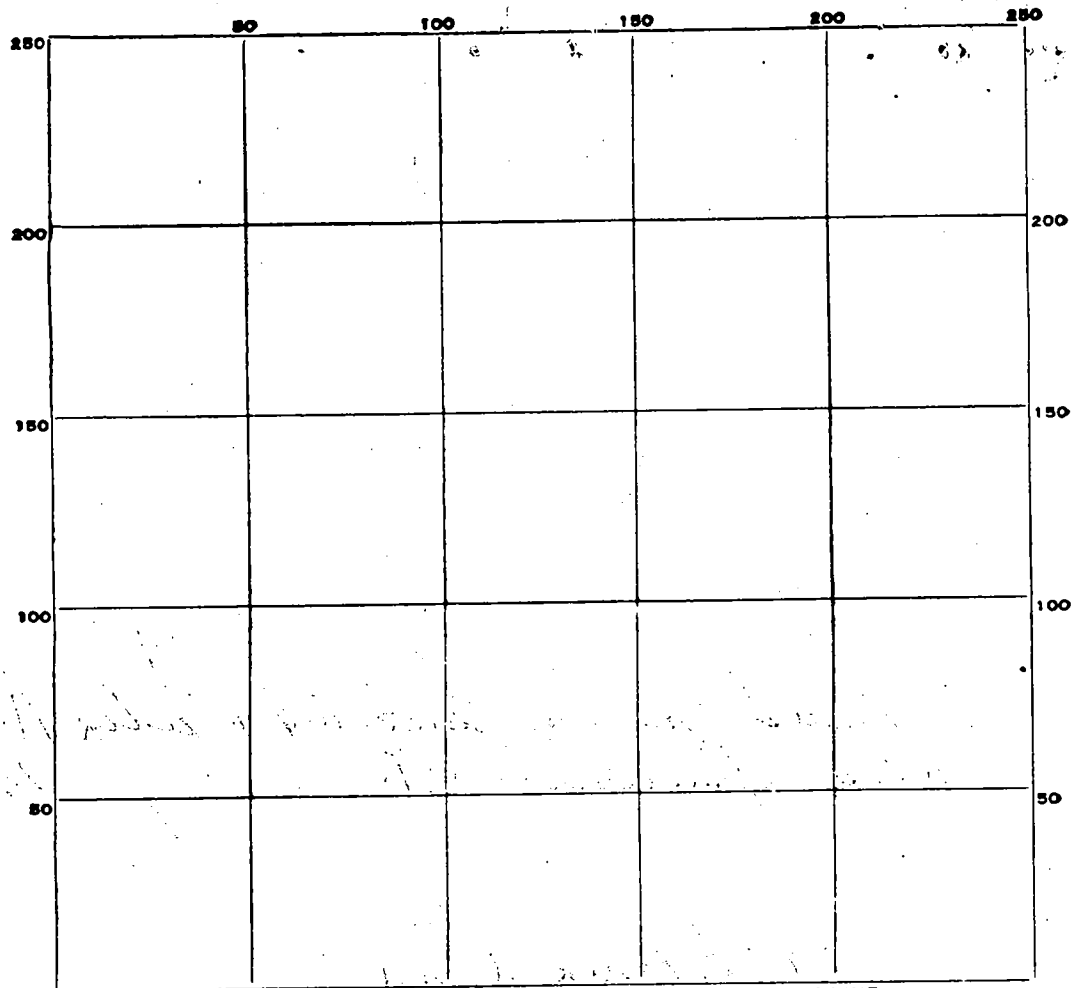

INDICATE NORTH. - NAME ADJOINING ROADWAY AS BASE LINE.

DATE	TEST NO.	DEPTH	PRE-WET		TEST - 1" DROP		TIME
			START	STOP	START	STOP	
2/6/70	3 (1)	5 1/2 ft	11 ¹²	11 ²⁶	Overturn 2nd wheel		
	3 (2)	10 ft	11 ¹³			11 ¹⁴	11 min
	4 (3)	12 ft	11 ²²	11 ²⁴	11 ²⁴	11 ²⁸	4 min
	4 (4)	6 ft	11 ²⁵		Little Perc.		
	5 (5)	6 ft	12 ⁵⁸	1 ⁰³	1 ⁰³	1 ¹⁸	15 min
	5 (6)	9 1/2 ft	1 ⁰⁰	1 ⁰²	1 ⁰⁴	1 ⁰⁴	2 min
		Dug to 12 ft same soil					

SOIL AUGER FINDING

TESTED BY R. Toner

REMARKS Hold No. 3 & 4 Poor soil until 8-9 ft.

Note 1: Good soil at 9 ft. system can be put in 12 ft deep.

FRED OMER

15074

NEAR NEAR CARROLL MILL ROAD

TRIDELPHIA ROAD


4/18/73

Plan OK

omer agreed
to fill old
well (W)
with cement

RH

600 ± FT

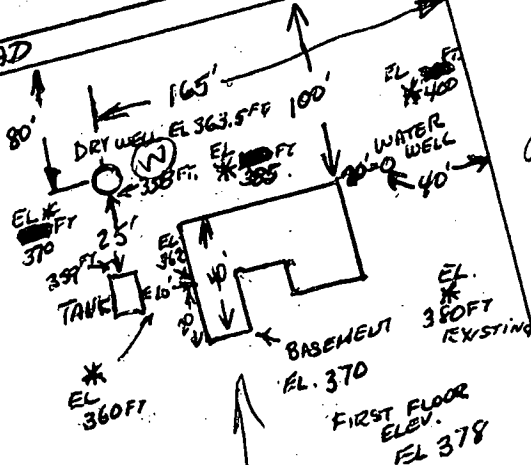

9.536 ACRES

Peck OK 3/29/73
MR. HODGE

I certify the above measurements and
elevation differences are actual and
correct for this property.

Signed: *[Signature]*

3-02.10.02 N

IP FD.

S 51° 42' 57" W
117.28'

IP set

S 36° 02' 05" W
66.00'

IP set

S 34° 27' 55" E
206.25'

S 19° 27' 55" E 15.00'
TRIDELPHIA
N 70° 32' 05" E

N 56° 12' 02" E
29.03'

20.14'
IP FD.

ROAD

44.00'

59%

10° 58' 50" E

S 70° 32' 05" W 15.15'

S 77° 34' 57" W
67.70'

N 77° 34' 57" E
67.70'

6

01

6

Fifth Line
JHO 62/4510

1

2

3

6

4

point of beginning
S 87° 10' 11" W 257.72'

N 87° 10' 11" E 257.72'

point of beginning

Fourth Line
"Saw Mill Lot"
Partition Record
E.P.H. 1/35

IP set

N 72° 10' 25" W

987.71'

1312.62'

S 13° 05' 02" W
132.00'

83.00'

also

45
99

195
5
391