

PERMIT

SEWAGE DISPOSAL SYSTEM

DEPARTMENT OF HEALTH AND MENTAL HYGIENE

HOWARD COUNTY HEALTH DEPARTMENT

BUREAU OF ENVIRONMENTAL HEALTH

~~XXXXXX~~

410-313-2640

INDEXED

05-428211

P 513350

A 58919-C

DISTRICT

DATE 3-28-2000

DATE SYSTEM APPROVED

INSPECTOR

South Carroll Backhoe, Inc.

IS PERMITTED TO INSTALL ☒ ALTER

ADDRESS 4410 Salem Bottom Road, Westminster, MD 21157

PHONE 410-875-4197

SUBDIVISION Lindsey's Landing

LOT 3

ROAD 14969 Triadelphia Road

PROPERTY OWNER Foster

ADDRESS

TOP SEAMED SEPTIC TANK REQUIRED

SEPTIC TANK CAPACITY 1250 GALLONS

NUMBER OF BEDROOMS 4

180 SQUARE FEET PER BEDROOM

LINEAR FEET OF TRENCH REQUIRED 180

PUMPED SEPTIC SYSTEM PROPOSED

INSTALL: - 1-1250 GALLON TOP SEAMED PUMP CHAMBER

NOTES: - Septic pump detail to be provided by installer prior to issuance of septic permit.

- Pump performance test is necessary prior to Health Department approval of pumped septic system.

TRENCHES - Trench to be 2 feet wide. Inlet 2.5 feet below original grade. Bottom maximum depth 6.5 feet below original grade. Effective area begins at 2.5 feet below original grade. 4 feet of stone below distribution pipe.

LOCATION - From the end of the pipestem access, place the distribution box approximately 170 feet down the left lot line and 55 feet off that lot line. Run trenches along contour toward right side of lot, making certain to install system as high on property as practical - while maintaining 100 foot separation from all surrounding wells. TRENCH LAYOUT INSPECTION SUGGESTED PRIOR TO BEGINNING TRENCH INSTALLATION.

NOTES - No trench to exceed 100 feet in length. Provide 6" - 8" diameter cleanout and cap to grade or above on septic tank. OK/MR

PLANS APPROVED BY C. Williams

DATE 6-28-1999

COVER NO WORK UNTIL INSPECTED AND APPROVED

NEITHER THE HOWARD COUNTY COUNCIL NOR THE HEALTH DEPARTMENT IS RESPONSIBLE FOR THE SUCCESSFUL OPERATION OF ANY SYSTEM

NOTE: CLEANOUT REQUIRED EVERY 70 FEET OF SEWER LINE AND/OR AT 90° SWEEPS IN LINES FROM HOUSE TO DRAIN FIELDS. 90° ELBOWS NOT ACCEPTABLE.

NOTE: ALL PARTS OF SEPTIC SYSTEMS (I.E. TANK, DISTRIBUTION BOX TRENCHES) TO BE 100 FEET FROM WELL (UNLESS OTHERWISE SPECIFICALLY AUTHORIZED)

NOTE: IF DEEP TRENCH(ES) ARE USED CALL FOR INSPECTION BEFORE AND AFTER PLACING GRAVEL IN TRENCH(ES)

NOTE: NO DRY WELL SHALL EXCEED 15 FOOT IN DIAMETER NO ABSORPTION TRENCH TO EXCEED 100 FEET IN LENGTH

NOTE: ALL PIPE FROM HOUSE TO SEPTIC TANK MUST BE CAST IRON OR SCHEDULE 35/40 PVC OR ABS


PERMIT VOID AFTER TWO YEARS

NOTE: INSTALL STAND PIPE ON SEPTIC TANK AND DRY WELL STAND PIPES MUST BE 6 INCHES IN DIAMETER CAST IRON, CONCRETE OR TERRA COTTA OR PVA OR ABS ACCEPTED. IF TOP OF SEPTIC TANK IS DEEPER THAN 3 FEET, MANHOLE TO GRADE REQUIRED.

NOTE: DISTRIBUTION BOXES MUST HAVE BAFFLES

*INSTALLER IS RESPONSIBLE FOR OBTAINING FINAL APPROVAL ON THIS PERMIT

*CALL 461-9933 FOR INSPECTION OF SEPTIC SYSTEM.

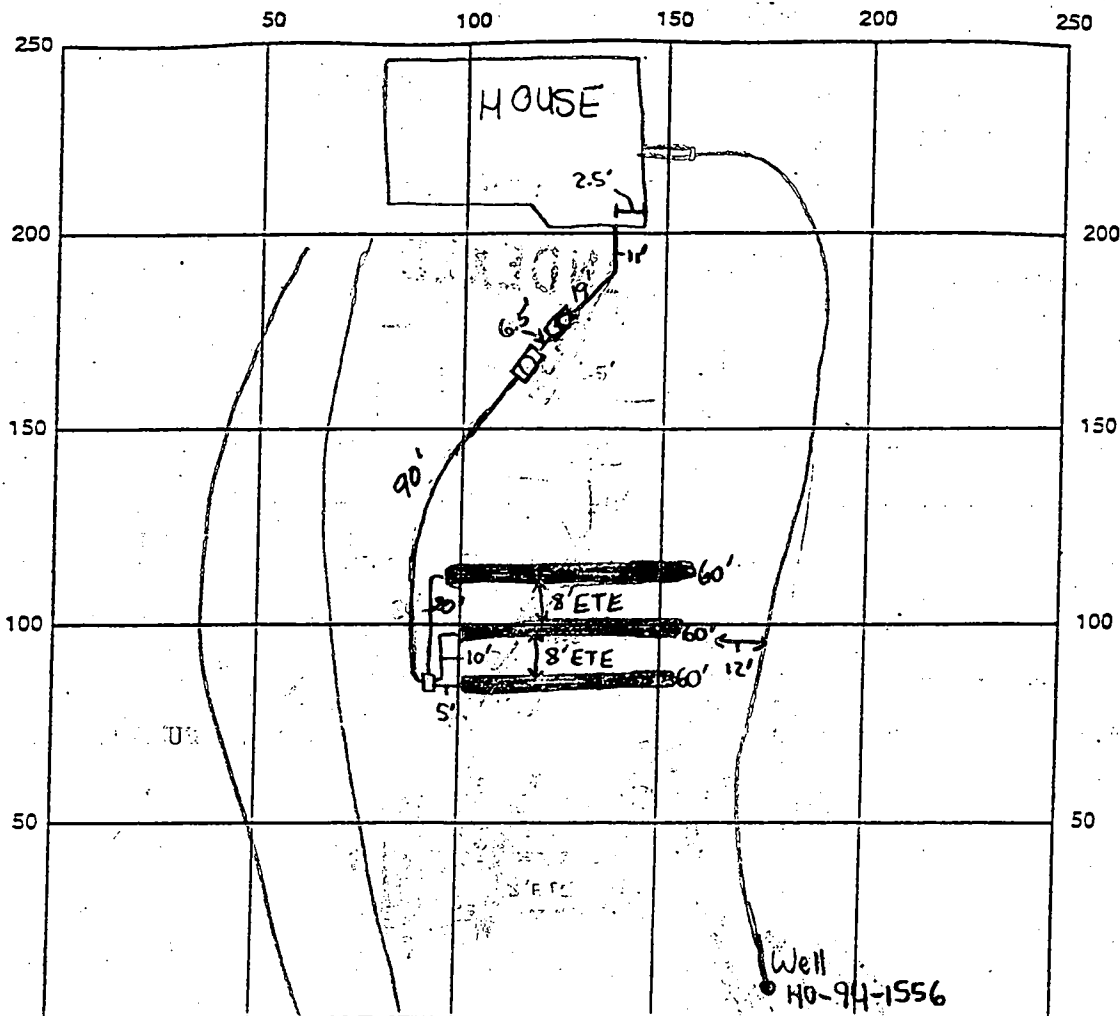

INDICATE NORTH - NAME ADJOINING ROADWAY AS BASE LINE

SEPTIC TANK LEVEL ☒ 1500 gallon topseam tank
☒ 1500 gallon topseam pump tank

CLEANOUTS Manhole on Septic Tank
 Manhole on Pump Tank

DISTRIBUTION BOX LEVEL ☒

DRAIN FIELD/TITLE DEPTH 6.5 FT.

TRENCH WIDTH 2 FT.

INLET DEPTH 2.5 FT.

EFFECTIVE GRAVEL DEPTH 4 FT.

TOTAL LENGTH 180 FT.

NUMBER OF TRENCHES 3

ONE SIDEWALL/BOTTOM AREA 720 SQ. FT.

DRYWALL INSIDE DIAMETER N/A FT.

EFFECTIVE DEPTH BELOW INLET N/A FT.

ABSORBENT AREA N/A SQ. FT.


REMARKS: 7/17/00 - OK TO CONTINUE WORK (SRW) 7/18/00 System satisfactory. O.K.
To cover. Final approval pending pump and alarm test. (BB)
Pump test OK - minor leak at quick disconnect, but passable. R/P 8/2/00

DATE SYSTEM APPROVED

8/2/00

INSPECTOR

R/P Kelly

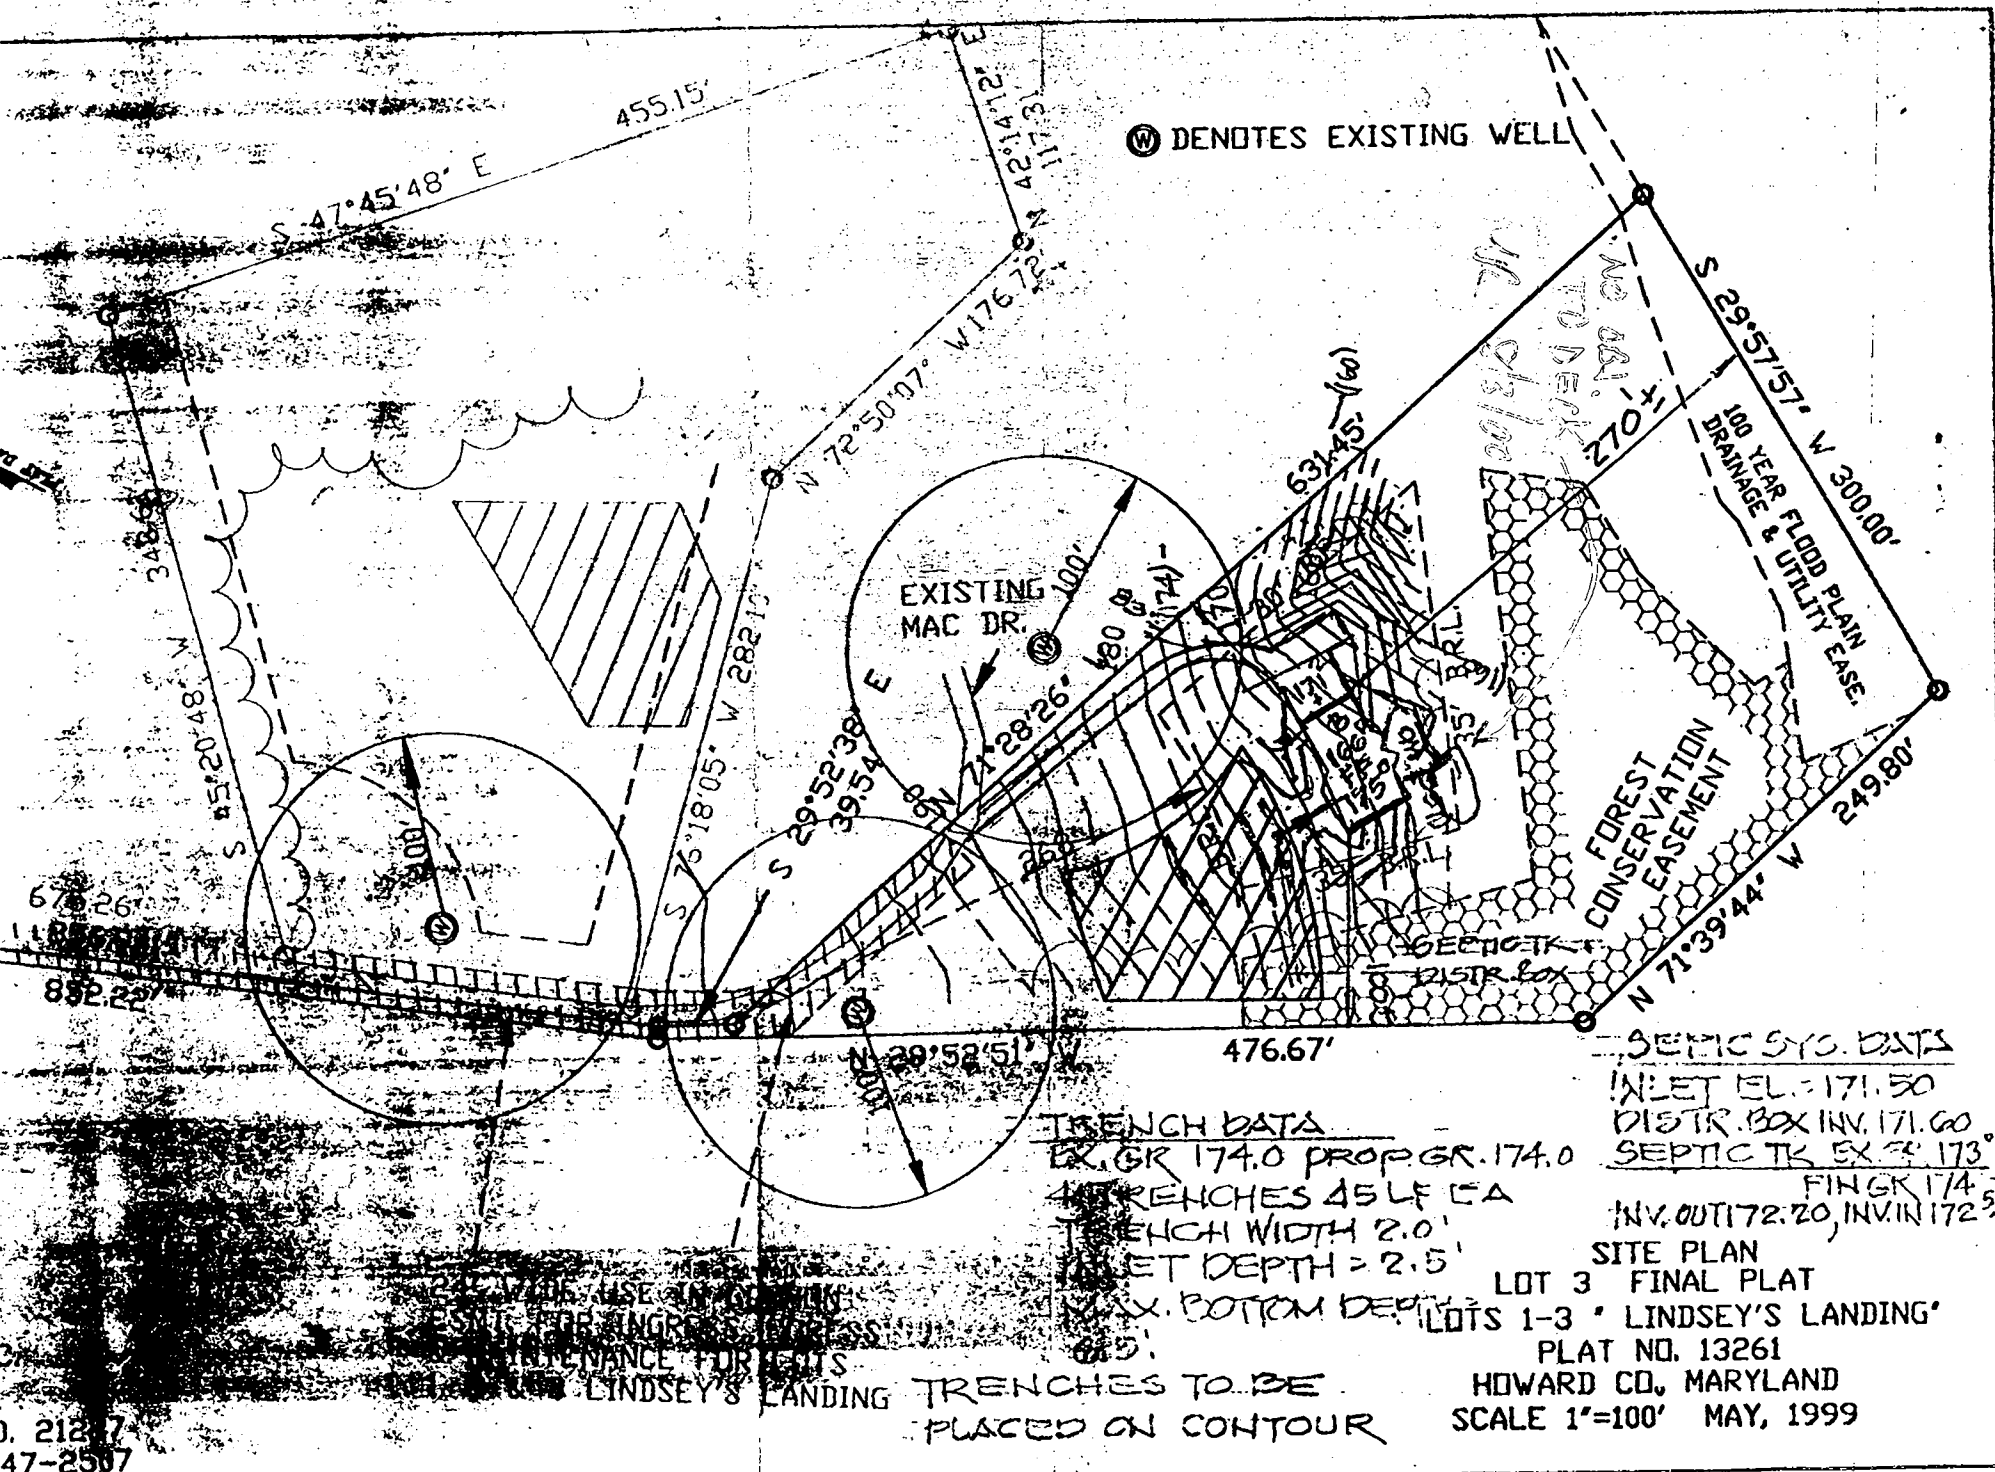

DEPARTMENT OF INSPECTIONS, LICENSES AND PERMITS 3430 COURT HOUSE DRIVE ELLICOTT CITY, MD 21043 PERMITS (410)313-2455 INSPECTIONS (410)313-1810 AUTOMATED INFORMATION (410) 313-3800	HOWARD COUNTY PERMIT APPLICATION	PERMIT NUMBER <u>300125823</u>
---	---	--

Building Address <u>14969 TRIDELPHIA Rd.</u> <u>GLENELG MD, 20737</u> Suite/Apt. #: _____ SDP/M/P/Petition #: _____ Census Tract <u>6051.01</u> Subdivision <u>LINDSEYS LANDING</u> Section _____ Area _____ Lot <u>3</u> Tax Map <u>27</u> Parcel <u>17</u> Grid <u>10</u> Zoning <u>HC-DEU</u> Map Coordinates <u>B B'</u> Lot size _____ Existing Use <u>SED</u> Proposed Use <u>SHINE</u> Estimated Construction Cost \$ <u>6,000</u> Description of Work <u>DECK ON REAR OF HOUSE</u> <u>APPROX 18' x 30' 1/2" x 1/2"</u>	Property Owner's Name <u>ROBERT FOSTER</u> Address <u>14965 TRIDELPHIA Rd.</u> City <u>GLENELG</u> State <u>MD</u> Zip Code <u>21737</u> Home Phone <u>410 381-2580</u> Work Phone _____ Applicant's Name & Mailing Address: (If other than stated hereon): <u>ROBERT SHILKE</u> <u>7475 NICKERSON LANE CIRCLE</u> <u>COLUMBIA, MD 21045</u> Phone <u>410 381-5765</u> Fax _____ Contractor Company <u>SELF</u> Contact Person _____ Address _____ City _____ State _____ Zip Code _____ License No. _____ Phone _____ Fax _____ Occupant or Tenant _____ Contact Name _____ Address _____ City _____ State _____ Zip Code _____ Phone _____ Fax _____
---	--

BUILDING DESCRIPTION - <u>COMMERCIAL</u>		BUILDING DESCRIPTION - <u>RESIDENTIAL</u>	
Building Characteristics Height: _____ No. of stories: _____ Gross area, sq. ft. per floor: _____ Use group: _____ Construction type: ☐ Reinforced Concrete ☐ Structural Steel ☐ Masonry ☐ Wood Frame ☐ State Certified Modular	Utilities Water Supply: ☐ Public ☐ Private Sewage Disposal: ☐ Public ☐ Private Electric Yes ☐ No ☐ Gas Yes ☐ No ☐ Heating System: Electric ☐ Oil ☐ Natural Gas ☐ Propane Gas ☐ Sprinkler system: <u>N/A</u> ☐ ☐ Full ☐ Partial ☐ Other Suppression ☐ # of Heads	Building Characteristics SF Dwelling ☐ SF Townhouse ☐ <u>Depth</u> <u>Width</u> 1st floor: _____ 2nd floor: _____ Basement: _____ Finished Basement ☐ Unfinished Basement ☐ Crawl space ☐ Slab on Grade ☐ No. of Bedrooms: _____ Multi-family dwellings: No. of efficiency units: _____ No. of 1 BR units: _____ No. of 2 BR units: _____ No. of 3 BR units: _____ Other Structure: _____ Dimensions: _____ Footings: _____ Roof: _____ ☐ State Certified Modular ☐ Manufactured Home	Utilities Water Supply: ☐ Public ☒ Private Sewage Disposal: ☐ Public ☒ Private Electric Yes ☐ No ☐ Gas Yes ☐ No ☐ Heating System: Electric ☐ Oil ☐ Natural Gas ☐ Propane Gas ☐ Sprinkler system: <u>N/A</u> ☐ ☐ NFPA #13D ☐ NFPA #13R ☐ Other

THIS UNDERSIGNED HEREBY CERTIFIES AND AGREES AS FOLLOWS: (1) THAT HE/SHE IS AUTHORIZED TO MAKE THIS APPLICATION; (2) THAT THE INFORMATION IS CORRECT; (3) THAT HE/SHE WILL COMPLY WITH ALL REGULATIONS OF HOWARD COUNTY WHICH ARE APPLICABLE THEREIN; (4) THAT HE/SHE WILL PERFORM NO WORK ON THE ABOVE REPRESENTED PROPERTY NOT SPECIFICALLY DESCRIBED IN THIS APPLICATION; (5) THAT HE/SHE GRANTS COUNTY OFFICIALS THE RIGHT TO ENTER ONTO THIS PROPERTY FOR THE PURPOSE OF INSPECTING THE WORK PERMITTED AND POSTING NOTICES.

<u>Robert Shilke</u> Applicant's Signature	<u>ROBERT SHILKE</u> Print Name
<u>Tule/Company</u> Title/Company	Date

Checks payable to: **DIRECTOR OF FINANCE OF HOWARD COUNTY**
**** PLEASE WRITE NEATLY AND LEGIBLY ****
- FOR OFFICE USE ONLY -

AGENCY ☒ Land Development DPZ ☒ State Highways ☒ Building Official ☒ Dev. Engineering DPZ ☒ Health ☒ Fire Protection	DATE <u>8/15/00</u> <u>8/3/00</u>	SIGNATURE APPROVAL <u>[Signature]</u> <u>Mark Kipper</u>	DPZ SETBACK INFORMATION Front: _____ Rear: _____ Side: _____ Side St.: _____ All minimum setbacks met? YES ☐ NO ☐ Is Entrance Permit required? YES ☐ NO ☐ Historic District? YES ☐ NO ☐ Lot Coverage for New Town Zone _____ SDP/Red-line approval date _____	PROPERTY ID# <u>35-169</u> Filing fee \$ _____ Permit fee \$ <u>50</u> Excise tax \$ _____ Sub-total paid \$ _____ Add'l permit fee \$ _____ TOTAL FEES \$ <u>3.5</u> Balance due \$ _____ Check # <u>001</u> Validation # _____
---	--	---	---	---

Is Sediment Control approval required prior to issuance?
 YES ☐ NO ☐

CONTINGENCY CONSTRUCTION START: ☐
 ONE STOP SHOP: ☐

Distribution of Copies: White: Building Official Green: LDD, DPZ Yellow: DED, DPZ Pink: Health Gold: SHA

Att.
ml
Bafel

Information

NOTE: The installer is responsible for requesting an inspection prior to 9 am on the day of the desired inspection. No work is to be covered until approved by the Health Department. All installations must comply with the National Standard Plumbing Code (NSPC, as amended locally) and COMAR 26.04.04 (MD Well Construction Regulations). Submission of a complete form is required prior to Use and Occupancy approval.

(Must circle one) Licensed Plumber Licensed Well Driller Licensed Well Pump Installer

*A licensed individual must perform the actual installation. Apprentices must be under the direct supervision of a licensed journeyman or master plumber, pump installer or well driller. Licenses may be subjected to field verification.

Subdivision: _____ Lot #: _____ Well Tag #: HO-94-1556

Submersible Pump Data Pitless Adapter

Model #: 554720-

Pump Capacity 7 GPM

Well Yield: 2 GPM

Depth of well encountered at time of pump installation: 170 (feet)

If pump capacity exceeds well yield, a low water cut off switch is required by NSPC 1990 Section 17.8.4

Torque arrestors or Cable guards are required. Must circle one

Safety rope, if used, attached to inside of well casing with eye bolt

Piping to house

Type: 1" Plastic

PSI: 200 (169 psi min)

Depth of supply line: (36" min)

House Connection

PVC sleeved to undisturbed soil at wall penetration:

Approximate length of sleeve: 5"

Sleeve caulked and sealed properly: ☒

The water supply line is required to be at least ten feet from the septic tank, pump chamber, sewage piping, distribution box, drainfields, and sewage reserve area. If this cannot be accomplished, contact this office for approval prior to installation.

Signature of company representative responsible for installation

date

For Health Department Use Only – Not to be completed by Installer

Date Insp. Requested: 7/18/00

Date Insp. Approved: 7/18/00 BL

Inspection Data: Pitless adapter and water supply line at least 36" below grade

Two piece cap installed and attached to casing securely

Elec. conduit extends at least 18" below grade/attached to cap properly

Safety rope installed inside of well casing

Correct well tag attached properly and casing 8" above finished grade ✓

Water supply line sleeved adequately at house connection	✓
--	---

Adequate grout observed below pitless adapter

NOTE: PUMP CHAMBER TO BE SAME SIZE AS SEPTIC TANK.

NOTE: HEALTH DEPT. APPROVAL OF THIS BUILDING PERMIT PLAN CONSTITUTES APPROVAL OF THE DEPICTED AMENDMENT TO THE RECORDED SEWAGE DISPOSAL EASEMENT.


6/28/99 CW

Ⓜ DENOTES EXISTING WELL

REVISED
Date: 6-28-99
Comments: 14969 Triadelphia Rd. 800118274

Moved house per Health Dept request - Septic

OK - *Craig Wilkins* 6/28/99

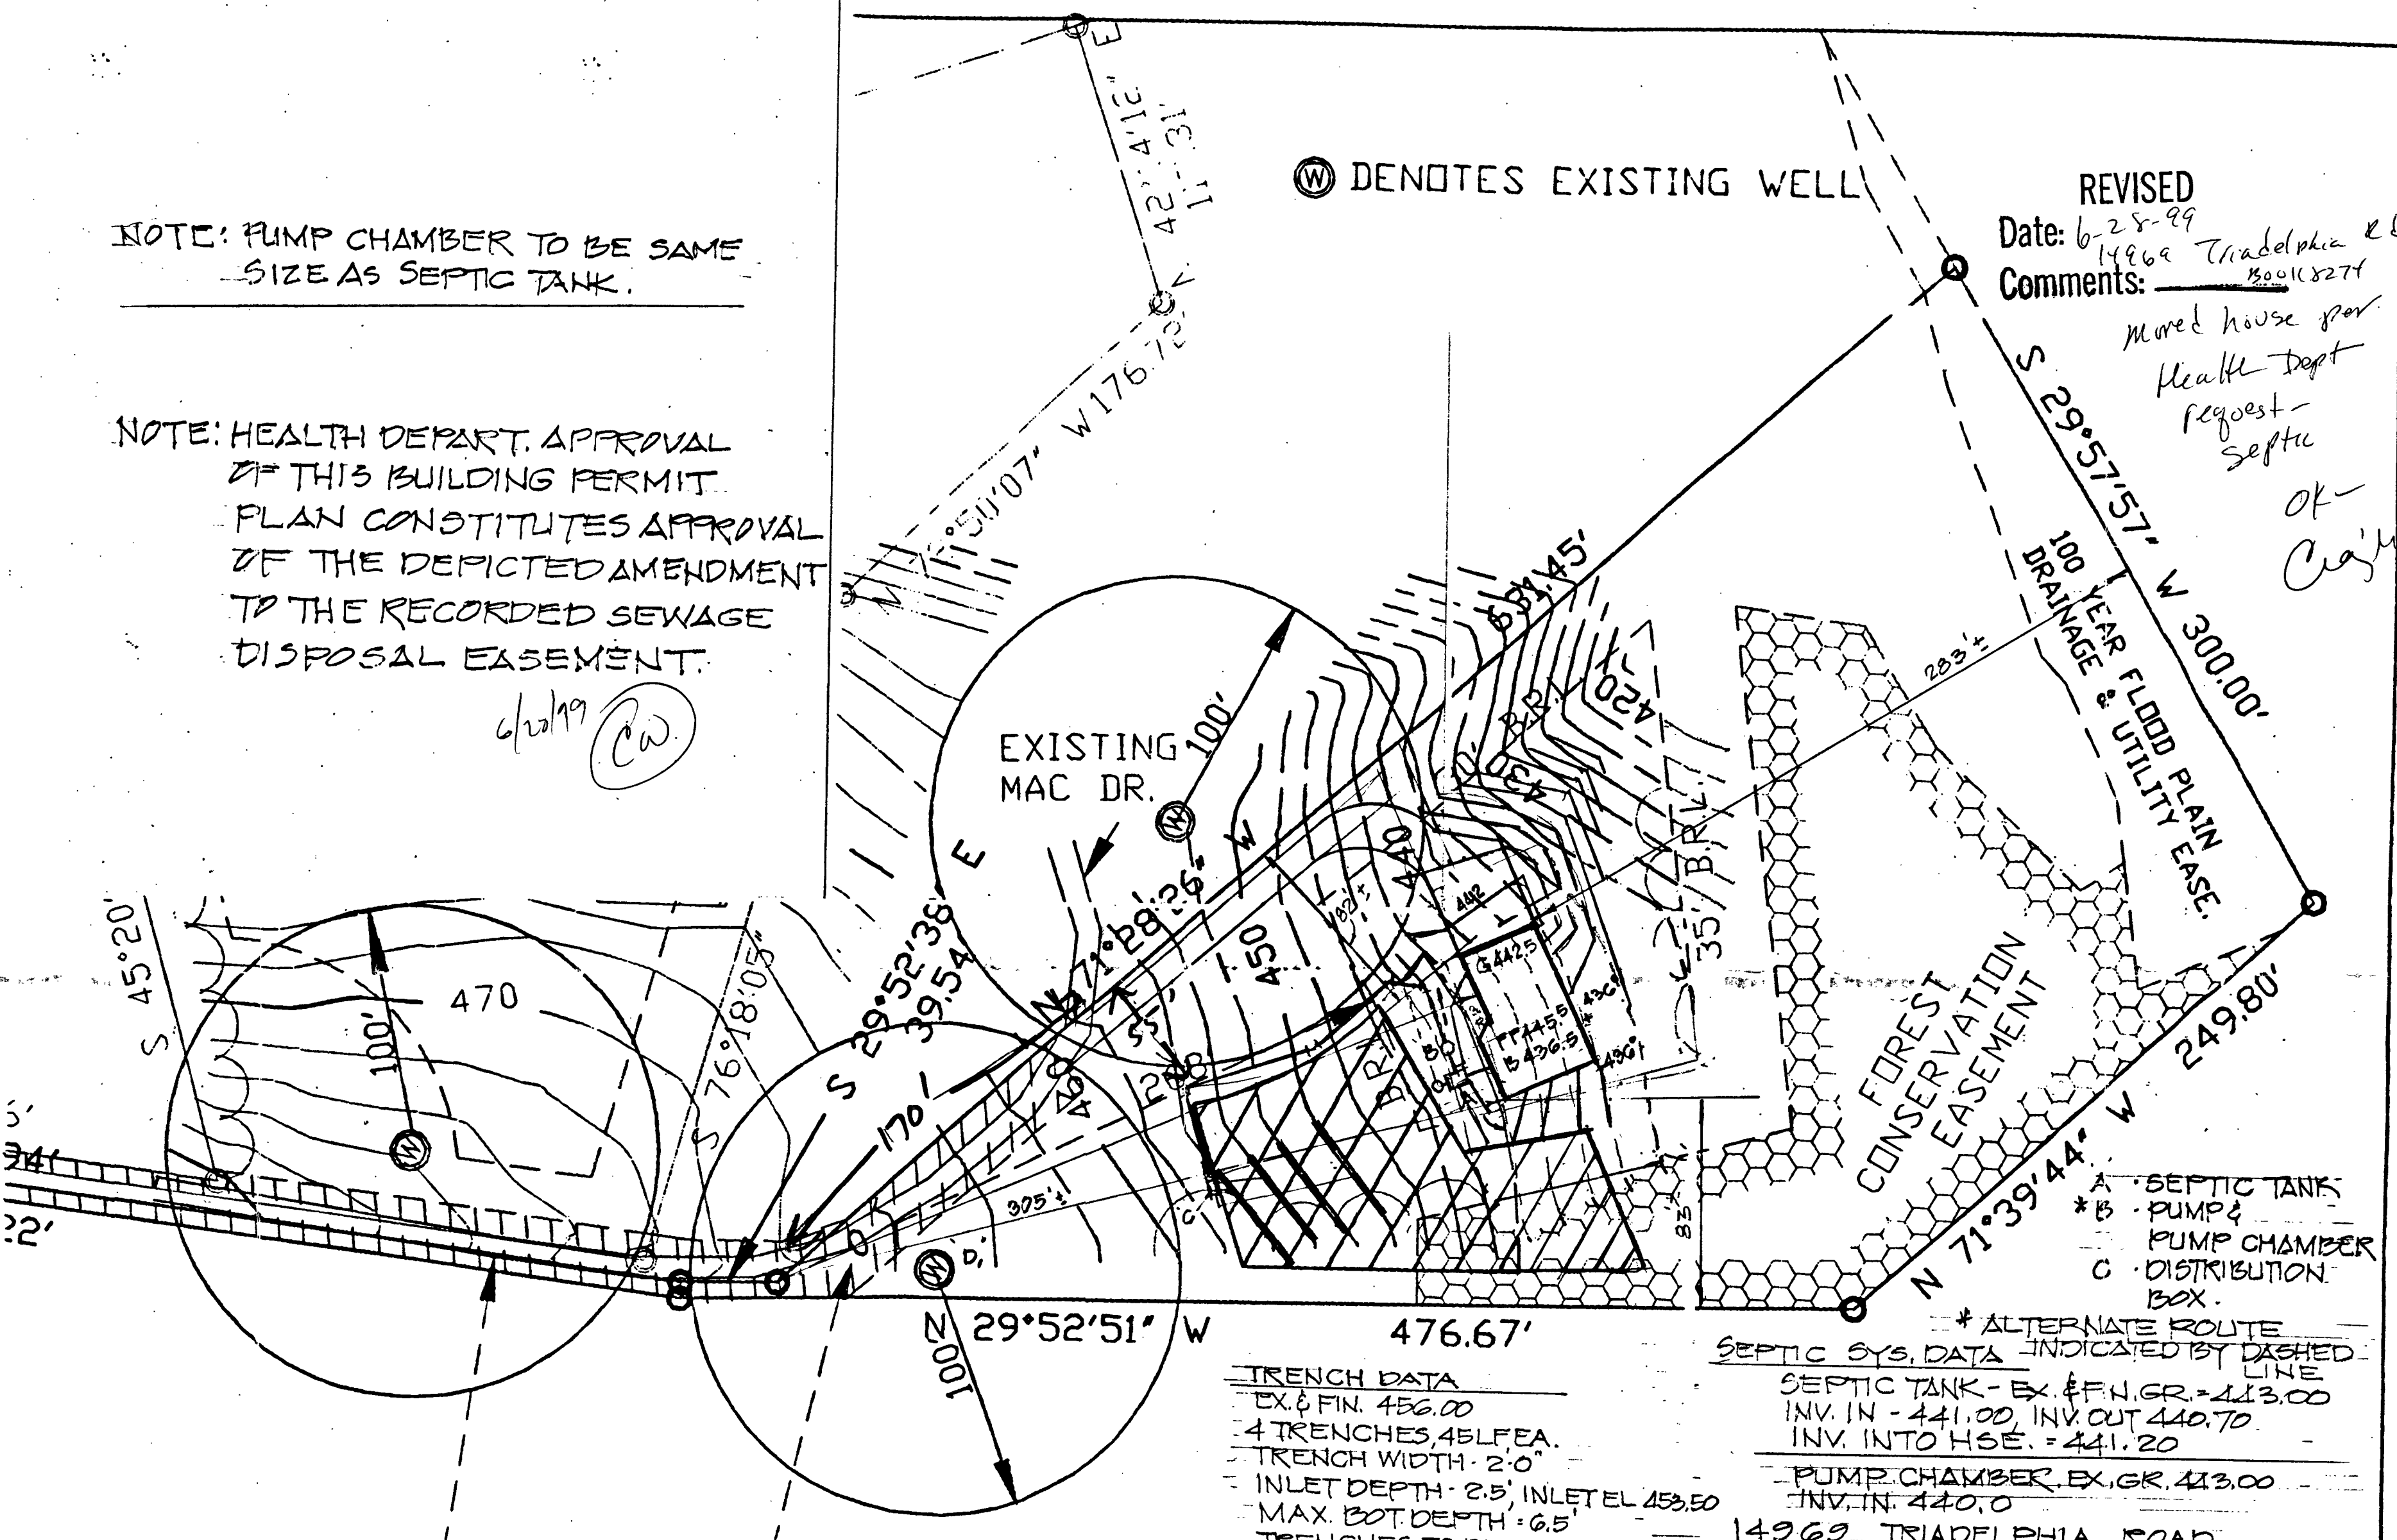

TRENCH DATA
EX. & FIN. 456.00
4 TRENCHES, 451 FEET
TRENCH WIDTH - 2'-0"
INLET DEPTH - 2'-5", INLET EL. 453.50
MAX. BOT. DEPTH - 6'-5"
TRENCHES TO BE PLACED ON CONTOUR.

SEPTIC SYS. DATA INDICATED BY DASHED LINE
SEPTIC TANK - EX. & FIN. GR. = 443.00
INV. IN - 441.00, INV. OUT 440.70
INV. INTO HSE. = 441.20
PUMP CHAMBER, EX. GR. 443.00
INV. IN - 440.00
14969 TRIADELPHIA ROAD

SITE PLAN
LOT 3 FINAL PLAT
LOTS 1-3 "LINDSEY'S LANDING"
PLAT NO. 13261
HOWARD CO., MARYLAND

"NOT TO" SCALE 1"=100' MAY, 1999

MAGNIFIED TO 1"=50'


Revised Septic System Plan
Howard County Health Department
800118274 SFD-4 BR
(REVISED HOUSE LOCATION AND SEWAGE DISPOSAL EASEMENT)
Craig Wilkins 6/28/99

Total linear feet of trench required 180 feet

Width of trench 2 feet
(INLET 2 1/2)
Depth of trench 6 1/2 feet

Depth of trench required below distribution pipe 4 feet


RON PARK

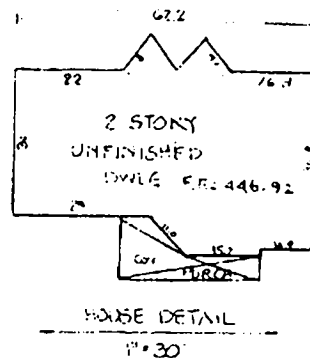

PROPANE TANK
LOCATION
OK
NO OBJECTION
ML 5/8/00

TRIADLPHIA ROAD

70' WIDE USE IN COMMON EASEMENT
FOR INGRESS EGRESS & MAINTENANCE
FOR LOTS 1 & 3 LINDSEY'S LANDING

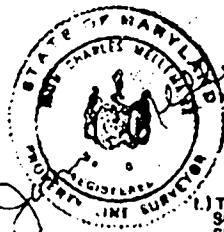

- 1.) THE PLAT IS OF BENEFIT TO A CONSUMER ONLY IN-
SO FAR AS IT IS REQUIRED BY A LENDER OR TITLE IN-
SURANCE COMPANY OR ITS AGENT IN CONNECTION OR
WITH CONTEMPLATED TRANSFER, FINANCING OR RE-
FINANCING.
- 2.) THE PLAT IS NOT TO BE RELIED UPON FOR THE ES-
TABLISHMENT OR LOCATION OF FENCES, GARAGES,
BUILDING, OR OTHER EXISTING OR FUTURE IMPROVE-
MENTS.

24' WIDE USE IN COMMON
EASEMENT FOR INGRESS, EGRESS
& MAINTENANCE FOR LOTS 1, 2 & 3
LINDSEY'S LANDING

NOTE: ALSO KNOWN AS LOT 3 AS SHOWN ON FINAL PLAT
LOT 1-3 LINDSEY'S LANDING RECORDED IN
HOWARD CO. MD. ON PLAT CM P 13261

PREPARED BY:
JOHN C. MELLEMA SR., INC.
LAND SURVEYORS

5409 EAST DRIVE BALTO., MD. 21227

LOCATION DRAWING

ADDRESS: LOT 3 TRIADLPHIA ROAD

COUNTY: HOWARD CO. SCALE: 1" = 100'

DATE: 2-8-00 JOB NO: 2042

Install a 1000 Gallon ASME UNDER GROUND
LP TANK, PER NFPA 58.

DEPARTMENT OF INSPECTIONS, LICENSES AND PERMITS 3430 COURT HOUSE DRIVE ELIJAH CITY, MD 21043 PERMITS (410) 313-2455 INSPECTIONS (410) 313-1810 AUTOMATED INFORMATION (410) 313-3800	HOWARD COUNTY PERMIT APPLICATION	PERMIT NUMBER <u>1300123777</u>
---	---	---

Building Address <u>14969 Tanadelpin Rd</u> <u>Jay Lm, MD 21036</u> Suite/Apt. #: _____ SDP/WP/Petition #: _____ Census Tract <u>6051.01</u> Subdivision <u>Lindseys Landing</u> Section _____ Area _____ Lot <u>3</u> Tax Map <u>27</u> Parcel <u>17</u> Grid <u>10</u> Zoning <u>RC-D40</u> Map Coordinates <u>13B1</u> Lot size _____ Existing Use <u>Single Family Dwelling</u> Proposed Use <u>Same with LP Tank</u> Estimated Construction Cost <u>\$35,000</u> Description of Work <u>Install (1) new 60 Gallon LP tank (under ground) LP tank per NFPA 58</u> <u>LIQUID PROPANE 1300123777</u> Occupant or Tenant <u>owner</u> Contact Name _____ Address _____ City _____ State _____ Zip Code _____ Phone _____ Fax _____	Property Owner's Name <u>R. Scott J. McLaughlin</u> Address <u>10306 Bala Natic Pike</u> City <u>Ellicott City</u> State <u>MD</u> Zip Code <u>21043</u> Home Phone _____ Work Phone <u>410-740-4640</u> Applicant's Name & Mailing Address, (if other than stated hereon): _____ Phone _____ Fax _____ Contractor Company <u>Amco Gas</u> Contact Person <u>Tom McLaughlin</u> Address <u>10097 Bala Natic Pike</u> City <u>Ellicott City</u> State <u>MD</u> Zip Code <u>21042</u> License No. _____ Phone <u>410-465-0800</u> Fax _____ Engineer or Architect Company _____ Contact Person _____ Address _____ City _____ State _____ Zip Code _____ Phone _____ Fax _____
---	---

BUILDING DESCRIPTION - <u>COMMERCIAL</u>		BUILDING DESCRIPTION - <u>RESIDENTIAL</u>	
Building Characteristics Height: _____ No. of stories: _____ Gross area, sq. ft. per floor: _____ Use group: _____ Construction type: ☐ Reinforced Concrete ☐ Structural Steel ☐ Masonry ☐ Wood Frame ☐ State Certified Modular	Utilities Water Supply: ☐ Public ☐ Private Sewage Disposal: ☐ Public ☐ Private Electric Yes ☐ No ☐ Gas Yes ☐ No ☐ Heating System: Electric ☐ Oil ☐ Natural Gas ☐ Propane Gas ☐ Sprinkler system: <u>N/A</u> ☐ ☐ Full ☐ Partial ☐ Other Suppression ☐ # of Heads	Building Characteristics SF Dwelling ☐ SF Townhouse ☐ <u>Depth</u> <u>Width</u> 1st floor: _____ 2nd floor: _____ Basement: _____ Finished Basement ☐ Unfinished Basement ☐ Crawl space ☐ Slab on Grade ☐ No. of Bedrooms: _____ Multi-family dwellings: No. of efficiency units: _____ No. of 1 BR units: _____ No. of 2 BR units: _____ No. of 3 BR units: _____ Other Structure: _____ Dimensions: _____ Footings: _____ Roof: _____ ☐ State Certified Modular ☐ Manufactured Home	Utilities Water Supply: ☐ Public ☐ Private Sewage Disposal: ☐ Public ☐ Private Electric Yes ☐ No ☐ Gas Yes ☐ No ☐ Heating System: Electric ☐ Oil ☐ Natural Gas ☐ Propane Gas ☐ Sprinkler system: <u>N/A</u> ☐ ☐ NFPA #13D ☐ NFPA #13R ☐ Other:

THIS UNDERSIGNED HEREBY CERTIFIES AND AGREES AS FOLLOWS: (1) THAT HE/SHE IS AUTHORIZED TO MAKE THIS APPLICATION; (2) THAT THE INFORMATION IS CORRECT; (3) THAT HE/SHE WILL COMPLY WITH ALL REGULATIONS OF HOWARD COUNTY WHICH ARE APPLICABLE THEREBY; (4) THAT HE/SHE WILL PERFORM NO WORK ON THE ABOVE REFERENCED PROPERTY NOT SPECIFICALLY DESCRIBED IN THIS APPLICATION; (5) THAT HE/SHE GRANTS COUNTY OFFICIALS THE RIGHT TO ENTER ONTO THIS PROPERTY FOR THE PURPOSE OF INSPECTING THE WORK PERMITTED AND POSTING NOTICES.

<u>Thomas R. McLaughlin</u> Applicant's Signature <u>Amco Gas</u> Title/Company	<u>Thomas R. McLaughlin</u> Print Name <u>Apr 24, 2000</u> Date
--	--

Checks payable to: DIRECTOR OF FINANCE OF HOWARD COUNTY
 ** PLEASE WRITE NEATLY AND LEGIBLY. **
 - FOR OFFICE USE ONLY -

AGENCY ☒ Land Development DPZ ☐ State Highways ☐ Building Official ☐ Dev. Engineering DPZ ☐ Health ☐ Fire Protection	DATE <u>5/9/00</u>	SIGNATURE APPROVAL <u>Mark P. R. R. R.</u>	DPZ SETBACK INFORMATION Front: _____ Rear: _____ Side: _____ Side St: _____ All minimum setbacks met? YES ☐ NO ☐ Is Entrance Permit required? YES ☐ NO ☐ Historic District? YES ☐ NO ☐ Lot Coverage for New Town Zone _____ SDP/Red-line approval date _____	PROPERTY ID# <u>41365</u> Filing fee \$ <u>112.00</u> Permit fee \$ _____ Excise tax \$ _____ Sub-total paid \$ _____ Add'l permit fee \$ _____ TOTAL FEES \$ <u>112.00</u> Balance due \$ _____ Check # <u>10887377</u> Validation # <u>31160</u>
--	------------------------------	--	--	---

CONTINGENCY CONSTRUCTION START: ☐
 ONE STOP SHOP: ☐

Distribution of Copies - White: Building Official Green: LDD, DPZ Yellow: DED, DPZ Pink: Health Gold: SHA

e:\permit.fm Rev. 10/15/98

APPLICATION

PERCOLATION TESTING

A 58919C

P _____

HOWARD COUNTY HEALTH DEPARTMENT

BUREAU OF ENVIRONMENTAL HEALTH

3525-H ELLICOTT MILLS DRIVE/ELLICOTT CITY, MARYLAND 21043
TELEPHONE: 313-2640

DISTRICT _____

DATE 8-19-97

TO: THE COUNTY HEALTH OFFICER
ELLICOTT CITY, MARYLAND

I HEREBY APPLY FOR THE NECESSARY TEST PRIOR TO APPLICATION FOR PERMIT TO CONSTRUCT (OR RECONSTRUCT) A SEWAGE DISPOSAL SYSTEM.

PROPERTY OWNER Michael Smith Foster

ADDRESS 14965 Triadelphia Rd PHONE (410) 442-1125

AGENT OR PROSPECTIVE BUYER _____

ADDRESS _____ PHONE _____

PROPERTY LOCATION:

SUBDIVISION Smith property LOT NO. Lot 3

ROAD AND DESCRIPTION off of 14969 Triadelphia Rd on to macadam Drive

TAX MAP 27 PARCEL # 17

SIZE OF LOT 3.14 TYPE BLDG. Single Family Dwelling - 4Bm
(SINGLE FAMILY DWELLING OR COMMERCIAL)

ORIGINAL PERMIT SIGNED

AND RETURNED 6-25-99

Serial # B00118274

THE SYSTEM INSTALLED UNDER THIS APPLICATION IS ACCEPTABLE ONLY UNTIL PUBLIC FACILITIES BECOME AVAILABLE. I FULLY UNDERSTAND THE FEE CONNECTED WITH THE FILING OF THIS PERC TEST APPLICATION IS NON-REFUNDABLE UNDER ANY CIRCUMSTANCES. I ALSO AGREE TO COMPLY WITH ALL M.O.S.H.A. REQUIREMENTS IN TESTING THIS LOT.

Chad D. J.

(SIGNATURE OF APPLICANT)

APPROVED BY _____ FOR _____ DATE _____

DISAPPROVED BY _____ FOR _____ DATE _____

HOLD PENDING FURTHER TESTS _____

REASONS FOR REJECTION OR HOLDING _____

PERCOLATION TEST PLAT/PRELIMINARY PLAT - TITLE OR I.D. # _____ DATE _____

SITE DEVELOPMENT PLAN/FINAL PLAT - TITLE OR I.D. # _____ DATE _____


THIS IS NOT A PERMIT

58919 C
COUNTY #

STEEP SLOPE

SOIL PROFILE

SOIL PROFILE

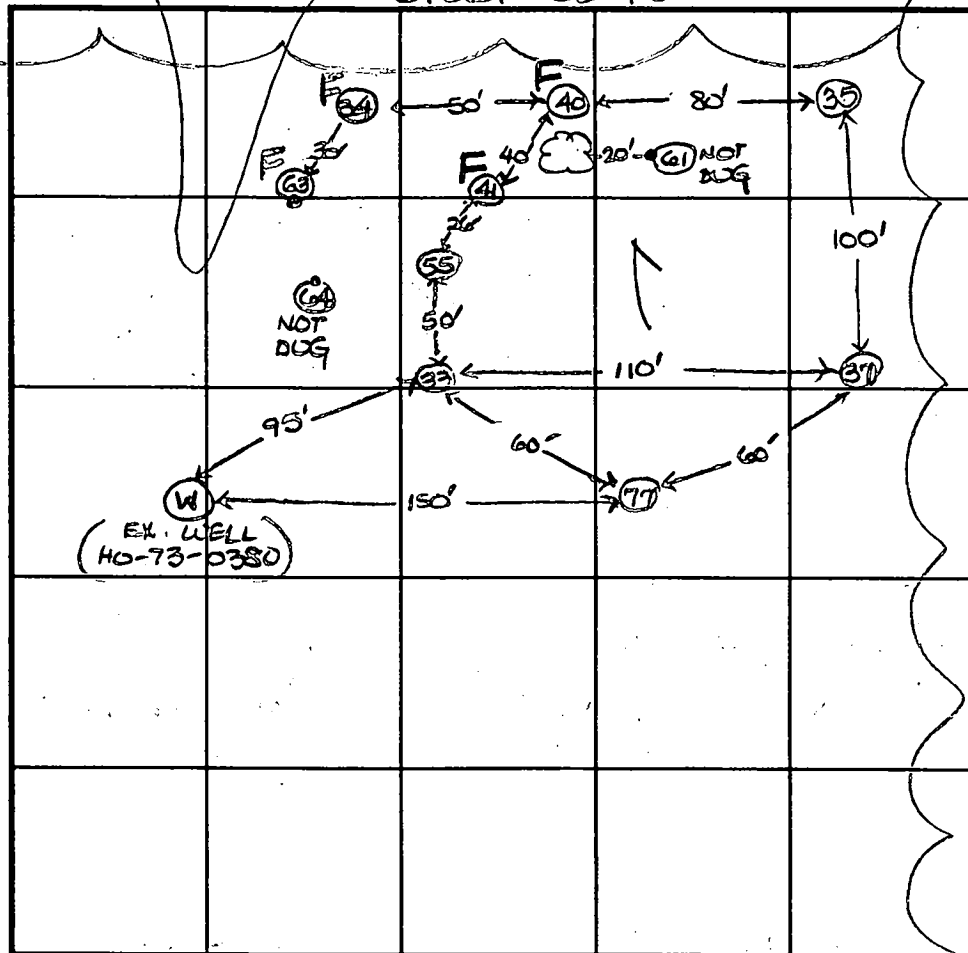

INDICATE NORTH - NAME ADJOINING ROADWAY AS BASE LINE.

Triadelphia Road

DATE	TEST NO.	DEPTH	PRE-WET		TEST - 1" DROP		TIME
			START	STOP	START	STOP	
9-15-97	33	2'8" S	11:49 ₃	11:58	11:58	12:10	12
		10'8" D	Visual				OK
	34	7.0' D	Refusal				FAIL
	35	3.0' S	12:03	12:04	12:04	12:06	2
		6.5' M	12:00	12:00 ₃	12:00 ₃	12:02	2
		11.0' D	Visual				OK
	40	8.0' D	Refusal				FAIL
	41	7.5' D	Refusal				FAIL
	37	3.0' S	12:09	12:14	12:14	12:20	6
		10.5' D	Visual				OK

REMARKS use holes (33), (55), (37), (77)

TYPE OF SOIL

TESTED BY D. Soe

ALSO PRESENT C. Zepp

TRENCH DESIGN DATA: AVERAGE PERCOLATION TIME

5

TRENCH WIDTH

2

INLET DEPTH 2.5

MAXIMUM BOTTOM DEPTH 6.5

SQ. FT./BEDROOM

180

Refusal

SOIL PROFILE

topsoil

org red
brn
cl lm

1+ org
brn
sa si
lm

topsoil
org red
brn
cl lm

pale
org brn
sa si lm

15%+
Rx

topsoil

org brn
cl lm

beige
sa si lm

10-15%
Rx

COUNTY #

SOIL PROFILE

0' (55)
 1' topsoil
 2.5' org red
 2' brn
 2' sil
 pale org
 brn
 sa sil
 1m
 15%+
 Rx
 12'

0' (77)
 1' topsoil
 2.5' org brn
 2' sil
 1+ brn
 to
 tan
 sa sil
 1m
 15%
 Rx
 12'

SOIL PROFILE

0'

PLEASE SEE ATTACHED
 FOR DIAGRAM

INDICATE NORTH - NAME ADJOINING ROADWAY AS BASE LINE.

DATE	TEST NO.	DEPTH	PRE-WET		TEST - 1" DROP		TIME
			START	STOP	START	STOP	
9-15-97	55	12.0'D	Visual				OK
	77	3.0'S	1:17	1:18 ₃	1:18 ₃	1:21	3
		12.0'D	Visual				OK
	63	8.0'D	Refusal				FAIL

REMARKS _____

TYPE OF SOIL _____

TESTED BY D. Soe ALSO PRESENT C. Zepp

TRENCH DESIGN DATA: AVERAGE PERCOLATION TIME _____ TRENCH WIDTH _____


INLET DEPTH _____ MAXIMUM BOTTOM DEPTH _____ SQ. FT./BEDROOM _____

Signed: PERC
Cert

PROPOSED 20' WIDE
PRIVATE EASEMENT FOR
INGRESS, EGRESS &
MAINTENANCE FOR LOTS
(USE - IN - COMMON)

CAPPS
2216/189

24' WIDE
EASEMENT FOR
EGRESS &
MAINTENANCE FOR LOTS
(COMMON)

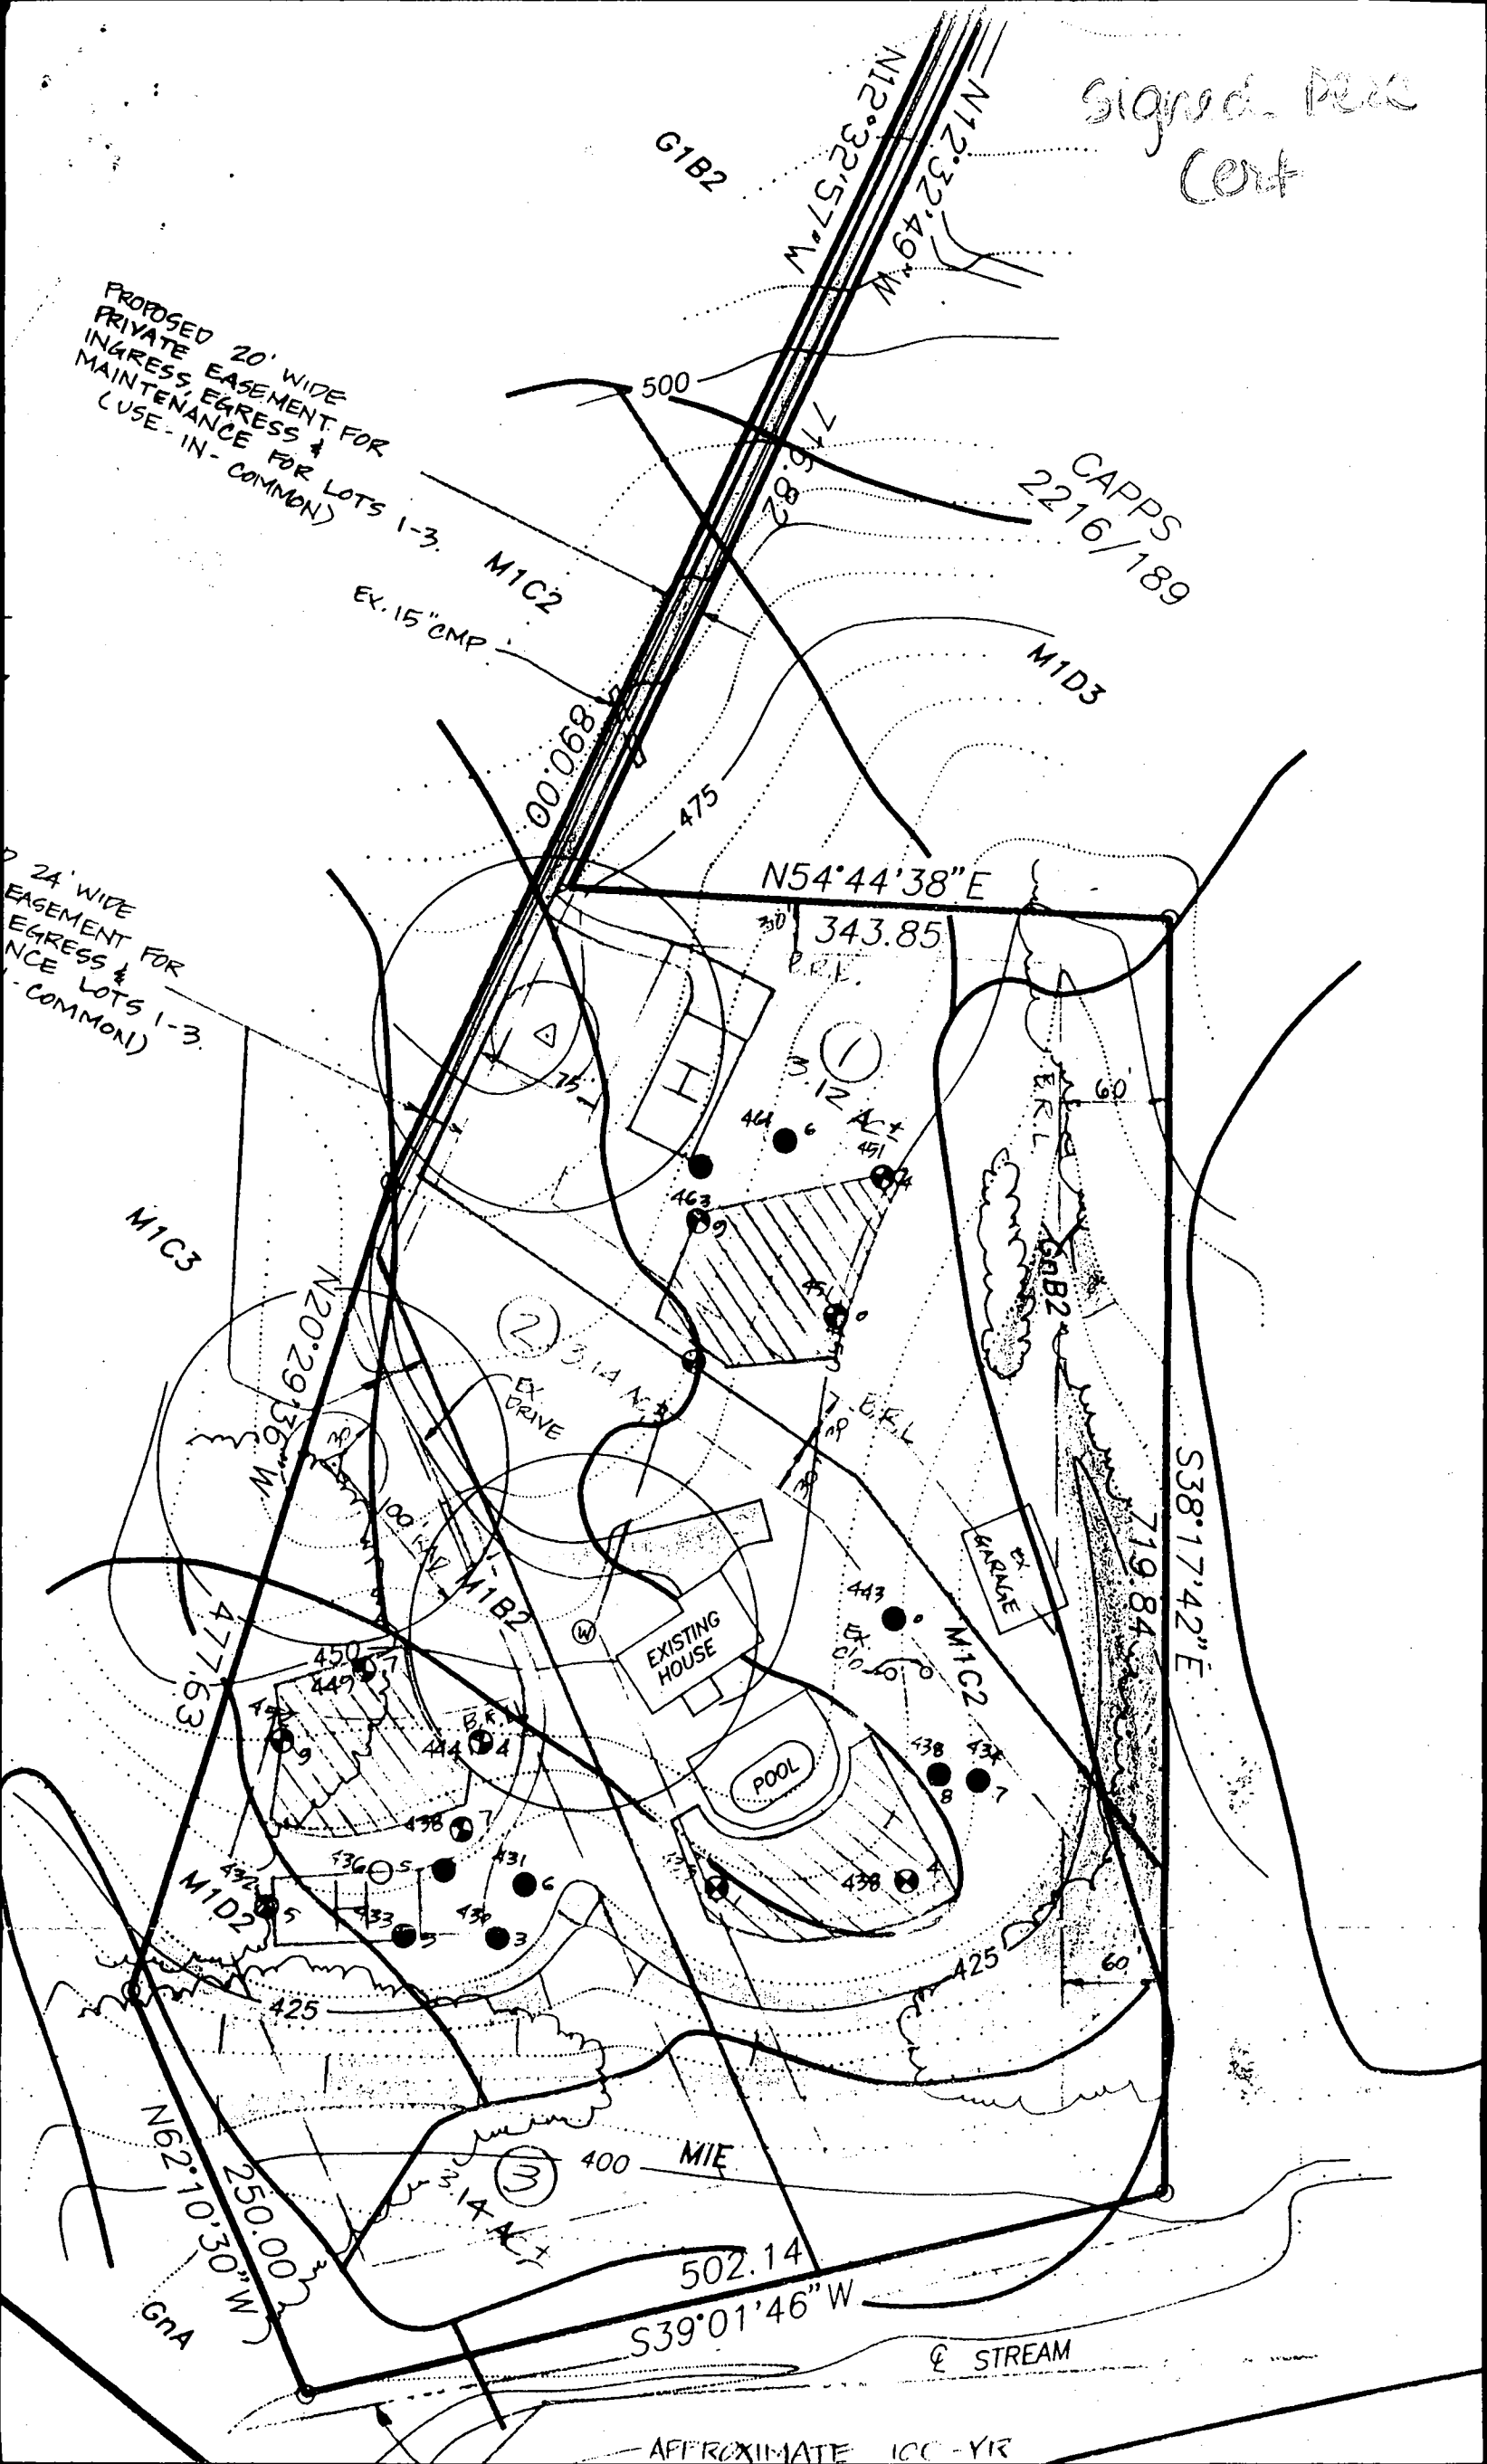

APPROXIMATE 100-YR

NOT EXCEED 8%.

WHERE ONE (1) DRIVEWAY SERVES MORE THAN ONE (1) (WAYS), A HOUSE NUMBER SIGN MUST BE PLACED AT EACH A RANGE OF STREET ADDRESS HOUSE NUMBERS SIGN WHERE WAY INTERSECTS WITH THE MAIN ROAD.

CAPABLE OF SAFELY PASSING 100 YEAR FLOOD WITH NO MORE THAN 1' DEPTH OVER EMT FROM STORMWATER MANAGEMENT REQUIREMENTS BECAUSE ER THAN TWO ACRES,


OR CONSTRUCTION IS PERMITTED WITHIN STREAM BUFFERS OR 100-YEAR

MOVED PERC TEST.
D PERC TEST.
ATION OF 100-YEAR FLOODPLAIN

copy of signed
Final
F-98-100

OF THE DESIGN NATURAL FLOODING IN THE
USE-IN-COMMON DRIVEWAY WITHIN A 20 FOOT EASEMENT FROM COORD. PTS. 13 & 14 TO PT. 13).



20. THE FOREST CONSERVATION EASEMENT HAS BEEN ESTABLISHED TO FULFILL THE REQUIREMENTS OF SECTION 16.1200 OF THE HOWARD COUNTY CODE FOREST CONSERVATION ACT. NO CLEARING, GRADING OR CONSTRUCTION IS PERMITTED WITHIN THE FOREST CONSERVATION EASEMENT, HOWEVER, FOREST MANAGEMENT PRACTICES AS DEFINED IN THE DEED OF FOREST CONSERVATION EASEMENT ARE ALLOWED.

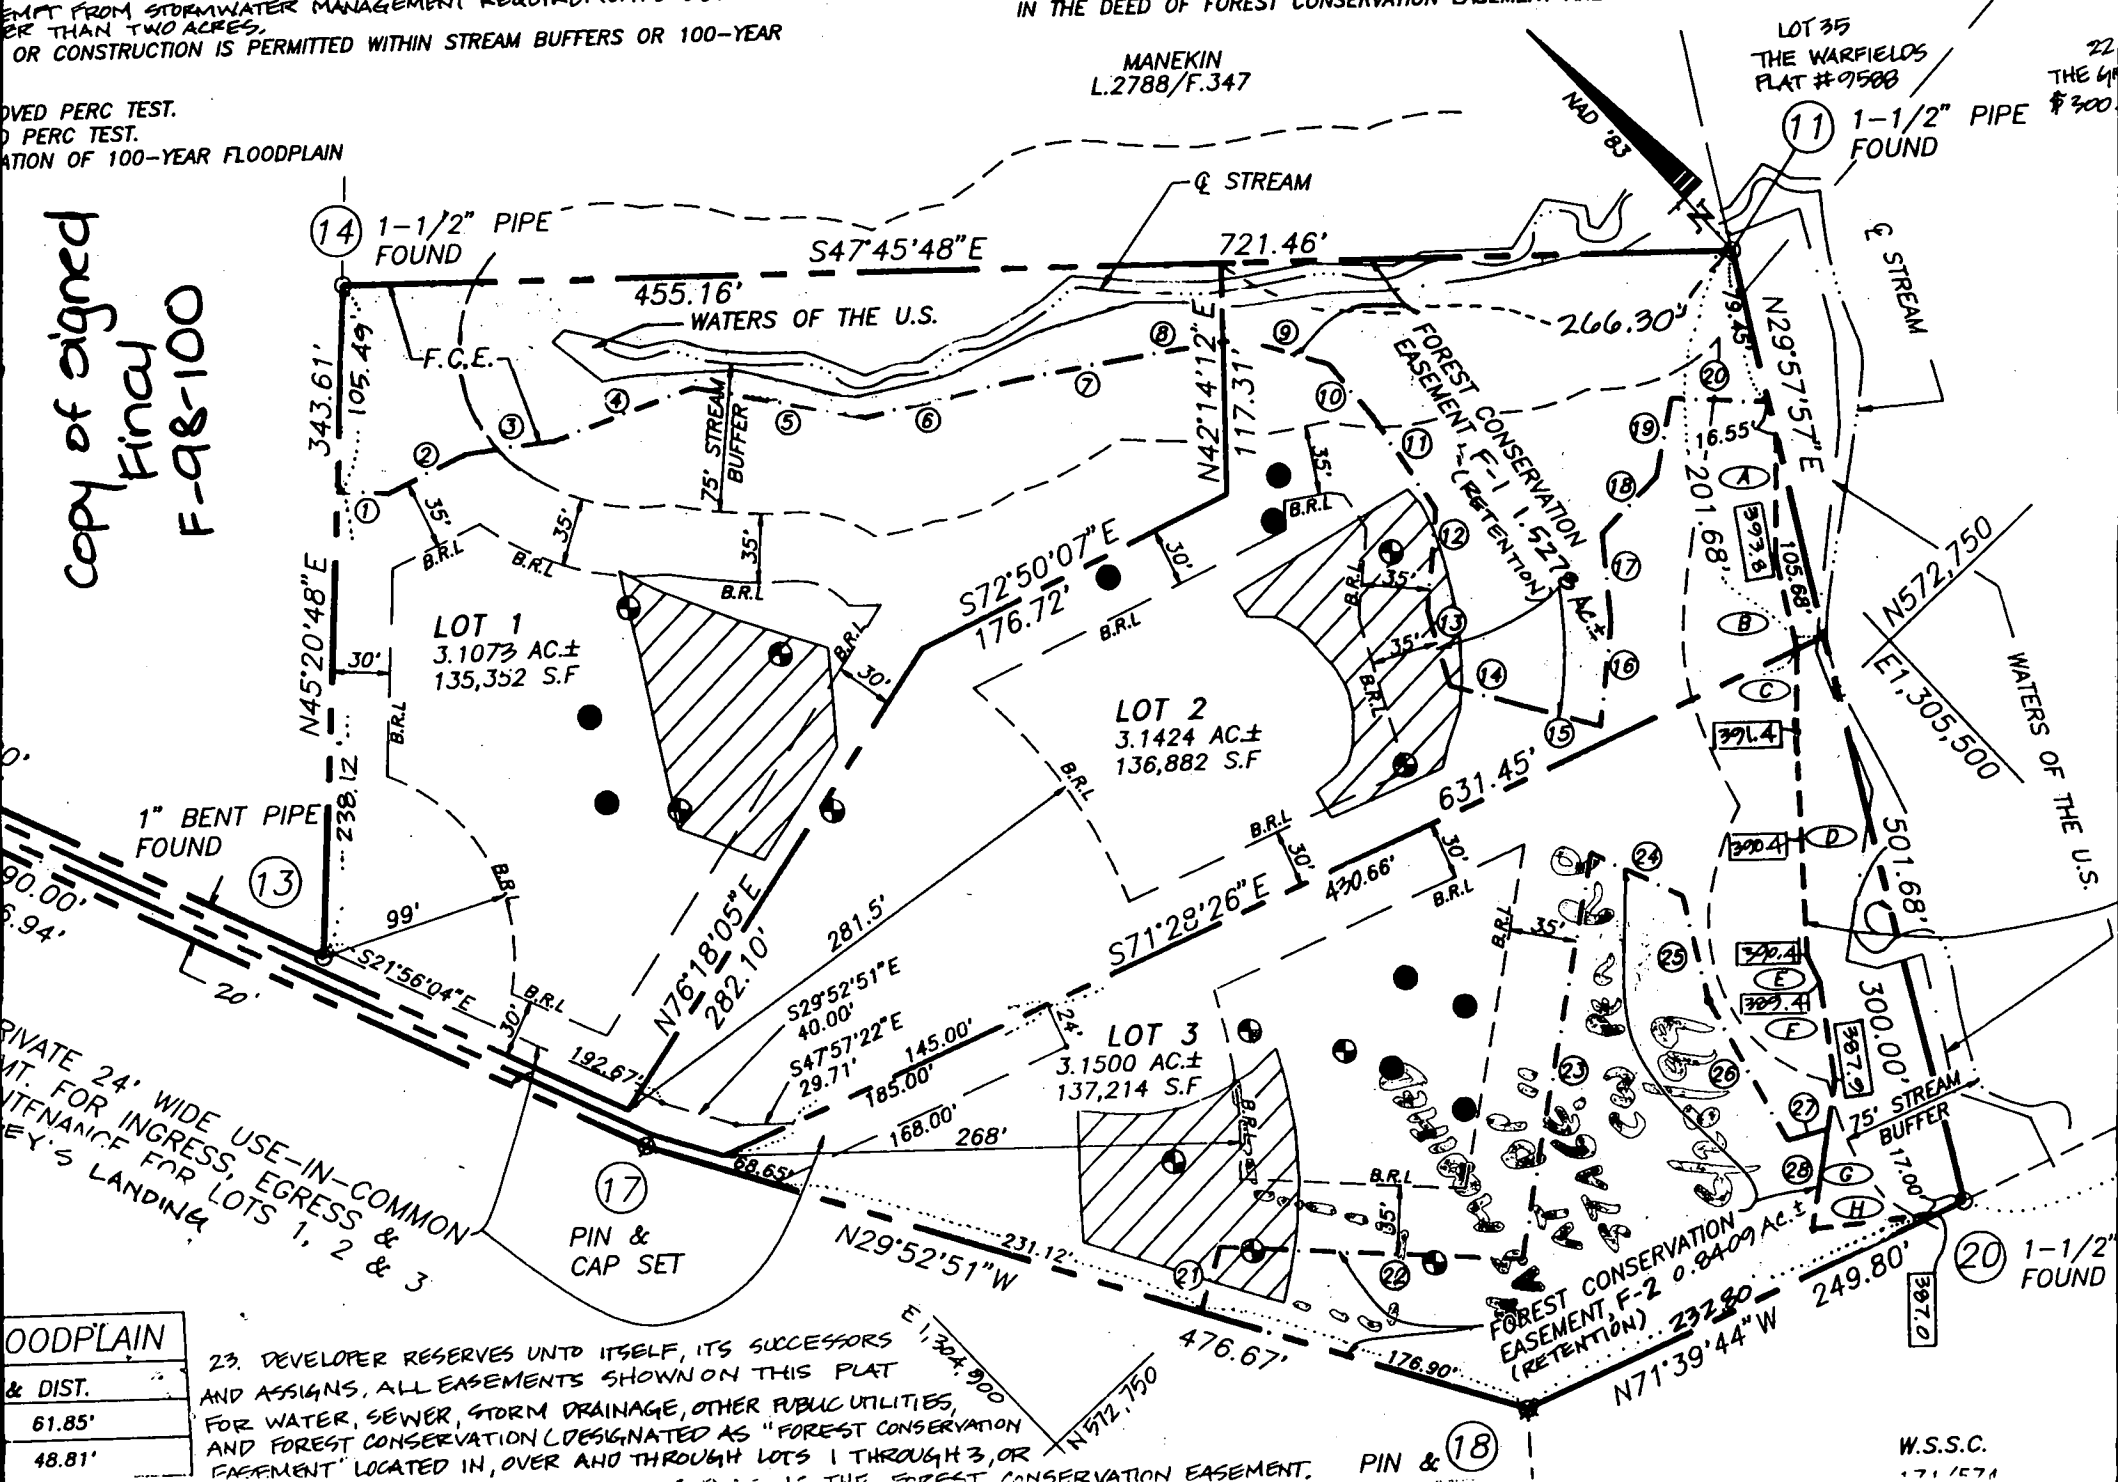

PRIVATE 24' WIDE USE-IN-COMMON
MT. FOR INGRESS, EGRESS &
MAINTENANCE FOR LOTS 1, 2 & 3
THEY'S LANDING

FLOODPLAIN	
& DIST.	
61.85'	
48.81'	

23. DEVELOPER RESERVES UNTO ITSELF, ITS SUCCESSORS AND ASSIGNS, ALL EASEMENTS SHOWN ON THIS PLAT FOR WATER, SEWER, STORM DRAINAGE, OTHER PUBLIC UTILITIES, AND FOREST CONSERVATION (DESIGNATED AS "FOREST CONSERVATION EASEMENT" LOCATED IN, OVER AND THROUGH LOTS 1 THROUGH 3, OR

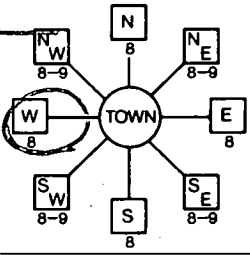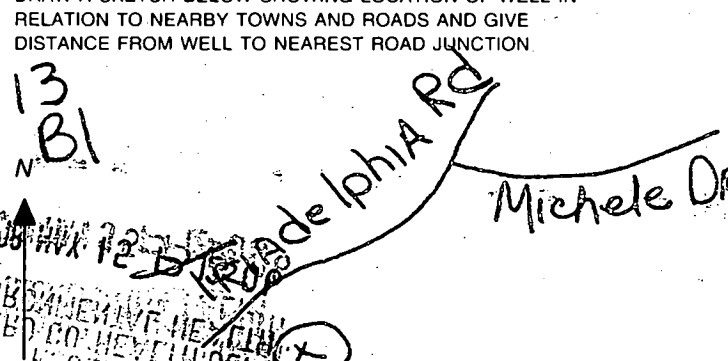B 1	0460	SEQUENCE NO. (MDE USE ONLY)	STATE OF MARYLAND PERMIT TO DRILL WELL please print or type	STATE PERMIT NUMBER <u>HO-94-1556</u> fill in this form completely
1 2 3 4 5 6 (THIS NUMBER IS TO BE PUNCHED IN COLS. 3-6 ON ALL CARDS)				
Date Received (APA) <u>5.15.98</u> 8 MM DD YY 13 Smith Mike 15 Last Name Owner First Name 34 14965 TRIADELPHIA Rd 36 Street or RFD 55 Glenelg Md 21737 57 Town 70 State 72 Zip 76		B 3 LOCATION OF WELL Howard County 8 COUNTY 21 Smith Property 23 SUBDIVISION 42 SECTION 44 46 LOT 3 48 50 Dayton 52 NEAREST TOWN 71 MILES FROM TOWN (enter 0 if in town) <u>4</u> M 73 76 77 78		
DRILLER INFORMATION David Kelly MWD 304 76 License No. 81 Jones Well Drilling Inc Firm Name 3700 Rush Rd Harrettsville 21084 Address David Kelly 5-14-98 Signature Date		B 4 1 2 DIRECTION OF WELL FROM TOWN (CIRCLE BOX)  TRIADELPHIA Rd 11 NEAR WHAT ROAD 30 ON WHICH SIDE OF ROAD (CIRCLE APPROPRIATE BOX). NORTH WEST EAST SOUTH Approx 1100 34 DISTANCE FROM ROAD 37 ENTER FT OR MI 38 39 TAX MAP: _____ BLK: _____ PARCEL: _____		
B 2 WELL INFORMATION 1 2 APPROX. PUMPING RATE (GAL. PER MIN.) <u>4</u> 8 12 AVERAGE DAILY QUANTITY NEEDED (GAL. PER DAY) <u>4000</u> 14 20		NOT TO BE FILLED IN BY DRILLER HEALTH DEPARTMENT APPROVAL Howard A589100 COUNTY NAME COUNTY NO. STATE SIGNATURE INSERT S → 41 DATE ISSUED <u>5/26/98</u> <u>5/25/99</u> 43 MM DD YY 48 CO SIGNATURE EXP. DATE NORTH GRID <u>512</u> 0 0 0 EAST GRID <u>0793</u> 0 0 0 50 55 57 63		
USE FOR WATER (CIRCLE APPROPRIATE BOX) ☒ HOME (SINGLE OR DOUBLE HOUSEHOLD UNIT ONLY) ☐ FARMING (LIVESTOCK WATERING & AGRICULTURAL IRRIGATION) 22 ☐ INDUSTRIAL, COMMERCIAL, STATE AND FEDERAL GOV. OTHER (REQUIRES APPROPRIATION PERMIT) ☐ PUBLIC OR PRIVATE WATER COMPANY (REQUIRES APPROPRIATION PERMIT AND STATE APPROVAL) ☐ TEST, OBSERVATION, MONITORING (MAY REQUIRE APPROPRIATION PERMIT)		SHOW MAJOR FEATURES OF BOX & LOCATE WELL WITH AN X SOURCES OF DRILLING WATER 1. 2. 3. WRITE THE BOX NUMBER FROM THE MAP HERE E <u>790</u> N <u>510</u> 000 000		
APPROXIMATE DEPTH OF WELL: <u>200</u> FEET 24 28 APPROXIMATE DIAMETER OF WELL <u>6</u> INCH NEAREST INCH		METHOD OF DRILLING (circle one) BORED (or Augered) ☒ JETTED ☐ Jetted & DRIVEN 30 AIR-ROTARY ☒ AIR-PERCussion ☐ ROTARY (Hydraulic Rotary) 37 CABLE ☒ REVERSE-ROTARY ☐ DRIVE-POINT other _____		
REPLACEMENT OR DEEPEINED WELLS (CIRCLE APPROPRIATE BOX) ☒ THIS WELL WILL NOT REPLACE AN EXISTING WELL ☐ THIS WELL WILL REPLACE A WELL THAT WILL BE ABANDONED AND SEALED 39 ☐ THIS WELL WILL REPLACE A WELL THAT WILL BE USED AS A STANDBY-CONTACT LOCAL APPROVING AUTHORITY FOR POLICY ON STANDBY WELLS ☐ THIS WELL WILL DEEPEN AN EXISTING WELL PERMIT NUMBER OF WELL TO BE REPLACED OR DEEPEINED (IF AVAILABLE) 41 _____ 52		DRAW A SKETCH BELOW SHOWING LOCATION OF WELL IN RELATION TO NEARBY TOWNS AND ROADS AND GIVE DISTANCE FROM WELL TO NEAREST ROAD JUNCTION 		
Not to be filled in by driller (MDE OR COUNTY USE ONLY)				
APPROP. PERMIT NUMBER _____ G A P _____ 63 FORCE <u>SS</u> WRITE INITIALS IN BOX <u>HO-94-1556</u> PERMIT NO. <u>HO-94-1556</u> 67 68 70 71 72 73 74 75 76 77 78 79				
SPECIAL CONDITIONS NOTE - APPROVING AUTHORITIES SHOULD USE SEPARATE SHEET IF NEEDED.				

CAPPS
2216/189

