

PERMIT

SEWAGE DISPOSAL SYSTEM

DEPARTMENT OF HEALTH AND MENTAL HYGIENE

P 58511

A REPAIR

DISTRICT

DATE 6-11-97

DATE SYSTEM APPROVED 6/24/97

INSPECTOR

HOWARD COUNTY HEALTH DEPARTMENT

BUREAU OF ENVIRONMENTAL HEALTH

461-9933

#341736
INDEXED

Hatfield's Equipment

IS PERMITTED TO INSTALL ☐ ALTER ☒

ADDRESS 13785 Burntwoods Road Glenelg, Maryland PHONE (301) 854-6172

SUBDIVISION LOT ROAD 13001 Triadelphia Road

PROPERTY OWNER Jessie Aplin

ADDRESS 13001 Triadelphia Road

SEPTIC TANK CAPACITY GALLONS

NUMBER OF BEDROOMS 3 ACCORDING TO NEIGHBOR - AGENT FOR OWNER

125 SQUARE FEET PER BEDROOM

LINEAR FEET OF TRENCH REQUIRED 75 MINIMUM

SEPTIC REPAIR - failing system

call for inspection when ground is opened so sanitarian can recommend repair.

INLET 3' MAX BOTTOM DEPTH 8' 5' STONE BELOW DISC.
PIPE.

PLANS APPROVED BY DATE

COVER NO WORK UNTIL INSPECTED AND APPROVED

NEITHER THE HOWARD COUNTY COUNCIL NOR THE HEALTH DEPARTMENT IS RESPONSIBLE FOR THE SUCCESSFUL OPERATION OF ANY SYSTEM

NOTE: CLEANOUT REQUIRED EVERY 70 FEET OF SEWER LINE AND/OR AT 90° SWEEPS IN LINES FROM HOUSE TO DRAIN FIELDS, 90° ELBOWS NOT ACCEPTABLE.

NOTE: ALL PARTS OF SEPTIC SYSTEMS (I.E. TANK, DISTRIBUTION BOX TRENCHES) TO BE 100 FEET FROM WELL (UNLESS OTHERWISE SPECIFICALLY AUTHORIZED)

NOTE: IF DEEP TRENCH(ES) ARE USED CALL FOR INSPECTION BEFORE AND AFTER PLACING GRAVEL IN TRENCH(ES)

NOTE: NO DRY WELL SHALL EXCEED 15 FOOT IN DIAMETER NO ABSORPTION TRENCH TO EXCEED 100 FEET IN LENGTH

NOTE: ALL PIPE FROM HOUSE TO SEPTIC TANK MUST BE CAST IRON OR SCHEDULE 35/40 PVC OR ABS

PERMIT VOID AFTER TWO YEARS

NOTE: INSTALL STAND PIPE ON SEPTIC TANK AND DRY WELL STAND PIPES MUST BE 6 INCHES IN DIAMETER CAST IRON. CONCRETE OR TERRA COTTA OR PVA OR ABS ACCEPTED. IF TOP OF SEPTIC TANK IS DEEPER THAN 3 FEET. MANHOLE TO GRADE REQUIRED.


NOTE: DISTRIBUTION BOXES MUST HAVE BAFFLES

*INSTALLER IS RESPONSIBLE FOR OBTAINING FINAL APPROVAL ON THIS PERMIT

HD-260(6-90)

*CALL 461-9933 FOR INSPECTION OF SEPTIC SYSTEM.

P 58511

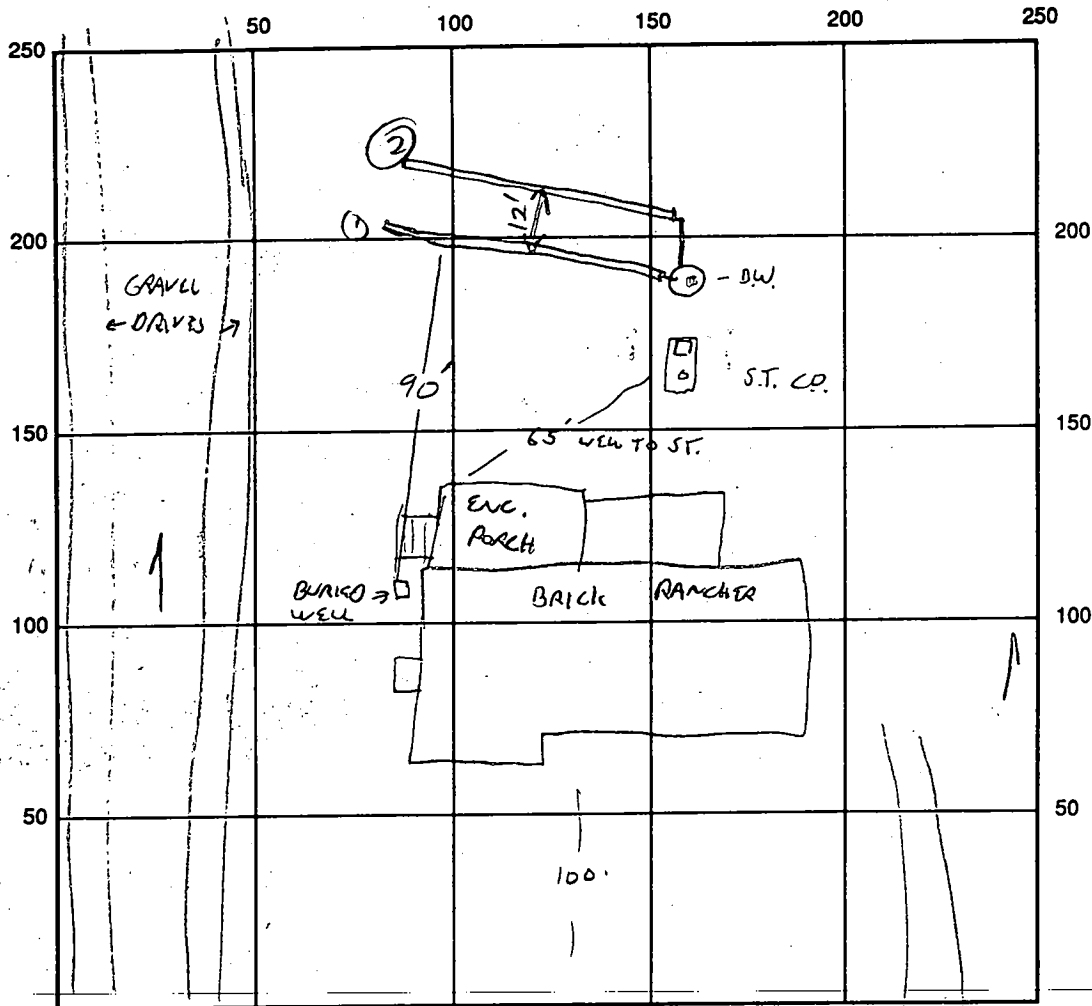

INDICATE NORTH - NAME ADJOINING ROADWAY AS BASE LINE
TRIAO MILL

SEPTIC TANK LEVEL NA 1250 gal ± existing CLEANOUTS 2 TANK, 1 4" ON DRYWELL

DISTRIBUTION BOX LEVEL NA

DRAIN FIELD/TITLE DEPTH 8 FT. TRENCH WIDTH 2 FT. INLET DEPTH 3 FT.

EFFECTIVE GRAVEL DEPTH 5 FT. TOTAL LENGTH 52/30 FT.

NUMBER OF TRENCHES 2 ~~ONE SIDEWALL~~ 500 SQ. FT.

DRYWALL INSIDE DIAMETER — FT. EFFECTIVE DEPTH BELOW INLET — FT.

ABSORBENT AREA — SQ. FT.

REMARKS: 6/23/97 OK TO STONE 1ST TRENCH, OK TO DIG
+ STONE SECOND TRENCH. LEAVE ENDS OPEN. SOIL IS SANDY/CLAY LOAM,
OK to cover when finished. RP 6/23/97

DATE SYSTEM APPROVED 6/23/97 INSPECTOR R/Kelly