

PERMIT

SEWAGE DISPOSAL SYSTEM

DEPARTMENT OF HEALTH AND MENTAL HYGIENE

05-368952

HOWARD COUNTY HEALTH DEPARTMENT

BUREAU OF ENVIRONMENTAL HEALTH

461-9933 313-2640

INDEXED

P 58965B

A REPAIR

DISTRICT

DATE 9-9-97

DATE SYSTEM APPROVED 9/11/97

INSPECTOR KM

Jack Fyock Septic Service IS PERMITTED TO INSTALL ALTER X

ADDRESS 4105 Ten Oaks Road Glenelg, MD 21737 PHONE (410) 988-9270

SUBDIVISION Linden Chapel Hills LOT 2, Sect. 1 ROAD 4940 Ten Oaks Road

PROPERTY OWNER Diane Crane

ADDRESS

SEPTIC TANK CAPACITY 1000 GALLONS

NUMBER OF BEDROOMS 3

125 SQUARE FEET PER BEDROOM

LINEAR FEET OF TRENCH REQUIRED 68

REPAIR - PURPOSE - EXISTING SEPTIC SYTEM HAS FAILED.

Call for inspection when ground is opened so sanitarian can recommend repair. 09/05/97

Drywell to be retained, two trenches to be installed with total linear feet of trench no less than 68 feet. Bottom of trench at 10', inlet at 4.5', depth of stone 5.5'

PLANS APPROVED BY Kimberly Maister DATE 9/11/97

COVER NO WORK UNTIL INSPECTED AND APPROVED

NEITHER THE HOWARD COUNTY COUNCIL NOR THE HEALTH DEPARTMENT IS RESPONSIBLE FOR THE SUCCESSFUL OPERATION OF ANY SYSTEM

NOTE: CLEANOUT REQUIRED EVERY 70 FEET OF SEWER LINE AND/OR AT 90° SWEEPS IN LINES FROM HOUSE TO DRAIN FIELDS, 90° ELBOWS NOT ACCEPTABLE.

NOTE: ALL PARTS OF SEPTIC SYSTEMS (I.E. TANK, DISTRIBUTION BOX TRENCHES) TO BE 100 FEET FROM WELL (UNLESS OTHERWISE SPECIFICALLY AUTHORIZED)

NOTE: IF DEEP TRENCH(ES) ARE USED CALL FOR INSPECTION BEFORE AND AFTER PLACING GRAVEL IN TRENCH(ES)

NOTE: NO DRY WELL SHALL EXCEED 15 FOOT IN DIAMETER NO ABSORPTION TRENCH TO EXCEED 100 FEET IN LENGTH

NOTE: ALL PIPE FROM HOUSE TO SEPTIC TANK MUST BE CAST IRON OR SCHEDULE 35/40 PVC OR ABS


PERMIT VOID AFTER TWO YEARS

NOTE: INSTALL STAND PIPE ON SEPTIC TANK AND DRY WELL STAND PIPES MUST BE 6 INCHES IN DIAMETER CAST IRON, CONCRETE OR TERRA COTTA OR PVA OR ABS ACCEPTED. IF TOP OF SEPTIC TANK IS DEEPER THAN 3 FEET. MANHOLE TO GRADE REQUIRED.

NOTE: DISTRIBUTION BOXES MUST HAVE BAFFLES

*INSTALLER IS RESPONSIBLE FOR OBTAINING FINAL APPROVAL ON THIS PERMIT

P 58965B

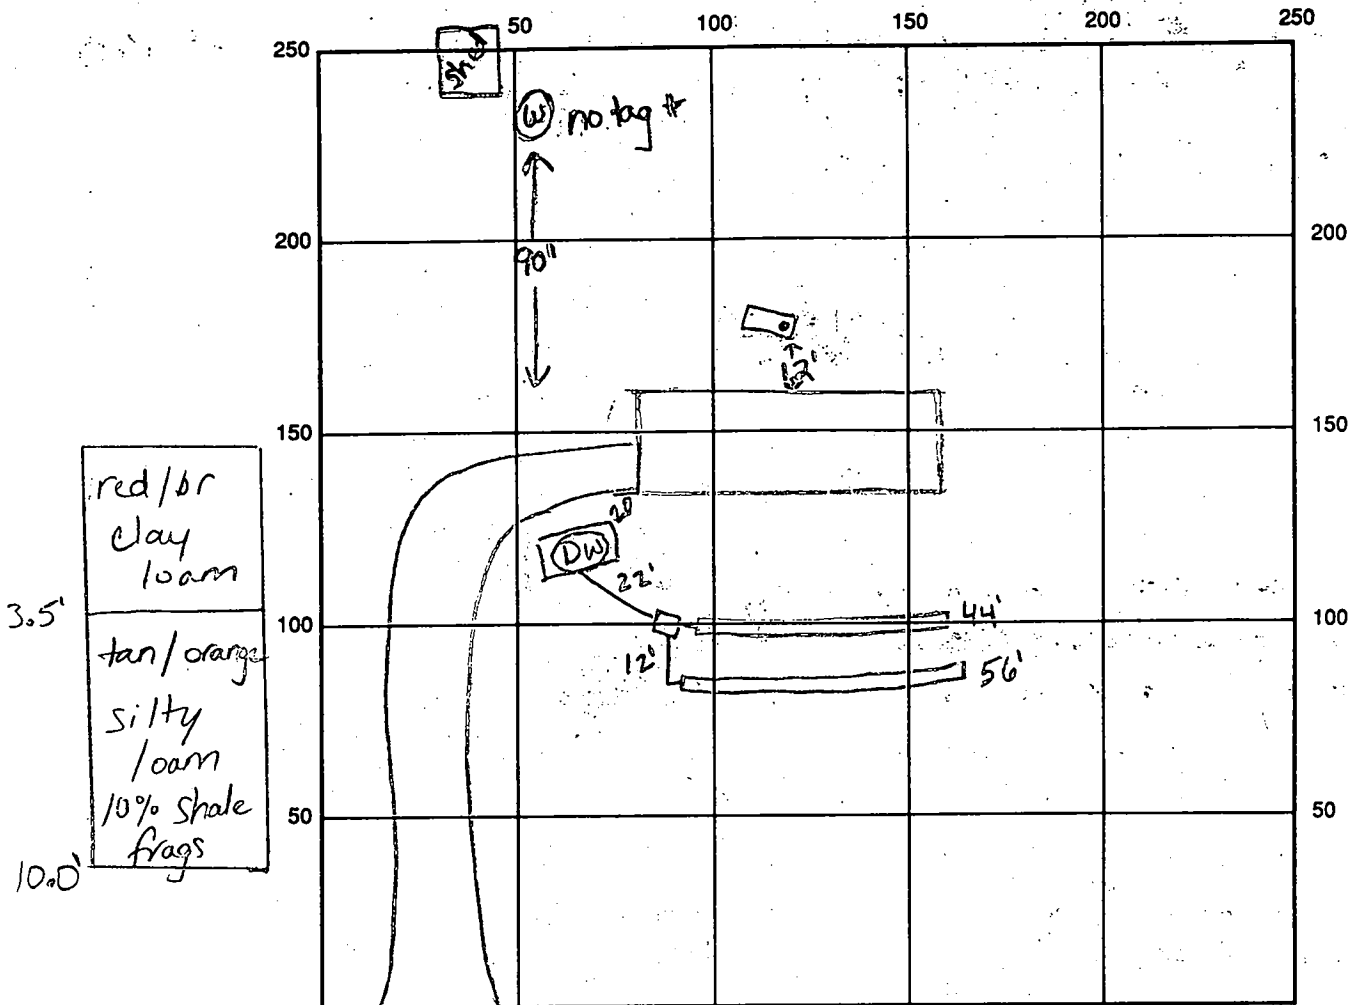

INDICATE NORTH - NAME ADJOINING ROADWAY AS BASE LINE

Ten Oaks Rd.

SEPTIC TANK LEVEL OK, 1000 gallons

CLEANOUTS 1 on drywell, 1 on tank

DISTRIBUTION BOX LEVEL OK

DRAIN FIELD/TITLE DEPTH 10.0 FT.

TRENCH WIDTH 2 FT.

INLET DEPTH 4.0 FT.

EFFECTIVE GRAVEL DEPTH 6.0 FT.

TOTAL LENGTH $\frac{1 \times 44}{1 \times 56}$ FT. $\rightarrow$ 100

NUMBER OF TRENCHES 2

ONE SIDEWALL/BOTTOM AREA 600 SQ. FT.

DRYWELL INSIDE DIAMETER _____ FT.

EFFECTIVE DEPTH BELOW INLET _____ FT.

ABSORBENT AREA _____ SQ. FT.

REMARKS: 9/11/97 (am) OK to continue, drywell has been pumped and will remain in use, property is used as Eldercare facility with 4 or 5 residents (KM)
9/11/97 (pm) tank has also been pumped, OK to stone last trench and cover all work (KM)
Soil information from previous perc notes (KM)

DATE SYSTEM APPROVED 9/11/97

INSPECTOR

Kimberley Maisto

INDEXED

PERMIT

SEWAGE DISPOSAL SYSTEM

MARYLAND STATE DEPARTMENT OF HEALTH

HOWARD COUNTY

ELLICOTT CITY

DISTRICT 8

DATE 12/18/70

Jack Fyock

IS PERMITTED TO INSTALL ☒ ALTER ☐

ADDRESS Tan Oak Road, Glenais, Maryland

PHONE 292-1929

A SEWAGE DISPOSAL SYSTEM LOCATED AT

SUBDIVISION Linden Chapel Hills

ROAD Tan Oak

LOT 2, Blk. A, Sec. 1

PROPERTY OWNER

John Sealey or Dine Crane

ADDRESS

SPECIFICATIONS - 3 bedrooms

DRAIN FIELD DEPTH FEET, BOTTOM AREA SQ. FT.

SEEPAGE PITS ABSORBENT SIDE-WALL AREA SQ. FT.

SEPTIC TANK CAPACITY 1,000 GALLONS

FOR GARBAGE GRINDER, INCREASE DISPOSAL AREA 25% & TANK CAPACITY 50%

OTHER Dry wall to be 100 sq. ft. of sheet piling area below the inlet pipe per bedroom. Inlet pipe to begin 4 ft. below original grade. Maximum depth of dry wall to be 11 ft. below original grade. Locate dry wall 10 ft. from front property line and 23 ft. from left side line as lot is seen standing on Tan Oak Rd., facing lot.

NOTE: NO BASEMENT FIXTURES. ALL PIPE FROM HOUSE TO SEPTIC TANK MUST BE CAST IRON.

PLANS APPROVED BY James T. Wright

DATE 11/18/70

NOTE: PERMIT VOID AFTER THREE YEARS.

FILL SEPTIC TANK AND DISTRIBUTION BOX WITH WATER BEFORE CALLING FOR AN INSPECTION. COVER NO WORK UNTIL INSPECTED AND APPROVED.

NOTE: INSTALL STAND PIPE ON SEPTIC TANK AND DRY WELL.

NEITHER THE HOWARD COUNTY COMMISSIONERS NOR THE HEALTH DEPARTMENT IS RESPONSIBLE FOR THE SUCCESSFUL OPERATION OF ANY SYSTEM.

15430

INDEXED

PERMIT

15250

15250

BLISS CITY

BLISS CITY

15250

15250

INDICATE NORTH - NAME ADJOINING ROADWAY AS BASE LINE

Tan Oak Rd

PERMIT CARD

SEPTIC TANK, LEVEL

DISTRIBUTION BOX, LEVEL

TILE FIELD, DEPTH

GRAVEL, DEPTH

NUMBER OF TRENCHES

FREEPAGE PITS, INCHES

ABSORBENT AREA

REMARKS

NOTE: PERMIT VOID AFTER THREE YEARS

NOTE: PERMIT VOID AFTER THREE YEARS

DATE SYSTEM APPROVED 11-17-71

INSPECTOR

[Signature]

APPLICATION

SEWAGE DISPOSAL TESTING

MARYLAND STATE DEPARTMENT OF HEALTH

HOWARD COUNTY *Septic tank to be 1000 gal*

ELLICOTT CITY

DISTRICT 1

DATE 11/18/70

*Dry well to be 100 sq ft of absorbent material
Area follows the inlet pipe per bed room, closet
to porch - 4 1/2 ft follow original. 11/10 ft from
the 13 ft follow original grade. Locate dry well 106 ft from
front property line and 23 ft from left side line as lot is
now standing on the corner facing lot*

TO: THE COUNTY HEALTH OFFICER
ELLICOTT CITY, MARYLAND

I, HEREBY, APPLY FOR THE NECESSARY TESTS IN ORDER TO CONSTRUCT OR RECONSTRUCT A SEWAGE DISPOSAL SYSTEM.

PROPERTY OWNER Ashton Realty Co.

ADDRESS Ashton, Maryland

PHONE 924-4811

PROPERTY LOCATION:

SUBDIVISION Linden Chapel Woods Hills

LOT NO. 2A SECT 1

ROAD AND DESCRIPTION THE CORNER

OCCUPANT

PERSON TO CONSTRUCT SYSTEM

ADDRESS

SIZE OF LOT 32,500 sq. ft.

TYPE BLDG. 1

NUMBER OF BEDROOMS

IF NOT SINGLE RESIDENCE DESCRIBE

SIGNATURE OF APPLICANT /s/ Robert Johnson

APPROVED BY James T. Wright FOR Dry well DATE 11/18/70

REJECTED BY _____ FOR _____ DATE _____

HOLD PENDING FURTHER TESTS _____ DATE _____

REASONS FOR REJECTION OR HOLDING _____

THIS IS NOT A PERMIT

2 in
AV
and
4 ft

C1		7804		SEQUENCE NO. (DENV USE ONLY)		STATE OF MARYLAND WELL COMPLETION REPORT FILL IN THIS FORM COMPLETELY PLEASE PRINT OR TYPE						THIS REPORT MUST BE SUBMITTED WITHIN 45 DAYS AFTER WELL IS COMPLETED.					
1 2 3 938																	