

04-339592

PERMIT

SEWAGE DISPOSAL SYSTEM

DEPARTMENT OF HEALTH AND MENTAL HYGIENE

HOWARD COUNTY HEALTH DEPARTMENT
BUREAU OF ENVIRONMENTAL HEALTH

~~XXXXXXXXXX~~ 410-313-2640

PAID BY CHECK FROM VAN OSTEROM'S
363, \$25.00
88

P 59802

A REPAIR

DISTRICT 4th

DATE 2/2/98

DATE SYSTEM APPROVED 2/2/98

INSPECTOR 88

INDEXED

Paul Diamond

IS PERMITTED TO INSTALL _____ ALTER X

ADDRESS _____ PHONE 442-5774

SUBDIVISION _____ LOT _____ ROAD 2970 Woodbine Road

PROPERTY OWNER George W. VanOsterom

ADDRESS 2970 Woodbine Road

Woodbine, Maryland 21797

SEPTIC TANK CAPACITY 1250 GALLONS

NUMBER OF BEDROOMS 4?

EXISTING SEPTIC TANK TO BE REPLACED WITH
LARGER (1250 GAL) ONE, LOCATION TO BE
AT LEAST 10' FROM PROPOSED ADDITION.

_____ SQUARE FEET PER BEDROOM

LINEAR FEET OF TRENCH REQUIRED _____

REPAIR - PURPOSE - IN SUPPORT OF BUILDING PERMIT APPLICATION No. B00109536. (Replace Tank)

Call for inspection when tank is in place so that a sanitarian can approve the size and location. 01/30/98

BLDG. PERMIT SIGNED

AND RETURNED 2-2-98

Serial # B00109536
1-Story addition

PLANS APPROVED BY Glen Savage DATE 01/30/98

COVER NO WORK UNTIL INSPECTED AND APPROVED

NEITHER THE HOWARD COUNTY COUNCIL NOR THE HEALTH DEPARTMENT IS RESPONSIBLE FOR THE SUCCESSFUL OPERATION OF ANY SYSTEM

NOTE: CLEANOUT REQUIRED EVERY 70 FEET OF SEWER LINE AND/OR AT 90° SWEEPS IN LINES FROM HOUSE TO DRAIN FIELDS, 90° ELBOWS NOT ACCEPTABLE.

NOTE: ALL PARTS OF SEPTIC SYSTEMS (I.E. TANK, DISTRIBUTION BOX TRENCHES) TO BE 100 FEET FROM WELL (UNLESS OTHERWISE SPECIFICALLY AUTHORIZED)

NOTE: IF DEEP TRENCH(ES) ARE USED CALL FOR INSPECTION BEFORE AND AFTER PLACING GRAVEL IN TRENCH(ES)

NOTE: NO DRY WELL SHALL EXCEED 15 FOOT IN DIAMETER NO ABSORPTION TRENCH TO EXCEED 100 FEET IN LENGTH

NOTE: ALL PIPE FROM HOUSE TO SEPTIC TANK MUST BE CAST IRON OR SCHEDULE 35/40 PVC OR ABS

PERMIT VOID AFTER TWO YEARS


NOTE: INSTALL STAND PIPE ON SEPTIC TANK AND DRY WELL STAND PIPES MUST BE 6 INCHES IN DIAMETER CAST IRON. CONCRETE OR TERRA COTTA OR PVA OR ABS ACCEPTED. IF TOP OF SEPTIC TANK IS DEEPER THAN 3 FEET. MANHOLE TO GRADE REQUIRED.

NOTE: DISTRIBUTION BOXES MUST HAVE BAFFLES

***INSTALLER IS RESPONSIBLE FOR OBTAINING FINAL APPROVAL ON THIS PERMIT**

*CALL 461-9933 FOR INSPECTION OF SEPTIC SYSTEM.

R59802

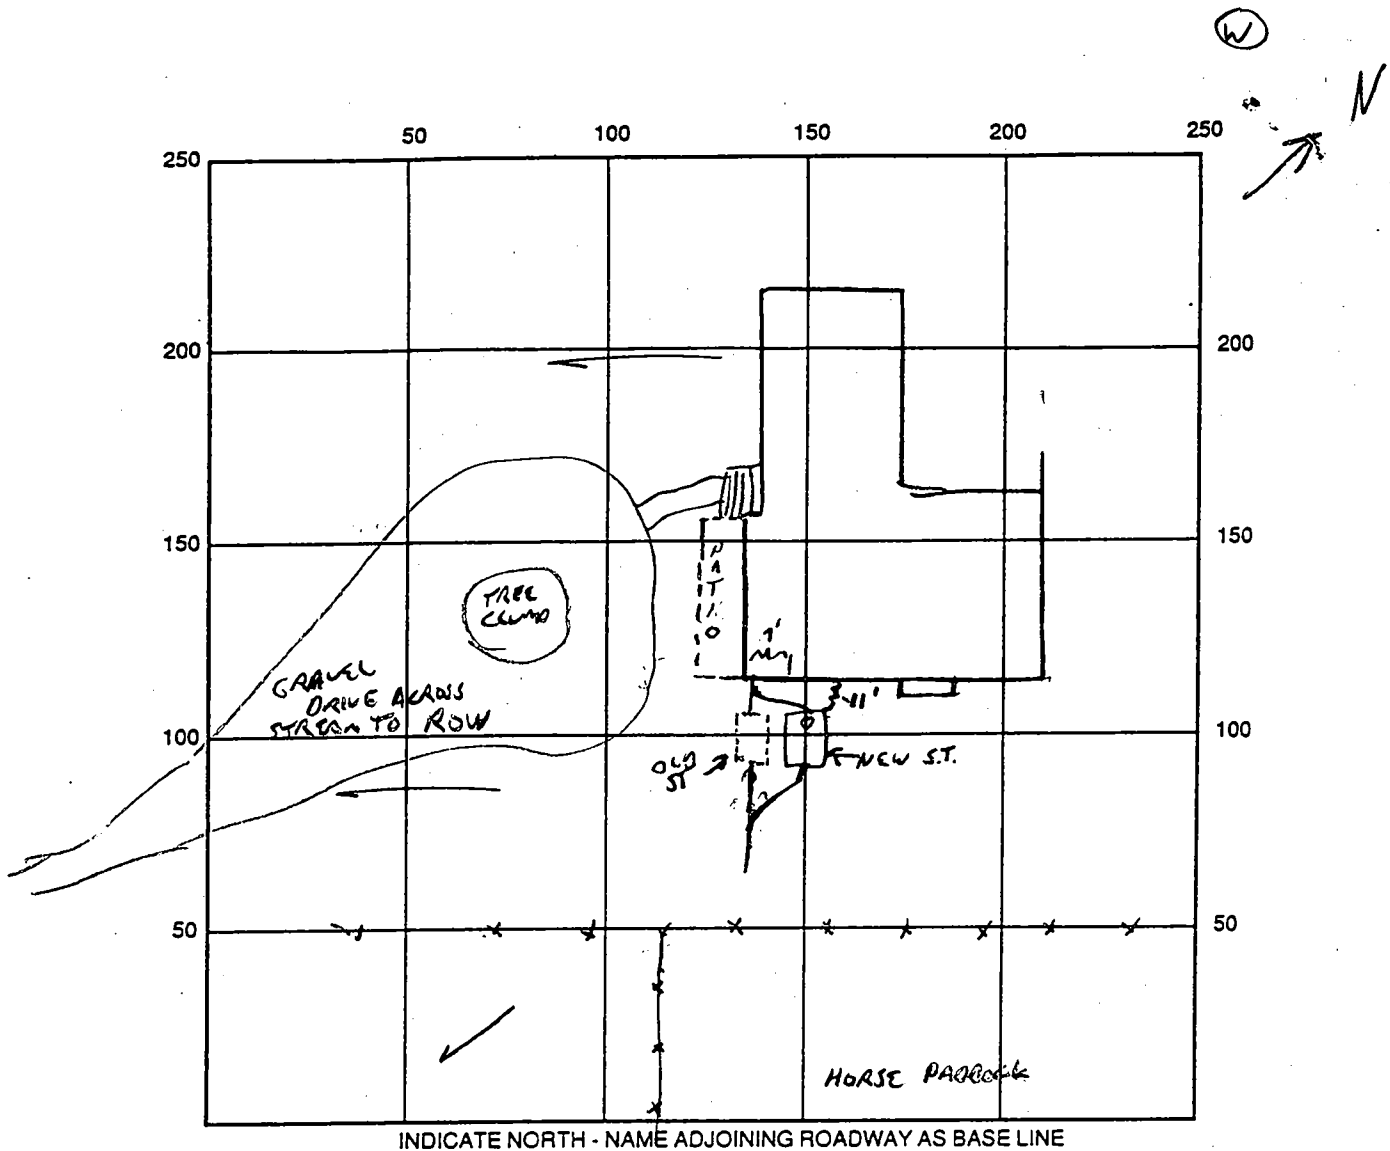

INDICATE NORTH - NAME ADJOINING ROADWAY AS BASE LINE

SEPTIC TANK LEVEL ok CLEANOUTS _____

DISTRIBUTION BOX LEVEL _____

DRAIN FIELD/TITLE DEPTH _____ FT. TRENCH WIDTH _____ FT. INLET DEPTH _____ FT.

EFFECTIVE GRAVEL DEPTH _____ FT. TOTAL LENGTH _____ FT.

NUMBER OF TRENCHES _____ ONE SIDEWALL/BOTTOM AREA _____ SQ. FT.

DRYWALL INSIDE DIAMETER _____ FT. EFFECTIVE DEPTH BELOW INLET _____ FT.


ABSORBENT AREA _____ SQ. FT.

REMARKS: 2/2/98 TANK LINES CAST IRON, CUT + SLEVED TO PVC, EX. ST
RUMPED TO BE COLLAPSED, WAS 1000 GALLONS, GUTTER DRAIN/CINET
CROSS TANK TO BE RE-CONNECTED TO MINIMIZE WATER ENTRY TO TANK.
APPLICANT IS ADVISED TO REPLACE OUTLET LINE FROM S.T. TO A POINT WHERE
LINE IS IN GOOD CONDITION AND IS ACCESSIBLE FOR REPAIRS.
OK TO COVER AS WORK IS COMPLETED.

DATE SYSTEM APPROVED 2/2/98 INSPECTOR [Signature]

Property known as: 5.01 ac. #2970 ROUTE 94
 4th Election District
 HOWARD COUNTY MARYLAND
 WOODBINE
 LIBER 1611 FOLIO 542

COMMUNITY PANEL NO.
 2400440013 B
 ZONE "C"

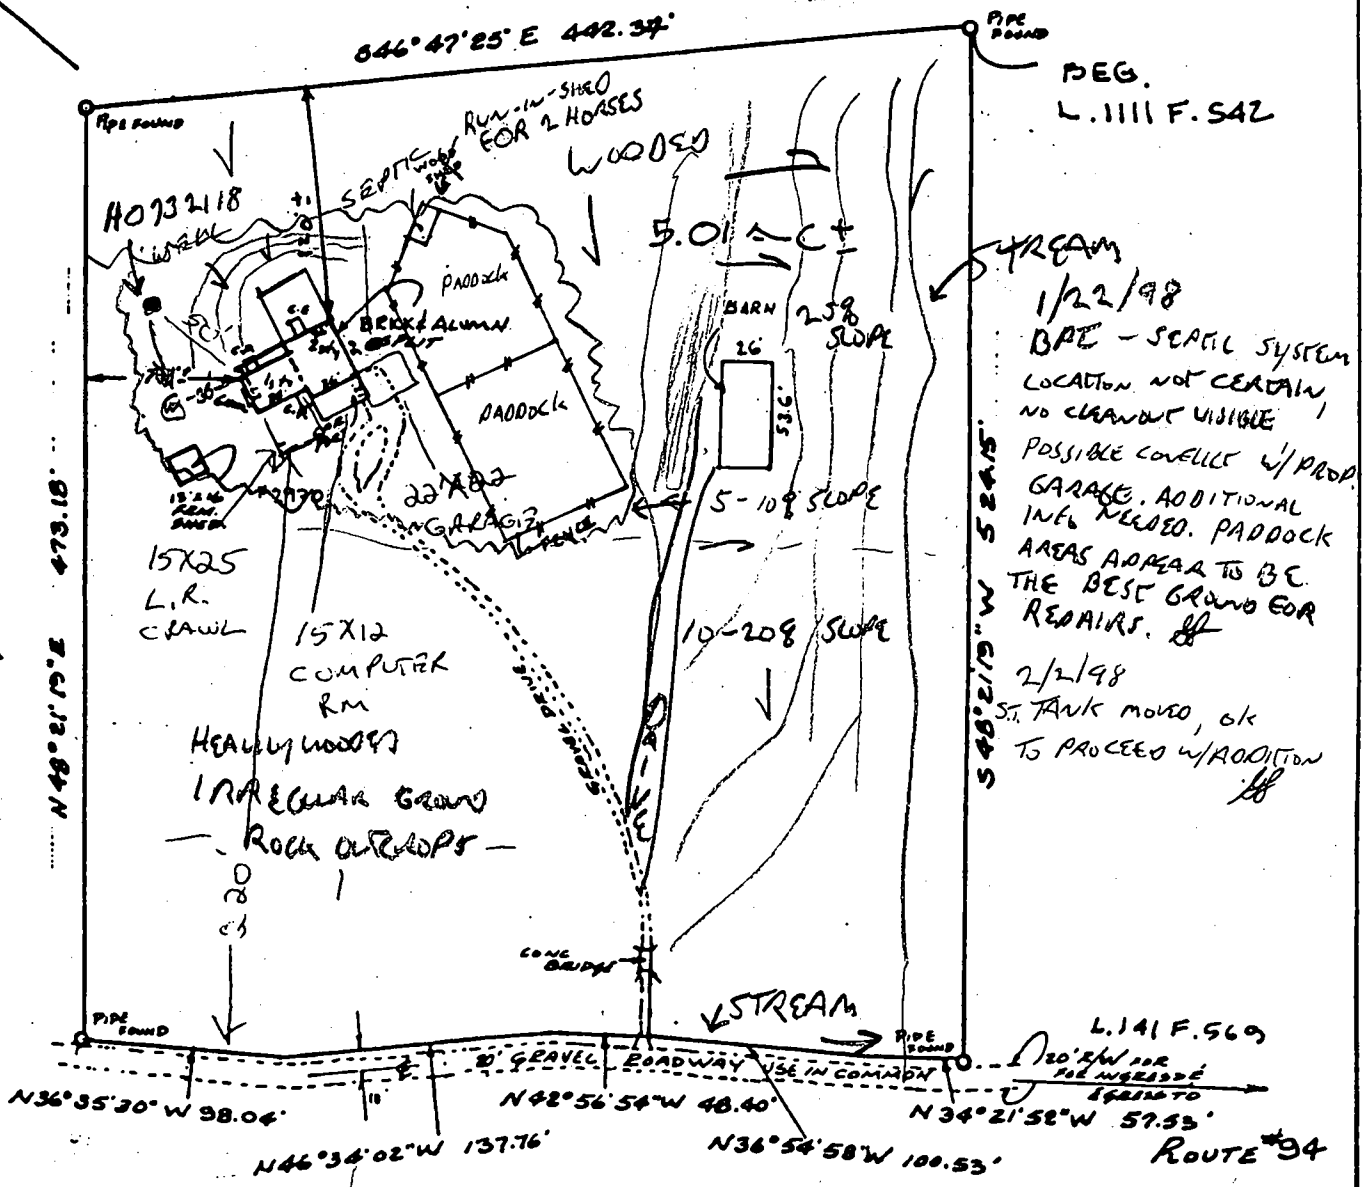

I HEREBY CERTIFY THAT THE LOT SHOWN HEREON HAS BEEN SURVEYED FOR THE PURPOSE OF LOCATING ALL IMPROVEMENTS AND THAT ALL SUCH IMPROVEMENTS ARE LOCATED AS SHOWN

M.H. DEVELOPMENT ENGINEERS, INC.

DRAWN	SURVEYED	CHECKED	SCALE	DATE
W.P.	I.B.	V.T.M.	1"=100'	1/23/90

200 East Joppo Road
 Room 101, Shell Building

1/21/98 SITE INSPECTION

APPLICATION

HOWARD COUNTY

PERMIT APPLICATION

DEPARTMENT OF INSPECTIONS, LICENSES & PERMIT
3430 COURT HOUSE DRIVE, ELLICOTT CITY, MARYLAND 21043

SERIAL NUMBER

B0009536

BUILDING ADDRESS (HOUSE NO., STREET, TOWN OR AREA)

2970 RT94 (WOODBINE RD)

WOODBINE Md. 21797

LOT NO.	PARCEL NO.	SEC.	AREA	BLOCK NO.	LIBER	FOLIO
N/A	14	11A	11A	7	1111	542
SUB DIVISION		ZONE	ZONE MAP	ELEC. DIST.	CENSUS TR.	
N/A		RC-1	13	4TH	6040	

OWNER NAME AND ADDRESS

GERGE W. VAN OSTEROM
P.O. BOX 77 WOODBINE MD. 21797

PHONE NO.

410489
5387
PAGE 2
21797 2100788

OCCUPANT'S NAME AND ADDRESS

SAME

PHONE NO.

ARCHITECT OR ENGINEER'S NAME AND ADDRESS

PHONE NO.

CONTRACTOR'S NAME AND ADDRESS

OWNER

PHONE NO.

EXISTING USE

SINGLE FAMILY
RESIDENTIAL

PROPOSED USE

SAME w/ ADDITION

EST. CONSTRUCTION COST

183000

LICENSE NUMBER

PERMIT FEE

W/S CODE

FOR OFFICE USE ONLY

DISTANCE IN FEET FROM RW LINE TO FRONT BUILDING LINE

SIDE YARD

(DISTANCE IN FEET FROM SIDE BLDG. LINE TO SIDE PROPERTY LINE)

TO SIDE BUILDING LINE

DISTANCE IN FEET, REAR YD. REQUIRING SET

BACK

(CORNER LOT ONLY)

SDP #

Check payable to: DIRECTOR OF FINANCE OF HOWARD COUNTY

CAUTION

To begin construction before a permit placard has been issued and displayed on the job is a violation of the law.

Use and occupancy permit must be applied for two weeks before it will be issued.

IMPORTANT: PLEASE SHOW ZIP CODES AND AREA CODES WHEREVER REQUIRED.

LP-69-591

GRADING/SEDIMENT CONTROL YES NO

SDP #

DESCRIPTION OF WORK AUTHORIZED

24x15
1 STORY ON CRAWL (LIVING RM EXT)
1 COMPUTER RM SLAB
1 GARAGE (2 CAR ATTACHED)
SLAB 22x22

SIZE OF BLDG.	FRONT	DEPTH	HEIGHT
ALL ON FRONT	OF HOUSE		

TYPE OF BLDG.	AREA	VOLUME	ROOF
B. ROOMS			
ROOMS			
BATHS			
FIREPLACES			

FOOTINGS	FOUNDATION	S. WALLS

UTILITIES				
WATER/WELL	SEWER/SEPTIC	GAS	ELECTRICITY	TYPE OF HEAT
				AC
				HP

I have carefully examined and read this application and know the same is true and correct, and that is doing this work, all provisions of Howard County Ordinances and the State Laws of Maryland will be complied with, whether specified or not; and I will notify the Department of Inspections, and Permits twenty-four hours in advance when I am ready for the inspections called for elsewhere in the application; and that no work will be covered up until such inspections have been completed with.

George W. Van Osterom
OWNER
SIGNATURE
1-16-98
DATE

FUNCTION	DATE	SIGNATURE APPROVAL
ZONING/PLANNING		
SHA		
SEDIMENT/GRADING		
BUILDING OFFICIAL		
WATER & SEWER		
HEALTH DEPT.	2/2/98	[Signature]
FIRE PROTECTION		
STORM WATER MGM.		

APPROVED

DATE

Distribution of Copies:
White - Building Official
Green - Planning & Zoning

Yellow - Engineering
Pink - Health Dept.
Gold - S.H.A.

A C