		CTATE DEDINET NUMBER			
B 1 SETE SEQUENCE NO. (MDE USE ONLY)	STATE OF MARYLAND	STATE PERMIT NUMBER			
1 2 3 6	PERMIT TO DRILL WELL	HO-94-1530			
(THIS NUMBER IS TO BE PUNCHED IN COLS. 3-6 ON ALL CARDS)	please print or type	<sup>70</sup> fill in this form completely <sup>79</sup>			
Date Received (APA)	INDENED3 4/	LOCATION OF WELL			
8 MM DD YY (13	ATION INDLACED AGENTY	raid 21			
Contra	Carrol				
15 Last Name Owner F	First Name 34 23 SUBDIVISIO	42			
14035 Privadelphia m	iel Rd. SECTION	гот [			
36 Street or RFD	55 44	46 48 50			
Laylon mo.	210.36	auton			
57 Town 70 State 72  DRILLER INFORMATION	Zip 76 52 NEAREST 1	52 NEAREST TOWN 71			
1	X	MILES FROM TOWN (enter 0 if in town)   M_			
Differ's Name 76	License No. 81 B 4	14035			
Describe L. Mayor Dell &	Direction of Well FR				
Fifty Name	TOWN (CIRCLE BOX)	11 NEAR WHAT ROAD 30			
5512 Radge Rd. Mrt. ain	21771 N N	ON WHICH SIDE OF ROAD NORTH			
Address	N 8 N 8-9 8-9 8-9 8-9	CIRCLE APPROPRIATE BOX)			
Signature 4	Date W TOWN	west			
B 2 WELL INFORMATION	5- 8	8 DISTANCE FROM ROAD			
1 2 APPROX. PUMPING RATE (GAL. PER MIN.) 8	12   [5]	$\frac{27}{2}$ ENTER FT OR MI $\frac{1}{38}$ $\frac{1}{39}$			
AVERAGE DAILY QUANTITY NEEDED		TAX MAP: 28 BLK: PARCEL 26			
(GAL. PER DAY) 14	20				
USE FOR WATER (CIRCLE APPRO		OT TO BE FILLED IN BY DRILLER : EALTH DEPARTMENT APPROVAL			
		13			
F FARMING (LIVESTOCK WATERING & AGRICUL	COUNTY NAME	COUNTY NO.			
22. INDUSTRIAL, COMMERCIAL, STATE AND FEDE		INSERT S			
,,	DATE ISSUED	DATE ISSUED			
P PUBLIC OR PRIVATE WATER COMPANY (REQU APPROPRIATION PERMIT AND STATE APPROV	UIRES	43 MM DD VY 48 CO SIGNATURE EXP. DATE			
TEST, OBSERVATION, MONITORING (MAY REC	QUIRE NORTH 50	NORTH EAST 190			
APPROPRIATION PERMIT)	50 SAID 50	55 57 63			
	SHOW MAJOR FE	ATURES OF 8.30 Grout -4-30-98			
APPROXIMATE DEPTH OF WELL 24	BOX & LOCATE W	LLING WATER Miller land to 20 Rd			
ADDROVINATE DIAMETER OF WELL	NEAREST SOURCES OF DRI	LLING WATER From Carres A			
APPROXIMATE DIAMETER OF WELL	INCH 1. Well 2.	2 growth but folking ox			
METHOD OF DRILLING (cir.	cle one) 3.	AN 4/20/901			
BORED (or Augered)  JETTED	Jetted & <u>DRIVEN</u>	465 day 25 gpm x			
27	TARY (Hydraulic Rotary) WRITE THE BOX I				
CABLE HEVerse-HOTary	DRIVE-POINT FROM THE MAP H	1			
other	E 79	22-134-9/20			
REPLACEMENT OR DEEPENE (CIRCLE APPROPRIATE BO	)X)	000 77 97 0			
THIS WELL WILL NOT REPLACE AN EXISTING	WELL N .50	<b>\$</b>			
THIS WELL WILL REPLACE A WELL THAT WILL ABANDONED AND SEALED		BELOW SHOWING LOCATION OF WELL IN ARBY TOWNS AND ROADS AND GIVE			
THIS WELL WILL REPLACE A WELL THAT WILL	L BE USED . DISTANCE FROM	WELL TO NEAREST ROAD JUNCTION			
39 AS A STANDBY-CONTACT LOCAL APPROVING FOR POLICY ON STANDBY WELLS	AUTHORITY	ak			
D THIS WELL WILL DEEPEN AN EXISTING WELL		A Surger land			
PERMIT NUMBER OF WELL TO BE REPLACED OR DI (IF AVAILABLE) 41	N/	i vajiti			
	52	X			
Not to be filled in by driller (MDE OR COU	NTY USE ONLY)	of the			
APPROP. PERMIT. NUMBER G A		Marie Dice R.			
WRITE 54	63	hill Rd.			
FORCE 67 68 IN BOX PERMIT No. 77. 0 - 7	7 <i>9 - 1 3 3 6</i> 3 74 75 76 77 78 79	well !			
SPECIAL CONDITIONS		<b>⊗</b>			

COUNTY

WELL COMPLETION REPORT 45 DAYS AFTER W	VELL IS COMPLETED.		
(THIS NOMBER IS TO BE PUNCHED PLEASE PRINT OR TYPE NUMBER	COUNTY /3		
ST/CO LISE ON ALL CARDS)  ST/CO LISE ON ALL CARDS	PERMIT NO.  OM "PERMIT TO DRILL WELL"  - 14 - 153		
8 - 13 T5 20 (TO NEAREST FOOT) 28 2	29 30 31 32 33 34 35 36 37		
OWNER CARROL STREET OR RFD IASI NAME / 4035 TRIADILIDIA MILLIFIST NAME TOWN DAY TON	· · · · · · · · · · · · · · · · · · ·		
	3		
WELL LOG  Not required for driven wells  WELL HAS BEEN GROUTED (Circle Appropriate Box)  Output  Outpu	IMPING TEST		
STATE THE KIND OF FORMATIONS PENETRATED, THEIR COLOR, DEPTH, THICKNESS AND IF WATER BEARING  TYPE OF GROUTING MATERIAL (Circle one)  HOURS PLIMPED (n			
DESCRIPTION (Use addulional sheets if needed)  DESCRIPTION (Use addulional sheets if needed)  TO bearing  NO. OF BAGS  NO. OF POUNDS  DESCRIPTION (Use addulional sheets if needed)  NO. OF BAGS  PUMPING RATE (gallow)	al. per min.)		
GASING RECORD  GALLONS OF WATER 132  METHOD USED TO MEASURE PUMPING  WATER LEVEL (distance)  BEFORE PUMPING	$\Omega_{AA}$		
Gray Mica. $59 \# 50 $ from $\frac{0}{48 \text{ TOP } 52}$ ft. to $\frac{60}{54 \text{ BOTTOM } 58}$ ft. WATER LEVEL (distance)	tance from land surface)		
casing Odding Record	5 / ft.		
insert appropriate STEEL CONCRETE WHEN PUMPING	3.80 ft.		
below PLASTIC OTHER TYPE OF PUMP USE	ED (for test)  P piston T turbine		
MAIN Nominal diameter Total depth CASING top (main) casing of main casing TYPE (nearest inch)! (nearest foot)  C centrifugal	R rotary O other (describe		
$ \begin{array}{c ccccccccccccccccccccccccccccccccccc$	27 below) S submersible		
E OTHER CASING (if used) A diameter depth (feet) C inch from to	27		
	AP-INSTALLED ALL PUMP YES (NO)		
	LS PUMP, THIS SECTION FED FOR ALL WELLS.		
screen type or open hole or open hole insert STEEL BRASS OPEN TYPE OF PUMP INSTRUCTION OF THE PLACE (A,C,J,P,R,S, IN BOX 29.	TALLED		
appropriate code below BRONZE HOLE GALLONS PER MI (to nearest gallon)			
PLASTIC OTHER PUMP HORSE PO	OWER 37 41		
NUMBER OF UNSUCCESSFUL WELLS:  DEPTH (nearest ft.)  PUMP COLUMN L (nearest ft.)	<u> </u>		
100 600	(circle appropriate box and enter casing height)		
CIRCLE APPROPRIATE LETTER A WELL WAS ABANDONED AND SEALED WHEN THIS WELL WAS COMPLETED  A WELL WAS COMPLETED  B 23 24 26 30 32 36 S C 3	LAND SURFACE (nearest)		
E ELECTRIC LOG OBTAINED  R 38 39 41 45 47 51 49  TEST WELL CONVERTED TO PRODUCTION	N OF WELL ON LOT		
I HEREBY CERTIFY THAT THIS WELL HAS BEEN CONSTRUCTED IN ACCORDANCE WITH COMAR 26 04.04 "WELL CONSTRUCTION" AND IN CONFORMANCE WITH ALL CONDITIONS STATED IN THE ABOVE OF SCREEN INCH.	NENT STRUCTURE SUCH AS PTIC TANKS, AND /OR AND INDICATE NOT LESS		
HEREIN IS ACCURATE AND COMPLETE TO THE BEST OF MY 56 60 THAN TWO DIS			
DRILLERS LIC. NO. 1 M S D O 2 4 1  GRAVEL PACK  IF WELL DRILLED  WAS FLOWING WELL  W	16 3		
ORILLERS SIGNATURE (MUST MATCH SIGNATURE ON APPLICATION)  MDE USE ONLY (NOT TO RE-EILLED IN BY DRILLER)	M. /5 3		
COTIL MAND 27, TO BELLEN, JOHN OF THE MANDER OF THE PROPERTY O	3		
SITE SUPERVISOR (sign. of driller or journeyman 72			
CASING INDICATOR OTHER DATA	<i>I</i> }		

ROUGH DRAFT SENT, AGAO AND AGRESO ON 4-23-98

BY BOTH CAROL+GARY CORTES,
TANK REMOVER PERESRMED 4-24-98

. SUPERUSSO BY BERT NIXON, HE REPORTED THAT THERE WAS NO EULIDENCE OF CEARAGE IN SOLLS

AROUND PONKS, NO NEED FOR LOC SOMAING

OK QUENTO TEE MAYNE 4-24

Glen. Jop margin

## HOWARD COUNTY HEALTH DEPARTMENT

Joyce M. Boyd, M.D., County Health Officer

Carrol Coates 14035 Triadelphia Mill Road Dayton, Maryland 21036

RE:

Replacement Well at the Above

Referenced Property

Dear Ms. Coates:

The Howard County Health Department will grant permission to drill a replacement well at the above referenced property subject to the following conditions:

The homeowner provides a signed agreement that as a condition of approval of the proposed well site, approximately 30° from two buried fuel tanks and that both tanks shall be removed in an expeditious manner, within two weeks of completion of the replacement well. The homeowner is to knowledge awareness of the risk of contamination of the well from the fuel tanks and the willingness to assume responsibility for remedial processors, including installation of an appropriate water treatment device, should contamination be detected.

Upon completion of the new well, the homeowner shall make arrangements with this office for V.O.C. (Volatile Organic Compound's) sampling.

Siting of the replacement well at least 100° away from the existing fuel tanks will be acceptable without the agreement previously described. However, the Health Department strongly recommends removal of both fuel tanks, in an expeditious manner, since they represent a potential source of contamination to the groundwater.

Sincerely,

Glen Savage, R.S. Water and Sewerage Program

Joe Mayne Jack Fyock File

FROM 1 808 1 DWER SCHOOL PROPERTY IN

8472375U

PHONE NO. : 410 531 0323

3 Apr. 23 1998 10:02AM P2 <u>Apr. 23 98 8:26 No.002 7.02</u>

PORN'FER INE 7871 PAIG -23 M ROBER 2

CAPAC CONTRA CONTRA CONTRAC SAURGE

CONTRAC CONT

DRAGT

CAROL COUTES
14035 TRIADELPHIA ALL ROAD KARINGUOD GOTS

RE REMARKANT WALL AT THE MOOR RECENERICES

VEAR AS COATES, MR. COATES

THE HOWARD COUNTY HEALTH DEPT WILL GRANT DEATH WELL AT THE DEATH WELL AT THE ABOVE REFERENCES PROPERTY SUBJECT TO THE GOLDWING CONDITIONS:

THE ACKE OWNER FROMORY A STENEOU ARRECAENT The As A Conomian of Approved of the Apposed wells APPRIO MATEY SME , 30' FROM The RENDED FUEL TAINKS, THEN WITHIN TORYS AN APPLICATION IS FIRED FOR ALMOMEL THE EVEL TANKS AND THAT BOTH Cont THINKS SHALL BE REMIND IN AN EXPLOITERS MANNER - WITHIN TWO WEEKS OF COMESTION OF THE REPRESENT WELL. THE ACREOWER IS to Achoreste Awareness of the Risk CONTRACTION OF THE WALL FROM THE FUEL TANKS AND THE WILLMANSS TO ABOTHE PETPONSONO THE MARRIED ARCHITICAL , WOLLDWIS WERRING OF AN ARRIVANAIL WATER TREATMENT TRUICE, 540019 EUT PANNATIN BE DETECTED. coase convertion of the new well, The home owner steel make steel coming with the office

FOR MUE. HOWARE ORGANIC COMPERANTS & SAMPLING.

923

COATES

FROY : ALL LONES SCHOOL....

SITING BE THE REMAREMENT WELL AT GRAST 100 Amony FROM THE EXISTING GUIL THINKS WILL BE ACCOMPOSE WITHOUT THE MERCHANT PRINTERS WEST RIBBO. HOWEVER, THE HEAVEN ORTH STRONGLY RECOGNISMS. RECOGNISMS REPORTED REPORTED THE HEAVEN OF BOTH THE TONKS, IN HAVE EXPLICITLY A BOTENTIAL SOURCE OF CONTINUATION.

HE OFFITTAL SOURCE OF CONTINUATION.

STUCKALY

SHA SOLF

GERS SHARE, RS.

WITTE THE STURMENT COMPA

ec. Jee Myve Jiek Cyck Filt

Relived + alliantedge 423-98 MM Gartes

G.H. COMES

MARYLAND DEPARTMENT OF THE ENVIRONMENT, WATER MANAGEMENT ADMINISTRATION 2500 BROENING HIGHWAY, BALTIMORE, MARYLAND 21224, (410) 631-3784 WATER WELL ABANDONMENT-SEALING REPORT FORM SUBMIT COPIES OF COMPLETED FORM TO: COUNTY ENVIRONMENT AGENCY (contact MDE, WMA if address needed) WELL OWNER MDE, WATER MANAGEMENT ADMINISTRATION, WELL PROGRAM DATE WELL ABANDONED: PERMIT NUMBER OF ABANDONED WELL (if any) PERMIT NUMBER OF REPLACEMENT WELL PERSON ABANDONING WELL: froigh & Mayrie CIRCLE: MWD/MSD/MGD OWNER'S NAME: WELL LOCATION: COUNTY: - Wow -NEAREST TOWN: \_\_\_ PARCEL SUBDIVISION: \_ SECTION: \_ NEAREST ROAD: Trindslehin MARYLAND GRID COORDINATES 000 000 **BOX NUMBER** N505 SHOW WELL LOCATION BY X WITHIN BOX TYPE OF WELL BEING ABANDONED: DRILLED BORED/AUGUERED \_\_\_\_\_ HAND DUG LOG OF SEALING MATERIAL OTHER (specify) \_\_\_\_ FEET USE CODE: MATERIAL DOMESTIC \_\_\_\_\_ MUNICIPAL/PUBLIC **FROM** TO **IRRIGATION** \_\_\_\_\_ INDUSTRIAL 30-\_ TEST/OBSERVATION 65 30 TYPE OF CASING: STEEL \_\_ PLASTIC CONCRETE \_\_\_\_ OTHER (specify) SIZE OF CASING: 1 INCHES IN DIAMETER DEPTH OF WELL: \_\_\_\_\_\_\_\_ FEET DEEP WAS ANY CASING REMOVED? \_\_\_ YES \_\_\_\_ 100 17 100 7 15: 10

SIGNATURE-MASTER WELL DRILLER OR SUPÉRVISING SANITARIAN

WAS CASING RIPPED OR PERFORATED? \_\_\_\_YES \_\_\_\_NO

if yes, length removed, in feet: \_\_

CIRCLE ONE

Residential Tank Pull 14035 Triadelphia Mill Road Coatsa Residence

Met Robert Ryock - 2 = 275 pal tambes along salge of driveway were extracted. Touchs were cheedy extracted. Whe shallow in the ground (25° to tank bottom).

Both tomks were in Excellent shape. Minimum widence of putting; me holes seen or excessive wear around the seams.

No evidence of orders in soils

OK to dispose of tanks i close up holes. OK to proceed of anotallation of emergence replacement well (= 30th from Edge of tanks). BP # 11/322

Photos taken of tanks

BP# BOO 111322 (for Yank removal)

B Nifa

Colled MDE Oil Control Program - provided site info & that no problems w/ Vanks:

**APPLICATION** 

## - Information Only HOWARD COUNTY

1200

SERIAL NUMBER

B0011322

## PERMIT APPLICATION

DEPARTMENT OF INSPECTIONS, LICENSES & PERMIT
3430 COURT HOUSE DRIVE, ELLICOTT CITY, MARYLAND 21043

BUILDING ADDRESS (HOUSE NO., STREET, TOWN OR AREA)		GRADING/SEDIMENT	GRADING/SEDIMENT CONTROL QYES QNO			
14035 TRIADELPHIA M	ILL ICLY	DESCRIPTION OF WO	PK ALITHODIZE	on if to other In other of	SDP#	
DAYTON, N.D. 21036	3540		_		INF 115	
LOTNO. PARCEL NO. SEC. AREA BLOCK	(NO. LIBER FOLI	9-180	gad .	250 -27	INE U.S.	
2 76 - 3	7					
SUB DIVISION ZONE ZONE MAP	ELEC. DIST. CENSUS	17,701.70	Remov	SD 4/0	24/98	
OWNER NAME AND ADDRESS	AJ PHONE NO	SIZE OF BLDG.	FRONT	DEPTH	HEIGHT	
BAROLA: COATE	MILLION ES	<i>t</i>				
TAYTON MID. 21026	3225	<b>S</b>	-			
OCCUPANT'S NAME AND ADDRESS	PHONE NO	111 5 01 0000.	AREA	VOLUME	ROOF	
ANTEL AS OWNED	CAME	B. ROOMS ROOMS				
ARCHITECT OR ENGINEER'S NAME AND ADDRESS	PHONE NO	BATHS FIREPLACES				
		FOOTING	3	FOUNDATIO	N S. WALLS	
CONTRACTOR'S NAME AND ADDRESS						
	PHONE NO	WATERWELL SEWER/SEPT	UTILITIE		PE OF HEAT AC	
MCK.C.FYOCK OF	221	•				
	929	I have carefully examined an and that is doing this work	all provisions of	Howard County On	dinances and the State	
PROPOSED U	SE TANK	Laws of Maryland will be on Department of Inspections, at the inspections called for els	and Permits twenty	-four hours in advar	nce when I am ready to	
SFD SFD	WITH REMOVA	until such inspections have t			CAR WIN DE COVERED UP	
EST, CONSTRUCTION COST LICENSE NUMBE		Waxell	SIGNAT	URE 4	22-98	
W/S CODE F	OR OFFICE U	SE ONLY	Control of the Control		DATE	
	OR OFFICE U	FUNCTION	DATE	SIGNAT	URE APPROVAL	
DISTANCE IN FEET FROM R/W LINE TO FRONT BUILDING LINE		ZONING/PLANNING				
SIDE YARD (DISTANCE IN FEET FROM SIDE BLDG. LINE TO SID	DE PROPERTY LINE)	SHA				
TO SIDE BUILDING LINE		SEDIMENT/GRADING	1		1	
DISTANCE IN FEET, REAR YD. REQUIRING SET		BUILDING OFFICIAL	X 41231	W DX	Trancos	
BACK(CORNER LOT ONLY)	SDP#	WATER & SEWER	11.1	6 10 1	7,10, 40	
Check payable to: DIRECTOR OF FINANCE OF HOWAR	RD COUNTY	HEALTH DEPT.	X 4/29/9	8 B1	Tilan	
CAUTION		FIRE PROTECTION			1	
To begin construction before a permit plai and displayed on the job is a violation of the law	card has been issue	STORM WATER MGM				
Use and occupancy permit must be ap before it will be issued.	plied for two week					
MPORTANT: PLEASE SHOW ZIP CODES AND AREA CODE		APP	ROVED	<del></del>	DATE	


IMPORTANT: PLEASE SHOW ZIP CODES AND AREA CODES WHEREVER REQUIRED

LP-69-591

K6621

Distribution of Copies: White - Building Official Green - Planning & Zoning Yellow - Engineering Pink - Health Dept. Gold - S.H.A.

SITE INSPECTION SHEET 301-854-2285  SITE INSPECTION SHEET COUNTRY SCHOOL
11:00 meeted SITE INSPECTION SHEET 301-854-2285  11:00 meeted CAROL-410-531-7332 EXT 2116 COUNTRY SCHOOL  OWNER: Gary Coates DATE REQUESTED: 4/21/98
ADDRESS: 4035 Triadelphia Mill Rd DRILLER: Joe Mayne
Karinwood - Lot 3 WELL TAG # NA (Now tho-94-1530)
COUNTY #
PROPOSAL: Replacement Well House is in wood, GRAUGE DRIVE ON
TES OUTH SIDE OF ROAD AT TOP OF HIM
LOCATION DIAGRAM

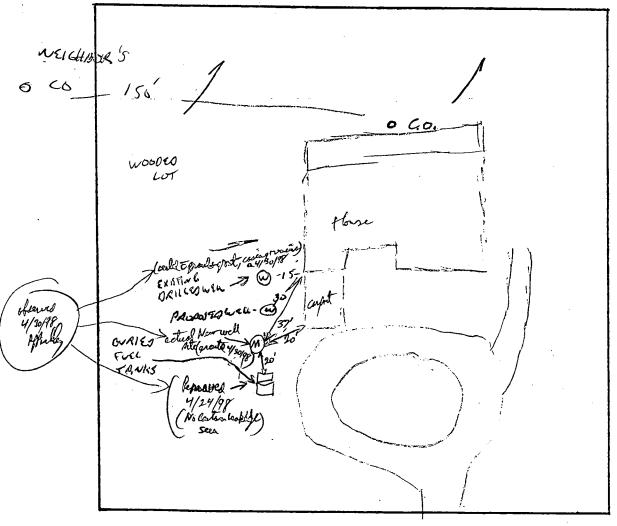

BULLS TO LEW SITE WITE WITE LOST OF TRAKS IS CONTRIGENT ON TRAK REMAINED

DATE:

INSPECTOR: