

6/9/98
6/10/98
ASAP
house cesspool abandonment

PERMIT

SEWAGE DISPOSAL SYSTEM

DEPARTMENT OF HEALTH AND MENTAL HYGIENE

05-395052

4/10/98 Needs
abandonment tag
of filing system
done

P 570180-C

A REPAIR

DISTRICT

DATE 6-3-98

DATE SYSTEM APPROVED 7/7/98

INSPECTOR DK5

HOWARD COUNTY HEALTH DEPARTMENT

BUREAU OF ENVIRONMENTAL HEALTH

461-9933

410313-2640

INDEXED

Jack Fyock Septic Services

IS PERMITTED TO INSTALL ☐ ALTER ☒

ADDRESS 13775 Triadelphia Rd, Glenelg, MD 21737

PHONE 410-988-9270

SUBDIVISION LOT ROAD 13883 Triadelphia Road

PROPERTY OWNER Jacobs

ADDRESS 13883 Triadelphia Rd, Glenelg, MD 21737

SEPTIC TANK CAPACITY 1000 GALLONS

NUMBER OF BEDROOMS 3

240 SQUARE FEET PER BEDROOM

LINEAR FEET OF TRENCH REQUIRED 240

REPAIR - PURPOSE - SEPTIC SYSTEM HAS FAILED.

Call for an inspection when the ground is opened so a sanitarian can recommend repairs.

6-2-98.

Inlet at 7.0', Bottom at 9.0', trench 30' wide, 2' of stone
linear feet of trench installed 240'

PLANS APPROVED BY

Kim Maiste

DATE 6.8.98

COVER NO WORK UNTIL INSPECTED AND APPROVED

NEITHER THE HOWARD COUNTY COUNCIL NOR THE HEALTH DEPARTMENT IS RESPONSIBLE FOR THE SUCCESSFUL OPERATION OF ANY SYSTEM

NOTE: CLEANOUT REQUIRED EVERY 70 FEET OF SEWER LINE AND/OR AT 90° SWEEPS IN LINES FROM HOUSE TO DRAIN FIELDS, 90° ELBOWS NOT ACCEPTABLE.

NOTE: ALL PARTS OF SEPTIC SYSTEMS (I.E. TANK, DISTRIBUTION BOX TRENCHES) TO BE 100 FEET FROM WELL (UNLESS OTHERWISE SPECIFICALLY AUTHORIZED)

NOTE: IF DEEP TRENCH(ES) ARE USED CALL FOR INSPECTION BEFORE AND AFTER PLACING GRAVEL IN TRENCH(ES)

NOTE: NO DRY WELL SHALL EXCEED 15 FOOT IN DIAMETER NO ABSORPTION TRENCH TO EXCEED 100 FEET IN LENGTH

NOTE: ALL PIPE FROM HOUSE TO SEPTIC TANK MUST BE CAST IRON OR SCHEDULE 35/40 PVC OR ABS

PERMIT VOID AFTER TWO YEARS

NOTE: INSTALL STAND PIPE ON SEPTIC TANK AND DRY WELL STAND PIPES MUST BE 6 INCHES IN DIAMETER CAST IRON. CONCRETE OR TERRA COTTA OR PVA OR ABS ACCEPTED. IF TOP OF SEPTIC TANK IS DEEPER THAN 3 FEET. MANHOLE TO GRADE REQUIRED.

NOTE: DISTRIBUTION BOXES MUST HAVE BAFFLES

*INSTALLER IS RESPONSIBLE FOR OBTAINING FINAL APPROVAL ON THIS PERMIT

HD-260(6-90)

*CALL 461-9933 FOR INSPECTION OF SEPTIC SYSTEM.

P 570180-C


(A)
or/red
Clay ln
6.0'
red/bor
Sc ln
redox
features
sticky
moist

6.0' (C)
9:50₃₀ → 10:07
test stopped, slow

(B) test hole
deepened
7.5'

10:01₃₀ → 10:11

10:11 → 10:31
20 minutes

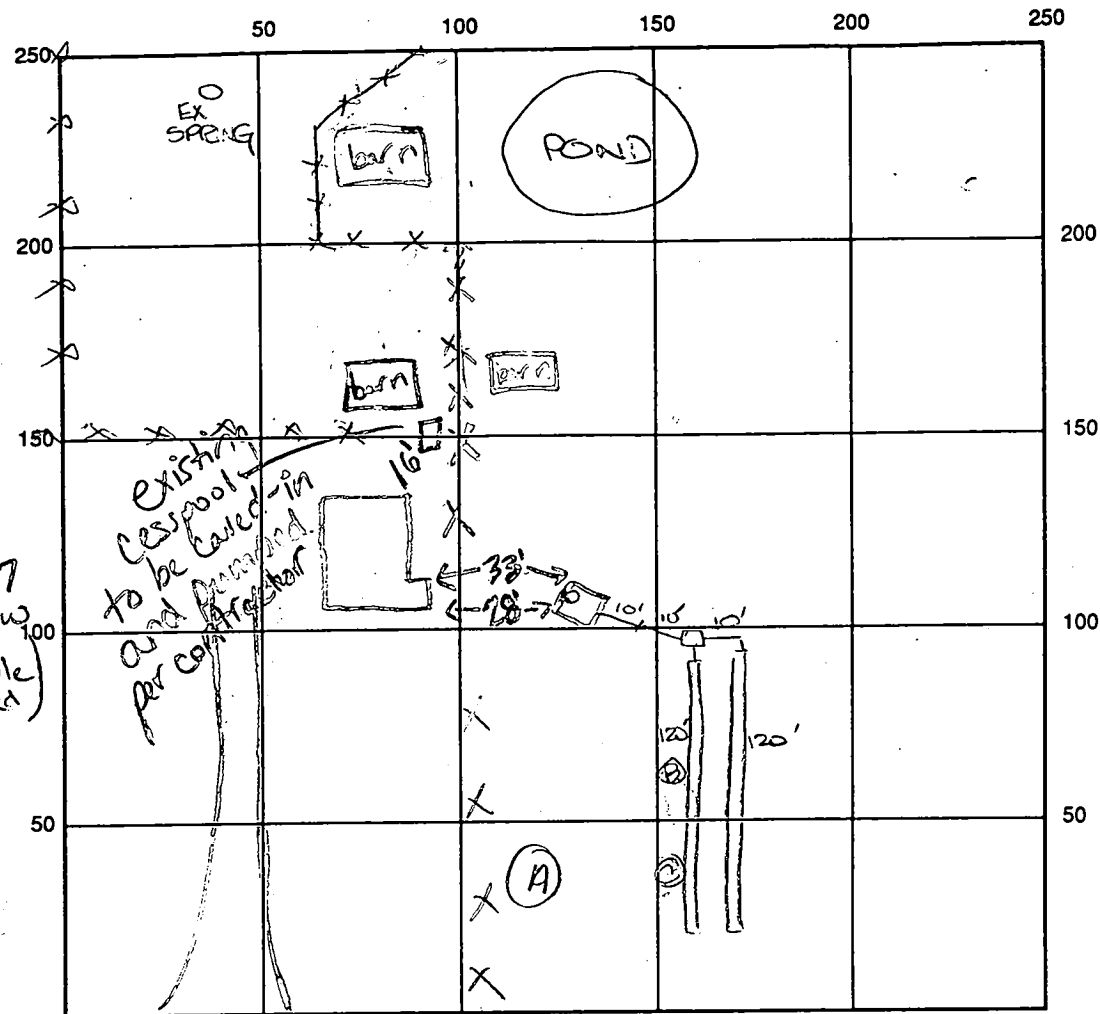

(new tank) INDICATE NORTH - NAME ADJOINING ROADWAY AS BASE LINE Triadelphia Rd.

SEPTIC TANK LEVEL OK, 1000 gallons

CLEANOUTS one on st.

DISTRIBUTION BOX LEVEL OK

DRAIN FIELD/TITLE DEPTH 9 FT.

TRENCH WIDTH 3 FT.

INLET DEPTH 7 FT.

EFFECTIVE GRAVEL DEPTH 2 FT.

TOTAL LENGTH 2X120 FT. → 240

NUMBER OF TRENCHES 2

ONE SIDEWALL/BOTTOM AREA 720 SQ. FT.

DRYWALL INSIDE DIAMETER — FT.

EFFECTIVE DEPTH BELOW INLET — FT.

ABSORBENT AREA — SQ. FT.

REMARKS: 6.8.98 ok to continue with trenches, will call for inspection tomorrow am. (km)

6/9/98 ok to cover all septic work. Needs house connection. Failing system to be abandoned when new system is put into service. DKS

6/10/98 house connection ok w/o insp - No final until abandonment

DATE SYSTEM APPROVED 7/7/98 INSPECTOR [Signature]

7/7/98 received certification of abandonment of failing system. DKS

JACK FYOCK SEPTIC SERVICE, INC.

SEPTIC PUMPING, INSTALLATION, AND REPAIRS

P.O. BOX 89 • GLENELG, MD 21737

PHONE (410) 988-9270 or (410) 531-2939

FAX: (410) 531-1256

July 7, 1998

Howard Co. Environmental

Health Dept. Kim Soe

3525 H Ellicott Mills Dr.

Ellicott City, MD

Dear Kim,

This is to certify that Jack Fyock Septic Service abandoned the septic tank at 13883 Triadelphia Rd. for Paul Jacobs.

We pumped the septic tank, caved it in and filled it with dirt.

Robert Fyock

Robert Fyock

ORIGINAL