

PERMIT

SEWAGE DISPOSAL SYSTEM

DEPARTMENT OF HEALTH AND MENTAL HYGIENE

P 511945

A 57577-F

DISTRICT _____

DATE 6-11-1999

HOWARD COUNTY HEALTH DEPARTMENT

BUREAU OF ENVIRONMENTAL HEALTH

~~XXXXXX~~ 410-313-2640

DATE SYSTEM APPROVED 7/8/99

INSPECTOR A

05-427967
INDEXED

Jack Fyock Septic Services

IS PERMITTED TO INSTALL X ALTER _____

ADDRESS P.O. Box 89, Triadelphia Road, Glenelg, Maryland 21737 PHONE 410-988-9270

SUBDIVISION Small Ridge LOT 2 ROAD 14608 Triadelphia Mill Road

PROPERTY OWNER I. Joseph Bart & T. Stallone

ADDRESS _____

SEPTIC TANK CAPACITY 1250 GALLONS

NUMBER OF BEDROOMS 4

180 SQUARE FEET PER BEDROOM

LINEAR FEET OF TRENCH REQUIRED 240

TRENCHES - Trench to be 3 feet wide. Inlet 3 feet below original grade. Bottom maximum depth 5 feet below original grade. Effective area begins at 5 feet below original grade. 2 feet of stone below distribution pipe.

LOCATION - From the junction of the 406.36' and 475.39' lot lines, place the distribution box 230 feet down the 475.39' lot line, and 100 feet off that same lot line. Run trenches along contour in both directions.

NOTES - No trench to exceed 100 feet in length. Provide 6" - 8" diameter cleanout and cap to grade or above on septic tank. OK/MR

PLANS APPROVED BY Glen Savage/Ronald J. Pinkley DATE 6-14-1999

COVER NO WORK UNTIL INSPECTED AND APPROVED

NEITHER THE HOWARD COUNTY COUNCIL NOR THE HEALTH DEPARTMENT IS RESPONSIBLE FOR THE SUCCESSFUL OPERATION OF ANY SYSTEM

NOTE: CLEANOUT REQUIRED EVERY 70 FEET OF SEWER LINE AND/OR AT 90° SWEEPS IN LINES FROM HOUSE TO DRAIN FIELDS. 90° ELBOWS NOT ACCEPTABLE.

NOTE: ALL PARTS OF SEPTIC SYSTEMS (I.E. TANK, DISTRIBUTION BOX TRENCHES) TO BE 100 FEET FROM WELL (UNLESS OTHERWISE SPECIFICALLY AUTHORIZED)

NOTE: IF DEEP TRENCH(ES) ARE USED CALL FOR INSPECTION BEFORE AND AFTER PLACING GRAVEL IN TRENCH(ES)

NOTE: NO DRY WELL SHALL EXCEED 15 FOOT IN DIAMETER NO ABSORPTION TRENCH TO EXCEED 100 FEET IN LENGTH

NOTE: ALL PIPE FROM HOUSE TO SEPTIC TANK MUST BE CAST IRON OR SCHEDULE 35/40 PVC OR ABS

PERMIT VOID AFTER TWO YEARS

NOTE: INSTALL STAND PIPE ON SEPTIC TANK AND DRY WELL STAND PIPES MUST BE 6 INCHES IN DIAMETER CAST IRON, CONCRETE OR TERRA COTTA OR PVA OR ABS ACCEPTED. IF TOP OF SEPTIC TANK IS DEEPER THAN 3 FEET, MANHOLE TO GRADE REQUIRED.

NOTE: DISTRIBUTION BOXES MUST HAVE BAFFLES

*INSTALLER IS RESPONSIBLE FOR OBTAINING FINAL APPROVAL ON THIS PERMIT

*CALL 461-9933 FOR INSPECTION OF SEPTIC SYSTEM.

BLDG. PERMITS DIVISION


AND RETURNED 8/16/2000

Boo126017 Hot Tub

AND RETURNED 11/16/00

Boo027436 Deck

511945

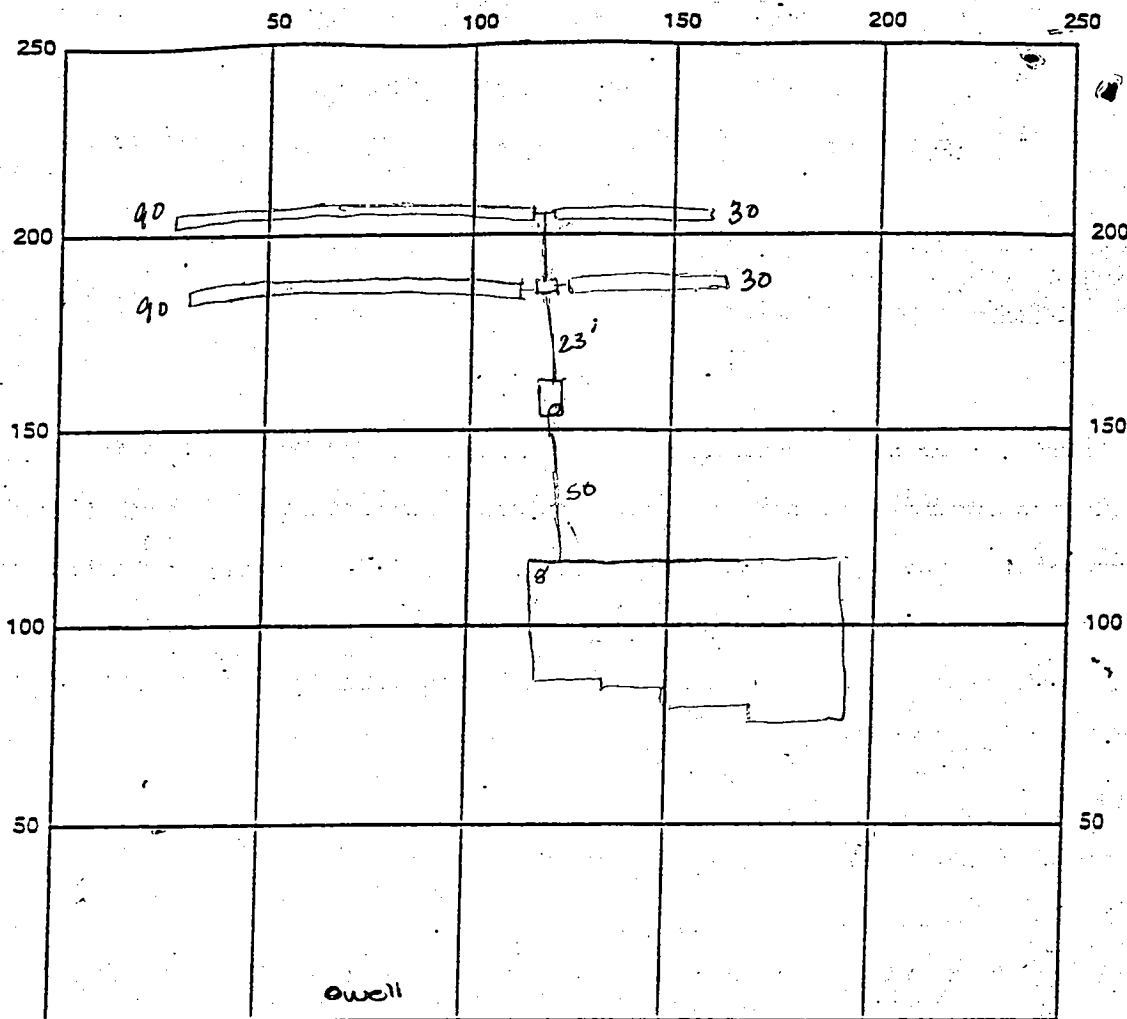

INDICATE NORTH - NAME ADJOINING ROADWAY AS BASE LINE

SEPTIC TANK LEVEL OK 1250 gal

CLEANOUTS OK

DISTRIBUTION BOX LEVEL OK

DRAIN FIELD/TITLE DEPTH 5.0 FT.

TRENCH WIDTH 3.0 FT.

INLET DEPTH 3.0 FT.

EFFECTIVE GRAVEL DEPTH 2.0 FT.

TOTAL LENGTH 240 FT.

NUMBER OF TRENCHES 4

ONE SIDEWALL/BOTTOM AREA 720 SQ. FT.

DRYWALL INSIDE DIAMETER — FT.

EFFECTIVE DEPTH BELOW INLET 2.0 FT.

ABSORBENT AREA — SQ. FT.

REMARKS: 7/1/99 Trenches unequal length - distrib. box in incorrect location
and last "trench" 120' long w/ only fee & earth berm separating
each side. 7/8/99 Spoke w/ Fyock - unable to move DB and get
inv. into trench @ 3.0 - OK to cover as is but future systems need to
have equal trench lengths &

7/7/99 WPI OK - pitless 4.0' below grade PUC conduit OK *

DATE SYSTEM APPROVED 7/8/99

INSPECTOR A McMill

APPLICATION

PERCOLATION TESTING

A 57577E

P _____

HOWARD COUNTY HEALTH DEPARTMENT

BUREAU OF ENVIRONMENTAL HEALTH

3525-H ELLICOTT MILLS DRIVE/ELLICOTT CITY, MARYLAND 21043
TELEPHONE: 313-2840

DISTRICT _____

DATE _____

TO: THE COUNTY HEALTH OFFICER
ELLICOTT CITY, MARYLAND

I HEREBY APPLY FOR THE NECESSARY TEST PRIOR TO APPLICATION FOR PERMIT TO CONSTRUCT (OR RECONSTRUCT) A SEWAGE DISPOSAL SYSTEM.

PROPERTY OWNER C.M.C. CONSTRUCTION, INC. F. Joseph Bert & T. Stagnone

ADDRESS _____ PHONE _____

AGENT OR PROSPECTIVE BUYER CHARLES A. SHARP

ADDRESS 3779 SHARP ROAD PHONE 410-989-4630

PROPERTY LOCATION:

SUBDIVISION C.M.C. CONSTRUCTION PROPERTY LOT NO. 22 2

ROAD AND DESCRIPTION HOWARD ROAD 3,000'± FROM INTERSECTION

14608 TRIDELPHIA ROAD (SOUTH)

TAX MAP 27 PARCEL # 12 142

SIZE OF LOT 40,000 - 50,000 SQ. FT. TYPE BLDG. SINGLE FAMILY DWELLING - 4 Bm
(SINGLE FAMILY DWELLING OR COMMERCIAL)

THE SYSTEM INSTALLED UNDER THIS APPLICATION IS ACCEPTABLE ONLY UNTIL PUBLIC FACILITIES BECOME AVAILABLE. I FULLY UNDERSTAND THE FEE CONNECTED WITH THE FILING OF THIS PERC TEST APPLICATION IS NON-REFUNDABLE UNDER ANY CIRCUMSTANCES. I ALSO AGREE TO COMPLY WITH ALL M.O.S.H.A. REQUIREMENTS IN TESTING THIS LOT.

Charles A. Sharp
(SIGNATURE OF APPLICANT)

APPROVED BY _____ FOR _____ DATE _____

DISAPPROVED BY _____ FOR _____ DATE _____

HOLD PENDING FURTHER TESTS _____

REASONS FOR REJECTION OR HOLDING _____

PERCOLATION TEST PLAT/PRELIMINARY PLAT - TITLE OR I.D. # _____ DATE _____

SITE DEVELOPMENT PLAN/FINAL PLAT - TITLE OR I.D. # _____ DATE _____

THIS IS NOT A PERMIT


A52577 F
COUNTY #

SOIL PROFILE

0'

TOPSOIL
ORANGE SANDY C.L.
TAN SILT

H
E
J
I
S
E

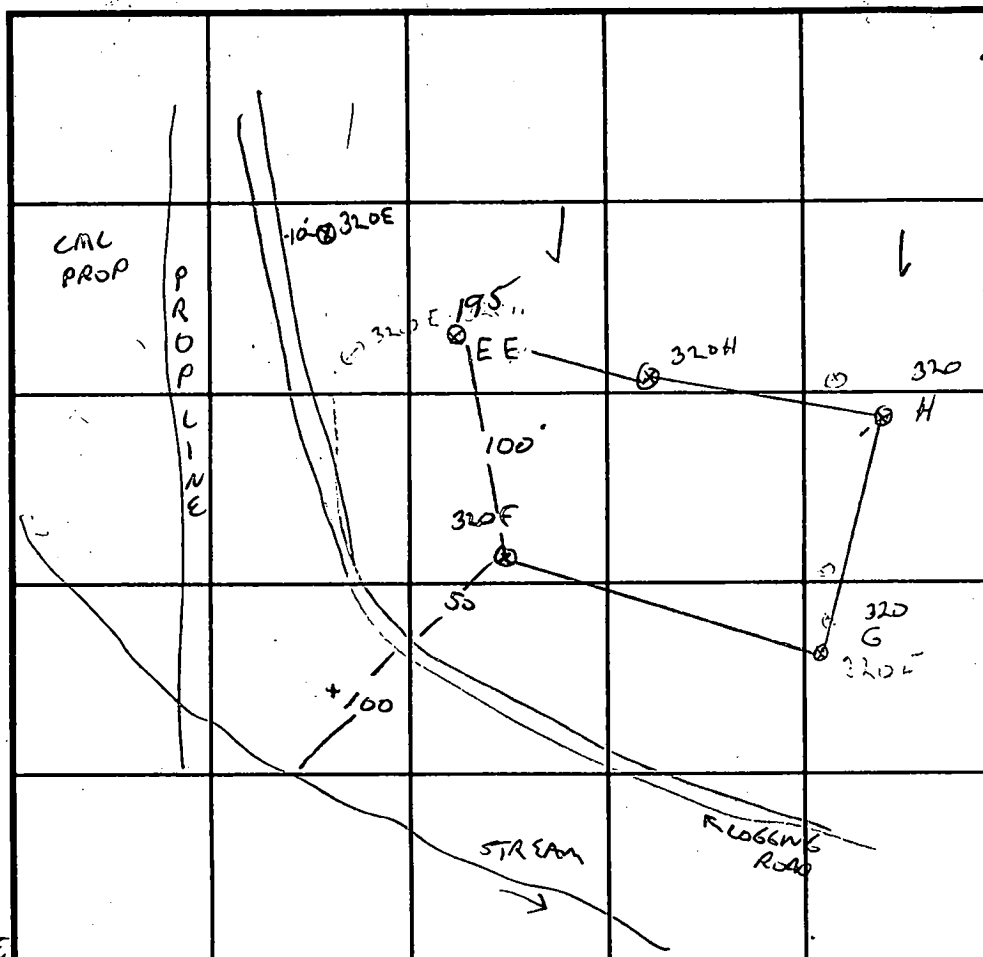

INDICATE NORTH - NAME ADJOINING ROADWAY AS BASE LINE.

SOIL PROFILE 320F

0' TOPSOIL
LIGHT BROWN S.C.L.
3' ORANGE SANDY SILT LOAM
6' TAN SANDY SILT LOAM
9' DARK GREENISH BR SANDY LOAM 30% PLATY FRACTION FRAGS
12'

DATE	TEST NO.	DEPTH	PRE-WET		TEST - 1" DROP		TIME
			START	STOP	START	STOP	
3/20/97	320F	3.5/12V	10:57	11:05	11:05	11:19	14 min
	320G	3/11V	11:05	11:08	11:08	11:12	4 min
		7	11:05	11:08	11:08	11:12	4 min
	320H	4/11V	11:13	11:15	11:15	11:18	3 min
		8V ok					
	320E	3.5/11V	11:21	11:24	11:24	11:31	7 min
	320J	3.5/11V	11:34				
	320K	3.5/11V	11:35				
	EE	12V dc					

REMARKS POKE PROPERTY LOT 2

TYPE OF SOIL

TESTED BY G. SAVAGE

ALSO PRESENT C. SHARP

TRENCH DESIGN DATA: AVERAGE PERCOLATION TIME 7 min

TRENCH WIDTH 3


INLET DEPTH 3

MAXIMUM BOTTOM DEPTH 5

SQ. FT./BEDROOM 180

Highland Development Corp.
3955 / 674

Washington Suburban Sanitary Commission

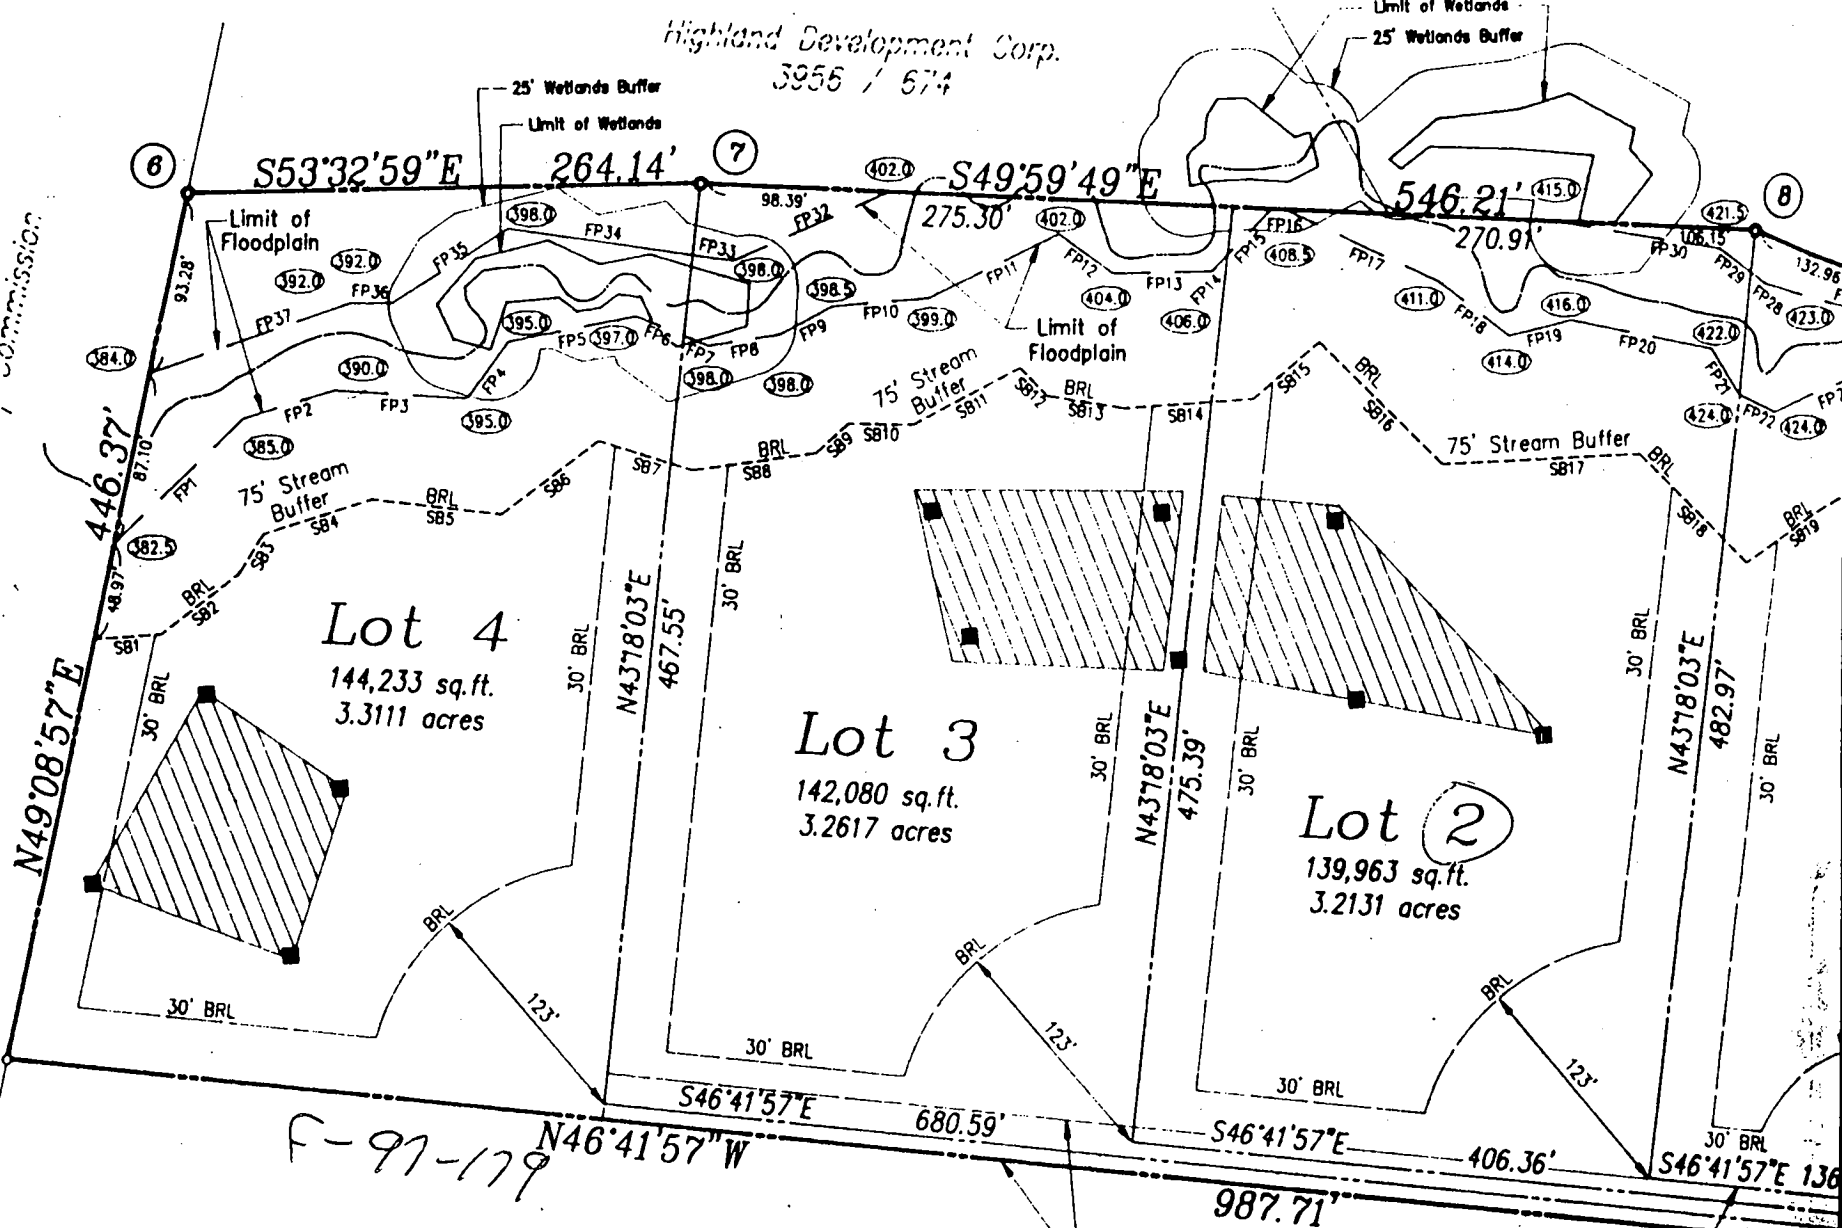

John R. & Elizabeth A. Kreider
1139 / 165

24 Foot Private Use-In-Common Ingress & Egress
Easement for Lots 1 through 4; Maintenance Agreement
to be recorded in the Land Records of Howard County

MAY-12-98 TUE 09:34 AM RICHARD DEMMITT
RC-DEO
RR-DEO
Suburban Sanitary Commission
145 / 150

N49°08'57"E

446.37'

6

S53°32'59"E

25 Wetlands Buffer
Limit of Wetlands

264.14'

7

S49°59'49"E

546.21'

25 Wetlands Buffer
Limit of Wetlands


Charles A. & Denise D. Sharp
1456 / 1267

51/2

LOT 1
WALKED

Charles A. & Denise D. Sharp
5708 / 1705

MARYLAND STATE
GRID NAD 83/91

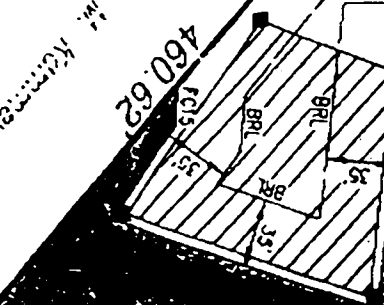

438.46'

S31°49'03"E

130

123

S79°28'00"W

Stone

10

12

11

13

14

15


306

307

308


309</

CHARLES A. & DENISE D. SHARP
L4136 F.267

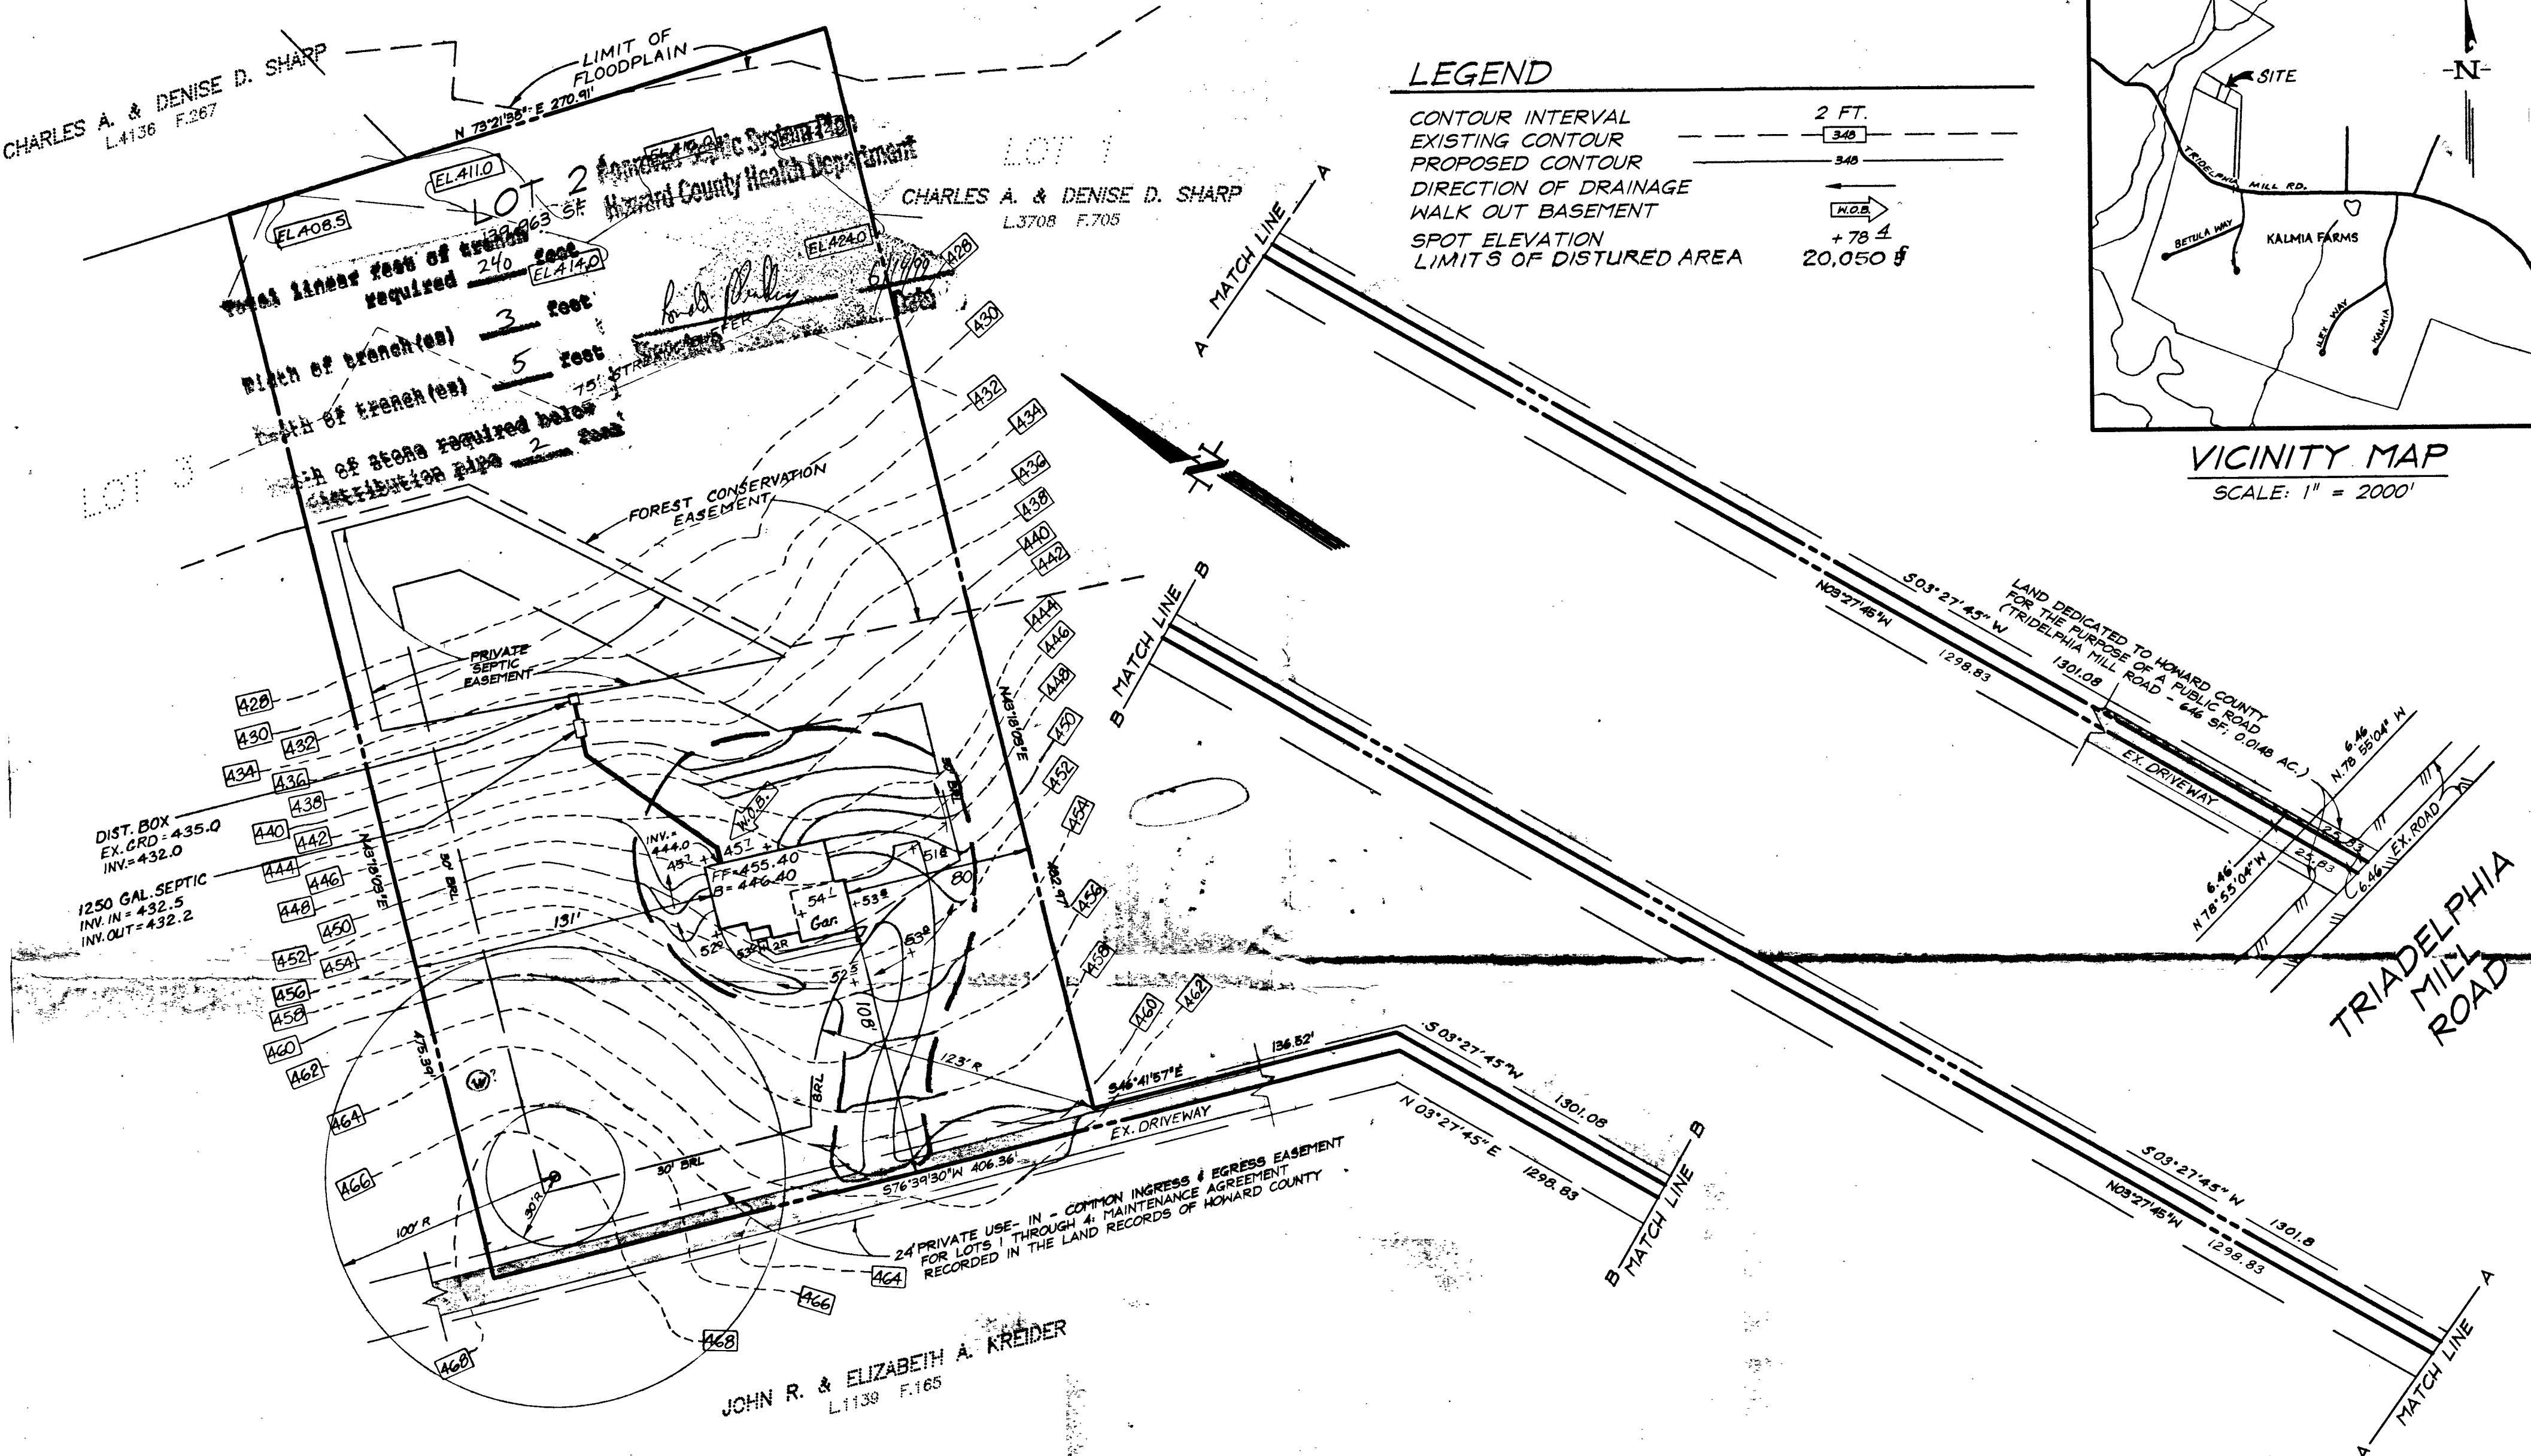

LEGEND

- CONTOUR INTERVAL 2 FT.
- EXISTING CONTOUR (dashed line)
- PROPOSED CONTOUR (solid line)
- DIRECTION OF DRAINAGE (arrow)
- WALK OUT BASEMENT (line with 'W.B.') and spot elevation +78.4
- LIMITS OF DISTURBED AREA 20,050 sq ft

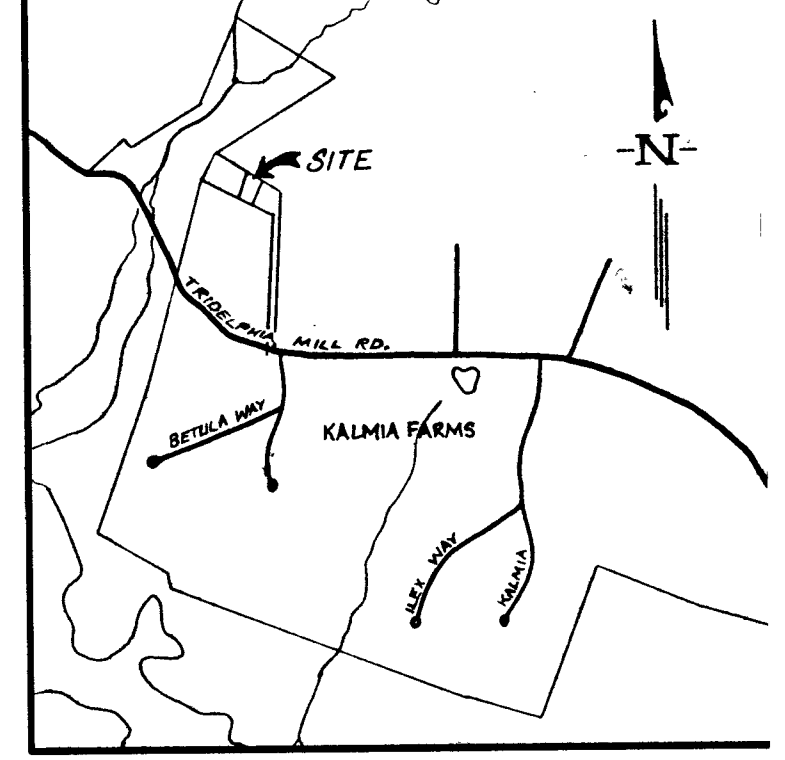

VICINITY MAP
SCALE: 1" = 2000'

GENERAL NOTES

1. TOPO WAS TAKEN FROM PLANS PREPARED BY R.M. MOCHI GROUP P.C.
2. LENGTH OF TRENCHES TO BE DETERMINED AT TIME OF PERMIT ISSUANCE.
3. DISTURBED AREA
4. RECORDED PLAT NO. 13096
5. FLOOD PLAIN ELEVATIONS SHOWN 414.0

CLARK • FINEFROCK & SACKETT, INC. ENGINEERS • PLANNERS • SURVEYORS 7135 MINSTREL WAY • COLUMBIA, MD 21045 • (410) 381-7500 BALT. • (301) 621-8100 WASH.		
DESIGNED JME	SITE DEVELOPMENT PLAN LOT 2 SMALL RIDGE TAX MAP 27 PARCEL 96 FOURTH (4TH) ELECTION DISTRICT HOWARD COUNTY, MARYLAND	SCALE 1" = 50'
DRAWN BLP		DRAWING 1 of 1
CHECKED JME		JOB NO. 99-079
DATE 5-26-99		FILE NO. 99-079-X
FOR: CROSEN HOMES, INC. 3825 Shady Lane Glenwood, Maryland 21738		

C1 05014

SEQUENCE NO.
(MDE USE ONLY)STATE OF MARYLAND
WELL COMPLETION REPORT
FILL IN THIS FORM COMPLETELY
PLEASE PRINT OR TYPETHIS REPORT MUST BE SUBMITTED WITHIN
45 DAYS AFTER WELL IS COMPLETEDCOUNTY
NUMBER A 57577 E1 2 3 4 5 6
(THIS NUMBER IS TO BE PUNCHED
IN COLS. 3-6 ON ALL CARDS)

ST/CO USE ONLY

DATE Received
MM DD YY

DATE WELL COMPLETED

MM DD YY
5 13 99

Depth of Well

22 340 26
(TO NEAREST FOOT)

PERMIT NO.

FROM "PERMIT TO DRILL WELL"

#0-94-1560
28 29 30 31 32 33 34 35 36 37OWNER HIGHLAND DEV. CORP
STREET OR RFD TRIADOLPHIA MILL ROAD TOWN DAYTON
SUBDIVISION SMALL RIDGE SECTION 2 LOT 2

WELL LOG

Not required for driven wells

GROUTING RECORD

WELL HAS BEEN GROUTED
(Circle Appropriate Box)yes no
Y N
44 44

TYPE OF GROUTING MATERIAL (Circle one)

CEMENT CM BENTONITE CLAY BCNO. OF BAGS 22 NO. OF POUNDS 2068GALLONS OF WATER 132

DEPTH OF GROUT SEAL (to nearest foot)

from 0 ft. to 71 ft.
TOP 48 52 54 58 BOTTOM
(enter 0 if from surface)

CASING RECORD

casing
types
insert
appropriate
code
belowST
STEELCO
CONCRETEPL
PLASTICOT
OTHERMAIN
CASING
TYPE
STNominal diameter
top (main) casing
(nearest inch)

6

Total depth
of main casing
(nearest foot)

82

60 61 63 64 66 70

OTHER CASING (if used)

E
A
C
H
C
A
S
I
N
Gdiameter depth (feet)
inch from toscreen type
or open hole

SCREEN RECORD

(insert
appropriate
code
below)ST
STEELBR
BRASSHO
OPEN
HOLEPL
PLASTICOT
OTHERNUMBER OF UNSUCCESSFUL WELLS: 0

WELL HYDROFRACTURED

yes

Y

no

N

CIRCLE APPROPRIATE LETTER

- A A WELL WAS ABANDONED AND SEALED
WHEN THIS WELL WAS COMPLETED
- E ELECTRIC LOG OBTAINED
- P TEST WELL CONVERTED TO PRODUCTION
WELL

I HEREBY CERTIFY THAT THIS WELL HAS BEEN CONSTRUCTED IN
ACCORDANCE WITH COMAR 26.04.04 "WELL CONSTRUCTION" AND
IN CONFORMANCE WITH ALL CONDITIONS STATED IN THE ABOVE
CAPTIONED PERMIT, AND THAT THE INFORMATION PRESENTED
HEREIN IS ACCURATE AND COMPLETE TO THE BEST OF MY
KNOWLEDGE.DRILLERS LIC. NO.: M 5D 024

DRILLERS SIGNATURE

(MUST MATCH SIGNATURE ON APPLICATION)

LIC. NO.: M DSITE SUPERVISOR (sign. of driller or journeyman
responsible for sitework if different from permittee)GRAVEL PACK
IF WELL DRILLED
WAS FLOWING WELL
INSERT F IN BOX 68

68

MDE USE ONLY

(NOT TO BE FILLED IN BY DRILLER)

T

(E.R.O.S.)

W Q

70

72

74 75 76
TELESCOPE LOG
CASING INDICATOR OTHER DATA

C 3

PUMPING TEST

HOURS PUMPED (nearest hour)

3

8 9

PUMPING RATE (gal. per min.)

4

METHOD USED TO
MEASURE PUMPING RATE

Bucket

WATER LEVEL (distance from land surface)

BEFORE PUMPING

65 ft.

WHEN PUMPING

248 ft.

TYPE OF PUMP USED (for test)

A air

P piston

T turbine

C centrifugal

R rotary

O other
(describe
below)

J jet

S submersible

PUMP INSTALLED

DRILLER WILL INSTALL PUMP
(CIRCLE) (YES or NO)

YES

NO

IF DRILLER INSTALLS PUMP, THIS SECTION
MUST BE COMPLETED FOR ALL WELLS.TYPE OF PUMP INSTALLED
PLACE (A,C,J,P,R,S,T,O)

29

CAPACITY:
GALLONS PER MINUTE
(to nearest gallon)

31 35

PUMP HORSE POWER

37 41

PUMP COLUMN LENGTH
(nearest ft.)

43 47

CASING HEIGHT (circle appropriate box
and enter casing height)


+ above

LAND SURFACE

- below

2 (nearest
foot)

LOCATION OF WELL ON LOT


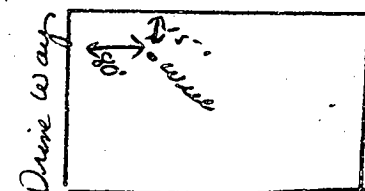
SHOW PERMANENT STRUCTURE SUCH AS
BUILDING, SEPTIC TANKS, AND /OR
LANDMARKS AND INDICATE NOT LESS
THAN TWO DISTANCES
(MEASUREMENTS TO WELL)

COUNTY

Well Permit No. HO - 94-1560
Location of property (road) Irishdelphia Mill Rd.
Subdivision Small Ridge Lot 2 Block Plat Sec.
Well Driller Joseph Mayne Owner Highland Development
Depth of well 340'
Distance of measuring point (M.P.) above ground 2'
Static water level (S.W.L.) below M.P. 65'

Time pump started 6:30 Pumping rate 20 gpm
Total time 30 min. to reach pumping water level 248 ft. below M.P.

[illegible]

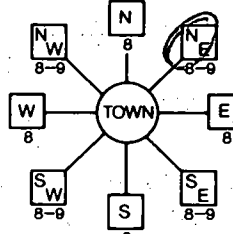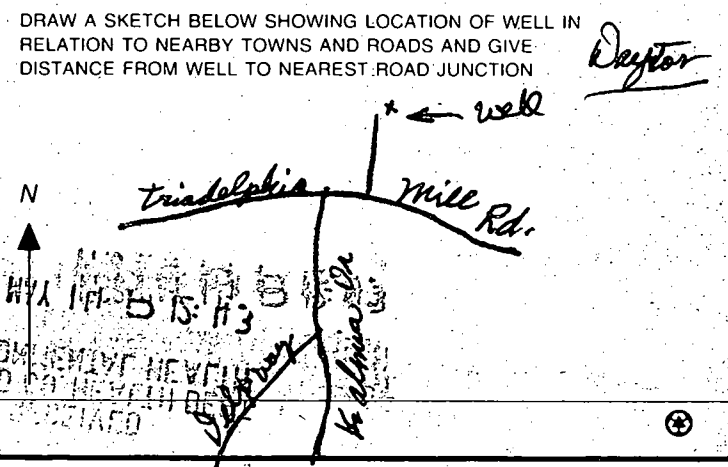B 1	6703	SEQUENCE NO. (MDE USE ONLY)	STATE OF MARYLAND PERMIT TO DRILL WELL please print or type	STATE PERMIT NUMBER HO-94-1560 fill in this form completely
Date Received (APA) MM DD YY 13 Highland Development Corp. P.O. Box 228 Clarksville Md. 21029		OWNER INFORMATION		
DRILLER INFORMATION Joseph L. Mayne Joseph L. Mayne well Drilling 5512 Ridge Rd. Mt. Airy, Md. 21771 Joseph L. Mayne 5/13/98		LOCATION OF WELL Howard Smallwood Ridge Dayton MILES FROM TOWN (enter 0 if in town) 4		
WELL INFORMATION APPROX. PUMPING RATE (GAL. PER MIN.) 5 AVERAGE DAILY QUANTITY NEEDED (GAL. PER DAY) 500		DIRECTION OF WELL FROM TOWN (CIRCLE BOX)  ON WHICH SIDE OF ROAD (CIRCLE APPROPRIATE BOX) Triadelphia Mill Road DISTANCE FROM ROAD 520 FT TAX MAP: 6 BLK: 11 PARCEL: 142		
USE FOR WATER (CIRCLE APPROPRIATE BOX) ☒ DOMESTIC POTABLE SUPPLY & RESIDENTIAL IRRIGATION ☐ FARMING (LIVESTOCK WATERING & AGRICULTURAL IRRIGATION) ☐ INDUSTRIAL, COMMERCIAL, DEWATERING ☐ PUBLIC WATER SUPPLY WELL ☐ TEST, OBSERVATION, MONITORING ☐ GEO-THERMAL		NOT TO BE FILLED IN BY DRILLER HEALTH DEPARTMENT APPROVAL HOWARD A-57577E COUNTY NAME COUNTY NO. STATE SIGNATURE INSERT S → DATE ISSUED 5 29 98 5.29.98 43 MM DD YY 48 CO SIGNATURE EXP. DATE NORTH GRID 510 000 EAST GRID 794 000 50 55 57 63		
APPROXIMATE DEPTH OF WELL 260 FEET APPROXIMATE DIAMETER OF WELL 6 INCH		SHOW MAJOR FEATURES OF BOX & LOCATE WELL WITH AN X SOURCES OF DRILLING WATER 1. Well 2. 3.		
METHOD OF DRILLING (circle one) ☒ BORED (or Augered) ☐ JETTED ☐ Jetted & DRIVEN ☐ AIR-ROTOR ☐ AIR-PERCussion ☐ ROTARY (Hydraulic Rotary) ☐ CABLE ☐ REVerse-ROTAry ☐ Drive-POINT other _____		WRITE THE BOX NUMBER FROM THE MAP HERE E 7904 N 540		
REPLACEMENT OR DEEPEINED WELLS (CIRCLE APPROPRIATE BOX) ☒ THIS WELL WILL NOT REPLACE AN EXISTING WELL ☐ THIS WELL WILL REPLACE A WELL THAT WILL BE ABANDONED AND SEALED ☐ THIS WELL WILL REPLACE A WELL THAT WILL BE USED AS A STANDBY-CONTACT LOCAL APPROVING AUTHORITY FOR POLICY ON STANDBY WELLS ☐ THIS WELL WILL DEEPEIN AN EXISTING WELL PERMIT NUMBER OF WELL TO BE REPLACED OR DEEPEINED (IF AVAILABLE) 41 _____ 52 _____		DRAW A SKETCH BELOW SHOWING LOCATION OF WELL IN RELATION TO NEARBY TOWNS AND ROADS AND GIVE DISTANCE FROM WELL TO NEAREST ROAD JUNCTION 		
Not to be filled in by driller. (MDE OR COUNTY USE ONLY)				
APPROP. PERMIT NUMBER HO-94-1560 PERMIT No. HO-94-1560				
SPECIAL CONDITIONS NOTE: APPROVING AUTHORITY'S SHOULD USE SEPARATE SHEET IF NEEDED.				

NEWARK COUNTY HEALTH DEPARTMENT
Bureau of Environmental Health
2825-M Ellicott Mills Drive
Ellicott City, MD 21043
410-2633

APPLICATION FOR FITLESS ADAPTER, WELL PUMP AND PRESSURE TANK INSTALLATION

New Installation ☒
Replacement ☐

Receipt # _____
Date _____

Name of Installer WILLoughby Plumbing, Inc.

Telephone 410-261-7051

Business Number 16992

Certified Well Pump Installer _____ Well Driller _____ Registered Plumber ☒

Name of Property Owner JOSEPH J. STALLONE, BERT

Telephone _____

Subdivision SMALL RIDGE Lot # 2

Well Tag # HD-99-1520

Site Address 14608 IRIDECRUM MILLS

Pump

1. Type
a. Deep well jet _____
b. Shallow well jet _____
c. Submersible ☒

Motor

1. Horsepower 3/4 HP
2. RPM _____
3. Voltage _____
a. 110 _____
b. 220 ☒

Fitless Adapter

1. Make HARVARD
2. Model # _____
3. Depth 4 ft.

4. Name IRIDIUM
5. Model # _____
6. Capacity 7 GPM

7. Pump exceeds well capacity Yes _____ No ☒
8. If Yes, is low pressure cutoff switch installed? Yes _____ No _____
9. What methods are used to protect the pump and electrical wiring from vibration? Torque wrenches ☒ Cable guards ☒ Other TAP

Tank

1. Capacity 40 gal
2. Pressure relief valve? yes

Piping

1. Type PESTLINE
2. Size 1"
3. NSF and/or BOCA Code approved yes
4. Depth of supply line 4 ft

Well Data

1. Depth 340 ft.
2. Yield 4 GPM
3. Static water level 65 ft.
4. Will water supply be affected by installation? NO

7/17/99 WPI OK - AM (rel)

I understand that it is my responsibility to notify the Newark County Health Department when the installation is ready for inspection (otherwise this permit is null and void).

All information given above is true to the best of my knowledge.

Signature of Applicant: Chris Willoughby

Date: 8/17/99

Notes: A seal indicating approval/status of the installation will be placed on the well during at the time of the inspection.

20-216

DRAIN FIELD


B00126017

14608 Trindell Hill Rd

add patient with hot eyes

No Conflict with well or Septic tank.

Recommend approval. RJP 8/16/00

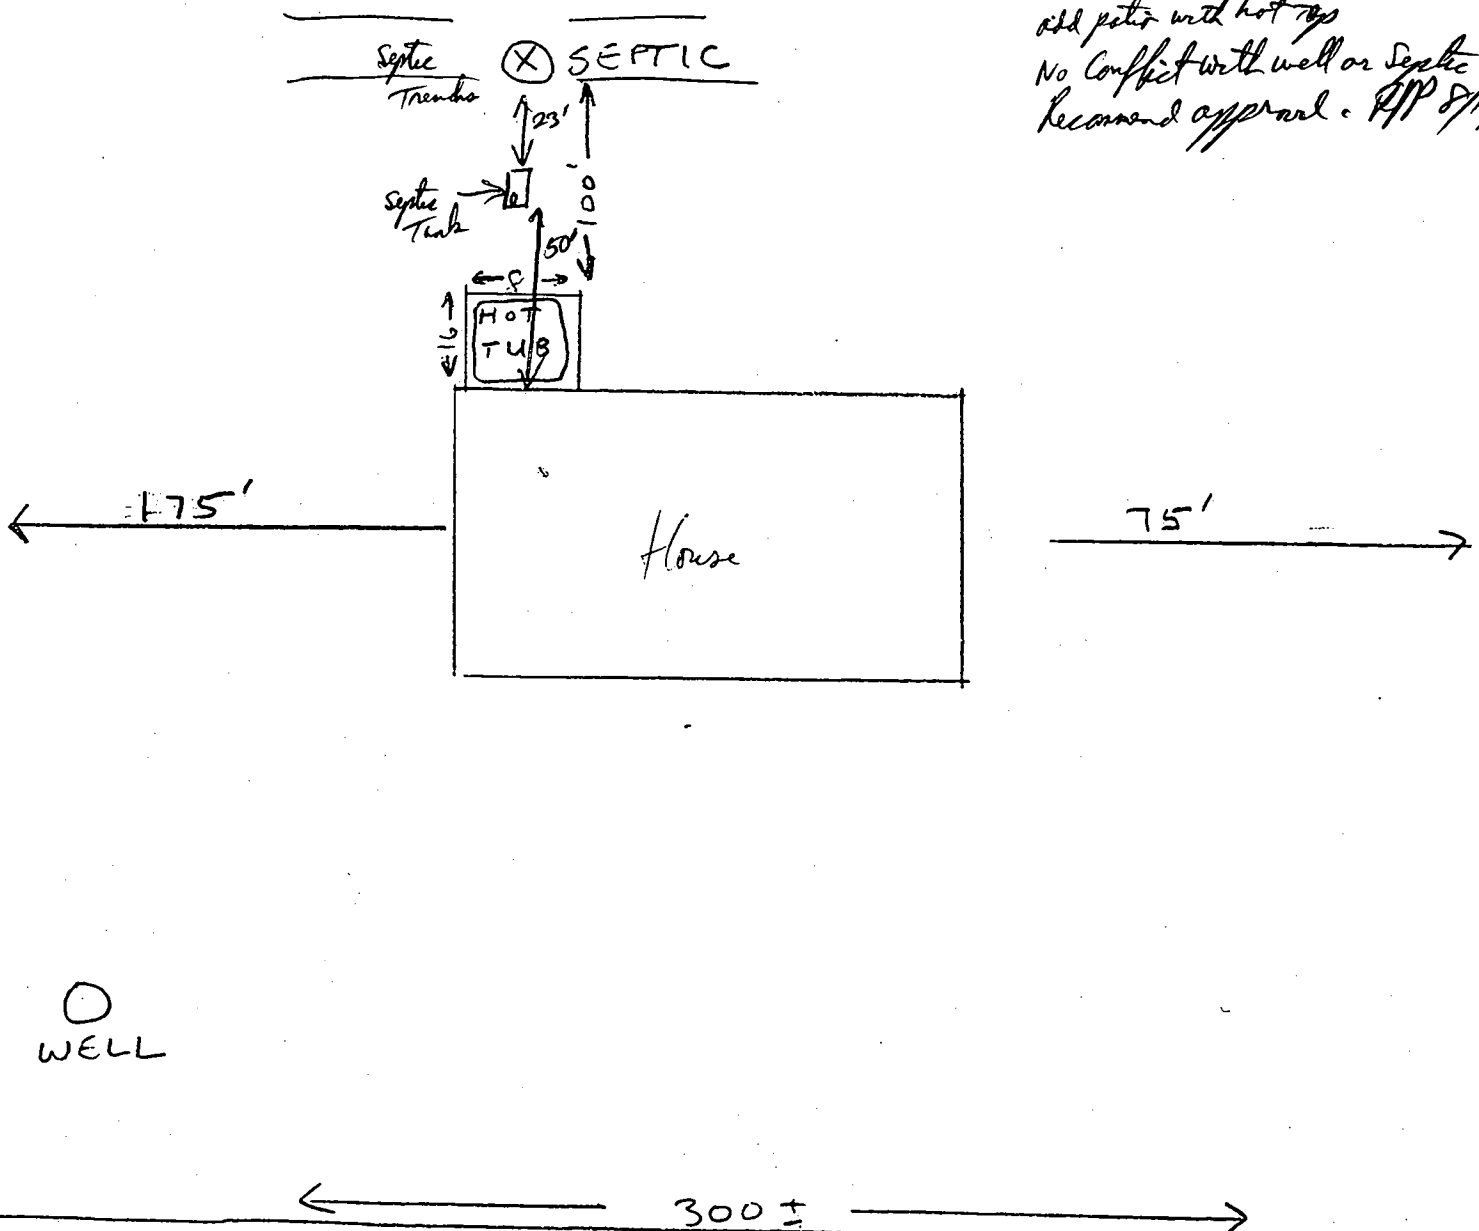

LOT 2
139,963 SF

FOREST CONSERVATION
EASEMENT

B00127436

8 MATCH LINE

Joe & Tracy Burt
14608 Tridelphia Mill Rd
DAYTON, MD
16x12 2ND Story
Covered Porch

24 PRIVATE USE - IN - COMMON INGRESS & EGRESS
FOR LOTS 1 THROUGH 4. MAINTENANCE AGREEMENT
RECORDED IN THE LAND RECORDS OF H&JARD

