

8/6/99
9:30-10 AM

PERMIT

SEWAGE DISPOSAL SYSTEM

DEPARTMENT OF HEALTH AND MENTAL HYGIENE

P 511957

A REPAIR

DISTRICT _____

DATE 6-18-1999

HOWARD COUNTY HEALTH DEPARTMENT

BUREAU OF ENVIRONMENTAL HEALTH
~~XXXXXX~~ 410-313-2640

RPS# 405858

INDEXED

DATE SYSTEM APPROVED 8/6/99

INSPECTOR M. R. F. K.

Mark Brew

IS PERMITTED TO INSTALL _____ ALTER ☒

ADDRESS 5436 Harris Farm Lane, Clarksville, Maryland 21029 PHONE 410-854-0609

SUBDIVISION Waterford LOT 11 ROAD 13243 Westmeath Lane

PROPERTY OWNER Michael Brown
13243 Westmeath Lane

ADDRESS Clarksville, Maryland 21029

SEPTIC TANK CAPACITY 1250 GALLONS

NUMBER OF BEDROOMS 4

SQUARE FEET PER BEDROOM _____

LINEAR FEET OF TRENCH REQUIRED _____

REPAIR - PURPOSE - IN SUPPORT OF BUILDING PERMIT B00118124 TO PROVIDE WASTEWATER DISPOSAL FOR NEW POOL HOUSE.

Call for inspection when ground is opened so sanitarian can recommend repair. 6-18-1999

CONN TO EX. SFD

PLANS APPROVED BY _____ DATE _____

COVER NO WORK UNTIL INSPECTED AND APPROVED.

NEITHER THE HOWARD COUNTY COUNCIL NOR THE HEALTH DEPARTMENT IS RESPONSIBLE FOR THE SUCCESSFUL OPERATION OF ANY SYSTEM

NOTE: CLEANOUT REQUIRED EVERY 70 FEET OF SEWER LINE AND/OR AT 90° SWEEPS IN LINES FROM HOUSE TO DRAIN FIELDS. 90° ELBOWS NOT ACCEPTABLE.

NOTE: ALL PARTS OF SEPTIC SYSTEMS (I.E. TANK, DISTRIBUTION BOX TRENCHES) TO BE 100 FEET FROM WELL (UNLESS OTHERWISE SPECIFICALLY AUTHORIZED)

NOTE: IF DEEP TRENCH(ES) ARE USED CALL FOR INSPECTION BEFORE AND AFTER PLACING GRAVEL IN TRENCH(ES)

NOTE: NO DRY WELL SHALL EXCEED 15 FOOT IN DIAMETER NO ABSORPTION TRENCH TO EXCEED 100 FEET IN LENGTH

NOTE: ALL PIPE FROM HOUSE TO SEPTIC TANK MUST BE CAST IRON OR SCHEDULE 35/40 PVC OR A2S

PERMIT VOID AFTER TWO YEARS

NOTE: INSTALL STAND PIPE ON SEPTIC TANK AND DRY WELL STAND PIPES MUST BE 6 INCHES IN DIAMETER CAST IRON, CONCRETE OR TERRA COTTA OR PVA OR ABS ACCEPTED. IF TOP OF SEPTIC TANK IS DEEPER THAN 3 FEET, MANHOLE TO GRADE REQUIRED.

NOTE: DISTRIBUTION BOXES MUST HAVE BAFFLES

*INSTALLER IS RESPONSIBLE FOR OBTAINING FINAL APPROVAL ON THIS PERMIT

*CALL 461-9333 FOR INSPECTION OF SEPTIC SYSTEM.

B0011763
POOL 4/29/99

511957

HOWARD COUNTY HEALTH DEPARTMENT
Bureau of Environmental Health
3525-H Ellicott Mills Drive
Ellicott City, MD 21043
461-9933

APPLICATION FOR PITLESS ADAPTER, WELL PUMP AND PRESSURE TANK INSTALLATION

New Installation X
Replacement _____

Receipt # _____
Date 6-18-99

Name of Installer Mark Brew Plumbing & Heating Telephone 301-854-0609

License Number 116761
Certified Well Pump Installer _____ Well Driller _____ Registered Plumber X

Name of Property Owner Michael Brown Telephone 410-381-6088
Subdivision Waterford Lot # 11 Well Tag # HO-81-2070
Site Address 13243 Westmeath Lane

Pump
1. Type
a. Deep well jet _____
b. Shallow well jet _____
c. Submersible _____
2. Make _____
3. Model # _____
4. Capacity _____ GPM
5. Pump exceeds well capacity Yes _____ No _____
6. If Yes, is low pressure cutoff switch installed? Yes _____ No _____
7. What methods are used to protect the pump and electrical wiring from vibrations? Torque arrestors _____ Cable guards _____ Other _____

Motor
1. Horsepower _____
2. RPM _____
3. Voltage _____
a. 110 _____
b. 220 _____

Pitless Adapter
1. Make _____
2. Model # _____
3. Depth _____

Tank
1. Capacity _____
2. Pressure relief valve? _____

Piping
1. Type poly 1/2" psi
2. Size 1"
3. NSF and/or BOCA Code approved _____
4. Depth of supply line 42"

Well data
1. Depth _____ ft.
2. Yield _____ GPM
3. Static water level _____ ft.
4. Will water supply be disinfected by installer? _____

installation of water line
to service new pool house
from existing well

I understand that it is my responsibility to notify the Howard County Health Department when the installation is ready for inspection (otherwise this permit is null and void).

All information given above is true to the best of my knowledge.

Signature of Applicant: Dana Robinson

Date: 6-18-99

Note: A sticker indicating approval/status of the installation will be placed on the well casing at the time of the inspection.

135004 Call Cont

DEPARTMENT OF INSPECTIONS, LICENSES AND PERMITS 3430 COURT HOUSE DRIVE ELLICOTT CITY, MD 21043 PERMITS (410) 313-2455 INSPECTIONS (410) 313-1810 AUTOMATED INFORMATION (410) 313-3900	HOWARD COUNTY PERMIT APPLICATION	PERMIT NUMBER 300119568
---	---	-----------------------------------

Building Address <u>13243 Westmoreland Lane</u> <u>Clarksville MD 21029</u> Suite/Apt. #: _____ SDP/WP/Petition #: _____ Census Tract <u>60251.01</u> Subdivision <u>Westmoreland</u> Section <u>3</u> Area <u>1.4</u> Lot <u>9</u> Tax Map <u>34</u> Parcel <u>602</u> Grid <u>9</u> Zoning <u>PPD-DE</u> Map Coordinates _____ Lot size _____	Property Owner's Name <u>Michael J. Brown</u> Address <u>13243 Westmoreland Lane</u> City <u>Clarksville</u> State <u>MD</u> Zip Code <u>21029</u> Home Phone <u>301-854-9567</u> Work Phone _____ Applicant's Name & Mailing Address, (if other than stated hereon): <u>KPK Construction</u> <u>9375-G Germantown Lane</u> <u>Columbia MD 21046</u> Phone <u>410-290-9962</u> Fax <u>410-290-9967</u>
Existing Use <u>SFD</u> Proposed Use <u>SFD w/deck</u> Estimated Construction Cost \$ <u>15,000</u> Description of Work <u>Reduce existing exterior</u> <u>deck. Approx 830 sq ft w/5x12</u> <u>irregular shape 42'x20</u>	Contractor Company <u>KPK Construction</u> Contact Person <u>Kevin Kennedy</u> Address <u>9375-G Germantown Lane</u> City <u>Columbia</u> State <u>MD</u> Zip Code <u>21046</u> License No. <u>18614</u> Phone <u>410-290-9962</u> Fax <u>410-290-9967</u>
Occupant or Tenant <u>owner</u> Contact Name _____ Address _____ City _____ State _____ Zip Code _____ Phone _____ Fax _____	Engineer or Architect Company _____ Contact Person _____ Address _____ City _____ State _____ Zip Code _____ Phone _____ Fax _____

BUILDING DESCRIPTION - COMMERCIAL		BUILDING DESCRIPTION - RESIDENTIAL	
Building Characteristics Height: _____ No. of stories: _____ Gross area, sq. ft. per floor: _____ Use group: _____ Construction type: ☐ Reinforced Concrete ☐ Structural Steel ☐ Masonry ☐ Wood Frame ☐ State Certified Modular	Utilities Water Supply: ☐ Public ☐ Private Sewage Disposal: ☐ Public ☐ Private Electric Yes ☐ No ☐ Gas Yes ☐ No ☐ Heating System: Electric ☐ Oil ☐ Natural Gas ☐ Propane Gas ☐ Sprinkler system: N/A ☐ ☐ Full ☐ Partial ☐ Other Suppression ☐ # of Heads	Building Characteristics SF Dwelling ☒ SF Townhouse ☐ <u>Depth</u> <u>Width</u> 1st floor: _____ 2nd floor: _____ Basement: _____ Finished Basement ☐ Unfinished Basement ☐ Crawl space ☐ Slab on Grade ☐ No. of Bedrooms: _____ Multi-family dwellings: No. of efficiency units: _____ No. of 1 BR units: _____ No. of 2 BR units: _____ No. of 3 BR units: _____ Other Structure: _____ Dimensions: _____ Footings: _____ Roof: _____ ☐ State Certified Modular ☐ Manufactured Home	Utilities Water Supply: ☐ Public ☒ Private Sewage Disposal: ☐ Public ☒ Private Electric Yes ☒ No ☐ Gas Yes ☐ No ☒ Heating System: Electric ☒ Oil ☐ Natural Gas ☐ Propane Gas ☐ Sprinkler system: N/A ☒ ☐ NFPA #13D ☐ NFPA #13R ☐ Other:

THE UNDERSIGNED HEREBY CERTIFIES AND AGREES AS FOLLOWS: (1) THAT HE/SHE IS AUTHORIZED TO MAKE THIS APPLICATION; (2) THAT THE INFORMATION IS CORRECT; (3) THAT HE/SHE WILL COMPLY WITH ALL REGULATIONS OF HOWARD COUNTY WHICH ARE APPLICABLE THEREON; (4) THAT HE/SHE WILL PERFORM NO WORK ON THE ABOVE REFERENCED PROPERTY NOT SPECIFICALLY DESCRIBED IN THIS APPLICATION; (5) THAT HE/SHE GRANTS COUNTY OFFICIALS THE RIGHT TO ENTER ONTO THIS PROPERTY FOR THE PURPOSE OF INSPECTING THE WORK PERMITTED AND POSTING NOTICES.

Applicant's Signature <u>Kevin Kennedy</u> Title/Company <u>KPK Construction</u>	Print Name <u>Kevin Kennedy</u> Date <u>7/17/99</u>
---	--

Checks payable to: DIRECTOR OF FINANCE OF HOWARD COUNTY

** PLEASE WRITE NEATLY AND LEGIBLY **

- FOR OFFICE USE ONLY -

AGENCY ☒ Land Development DPZ ☐ State Highways ☒ Building Official ☒ Dev. Engineering DPZ ☒ Health ☐ Fire Protection	DATE <u>8/10/99</u>	SIGNATURE APPROVAL <u>Mark E. Riffen</u>	DPZ SETBACK INFORMATION Front: _____ Rear: _____ Side: _____ Side St.: _____ All minimum setbacks met? YES ☐ NO ☐ Is Entrance Permit required? YES ☐ NO ☐ Historic District? YES ☐ NO ☐ Lot Coverage for New Town Zone SDP/Red-line approval date _____	PROPERTY ID# <u>410898</u> Filing fee \$ <u>30</u> Permit fee \$ _____ Excise tax \$ _____ Sub-total paid \$ _____ Add'l permit fee \$ _____ TOTAL FEES \$ _____ Balance due \$ _____ Check # <u>10813</u> Validation # _____ Accepted by <u>[Signature]</u>
---	-------------------------------	--	--	--

CONTINGENCY CONSTRUCTION START: ☐
 ONE STOP SHOP: ☐

Distribution of Copies: White: Building Official Green: LDD, DPZ Yellow: DED, DPZ Pink: Health Gold: SHA

ELECTION DISTRICT : 5TH
COUNTY : HOWARD
SCALE : 1" = 100'
DATE : OCTOBER 8, 1987
REV : 5/23/90

2/16/88 AM
2/9/88
1735 PP
2-10-88
2/30

PERMIT

SEWAGE DISPOSAL SYSTEM

MARYLAND STATE DEPARTMENT OF HEALTH

HOWARD COUNTY
BUREAU OF ENVIRONMENTAL HEALTH
461-9933

INDEXED

P 40434

A 35006

DISTRICT 5th

DATE 11/6/87

DATE SYSTEM APPROVED 2/16/88

INSPECTOR (Signature)

Paul Schissler/South Carroll Backhoe, Inc. IS PERMITTED TO INSTALL X ALTER

ADDRESS 4410 Salem Bottom Road, Westminster, Maryland PHONE 875-4197

SUBDIVISION Waterford ROAD 13243 Westmeath Lane LOT 11

PROPERTY OWNER Lowrie Sargent

ADDRESS

IF GARBAGE GRINDER IS USED INCREASE SEPTIC TANK CAPACITY BY 50% AND ABSORPTION AREA BY 22%.

GARBAGE GRINDER? YES NO X

SEPTIC TANK CAPACITY 1250 GALLONS NUMBER OF BEDROOMS 4

240
3 720
6
120

TRENCHES - 180 sq. ft. per bedroom. With garbage disposal - 220 sq. ft. per bedroom.
Trench to be 3.0 feet wide. Inlet 5.0 feet below original grade Bottom
maximum depth 7.0 feet below original grade. Effective area begins at 5.0 feet
below original grade. 2.0 feet of stone below distribution pipe.

LOCATION - Place the distribution box 10 feet off the intersection of the right 131.37 ft
lot line and the right 410.57 ft. lot line. Run trenches on contour toward
the left lot line.

NOTE - No trench to exceed 100 feet in length. Provide 6" - 8" diameter cleanout and
and cap to grade or above on septic tank. (Signature)

PLANS APPROVED BY S. Abel DATE 11/05/87

COVER NO WORK UNTIL INSPECTED AND APPROVED.

NEITHER THE HOWARD COUNTY COUNCIL NOR THE HEALTH DEPARTMENT IS RESPONSIBLE FOR THE SUCCESSFUL OPERATION OF ANY SYSTEM.

NOTE: CLEANOUT REQUIRED EVERY 70 FEET OF SEWER LINE AND/OR AT 90° SWEEPS IN LINES FROM HOUSE TO DRAIN FIELDS.

NOTE: ALL PARTS OF SEPTIC SYSTEMS (I.E., TANK, DISTRIBUTION BOX, TRENCHES) TO BE 100 FEET FROM WELL (UNLESS OTHERWISE SPECIFICALLY AUTHORIZED)

NOTE: IF DEEP TRENCH(IES) ARE USED CALL FOR INSPECTION BEFORE AND AFTER PLACING GRAVEL IN TRENCH(IES).

NOTE: NO DRY WELL SHALL EXCEED 15 FOOT IN DIAMETER. NO ABSORPTION TRENCH TO EXCEED 100 FEET IN LENGTH.

NOTE: ALL PIPE FROM HOUSE TO SEPTIC TANK MUST BE CAST IRON OR SCHEDULE 40 PVC OR ABS.

PERMIT VOID AFTER TWO YEARS.

NOTE: INSTALL STAND PIPE ON SEPTIC TANK AND DRY WELL. STAND PIPES MUST BE 6 INCHES IN DIAMETER. CAST IRON, CONCRETE OR TERRA COTTA OR PVC OR ABS
ACCEPTED. IF TOP OF SEPTIC TANK IS DEEPER THAN 3 FEET, MANHOLE TO GRADE REQUIRED.

NOTE: DISTRIBUTION BOXES MUST HAVE BAFFLES.

EDG. PERMIT SIGNED

AND RETURNED 5-20-88

Serial # 234118124

detached Pool House

*INSTALLER IS RESPONSIBLE FOR OBTAINING FINAL APPROVAL ON THIS PERMIT

*CALL 461-9933 FOR INSPECTION OF SEPTIC SYSTEMS.

EH - 2-1186

A 35006

Need only 1 application with the below checked items completed

APPLICATION

SEWAGE DISPOSAL TESTING

STATE OF MARYLAND - DEPARTMENT OF HEALTH AND MENTAL HYGIENE

HOWARD COUNTY HEALTH DEPARTMENT
ENVIRONMENTAL HEALTH SERVICES
P. O. BOX 476 ELLICOTT CITY, MARYLAND 21043
TELEPHONE: 992-2330

A 35716

P _____

DISTRICT 5th

DATE 2-13-85

TO: THE COUNTY HEALTH OFFICER
ELLICOTT CITY, MARYLAND

I, HEREBY, APPLY FOR THE NECESSARY TEST IN ORDER TO CONSTRUCT (OR RECONSTRUCT) A SEWAGE DISPOSAL SYSTEM.

✓ PROPERTY OWNER Feral International, % Mrs. Gabriela M. Arroyo LOWKIE SARGENT
ADDRESS 1310 Eighteenth St., N.W., Washington, D.C., 20036 PHONE 202-457-0727

PROPERTY LOCATION: WATERFORD SECTION 3

✓ SUBDIVISION Huntington Estates - Section 2 LOT NO. DO LOT 11

✓ ROAD AND DESCRIPTION North side of Brighton Dam Road approximately 3400
feet west of Ten Oaks Road 13243 WESTMEATH LANE

✓ SIZE OF LOT 3+ acres TYPE BLDG. Residence
(NUMBER OF BEDROOMS)

THE SYSTEM INSTALLED UNDER THIS APPLICATION IS ACCEPTABLE ONLY UNTIL PUBLIC FACILITIES BECOME AVAILABLE. I FULLY UNDERSTAND THE

FEE CONNECTED WITH THE FILING OF THIS PERC TEST APPLICATION IS NON-REFUNDABLE UNDER ANY CIRCUMSTANCES. I ALSO AGREE TO COMPLY

WITH ALL M.O.S.H.A. REQUIREMENTS IN TESTING THIS LOT. Charles J. Amos
(SIGNATURE OF APPLICANT)

APPROVED BY Sidney Abel FOR Shallow test fields DATE 4-2-87

REJECTED BY _____ FOR _____ DATE _____

HOLD PENDING FURTHER TESTS _____ DATE _____

REASONS FOR REJECTION OR HOLDING 3-20-85 PERC RESULTS SATISFACTORY, HOLD FOR CERTIFIED

HOLE LOCATION, HOUSE AND WELL SITE. SAME SEDG. PERMIT SIGNED
AND RETURNED 8/8/87

BP 13785


THIS IS NOT A PERMIT

① ②
SOIL PROFILE

0	A1-3
6"	RED BROWN CLAY LOAM L10%
5'	SAPROLITE
	Yellow Brown Silty SAND 10-20%
	SAPROLITE
13'	

0	③
6"	A1-3
	RED BROWN CLAY LOAM L10%
4'	SAPROLITE
	Yellow Brown SAND SILT 20-30%
11'	SAPROLITE
	SAPROLITE SANDSTONE 40-50%
13'	STRUCTURED SANDSTONE AT 13'

0	④
6"	A1-3
	RED BROWN CLAY LOAM L10%
4'	SAPROLITE
	Yellow Brown Silty SAND 20-30%
10'	SAPROLITE
	SANDSTONE SAPROLITE 40-50%

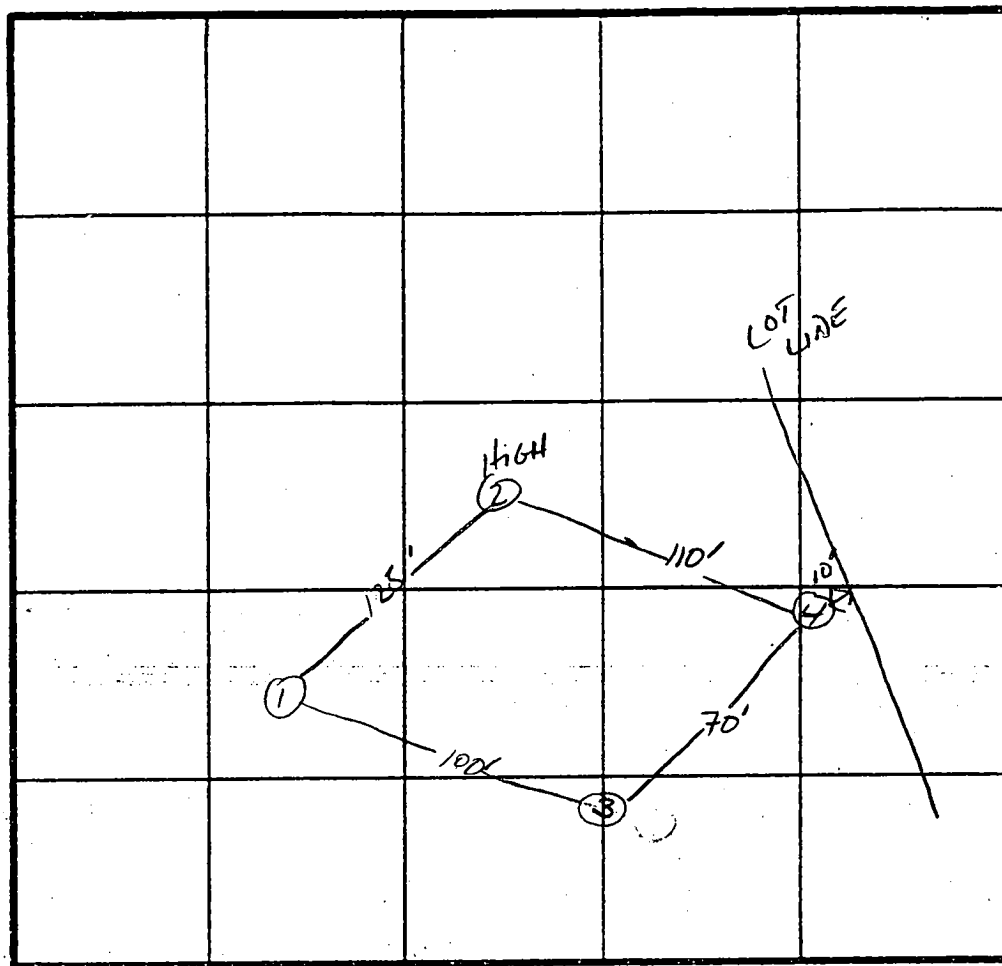

X PERC
6min
180°/R
IN LOT 5'
BOTTOM 7.0'



INDICATE NORTH - NAME ADJOINING ROADWAY AS BASE LINE.

BRIGHTON DAM Rd.

DATE	TEST NO.	DEPTH	PRE-WET		TEST - 1" DROP		TIME
			START	STOP	START	STOP	
3/20/85	15	6'	10:10	10:12	10:12	10:17	5min
	1V	13'	UNIFORM SOIL STRUCTURE Below 5'				
	25	6'	10:13	10:15	10:15	10:21	6min
	2V	13'	UNIFORM SOIL STRUCTURE Below 5'				
	35	5.5'	10:18	10:20	10:20	10:23	3min
	3V	13'	VARYING SOIL STRUCTURE SEE PROFILE				
	45	4'	10:22	10:25	10:25	10:33	8min
	4V	13'	SEE PROFILE VARYING SOIL STRUCTURE				

REMARKS: HOLES LOCATED PER PLAT APPROXIMATELY

TYPE OF SOIL: SAND
SKIP, LES, TERRY

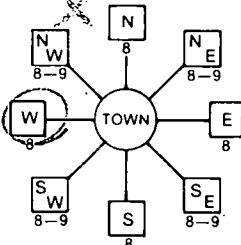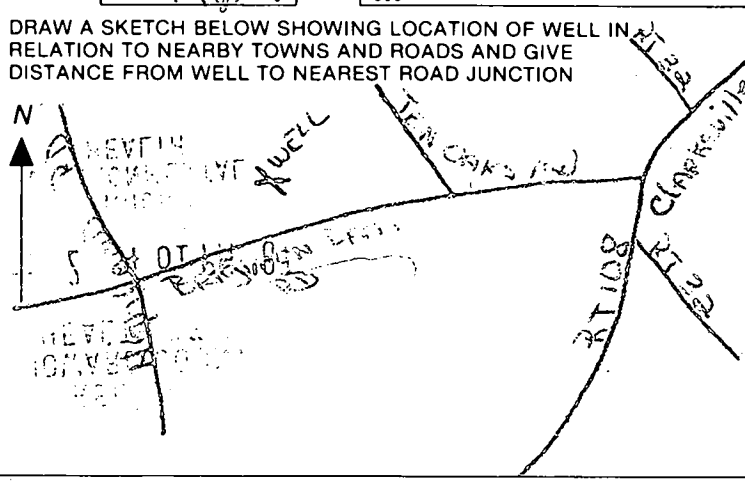B 1 7675 (THIS NUMBER IS TO BE PUNCHED IN COLS. 3-9 ON ALL CARDS)	SEQUENCE NO. (OEP USE ONLY) 6/10/87 2130	STATE OF MARYLAND PERMIT TO DRILL WELL please print or type	OEP PERMIT NUMBER 40-81-2070 fill in this form completely
Date Received OWNER INFORMATION 15 Last Name McDONOUGH 34 Owner JOHN First Name 36 6310 STEPHENS FOREST RD 55 Street or RFD 57 COLUMBIA 70 State 72 MD 76 Zip 21044		B 3 LOCATION OF WELL R-39017 1 HOWARD 21 COUNTY 23 SUBDIVISION WATERFORD 42 SECTION 3 46 LOT 11 50 52 NEAREST TOWN CLARKSVILLE 71 MILES FROM TOWN (enter 0 if in town) 1 73 MI 76 77 78	
DRILLER INFORMATION Driller's Name George F. Easterday 40 L. Franklin Easterday, Inc. Firm Name 6265 Brown Church RD., Mt. Airy, MD. 21771 Address Signature George F. Easterday 3/10/87 Date		B 4 DIRECTION OF WELL FROM TOWN (CIRCLE BOX)  ON WHICH SIDE OF ROAD (CIRCLE APPROPRIATE BOX) NORTH ☒ N ☐ NE ☐ E ☐ SE ☐ S ☐ SW ☐ W ☐ NW WEST EAST SOUTH 34 2000 37 DISTANCE FROM ROAD ENTER FT or MI FT 38 39	
B 2 WELL INFORMATION APPROX. PUMPING RATE (GAL. PER MIN.) 5 8 12 AVERAGE DAILY QUANTITY NEEDED (GAL. PER DAY) 500 14 20		NOT TO BE FILLED IN BY DRILLER HEALTH DEPARTMENT APPROVAL COUNTY NAME HOWARD COUNTY NO. A-35006 OEP SIGNATURE _____ STATE HEALTH INSERT S _____ DATE ISSUED 05/11/87 43 CO SIGNATURE B. Walker 48 EXP. DATE 01/11/87 NORTH GRID 499 000 50 55 EAST GRID 0807 000 57 63	
USE FOR WATER (CIRCLE APPROPRIATE BOX) ☒ HOME (SINGLE OR DOUBLE HOUSEHOLD UNIT ONLY) ☐ FARMING (LIVESTOCK WATERING & AGRICULTURAL IRRIGATION) ☐ INDUSTRIAL, COMMERCIAL, STATE AND FEDERAL GOV. OTHER (REQUIRES APPROPRIATION PERMIT) ☐ PUBLIC OR PRIVATE WATER COMPANY (REQUIRES APPROPRIATION PERMIT AND STATE HEALTH DEPARTMENT APPROVAL) ☐ TEST, OBSERVATION, MONITORING (MAY REQUIRE APPROPRIATION PERMIT)		SHOW MAJOR FEATURES OF BOX & LOCATE WELL WITH AN X SOURCES OF DRILLING WATER 1. WELL 2. 3. WRITE THE BOX NUMBER FROM THE MAP HERE E 8067 N 4909 000 000	
APPROXIMATE DEPTH OF WELL 200 24 28 FEET APPROXIMATE DIAMETER OF WELL 6 NEAREST INCH		DRAW A SKETCH BELOW SHOWING LOCATION OF WELL IN RELATION TO NEARBY TOWNS AND ROADS AND GIVE DISTANCE FROM WELL TO NEAREST ROAD JUNCTION 	
METHOD OF DRILLING (circle one) BORED (or Augered) ☒ JETTED ☐ Jetted & DRIVEN ☐ 30. AIR-ROTARY 37 AIR-PERCussion ROTARY (Hydraulic Rotary) CABLE REVERSE-ROTARY DRIVE-POINT other _____		REPLACEMENT OR DEEPEMED WELLS (CIRCLE APPROPRIATE BOX) ☒ THIS WELL WILL NOT REPLACE AN EXISTING WELL ☐ THIS WELL WILL REPLACE A WELL THAT WILL BE ABANDONED AND SEALED 39 ☐ THIS WELL WILL REPLACE A WELL THAT WILL BE USED AS A STANDBY ☐ THIS WELL WILL DEEPEN AN EXISTING WELL PERMIT NUMBER OF WELL TO BE REPLACED OR DEEPEMED (IF AVAILABLE) 41 _____ 52	
Not to be filled in by driller (OEP USE ONLY) APPROP. PERMIT NUMBER _____ 54 GAP _____ 63 FORCE Ra WRITE INITIALS IN BOX PERMIT NO. 40-81-2070 67 68 70 71 72 73 74 75 76 77 78 79		SPECIAL CONDITIONS	

C 1 2422		SEQUENCE NO. (OEP USE ONLY)		STATE OF MARYLAND WELL COMPLETION REPORT FILL IN THIS FORM COMPLETELY PLEASE PRINT OR TYPE		THIS REPORT MUST BE SUBMITTED WITHIN 45 DAYS AFTER WELL IS COMPLETED.	
(THIS NUMBER IS TO BE PUNCHED IN COLS. 3-6 ON ALL CARDS)						COUNTY NUMBER A 35006	
DATE Received.		DATE WELL COMPLETED		Depth of Well		PERMIT NO.	
8 13		15 20		22 26		FROM "PERMIT TO DRILL WELL"	
		061087		(TO NEAREST FOOT)		NO-81-2070	
OWNER		Mc DONOUGH BUILDERS		JOHN			
STREET OR RFD		BRIGHTON DAM ROAD		TOWN		CLARKSVILLE	
SUBDIVISION		WATER FOR		SECTION 3		LOT 11	
WELL LOG Not required for driven wells		GROUTING RECORD		PUMPING TEST			
STATE THE KIND OF FORMATIONS PENETRATED, THEIR COLOR, DEPTH, THICKNESS AND IF WATER BEARING		WELL HAS BEEN GROUTED (Circle Appropriate Box)		HOURS PUMPED (nearest hour)		3	
DESCRIPTION (Use additional sheets if needed)		TYPE OF GROUTING MATERIAL		PUMPING RATE (gal. per min. to nearest gal.)		12	
FEET		CEMENT ☒ CM BENTONITE CLAY ☒ BC		METHOD USED TO MEASURE PUMPING RATE		Buchot	
FROM TO		NO. OF BAGS 25 NO. OF POUNDS 2500		WATER LEVEL (distance from land surface)		BEFORE PUMPING 46	
Check if water bearing		GALLONS OF WATER 125		WHEN PUMPING 63			
		DEPTH OF GROUT SEAL (to nearest foot)		TYPE OF PUMP USED (for test)		A air P piston T turbine	
		from 0 ft. to 80 ft.		C centrifugal R rotary O other (describe below)			
		(enter 0 if from surface)		J jet S ☒ submersible			
Topsoil 0 2		CASING RECORD					
Br. mica 2 114		casing types insert appropriate code below					
Tan mica 114 132		ST CO PL OT					
Br. mica & Clay 132 147		STEEL CONCRETE PLASTIC OTHER					
Gray mica 147 160		MAIN CASING TYPE					
		Nominal diameter top (main) casing (nearest inch)					
		Total depth of main casing (nearest foot)					
		OTHER CASING (if used)					
		diameter inch					
		depth (feet) from to					
		SCREEN RECORD					
		screen type or open hole insert appropriate code below					
		ST BR HO PL OT					
		STEEL BRASS OPEN HOLE PLASTIC OTHER					
		DEPTH (nearest ft.)					
		1 2 3 80					
		SLOT SIZE 1 2 3					
		DIAMETER OF SCREEN (NEAREST INCH)					
		GRAVEL PACK IF WELL DRILLED WAS FLOWING WELL INSERT F IN BOX 68					
		OEP USE ONLY (NOT TO BE FILLED IN BY DRILLER)					
		T (E.R.O.S.) W Q					
		70 72 74 75 76					
		TELESCOPE CASING LOG INDICATOR OTHER DATA					
CIRCLE APPROPRIATE LETTER A A WELL WAS ABANDONED AND SEALED WHEN THIS WELL WAS COMPLETED E ELECTRIC LOG OBTAINED P TEST WELL CONVERTED TO PRODUCTION WELL		I HEREBY CERTIFY THAT THIS WELL HAS BEEN CONSTRUCTED IN ACCORDANCE WITH COMAR 10.17.13 "WELL CONSTRUCTION" AND IN CONFORMANCE WITH ALL CONDITIONS STATED IN THE ABOVE CAPTIONED PERMIT, AND THAT THE INFORMATION PRESENTED HEREIN IS ACCURATE AND COMPLETE TO THE BEST OF MY KNOWLEDGE.		LOCATION OF WELL ON LOT SHOW PERMANENT STRUCTURE SUCH AS BUILDING, SEPTIC TANKS, AND/OR LANDMARKS AND INDICATE NOT LESS THAN TWO DISTANCES (MEASUREMENTS TO WELL)		Rear lot line 200' Well 100'	
DRILLERS IDENT. NO. 40		DRILLERS SIGNATURE (MUST MATCH SIGNATURE ON APPLICATION)		SITING SUPERVISOR (sign of driller or journeyman responsible for sitework if different from permittee)			

FIELD DATA SHEET
HYDROGEOLOGIC AREA (7) WELL YIELD TEST

Maryland Well Permit No. 81-2070

Election District

Location of Property (road) Brighton Dam Rd.

Subdivision Water Ford Lot 11 Block Plat Sec.

Well Driller George Easterday Owner McDonough Builders, John

Depth of Well 160 40 GPM

Distance of Measuring Point (M.P.) above ground 2 ft

Static Water Level (S.W.L.) below M.P. 46

I. High Rate Pumping -- reservoir drawdown

Time pump started 10:30

Pumping rate 12 gpm

Total time 15 min to reach pumping water level 59 ft. below M.P.

II. Recovery pump test data - observations to be recorded every 15 minutes.

MIN. TIME	WATER LEVEL Below M.P.	PUMPING RATE Time to fill <u>5</u> gal. bucket	FLOW METER READING (if used)	CALCULATED FLOW (gallons per min.)
10:45	59'	25 Sec	1/4	12 gpm
11:00	62'	25 Sec	pump at 80'	12 gpm
11:15	64'	25	R. Hagan	12
11:30	64'	25		12
11:45	64'	25		12
12:00	65'	25		12
12:15	64'	25		12
12:30	63'	25		12
12:45	63'	25		12
1:00	63'	25		12
1:15	63'	25		12
1:30	63'	25		12
1:45	63'	25		12


DRILLER

SITE SUPERVISOR (sign of driller or journeyman responsible for sitework if different from permittee)

TELESCOPE CASING

LOG INDICATOR

OTHER DATA

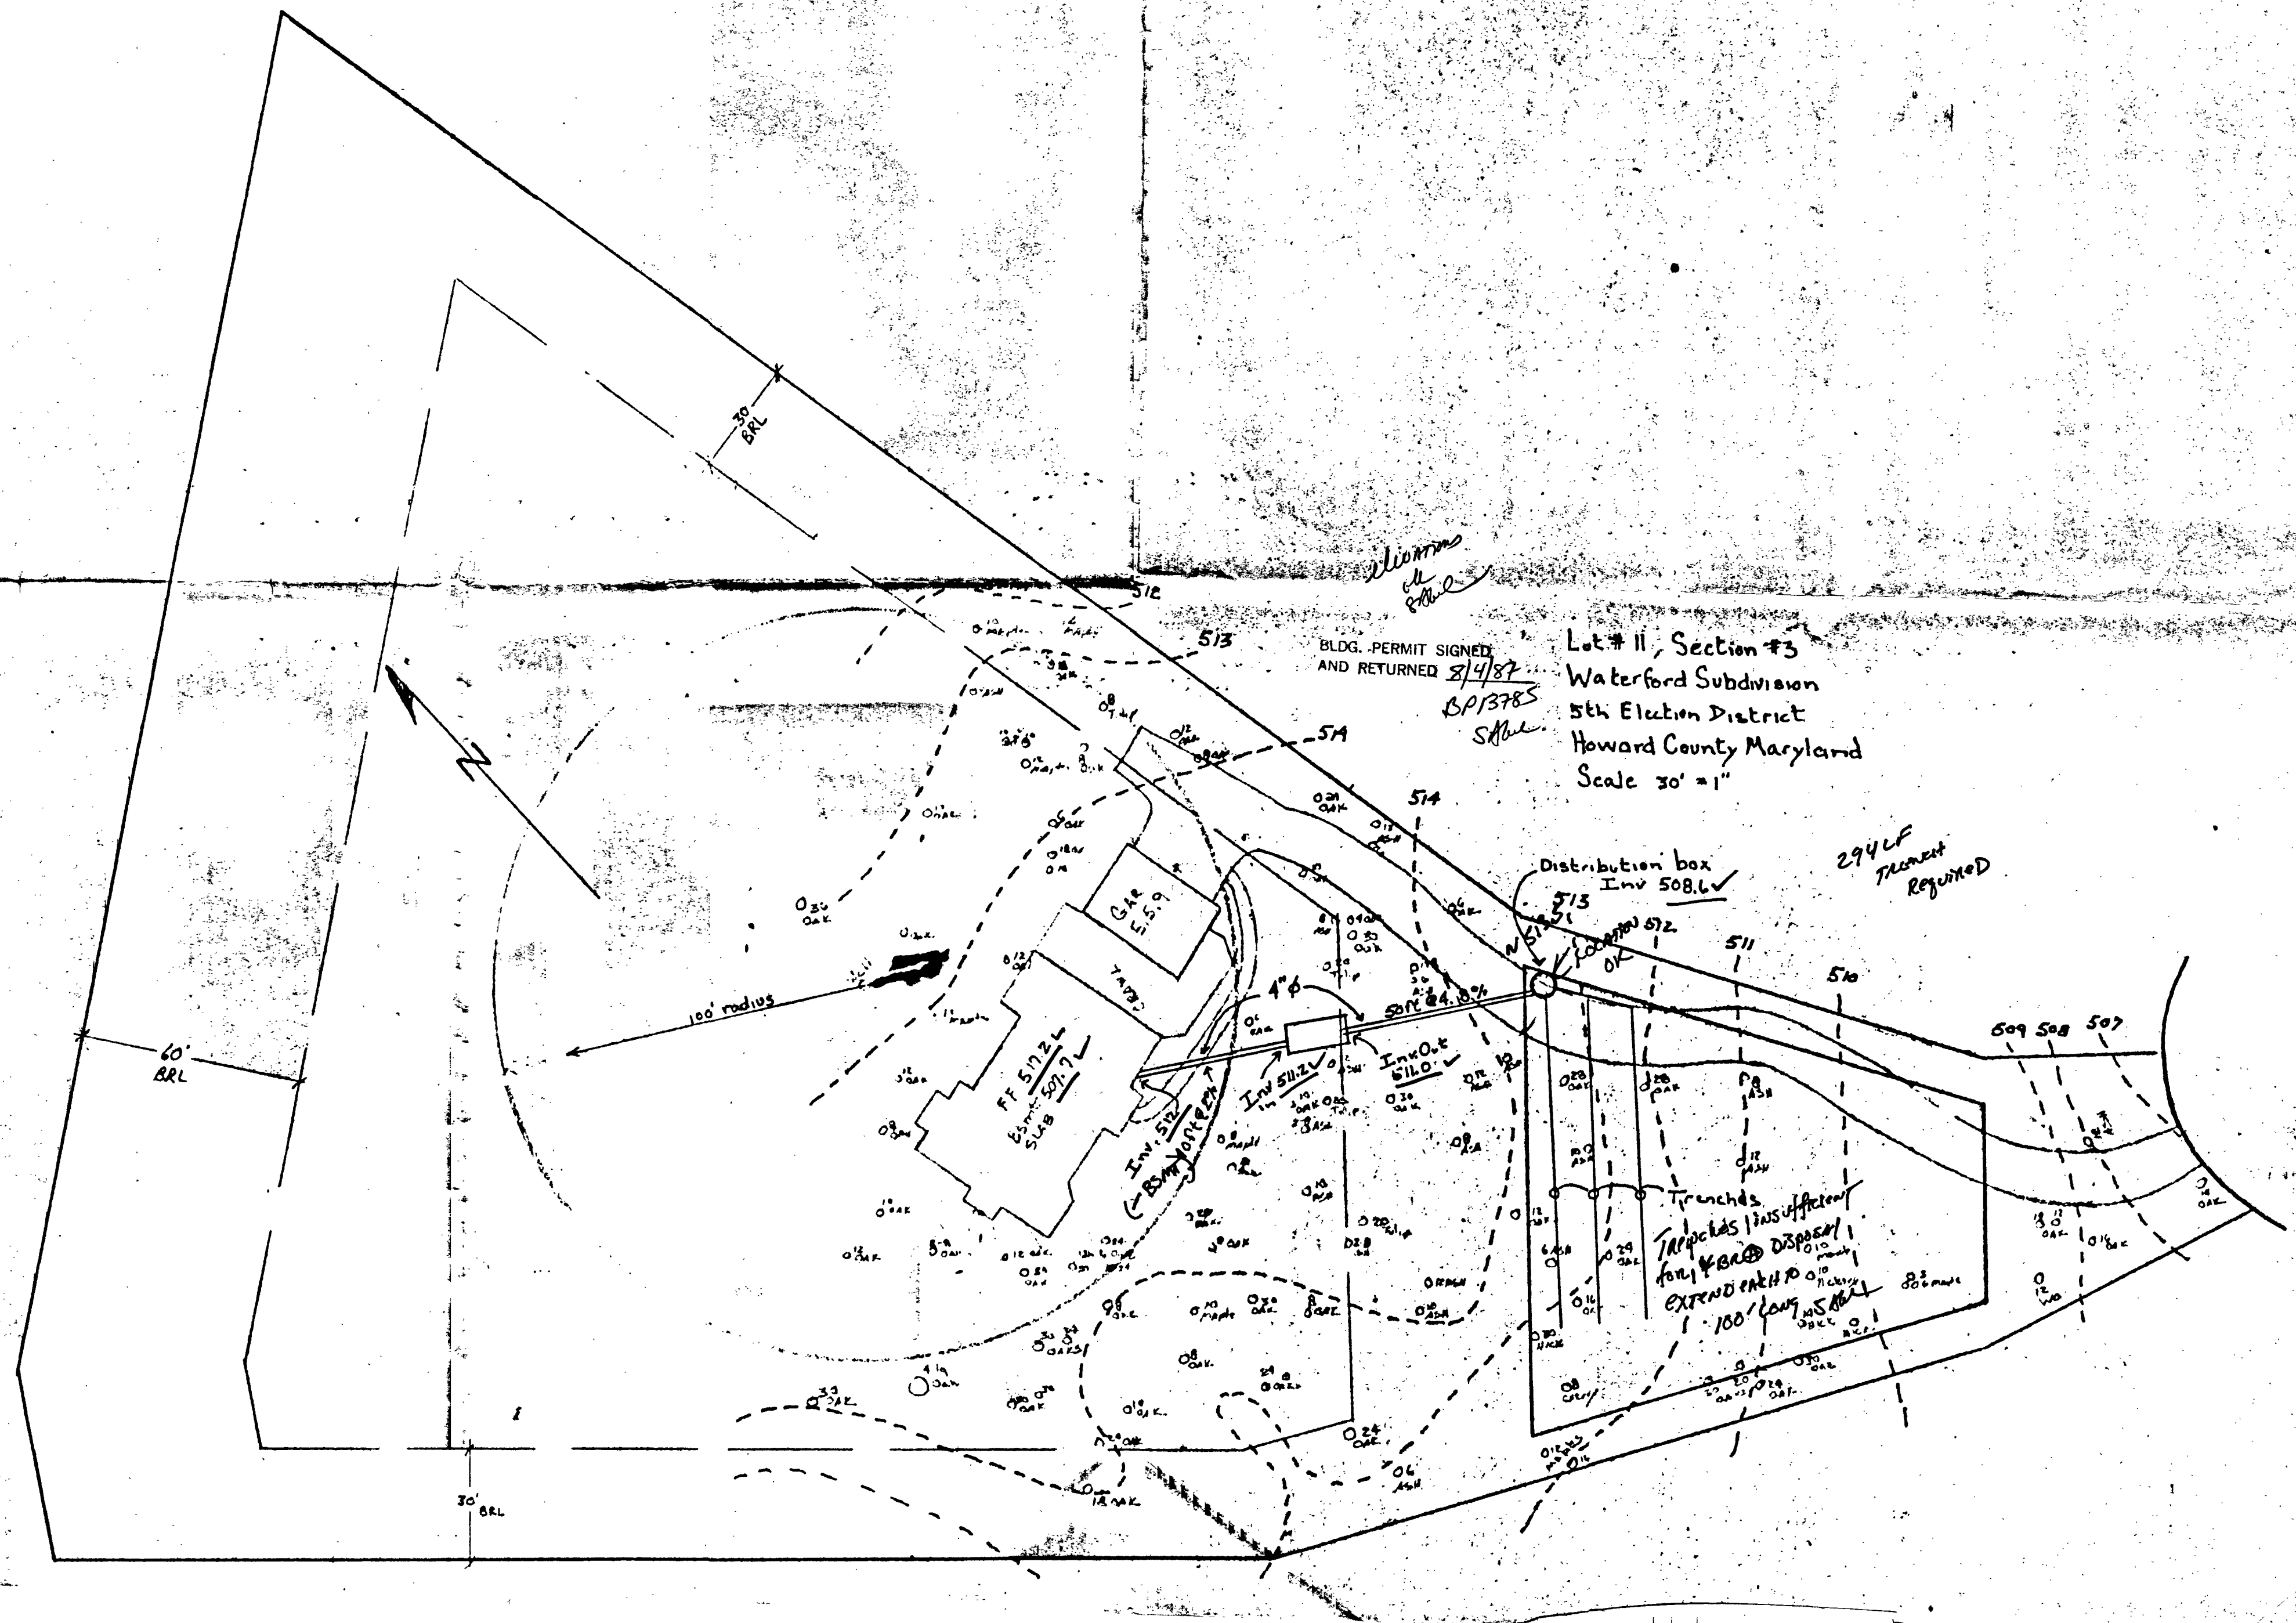

BLDG. PERMIT SIGNED
AND RETURNED 8/4/87
BP13785
SAB

Lot # 11, Section #3
Waterford Subdivision
5th Election District
Howard County Maryland
Scale 30' = 1"

294 LF
Trench
Required

Trenches
1155.4 ft long
for 1/2\"/>

2/10/87
10/11/87
2-10-87
2000

HOWARD COUNTY HEALTH DEPARTMENT
Bureau of Environmental Health
3525-H Ellicott Mills Drive
Ellicott City, MD 21043
461-9933

APPLICATION FOR PITLESS ADAPTER, WELL PUMP AND PRESSURE TANK INSTALLATION

New Installation ☒
Replacement ☐

Receipt # 39017
Date 4/3/87

Name of Installer L. Franklin Easterday

Telephone 829-1640

License Number _____
Certified Well Pump Installer _____ Well Driller _____ Registered Plumber _____

Name of Property Owner Lowrie Sargent Telephone _____
Subdivision Waterford Lot # 11 Well Tag # 140-81-2070
Site Address 13243 Westmeath Lane

Pump Motor Pitless Adapter
1. Type 1. Horsepower 1. Make
a. Deep well jet 2. RPM 2. Model #
b. Shallow well jet 3. Voltage 3. Depth
c. Submersible a. 110
2. Make b. 220
3. Model #
4. Capacity _____ GPM
5. Pump exceeds well capacity Yes _____ No _____
6. If Yes, is low pressure cutoff switch installed? Yes _____ No _____
7. What methods are used to protect the pump and electrical wiring from vibrations? Torque arrestors _____ Cable guards _____ Other _____

Tank Piping Well data
1. Capacity 1. Type 1. Depth 160 ft.
2. Pressure relief valve? 2. Size 2. Yield 12 GPM
3. NSF and/or BOCA Code approved 3. Static water level 46 ft.
4. Depth of supply line 4. Will water supply be disinfected by installer? NO

I understand that it is my responsibility to notify the Howard County Health Department when the installation is ready for inspection (otherwise this permit is null and void).


All information given above is true to the best of my knowledge.

Signature of Applicant: _____

Date: _____



Note: A sticker indicating approval/status of the installation will be placed on the well casing at the time of the inspection.

HD-215 111133-OK TO COVER OUTSIDE WORK PRESSURE TANK NOT YET IN PLACE RA. STICKER APPLIED

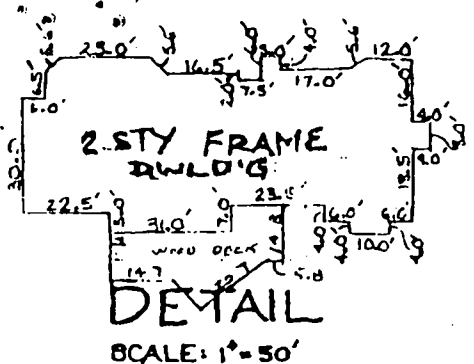

NOTES:

TOP FDTN ELEV 516.79

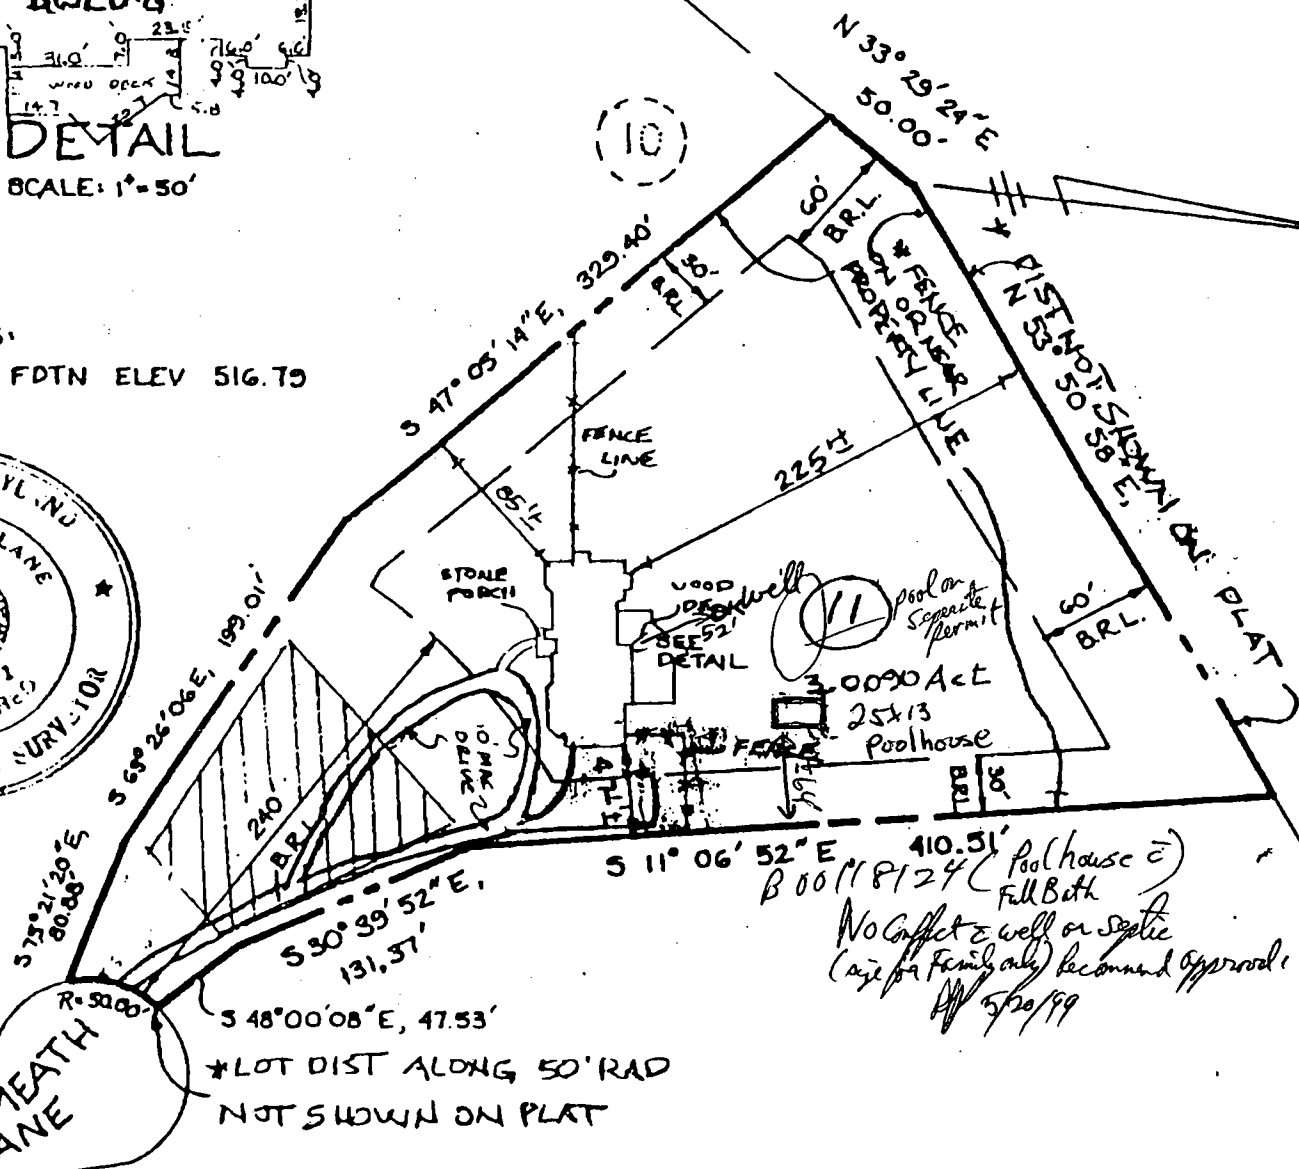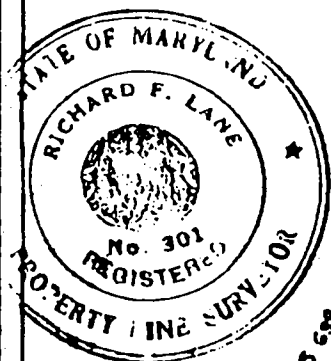

I HEREBY CERTIFY THAT I HAVE LOCATED THE IMPROVEMENTS AS SHOWN. THIS PLAT DOES NOT REPRESENT A BOUNDARY SURVEY & CANNOT BE USED TO ESTABLISH PROPERTY LINES OR CORNERS.

Richard F. Lane 10/8/87
SHANABERGER & LANE REV 5/23/90
 8726 TOWN & COUNTRY BLVD.
 SUITE 203
 ELLKOTT CITY, MD. 21043
 (301) 461-9563



AS-BUILT CERTIFICATION
WATERFORD
 LOT # 11
 SECTION 3
 PLAT # 7310

ELECTION DISTRICT : 5TH
 COUNTY : HOWARD
 SCALE : 1"=100'
 DATE : OCTOBER 8, 1987
 REV : 5/23/90

SECTION 3
 WATERFORD
 LOT 11
 1" = 30' NTS
 SITE PLAN

WESTMEAT LANE

800/17613
 No conflict with well
 or Septic
 & flood zone
 P/W 4/29/99

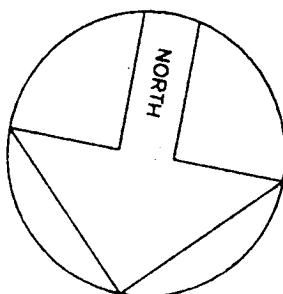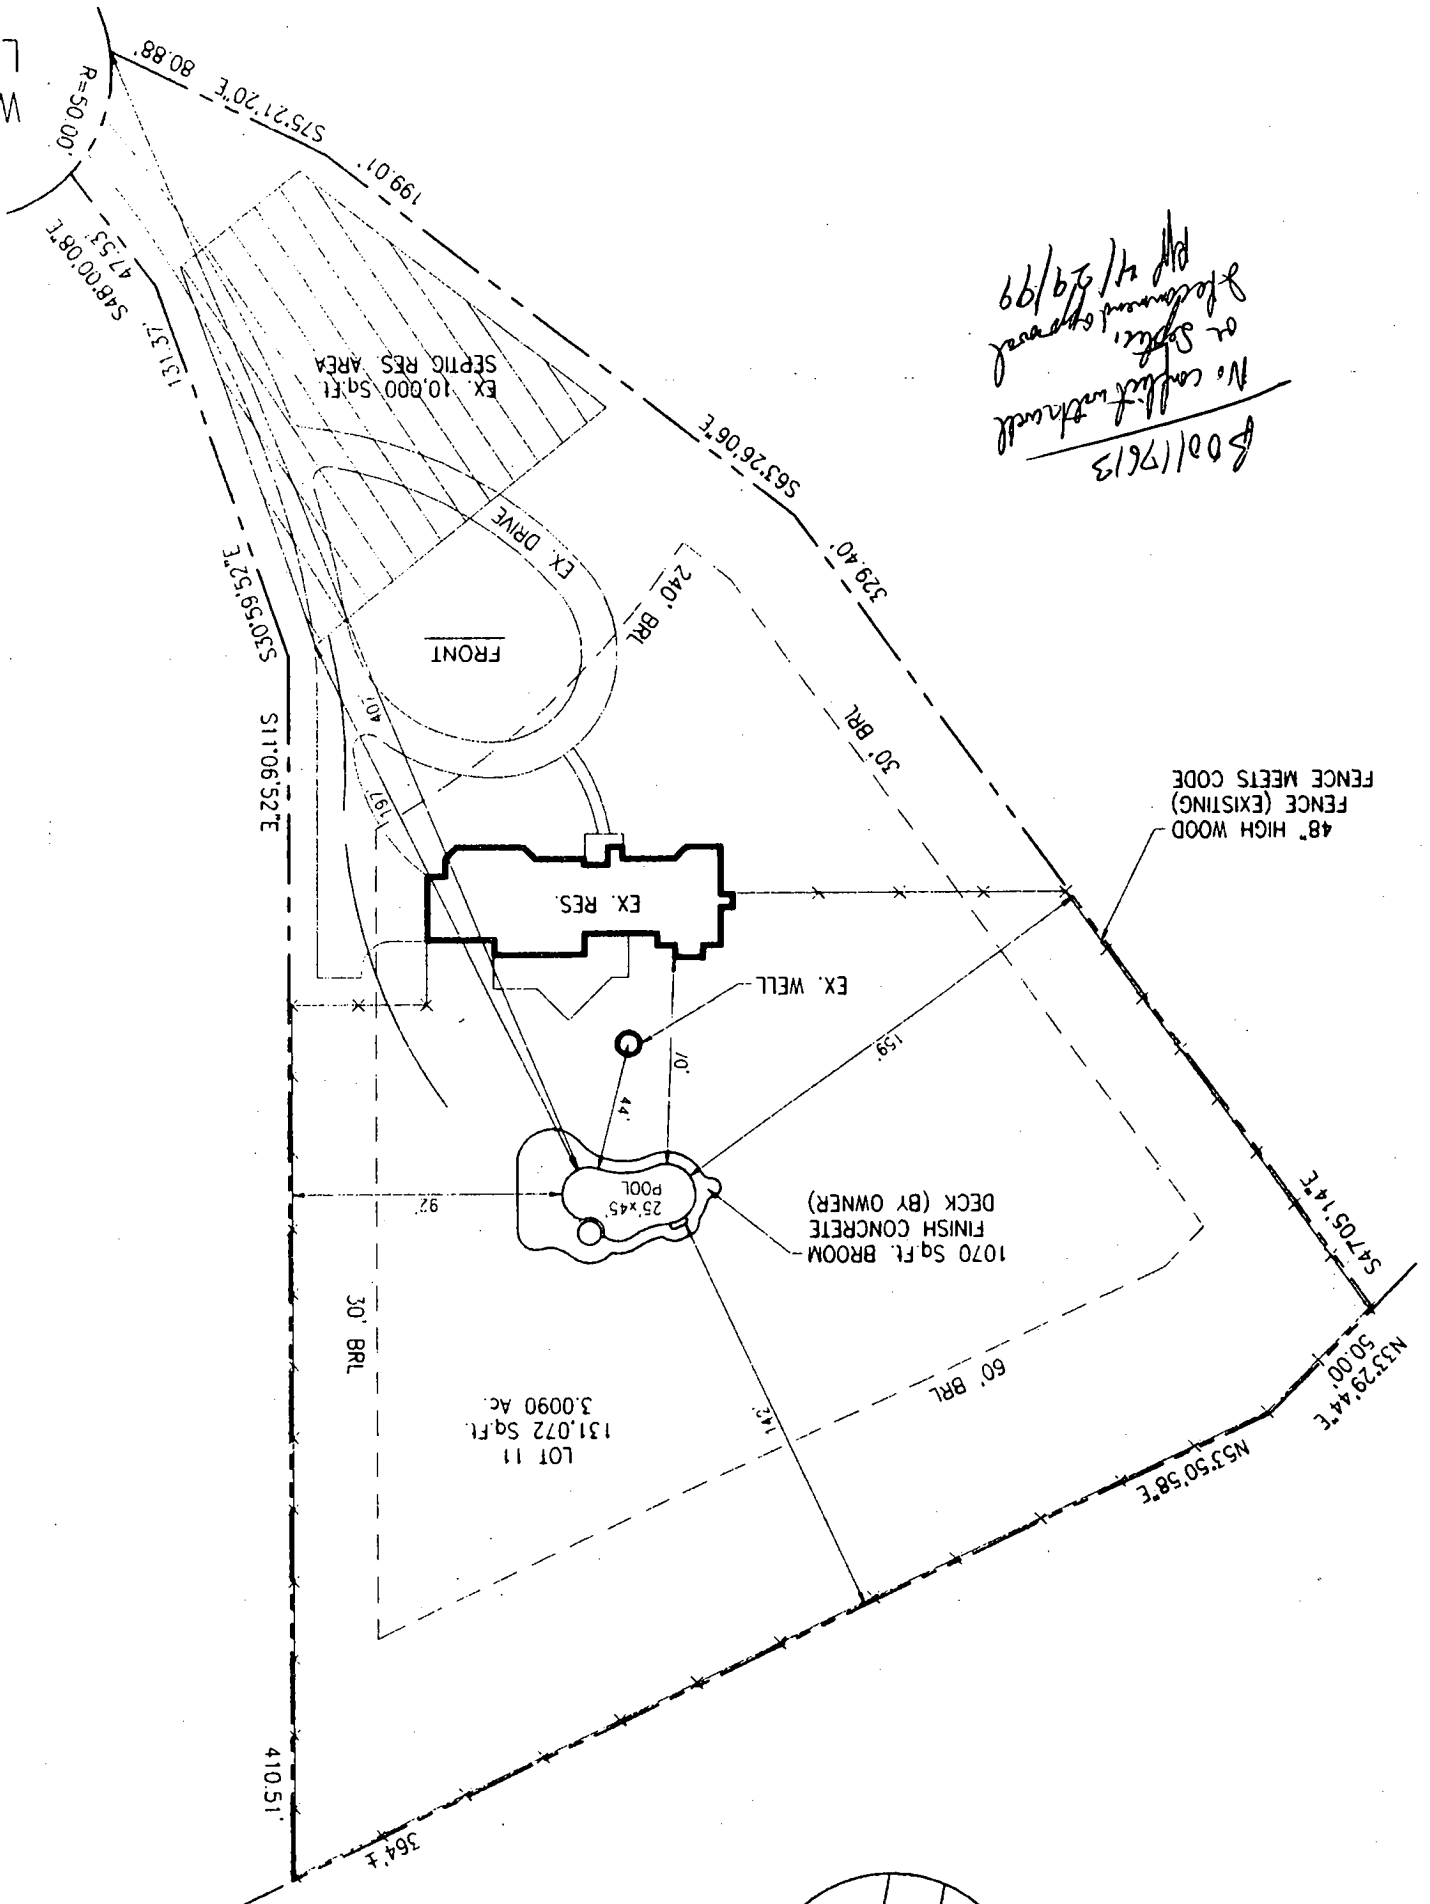

PRIVATE WELL
 & SEPTIC

ETBACKS:
 EAR PL. 10'
 IDE PL. 30'
 HOUSE 10'
 SEPTIC 20'
 WELL 30'