

PERMIT

SEWAGE DISPOSAL SYSTEM

DEPARTMENT OF HEALTH AND MENTAL HYGIENE

P 511975

A REPAIR

DISTRICT

DATE 6/25/99

HOWARD COUNTY HEALTH DEPARTMENT

BUREAU OF ENVIRONMENTAL HEALTH

~~XXXXXX~~ 410-313-2640

DATE SYSTEM APPROVED 6/26/99

INSPECTOR *AV*

INDEXED

RPS# 370361

Jack Fyock Septic Services

IS PERMITTED TO INSTALL ☐ ALTER ☒

ADDRESS P.O. Box 89, Triadelphia Road, Glenelg, Maryland 21737 PHONE 410-988-9270

SUBDIVISION LOT ROAD 4481 Ten Oaks Road

PROPERTY OWNER Vlach

ADDRESS 4481 Ten Oaks Road

Glenwood, Maryland 21738

SEPTIC TANK CAPACITY 1000 GALLONS

NUMBER OF BEDROOMS 3

SQUARE FEET PER BEDROOM

LINEAR FEET OF TRENCH REQUIRED

REPAIR -- PURPOSE - Septic System Failing.

Call for inspection when ground is opened so sanitarian can recommend repair. 06/21/1999

PLANS APPROVED BY DATE

COVER NO WORK UNTIL INSPECTED AND APPROVED

NEITHER THE HOWARD COUNTY COUNCIL NOR THE HEALTH DEPARTMENT IS RESPONSIBLE FOR THE SUCCESSFUL OPERATION OF ANY SYSTEM

NOTE: CLEANOUT REQUIRED EVERY 70 FEET OF SEWER LINE AND/OR AT 90° SWEEPS IN LINES FROM HOUSE TO DRAIN FIELDS. 90° ELBOWS NOT ACCEPTABLE.

NOTE: ALL PARTS OF SEPTIC SYSTEMS (I.E. TANK, DISTRIBUTION BOX TRENCHES) TO BE 100 FEET FROM WELL (UNLESS OTHERWISE SPECIFICALLY AUTHORIZED)

NOTE: IF DEEP TRENCH(ES) ARE USED CALL FOR INSPECTION BEFORE AND AFTER PLACING GRAVEL IN TRENCH(ES)

NOTE: NO DRY WELL SHALL EXCEED 15 FOOT IN DIAMETER NO ABSORPTION TRENCH TO EXCEED 100 FEET IN LENGTH

NOTE: ALL PIPE FROM HOUSE TO SEPTIC TANK MUST BE CAST IRON OR SCHEDULE 35/40 PVC OR ABS

PERMIT VOID AFTER TWO YEARS

NOTE: INSTALL STAND PIPE ON SEPTIC TANK AND DRY WELL STAND PIPES MUST BE 6 INCHES IN DIAMETER CAST IRON, CONCRETE OR TERRA COTTA OR PVA OR ABS ACCEPTED. IF TOP OF SEPTIC TANK IS DEEPER THAN 3 FEET, MANHOLE TO GRADE REQUIRED.

NOTE: DISTRIBUTION BOXES MUST HAVE BAFFLES

*INSTALLER IS RESPONSIBLE FOR OBTAINING FINAL APPROVAL ON THIS PERMIT


*CALL 481-9933 FOR INSPECTION OF SEPTIC SYSTEM.

511975

125
3
375

A
no distinct
clayey
bright red
to pink
SiSalm
10% micaceous
saprolite

12.5
75
51375
35
25

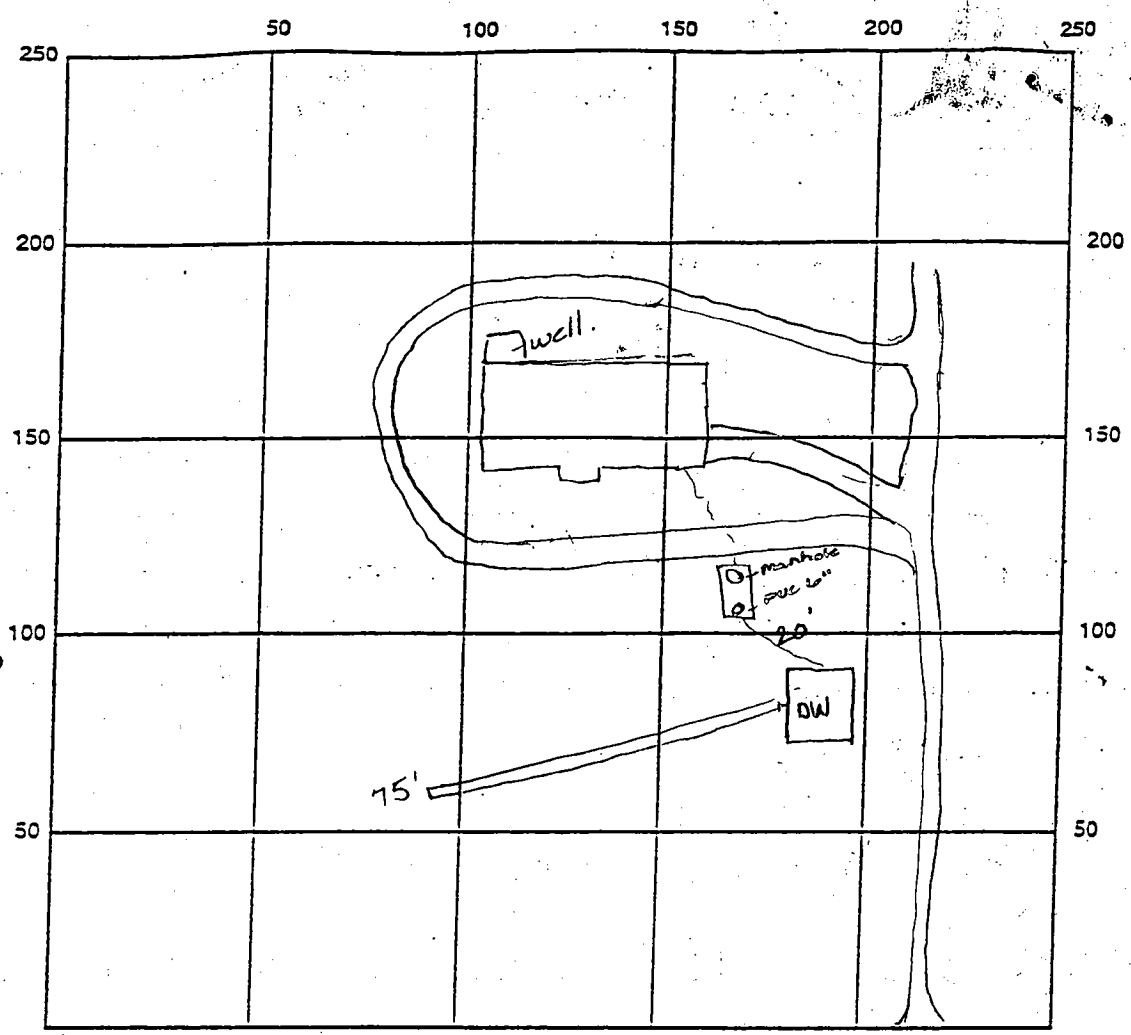

Ten Oaks INDICATE NORTH - NAME ADJOINING ROADWAY AS BASE LINE

SEPTIC TANK LEVEL N/A CLEANOUTS N/A

DISTRIBUTION BOX LEVEL N/A

DRAIN FIELD/TILE DEPTH 8.5 FT. TRENCH WIDTH 2.0 FT. INLET DEPTH 3.5 FT.

EFFECTIVE GRAVEL DEPTH 5.0 FT. TOTAL LENGTH 7.5 FT.

NUMBER OF TRENCHES 1 ONE SIDEWALL/BOTTOM AREA 375 SQ. FT.

DRYWALL INSIDE DIAMETER FT. EFFECTIVE DEPTH BELOW INLET 5.0 FT.

ABSORBENT AREA SQ. FT.

REMARKS: 6/25/99 OK to cover all work *A*

DATE SYSTEM APPROVED 6/25/99 INSPECTOR Amy McMillen

11/20/74 partial work
11/26/74 final OK work

PERMIT

P 20949
A 20558

SEWAGE DISPOSAL SYSTEM

MARYLAND STATE DEPARTMENT OF HEALTH

HOWARD COUNTY

ELLICOTT CITY

DISTRICT 5th

INDEXED

DATE 11/18/74

Jack Fyock

IS PERMITTED TO INSTALL X ALTER

ADDRESS Ten Oaks Road, Glenelg, Maryland PHONE 286-2939

SEWAGE DISPOSAL SYSTEM LOCATED AT

SUBDIVISION ROAD 4481 Ten Oaks Road LOT

PROPERTY OWNER Mr. Wilbur M. Vlach

ADDRESS Ten Oaks Road, Dayton, Maryland Phone: 531-5533

SPECIFICATIONS 3 bedrooms

DRAIN FIELD DEPTH FEET, BOTTOM AREA SQ. FT.

SEEPAGE PITS ABSORBENT SIDE-WALL AREA SQ. FT.

SEPTIC TANK CAPACITY 1000 GALLONS

FOR GARBAGE GRINDER, INCREASE DISPOSAL AREA 22% & TANK CAPACITY 50%.

OTHER DRY WELL - To have 130 sq. ft. effective absorbent sidewall area per bedroom below inlet. Inlet to be 3 ft. below original grade and maximum depth 11 ft. Locate dry well 150 ft. from edge of Ten Oaks Road and 20 ft. in from right property line as seen when facing lot from Ten Oaks Road.

NOTE: ALL PIPE FROM HOUSE TO DISPOSAL AREA MUST BE CAST IRON.
PERMIT VOID AFTER THREE YEARS.

NOTE: INSTALL STAND PIPE ON SEPTIC TANK AND DRY WELL. STAND PIPES MUST BE 6 INCHES IN DIAMETER - CAST IRON, CONCRETE OR TERRA COTTA ACCEPTED.


PLANS APPROVED BY Charles B. Streaker DATE 9/5/74

FILL SEPTIC TANK AND DISTRIBUTION BOX WITH WATER BEFORE CALLING FOR AN INSPECTION. COVER NO WORK UNTIL INSPECTED AND APPROVED.

NEITHER THE HOWARD COUNTY COMMISSIONERS NOR THE HEALTH DEPARTMENT IS RESPONSIBLE FOR THE SUCCESSFUL OPERATION OF ANY SYSTEM.

A 20558

20558

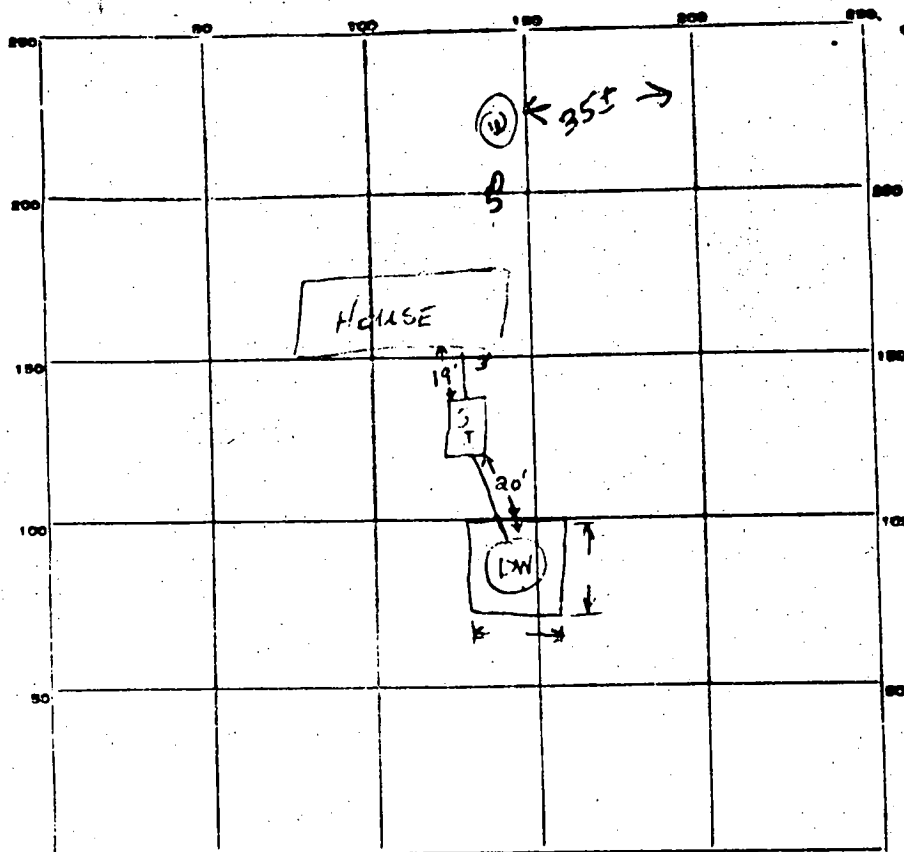

INDICATE NORTH - NAME ADJOINING ROADWAY AS BASE LINE
TEN OAKS RD

PERMIT CARD ☒

SEPTIC TANK, LEVEL ☒

CLEANOUTS Manhole ☒ DW

DISTRIBUTION BOX, LEVEL ☐

TILE FIELD, DEPTH _____ FT. TRENCH WIDTH _____ FT.

GRAVEL DEPTH _____ IN. TOTAL LENGTH _____ FT.

NUMBER OF TRENCHES _____ TOTAL BOTTOM AREA _____

SEEPAGE PITS, INSIDE DIAMETER 13x13 FT. DEPTH BELOW INLET 7 1/2 FT.

ABSORBENT AREA 390 SQ. FT.

REMARKS 11/22/74 All approved except no cover on manhole.

W ST

WWZ

11/26/74 All OK.

52
7 1/2
369
26
390

[illegible]

Elyria Ohio - 74								
DATE	TEST NO.	DEPTH	PRE-WET		TEST		DROP	TIME
			START	STOP	START	STOP		
7/5/51	1	3'	9:44	9:46	9:46	9:50	4m	
	② 2	11'	9:44	9:46	9:46	9:49	3m	
	3	2 1/2'	9:51	9:52	9:52	9:54	2m	
	④ 4	11'	9:50	10:02	10:02	10:25	23-	
	-	5'	10:02	10:10	10:10	10:20	10m	
	⑤ 5	11'	9:55	9:59	9:59	10:07	8m	
10/5/51	6	1 1/2'	10:00	10:01	10:01	10:03	23	
						6/50		

REMARKS

TYPE OF SOIL

ALSO PRESENT