

PUB. SEWER STATUS VERIFIED BY _____

RPS# ?

ISSUE DATE: 5/26/2000

P _____

APPROVAL DATE: _____

A W511551

**PERMIT
INDEXED**

**ON-SITE SEWAGE DISPOSAL SYSTEM
HOWARD COUNTY HEALTH DEPARTMENT
BUREAU OF ENVIRONMENTAL HEALTH**

_____ IS PERMITTED TO INSTALL ALTER

ADDRESS: _____ PHONE NUMBER: _____

SUBDIVISION: Cissel Property LOT NUMBER: TM 7, P136

ADDRESS: Woodbine Road (Route 94) PROPERTY OWNER: Lambert Cissel

SEPTIC TANK CAPACITY (GALLONS): _____

PUMP CHAMBER CAPACITY (GALLONS): _____

NUMBER OF BEDROOMS: _____

SQUARE FEET PER BEDROOM: _____

LINEAR FEET OF TRENCH REQUIRED: _____

TRENCHES:	Trench to be _____ feet wide. Inlet _____ feet below original grade. Bottom maximum depth _____ feet below original grade. Effective area begins at _____ feet below original grade. _____ feet of stone below distribution pipe.
LOCATION:	_____
PURPOSE:	_____

PLANS APPROVED: _____ DATE: 8/13/2000

- NOTE: PERMIT VOID AFTER 2 YEARS
- NOTE: CONTRACTOR RESPONSIBLE FOR SCHEDULING A PRE-CONSTRUCTION INSPECTION FOR ALL INSTALLATIONS
- NOTE: WATERTIGHT SEPTIC TANKS REQUIRED
- NOTE: ALL PARTS OF SEPTIC SYSTEM SHALL BE 100 FEET FROM ANY WATER WELL
- NOTE: MANHOLE RISERS REQUIRED ON ALL SEPTIC TANKS AND PUMP CHAMBERS

NEITHER THE HOWARD COUNTY COUNCIL NOR THE HEALTH DEPARTMENT IS RESPONSIBLE FOR THE SUCCESSFUL OPERATION OF ANY SYSTEM PERMITTEE RESPONSIBLE FOR OBTAINING FINAL APPROVAL ON THIS PERMIT CALL 410-313-2640 FOR INSPECTION OF SEPTIC SYSTEM

W511551

C 1 07784

SEQUENCE NO. (MDE USE ONLY)

STATE OF MARYLAND WELL COMPLETION REPORT

FILL IN THIS FORM COMPLETELY PLEASE TYPE

THIS REPORT MUST BE SUBMITTED AFTER WELL IS COMPLETED. On 8/13/00

COUNTY NUMBER W 511551

ST/CO USE ONLY DATE RECEIVED MM DD YY

DATE WELL COMPLETED

Depth of Well

PERMIT NO. FROM "PERMIT TO DRILL WELL" HO-94-2694

OWNER Cissel Lambert STREET OR RFD WOODBURN RD Rt. 94 TOWN Lisbon SUBDIVISION Map 7 P. 136 SECTION LOT

WELL LOG table with columns: DESCRIPTION, FEET (FROM, TO), check if water bearing. Rows include Top Sal Clay, Brown Shale, Brown Slate, Blue Slate, Flint Rock, Blue Slate, Brown Slate, Blue Slate.

GROUTING RECORD form with fields: WELL HAS BEEN GROUTED (Y), TYPE OF GROUTING MATERIAL (CM, BC), NO. OF BAGS (46), NO. OF POUNDS (500), GALLONS OF WATER (54), DEPTH OF GROUT SEAL (0 to 28 ft).

CASING RECORD form with fields: casing types insert appropriate code below (ST, CO, PL, OT), MAIN CASING TYPE (ST), Nominal diameter (6), Total depth (30).

OTHER CASING (if used) form with fields: diameter, depth (feet).

SCREEN RECORD form with fields: screen type or open hole (ST, BR, HO, PL, OT).

NUMBER OF UNSUCCESSFUL WELLS: 0. WELL HYDROFRACTURED: Y.

CIRCLE APPROPRIATE LETTER: A, E, P.

I HEREBY CERTIFY THAT THIS WELL HAS BEEN CONSTRUCTED IN ACCORDANCE WITH COMAR 26.04.04 "WELL CONSTRUCTION" AND IN CONFORMANCE WITH ALL CONDITIONS STATED IN THE ABOVE CAPTIONED PERMIT...

DRILLERS LIC. NO. M SD 111. DRILLERS SIGNATURE: Ralph E. Wiggins. LIC. NO. D SAME.

SITE SUPERVISOR (sign. of driller or journeyman responsible for sitework if different from permittee)


DEPTH (nearest ft.) table with rows A through N and columns 1-5.

GRAVEL PACK IF WELL DRILLED WAS FLOWING WELL INSERT F IN BOX 68.

MDE USE ONLY (NOT TO BE FILLED IN BY DRILLER) T (E.R.O.S.) W Q.

PUMPING TEST form with fields: HOURS PUMPED (3), PUMPING RATE (20), METHOD USED TO MEASURE PUMPING RATE (Bucket), WATER LEVEL (5 ft. before, 31 ft. when pumping), TYPE OF PUMP USED (S submersible).

PUMP INSTALLED form with fields: DRILLER INSTALLED PUMP (NO), TYPE OF PUMP INSTALLED (S), CAPACITY GALLONS PER MINUTE (31), PUMP HORSE POWER (37), PUMP COLUMN LENGTH (43), CASING HEIGHT (+ above, 2 below).

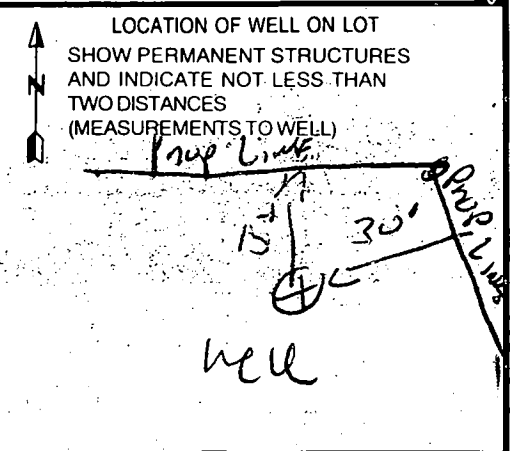

8/13/00

Howard

Date July 31, 2000

WELL YIELD TEST DATA SHEET - ~~Prince George's~~ County

Reviewed By OKSRK

Maryland Well Permit No. HO-94-2694

Owner or Applicant CAMBERT CISSEL

Location of Property (Road) OFF RT 94 IN LISBON

Subdivision CISSEL Prop. Lot --- Block --- Plat --- Sec. ---

Depth of Well 205' Height of Measuring Point Above Ground 2'

Static Water Level Below Measuring Point 5'

15 min to draw well down to 35 ft AT 20 GPM
The first entry in the table must be when you begin the drawdown. Enter all appropriate information. Indicate when the drawdown phase ends and the recovery test begins.
Pump Test Started AT 8:45

TIME (CHRONOLOGICAL)	WATER LEVEL Below M.P.	PUMPING RATE Time to Fill Gal. Bucket	FLOW METER READING (if used)	CALCULATED FLOW (gallons per minute)
9:00	35 ft	3 Sec	Flow Meter Reading (if used)	20 GPM
9:15	35 ft	3 Sec		20 GPM
9:30	35 ft	3 Sec		20 GPM
9:45	35 ft	3 "		20 GPM
10:00	35 ft	3 "		20 "
10:15	35 ft	3 "		20 "
10:30	35 ft	3 Sec		20 "
10:45	35 ft	3 Sec		20 GPM
11:00	35 ft	3 Sec		20 GPM
11:15	35 ft	3 "		20 GPM
11:30	35 ft	3 "		20 "
11:45	35 ft	3 "		20 "
12:00	35 ft	3 Sec		20 GPM

I hereby certify that the yield test was conducted as described in State Health Department Regulations COMAR 26.04.04.07.
30 ft casing @ 8 ft Jetted
9:45

Signature of Well Driller

B 1 1925

SEQUENCE NO. (MDE USE ONLY)

STATE OF MARYLAND PERMIT TO DRILL WELL please print or type

STATE PERMIT NUMBER

HO-94-2694

fill in this form completely

Date Received (APA)

04 03 99

OWNER INFORMATION

CISSEL Lambert
3425 Hipsley Mill Rd
Woodbine MD 21797

B 3

LOCATION OF WELL

Howard
CISSEL Prop
LISBOW


MILES FROM TOWN (enter 0 if in town) I M I

DRILLER INFORMATION

Ralph MAYNE MS D 116
Ralph Mayne Well Drilling
9120 Brown Church Rd Mt Airy
Ralph Mayne 4-28-99

B 4

DIRECTION OF WELL FROM TOWN (CIRCLE BOX)

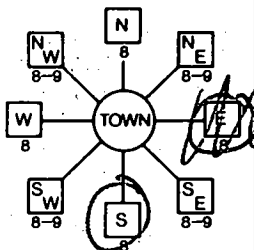

MD Rt. 94

ON WHICH SIDE OF ROAD (CIRCLE APPROPRIATE BOX)



1800
DISTANCE FROM ROAD

TAX MAP: 7 BLK: 17 PARCEL 136

WELL INFORMATION

APPROX. PUMPING RATE 20
AVERAGE DAILY QUANTITY NEEDED 2000

USE FOR WATER (CIRCLE APPROPRIATE BOX)

- DOMESTIC POTABLE SUPPLY & RESIDENTIAL IRRIGATION
FARMING (LIVESTOCK WATERING & AGRICULTURAL IRRIGATION)
INDUSTRIAL, COMMERCIAL, DEWATERING
PUBLIC WATER SUPPLY WELL
TEST, OBSERVATION, MONITORING
GEO-THERMAL

NOT TO BE FILLED IN BY DRILLER HEALTH DEPARTMENT APPROVAL

Howard W.511551
STATE SIGNATURE
DATE ISSUED 05 26 00 Mark E. Riffin 5/26/00
NORTH GRID 545 000 EAST GRID 0778 000

APPROXIMATE DEPTH OF WELL 150 FEET

APPROXIMATE DIAMETER OF WELL 6 NEAREST INCH

METHOD OF DRILLING (circle one)

BORED (or Augered) JETTED Jetted & DRIVEN
AIR-ROTARY AIR-PERCussion ROTARY (Hydraulic Rotary)
CABLE REVerse-ROTary DRive-POINT

REPLACEMENT OR DEEPEMED WELLS (CIRCLE APPROPRIATE BOX)

- THIS WELL WILL NOT REPLACE AN EXISTING WELL
THIS WELL WILL REPLACE A WELL THAT WILL BE ABANDONED AND SEALED
THIS WELL WILL REPLACE A WELL THAT WILL BE USED AS A STANDBY-CONTACT LOCAL APPROVING AUTHORITY FOR POLICY ON STANDBY WELLS
THIS WELL WILL DEEPEAN AN EXISTING WELL

PERMIT NUMBER OF WELL TO BE REPLACED OR DEEPEMED (IF AVAILABLE)

Not to be filled in by driller (MDE OR COUNTY USE ONLY)

APPROX. PERMIT NUMBER GAP

PERMIT No. HO-94-2694


SHOW MAJOR FEATURES OF BOX & LOCATE WELL WITH AN X

SOURCES OF DRILLING WATER
1. well

WRITE THE BOX NUMBER FROM THE MAP HERE

E 7708
S 5445

DRAW A SKETCH BELOW SHOWING LOCATION OF WELL IN RELATION TO NEARBY TOWNS AND ROADS AND GIVE DISTANCE FROM WELL TO NEAREST ROAD JUNCTION

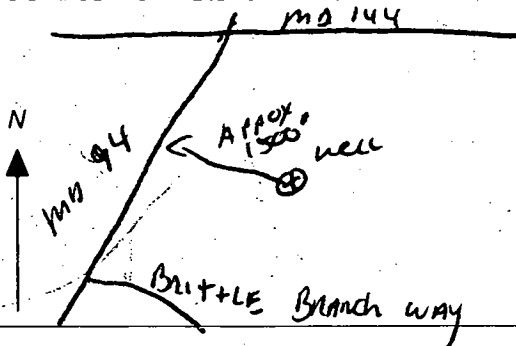

SPECIAL CONDITIONS

NOTE - APPROVING AUTHORITIES SHOULD USE SEPARATE SHEET IF NEEDED

RT 94

Metropolitan Regional Information Systems, Inc.

Tax ID#: 311353

** PUBLIC RECORD **

Tax ID#: 311353 County: HW
 PROPERTY ADDRESS: WOODBINE , , WOODBINE, MD 21797-
 Incorporated City:
 OWNER: WILLIS LAMBERT CISSEL, JR Phone #: () Abs Owner: Y
 Addtnl:
 MAIL ADDRESS: 3425 HIPSLEY MILL RD, , WOODBINE, MD 21797-7615
 LEGAL DESCRIPTION: 19 ACRES WOODBINE ROAD OF LISBON
 Mag/Dist #: 4 Lot: Block/Square: Tax Map:
 Elec Dist: 04 Legal Unit #: Grid: 17 Map: 7
 Section: Parcel: 136
 TOTAL TAX BILL: \$219 State/County Tax: \$88 City Tax: Levy Yr: 1998
 Front Foot Fee: Spec Tax Assmt: \$6 Refuse: \$125 Rate: 2.99
 Homestd/Exempt Status: 0 Exempt Class: 000

ASSESSMENT

Year Assessed	Total Tax Value	Land	Improvement	Land Use	Taxable Assessment
1995	\$3,130	\$6,270	\$0		State: \$
Previous	\$3,130	\$6,300			Municipal: \$
Early	\$3,130	\$6,300	\$0		City: \$

DEED

Transfer Date	Price	Grantor	Grantee	Deed Type:
02-MAY-1998	\$0	CISSEL, WILLIS L	CISSEL, WILLIS LAMBERT JR	CISSEL WILLIS L

Amount: /

Mortgagor:
PROPERTY DESCRIPTION
 Year Built: 0 Zoning: RCDEO Census Trct/Blck: / Irregular Lot: N
 Square Feet: 827,640 Acreage: 19.00 Land Use: Agricultural/Rural
 Prop Class: A Plat Liber/Folio: Property Card:
 Zoning Desc:
 Prop Use Code: AGRICULTURAL
 Building Use: AGRICULTURAL
 Lot Description:
 Dimensions:

STRUCTURE DESCRIPTION

	Section 1	Section 2	Section 3	Section 4	Section 5
Construction					
Story					
Area					
Dimensions:					
Ext Wall:		Roofing:		Foundation:	
Stories:	Units: 0		Style:		Year Remodeled:
Total Building Area:		Living Area: 0		Base Sq Ft: 0	
Patio/Deck Type:					
Rooms:	Bsmt Type:		Fireplaces:		Garage Type:
Bedrooms:	Bsmt Tot Sq Ft: 0		Fireplace Type:		Garage Sq Ft:
Full Baths: 0	Bsmt Fin Sq Ft:		Attic Type:		Garage Const.:
Half Baths: 0	Bsmt Unfin Sq Ft:		Attic Sq Ft:		Garage Spaces:
Baths: 0					
Other Amenities:					
Gas:		Heat:		Sewer:	
Electric:		Water:		Underground:	

No Perc on Site
 For Ag use Only

