

PERMIT

SEWAGE DISPOSAL SYSTEM

DEPARTMENT OF HEALTH AND MENTAL HYGIENE

HOWARD COUNTY HEALTH DEPARTMENT

BUREAU OF ENVIRONMENTAL HEALTH

461-9933

RPS #295206

INDEXED

P 513 211-C

A REPAIR

DISTRICT _____

DATE 1/5/2000

DATE SYSTEM APPROVED 2/13/98

INSPECTOR JCS

Jack Fyock Septic Service

IS PERMITTED TO INSTALL ☒ ALTER _____

ADDRESS 4105 Ten Oaks Road Glenelg, MD 21737 PHONE (410) 988-9270

SUBDIVISION Tax Map 16 P. 177 LOT _____ ROAD 2660 Thompson Drive

PROPERTY OWNER _____ Flannery

ADDRESS _____

SEPTIC TANK CAPACITY EX GALLONS

NUMBER OF BEDROOMS 3

125 SQUARE FEET PER BEDROOM

LINEAR FEET OF TRENCH REQUIRED 75

REPAIR - PURPOSE - EXISTING SEPTIC SYSTEM HAS FAILED.

Call for inspection when ground is open so sanitarian can recommend repair. 02/13/98

Install trench off existing drywell

Trench to be 2' wide, inlet 5', bottom 10', stone 5'

*Property served by public water

PLANS APPROVED BY [Signature] DATE 2/13/98

COVER NO WORK UNTIL INSPECTED AND APPROVED

NEITHER THE HOWARD COUNTY COUNCIL NOR THE HEALTH DEPARTMENT IS RESPONSIBLE FOR THE SUCCESSFUL OPERATION OF ANY SYSTEM

NOTE: CLEANOUT REQUIRED EVERY 70 FEET OF SEWER LINE AND/OR AT 90° SWEEPS IN LINES FROM HOUSE TO DRAIN FIELDS, 90° ELBOWS NOT ACCEPTABLE.

NOTE: ALL PARTS OF SEPTIC SYSTEMS (I.E. TANK, DISTRIBUTION BOX TRENCHES) TO BE 100 FEET FROM WELL (UNLESS OTHERWISE SPECIFICALLY AUTHORIZED)

NOTE: IF DEEP TRENCH(ES) ARE USED CALL FOR INSPECTION BEFORE AND AFTER PLACING GRAVEL IN TRENCH(ES)

NOTE: NO DRY WELL SHALL EXCEED 15 FOOT IN DIAMETER NO ABSORPTION TRENCH TO EXCEED 100 FEET IN LENGTH

NOTE: ALL PIPE FROM HOUSE TO SEPTIC TANK MUST BE CAST IRON OR SCHEDULE 35/40 PVC OR ABS


PERMIT VOID AFTER TWO YEARS

NOTE: INSTALL STAND PIPE ON SEPTIC TANK AND DRY WELL STAND PIPES MUST BE 6 INCHES IN DIAMETER CAST IRON, CONCRETE OR TERRA COTTA OR PVA OR ABS ACCEPTED. IF TOP OF SEPTIC TANK IS DEEPER THAN 3 FEET. MANHOLE TO GRADE REQUIRED.

NOTE: DISTRIBUTION BOXES MUST HAVE BAFFLES

*INSTALLER IS RESPONSIBLE FOR OBTAINING FINAL APPROVAL ON THIS PERMIT

P513 211-C

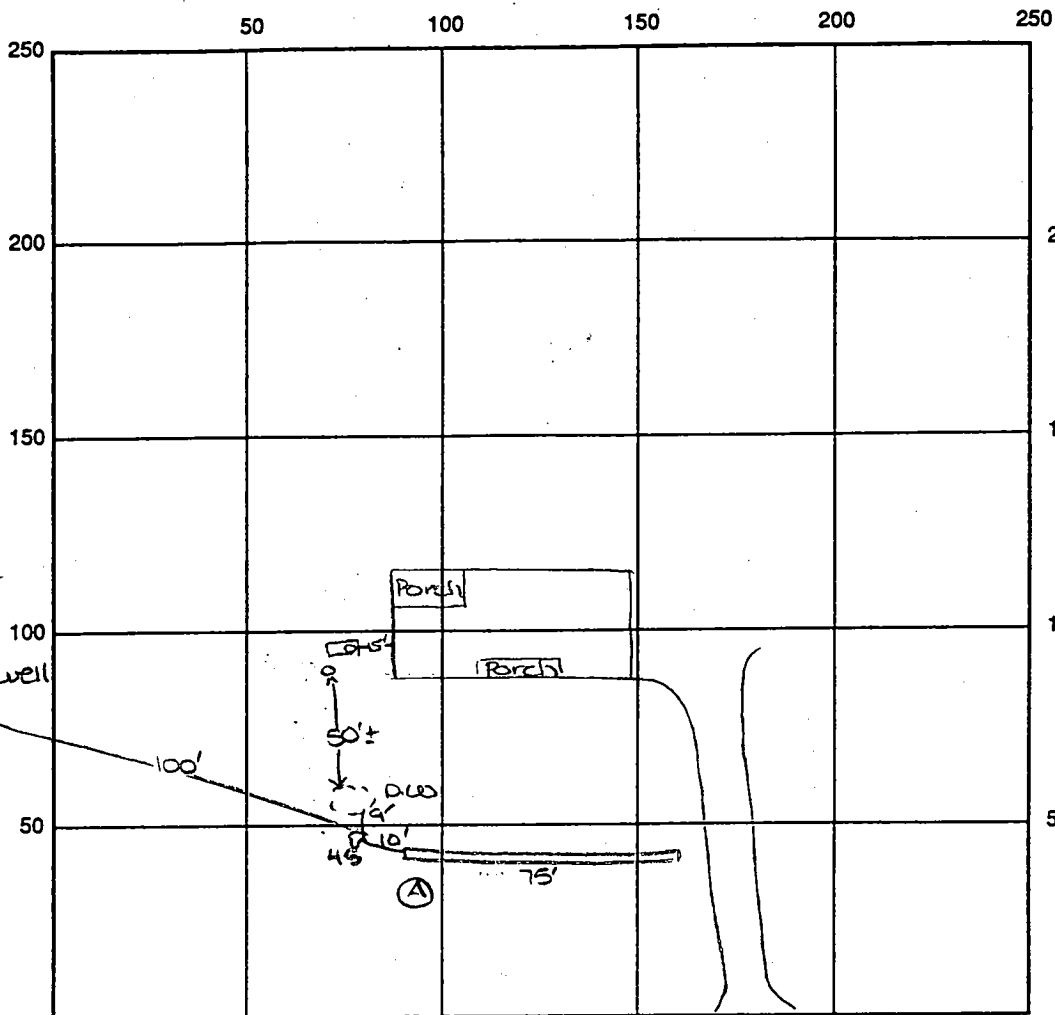

2'	Ⓐ	top soil
4'		org brn silty
13'		pale brn silty
		5-10% Rk

INDICATE NORTH - NAME ADJOINING ROADWAY AS BASE LINE

Thompson Drive

SEPTIC TANK LEVEL Existing CLEANOUTS one on s.t., one in line
one on d.w.

DISTRIBUTION BOX LEVEL N/A

DRAIN FIELD/TITLE DEPTH 10 FT. TRENCH WIDTH 2 FT. INLET DEPTH 5 FT.

EFFECTIVE GRAVEL DEPTH 5 FT. TOTAL LENGTH 75 FT.

NUMBER OF TRENCHES 1 ONE SIDEWALL BOTTOM AREA 375 SQ. FT.

DRYWALL INSIDE DIAMETER EX FT. EFFECTIVE DEPTH BELOW INLET EX FT.

ABSORBENT AREA 375 SQ. FT. + EX

REMARKS: 2/13/98 OK to install repair trench as specified. DKS
2/13/98 P.M. FINAL - OK to cover all work. DKS

DATE SYSTEM APPROVED 2/13/98 INSPECTOR Donna J. Scott