

3/24/00 ASAP

PERMIT
SEWAGE DISPOSAL SYSTEM
HOWARD COUNTY HEALTH DEPARTMENT
BUREAU OF ENVIRONMENTAL HEALTH
410-313-2640

P 513377

A REPAIR

ISSUE DATE _____

APPROVAL DATE 3/24/2000

INDEXED 03-290549

Hatfield's Equipment

IS PERMITTED TO INSTALL _____ ALTER _____

ADDRESS 13785 Burntwoods Road, Glenelg, MD 21737 PHONE 301-854-6172

SUBDIVISION _____ LOT NUMBER _____ ADDRESS 13212 Triadelphia Road

PROPERTY OWNER Sonya Hubbard PROPERTY OWNER'S ADDRESS 13212 Triadelphia Road

SEPTIC TANK CAPACITY _____ GALLONS

PUMP CHAMBER CAPACITY _____ GALLONS

NUMBER OF BEDROOMS _____

SQUARE FEET PER BEDROOM _____

LINEAR FEET OF TRENCH REQUIRED _____

TRENCHES: Trenches to be 2 feet wide. Inlet 4 feet below original grade. Bottom maximum depth 9 feet below original grade. 5 feet of stone below distribution box.

LOCATION: _____

REPAIR - PURPOSE - Existing system has failed.

Call for inspection when ground is opened so sanitarian can recommend repair. 3-24-00

ADD 85-90' TRENCH FROM DAYWELL TOWARDS DRIVEWAY

PLANS APPROVED _____ DATE 3/24/00 CW

PERMIT VOID AFTER 2 YEARS

NOTE: CONTRACTOR RESPONSIBLE FOR SCHEDULING A PRE-CONSTRUCTION INSPECTION FOR ALL INSTALLATIONS

NOTE: TOP OF SEPTIC TANKS ARE TO BE NO DEEPER THAN 3.0 FEET BELOW FINISH GRADE

NOTE: WATERTIGHT SEPTIC TANKS REQUIRED

NOTE: CLEANOUT REQUIRED EVERY 70 FEET OF SEWER LINE AND/OR AT 90° SWEEPS IN LINES FROM HOUSE TO DRAIN FIELDS, 90° ELBOWS ARE NOT ACCEPTABLE

NOTE: ALL PARTS OF SEPTIC SYSTEMS (I.E. TANK, DISTRIBUTION BOX, DRAINFIELDS) TO BE 100 FEET FROM ANY WATER WELL UNLESS OTHERWISE SPECIFICALLY AUTHORIZED

NOTE: NO ABSORPTION TRENCH TO EXCEED 100 FEET IN LENGTH UNLESS SPECIFICALLY AUTHORIZED

NOTE: ALL PIPE FROM HOUSE TO SEPTIC TANK MUST BE CAST IRON OR SCHEDULE 35/40 PVC OR ABS

NOTE: MANHOLE RISERS REQUIRED ON ALL SEPTIC TANKS AND PUMP CHAMBERS


NOTE: DISTRIBUTION BOXES MUST HAVE BAFFLES

NOTE: IF PUMPED SEPTIC SYSTEM REQUIRED, (1) SEPTIC PUMP DETAIL TO BE PROVIDED BY INSTALLER PRIOR TO ISSUANCE OF SEPTIC PERMIT (2) PUMP PERFORMANCE TEST IS NECESSARY PRIOR TO HEALTH DEPARTMENT APPROVAL OF SEPTIC PERMIT

NEITHER THE HOWARD COUNTY COUNCIL NOR THE HEALTH DEPARTMENT IS RESPONSIBLE FOR THE
SUCCESSFUL OPERATION OF ANY SYSTEM
PERMITTEE RESPONSIBLE FOR OBTAINING FINAL APPROVAL ON THIS PERMIT
CALL 410-313-2640 FOR INSPECTION OF SEPTIC SYSTEM

513377

NOT TO SCALE

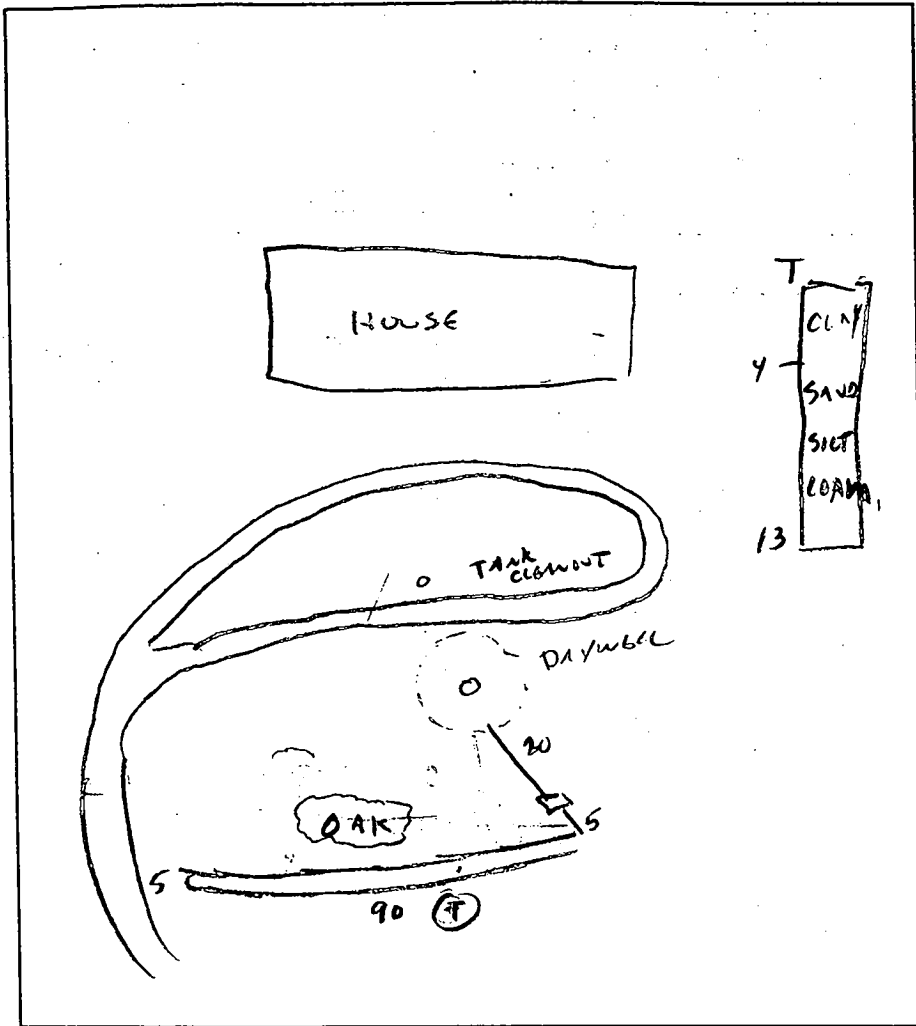

TRENCH DATA

TRENCH WIDTH 2
TRENCH INLET DEPTH 4
TRENCH BOTTOM DEPTH 9
DEPTH OF STONE 5
NUMBER OF TRENCHES 1
TOTAL TRENCH LENGTH 90
ABSORBENT AREA 450
DISTRIBUTION BOX LEVEL ☒
BAFFLE IN DISTRIBUTION BOX ☒

SEPTIC TANK DATA EXISTING

SEPTIC TANK GALLONS
MANHOLE RISER
6 INCH INSPECTION PORT ☒

PUMP CHAMBER DATA

PUMP CHAMBER GALLONS N/A
MANHOLE RISER
ALARM
PUMP PERFORMANCE TEST

PRE-CONSTRUCTION INSPECTION:

INSPECTION COMMENTS: 3/24/00 SOILS OK TO 13, ADD 90 TRENCH w/56 INCH
80 EXISTING DAYWELL
3/24/00 PM SYSTEM COMPLETE OK TO COVER

INSPECTOR CWILDA DATE SYSTEM APPROVED 3/24/00

MAY/1
56716 R


SONIA HUBBARD

HATFIELD

13212 TRINIDAD RD

TRINIDAD
(FARM)
MEADOWS
LOT 3


LOT 7
TRINIDAD TV

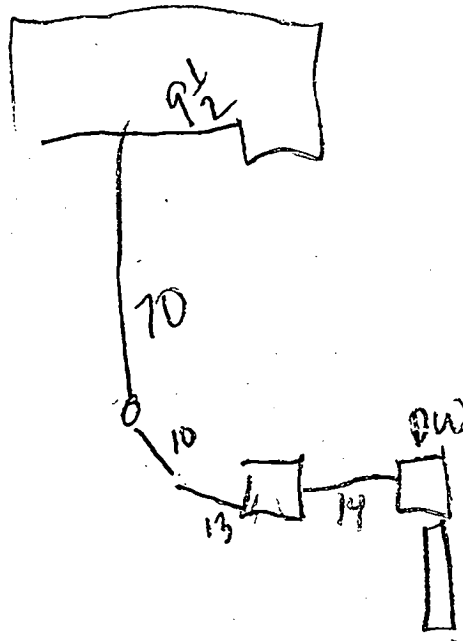


HO-73 1415
2
o

MAY/1
565716 R

SODNIA HUBBARD
HATFIELD
13212 T110024110 AD

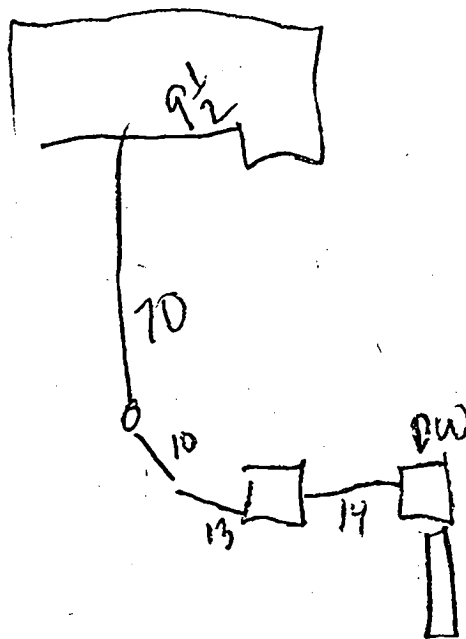

H0-73 1415
7
0

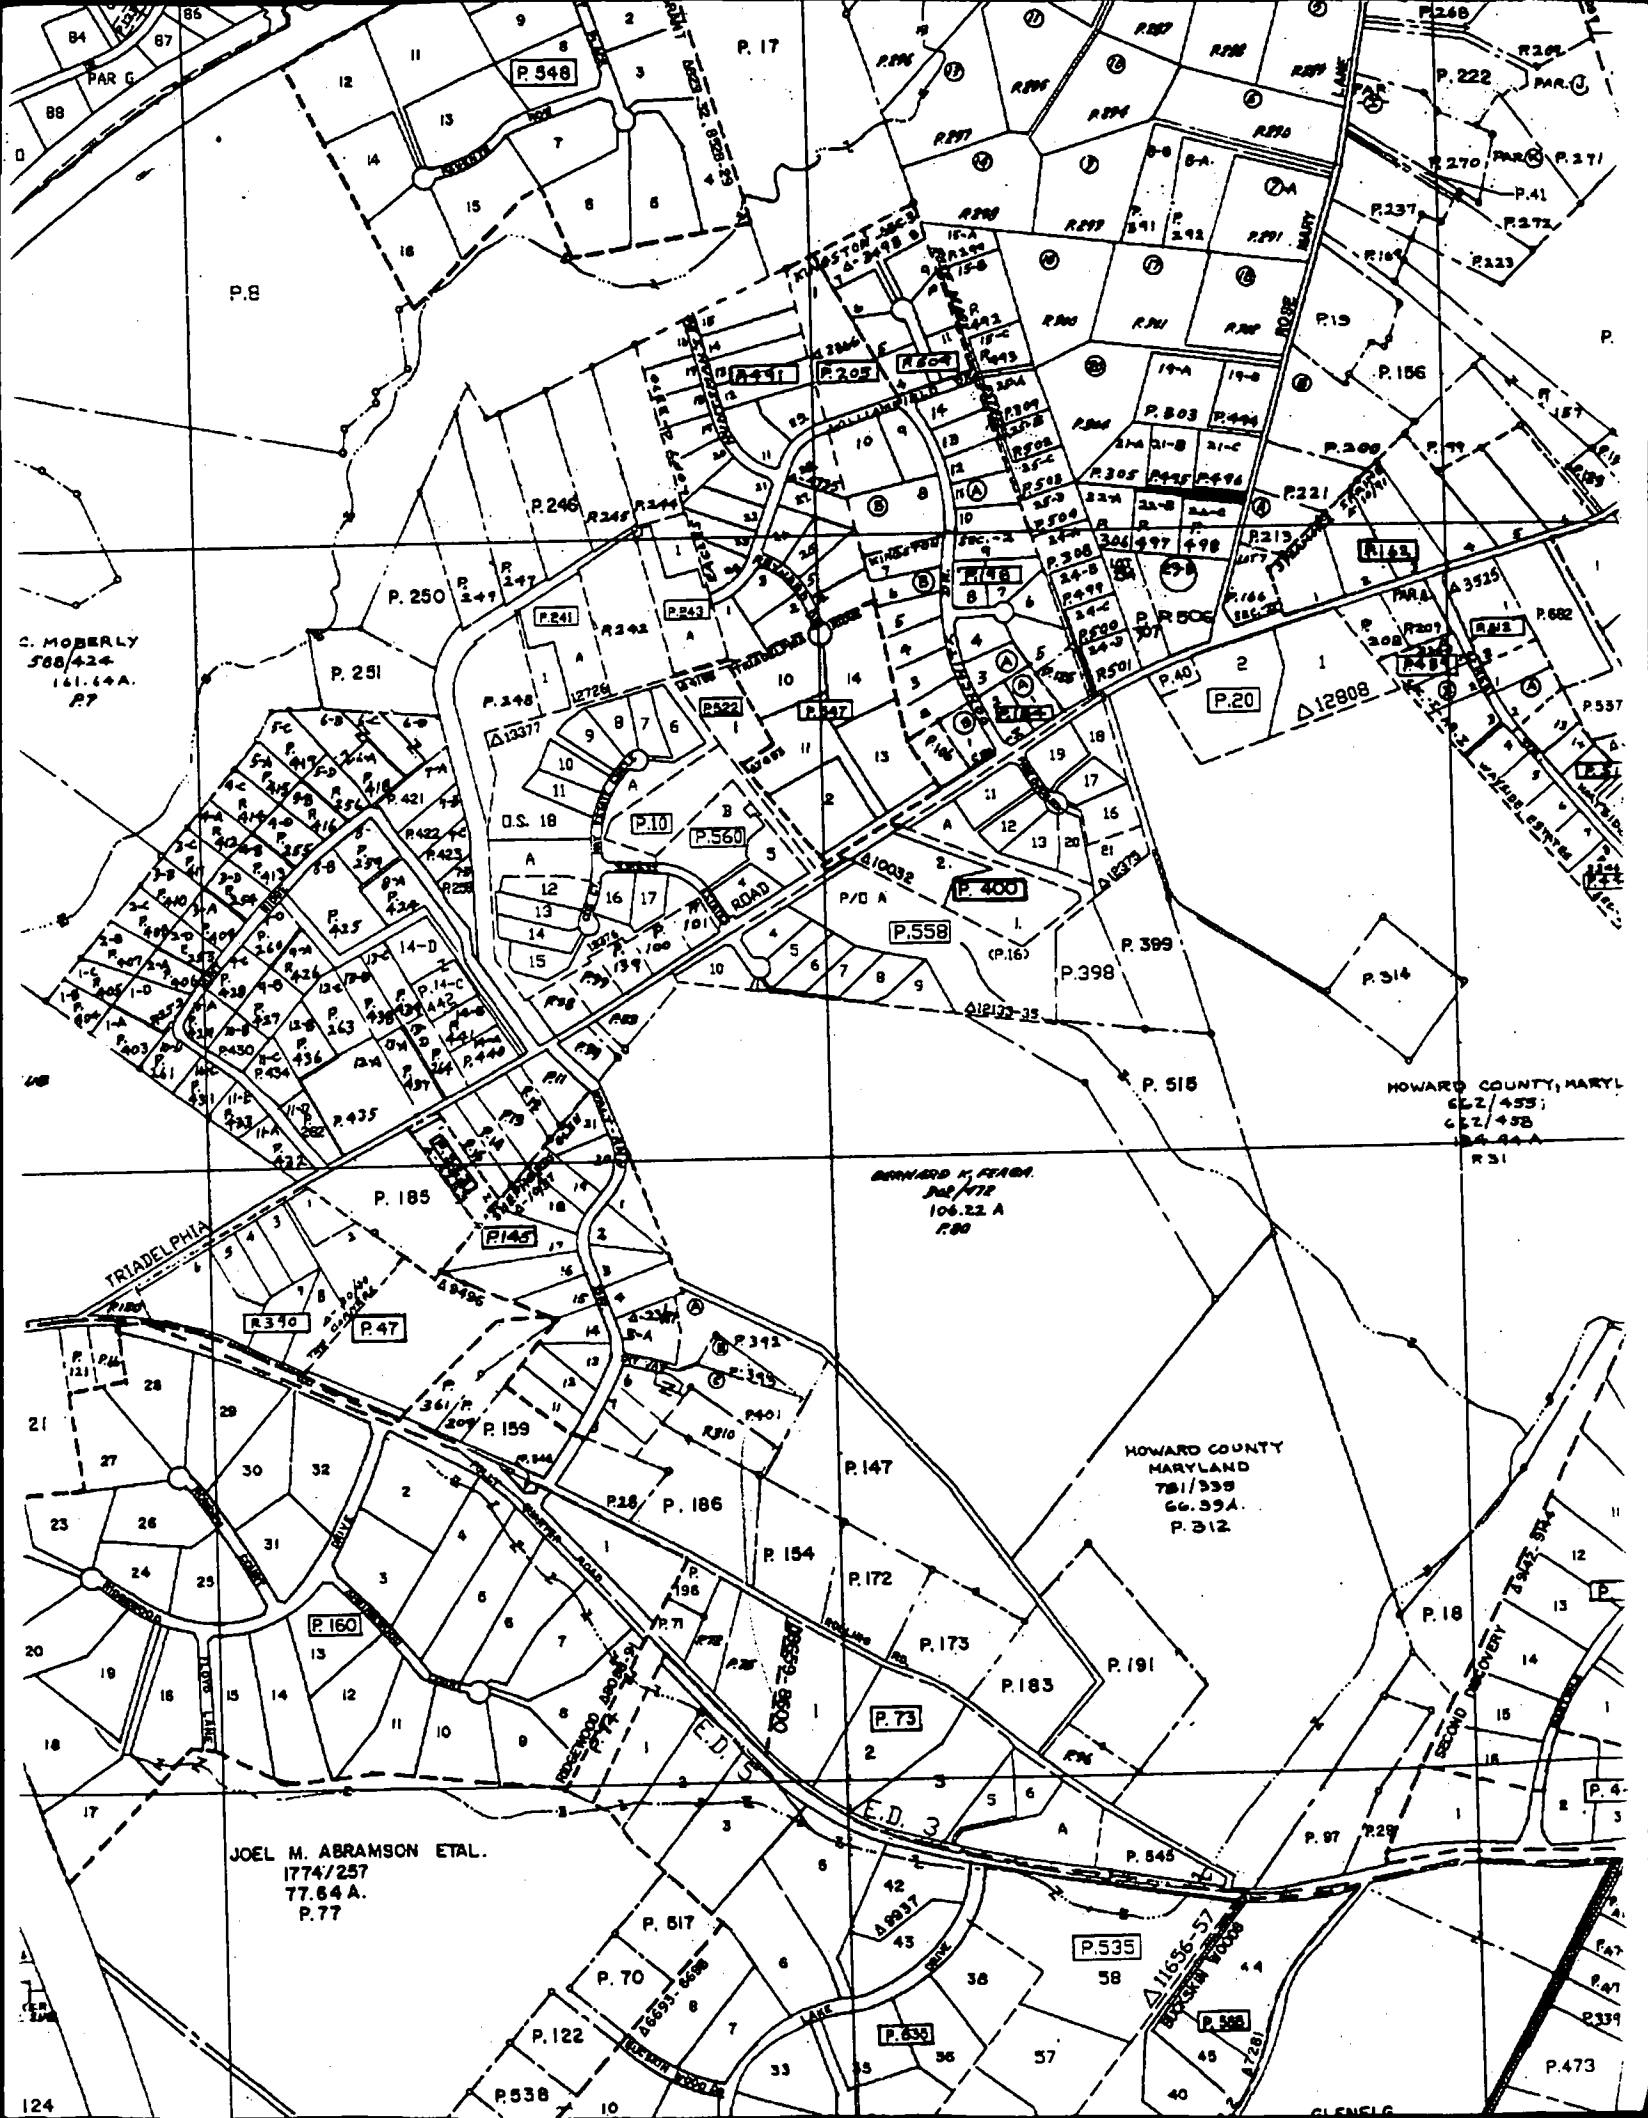

C. MOBERLY
588/424
161.44 A.
P.7

JOEL M. ABRAMSON ETAL.
1774/257
77.84 A.
P.77

BERNARD H. PEARL
302/772
106.22 A
P.80

HOWARD COUNTY
MARYLAND
781/338
66.39 A.
P.312

HOWARD COUNTY, MARYL
66.2/453;
66.2/453
P.31