

HOWARD COUNTY

INDEXED

ELLICOTT CITY

DISTRICT 1

DATE 2/13/74

8/74
very
File
John Bralcher

IS PERMITTED TO INSTALL ALTER X

ADDRESS Rt. 4 - Box 425 - Pasadena, Md. PHONE 255-8234

A SEWAGE DISPOSAL SYSTEM LOCATED AT _____

SUBDIVISION _____ ROAD 6729 Waterline Road LOT _____
(see application for better directions)

PROPERTY OWNER Charles L. Haines

ADDRESS 6729 Waterline Road, Ellicott City, Md. 21227 465-1375

SPECIFICATIONS REPAIR

DRAIN FIELD _____ DEPTH _____ FEET. BOTTOM AREA _____ SQ. FT.

BEREAGE PITS _____ ABSORBENT SIDE-WALL AREA _____ SQ. FT.

SEPTIC TANK CAPACITY 1000 GALLONS

FOR GARBAGE GRINDER, INCREASE DISPOSAL AREA 22% & TANK CAPACITY 50%.

OTHER REPAIR - 2/13/74 - sand for 8' x 8' - the water

install new 100 gal tank (old one is metal good tank)

Trunk - 9' x 8' deep - 7' x 8' deep with at least 4' x

apertures. 8' x 8' to install some stone if

trunk is necessary or 8' x 8' to use existing line from

trunk - when part of line is not up P. Tone

PLANS APPROVED BY Robert F. Vign DATE 2/13/74

from home, replace that portion that is twisted.

FILL SEPTIC TANK AND DISTRIBUTION BOX WITH WATER BEFORE CALLING FOR AN INSPECTION. COVER NO WORK
UNTIL INSPECTED AND APPROVED.

NEITHER THE HOWARD COUNTY COMMISSIONERS NOR THE HEALTH DEPARTMENT IS RESPONSIBLE FOR THE
SUCCESSFUL OPERATION OF ANY SYSTEM.


BLDG. PERMIT SIGNED
AND RETURNED 12/2/74

Serial # 4837.3

Initial alteration

RECEIVED BY _____

9514165-2

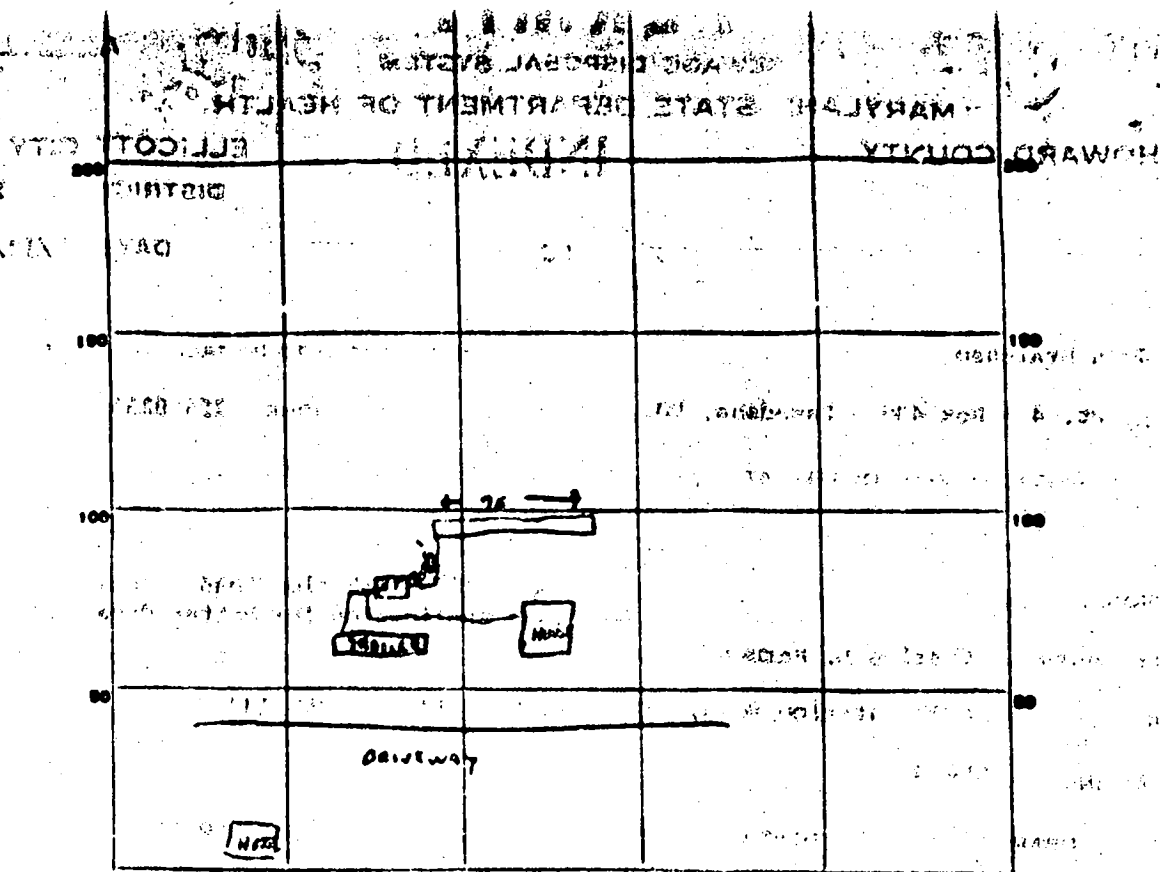

PERMIT CARD _____

SEPTIC TANK, LEVEL 100 gals

CLEANOUTS 04

DISTRIBUTION BOX, LEVEL —

TILE FIELD, DEPTH 7 FT. TRENCH WIDTH 3 FT.

GRAVEL DEPTH 3-4 ft IN. TOTAL LENGTH 25 FT.

NUMBER OF TRENCHES 1 Isolated area
TOTAL BOTTOM AREA 622 sq ft

SEEPAGE PITS, INSIDE DIAMETER 2 FT. DEPTH BELOW INLET — FT.

ABSORBENT AREA — SQ. FT.

REMARKS

2/28/74 - Only a portion of trench was seen before
stone was installed - this was early - Judging from
ground that came out of trench it appears that most
of trench was early - Owner was satisfied that
trench was 2 ft deep and adequate amount of
stone was installed - He wanted entire job.

DATE SYSTEM APPROVED

2/28/74

INSPECTOR

R. Tene

WATER WELL ABANDONMENT-SEALING REPORT FORM

SUBMIT COPIES OF COMPLETED FORM TO:

- * COUNTY ENVIRONMENT AGENCY (contact MDE, WMA if address needed)
- * WELL OWNER
- * MDE, WATER MANAGEMENT ADMINISTRATION, WELL PROGRAM

DATE WELL ABANDONED: 06/26/00 (month/day/year)

* PERMIT NUMBER OF ABANDONED WELL (if any)

* PERMIT NUMBER OF REPLACEMENT WELL

* PERSON ABANDONING WELL: Mike Johnson WELL DRILLERS LICENSE NUMBER: _____

* OWNER'S NAME: Harman

CIRCLE: MWD/MSD/MGD

* WELL LOCATION: 6739 Waterloo Rd

COUNTY: Howard
NEAREST TOWN: Elkridge
TAX MAP 37 BLOCK 21 PARCEL 453
SUBDIVISION: _____
SECTION: _____ LOT: _____

MARYLAND GRID COORDINATES

BOX NUMBER E 801
N 492

☒	
000	
000	

SHOW WELL LOCATION
BY X WITHIN BOX

* TYPE OF WELL BEING ABANDONED:

_____☐ DRILLED _____☐ JETTED
_____☐ BORED/AUGURED _____☒ HAND DUG
_____☐ OTHER (specify) _____

* USE CODE:

_____☒ DOMESTIC _____☐ MUNICIPAL/PUBLIC
_____☐ IRRIGATION _____☐ INDUSTRIAL
_____☐ TEST/OBSERVATION

* TYPE OF CASING:

_____☐ STEEL _____☐ PLASTIC
_____☐ CONCRETE _____☒ OTHER (specify)
Hand laid brick

* SIZE OF CASING: 36 INCHES IN DIAMETER

* DEPTH OF WELL: 36 FEET DEEP

* WAS ANY CASING REMOVED? ____ YES ____ ☒ NO
if yes, length removed, in feet: _____

* WAS CASING RIPPED OR PERFORATED? ____ YES ____ ☒ NO

LOG OF SEALING MATERIAL

MATERIAL	FEET	
	FROM	TO
36 #2 gravel	36	8
cement	8	5
clean fill	5	0

SIGNATURE-MASTER WELL DRILLER OR SUPERVISING SANITARIAN

LICENSE #

MWD/MSD/MGD
CIRCLE ONE

DATE

WATER WELL ABANDONMENT-SEALING REPORT FORM

SUBMIT COPIES OF COMPLETED FORM TO:

- * COUNTY ENVIRONMENT AGENCY (contact MDE, WMA if address needed)
- * WELL OWNER
- * MDE, WATER MANAGEMENT ADMINISTRATION, WELL PROGRAM

DATE WELL ABANDONED: 06/26/00 (month/day/year)

* PERMIT NUMBER OF ABANDONED WELL (if any)

* PERMIT NUMBER OF REPLACEMENT WELL

* PERSON ABANDONING WELL: Mike Johnson Associated Excavators WELL DRILLERS LICENSE NUMBER:

CIRCLE: MWD/MSD/MGD

* OWNER'S NAME: Harman

* WELL LOCATION: 6739 Waterloo Rd

COUNTY: Howard
NEAREST TOWN: Elkridge
TAX MAP 37 BLOCK 21 PARCEL 453
SUBDIVISION: _____
SECTION: _____ LOT: _____

MARYLAND GRID COORDINATES

BOX NUMBER E 861
N 492

* TYPE OF WELL BEING ABANDONED:

☒ DRILLED ☐ JETTED
☐ BORED/AUGURED ☐ HAND DUG
☐ OTHER (specify) _____

* USE CODE:

☒ DOMESTIC ☐ MUNICIPAL/PUBLIC
☐ IRRIGATION ☐ INDUSTRIAL
☐ TEST/OBSERVATION

* TYPE OF CASING:

☒ STEEL ☐ PLASTIC
☐ CONCRETE ☐ OTHER (specify) _____

* SIZE OF CASING: 6 INCHES IN DIAMETER

* DEPTH OF WELL: 100 FEET DEEP

* WAS ANY CASING REMOVED? ☐ YES ☒ NO
if yes, length removed, in feet: _____

* WAS CASING RIPPED OR PERFORATED? ☐ YES ☒ NO

NONE

N/A

<u>X</u>	
000	
000	

SHOW WELL LOCATION
BY X WITHIN BOX

LOG OF SEALING MATERIAL

MATERIAL	FEET	
	FROM	TO
Cement	100	0

SIGNATURE-MASTER WELL DRILLER OR SUPERVISING SANITARIAN

LICENSE #

MWD/MSD/MGD
CIRCLE ONE

DATE

DENV 828 JULY 1993

SITE INSPECTION SHEET

OWNER: Harman

DATE REQUESTED: 6/26/00 10:00

ADDRESS: 6739 Waterloo Rd

DRILLER/CONTRACTOR: Assoc. Excavators

WELL TAG NUMBER: None


TAX & PARCEL: TM 31 P453 & 21

COUNTY: P19524

PROPOSAL: Abandonment of 2 existing water wells -

property house is in process of demolition
(property was served by public sewer - septic system
previously abandoned)

LOCATION DIAGRAM

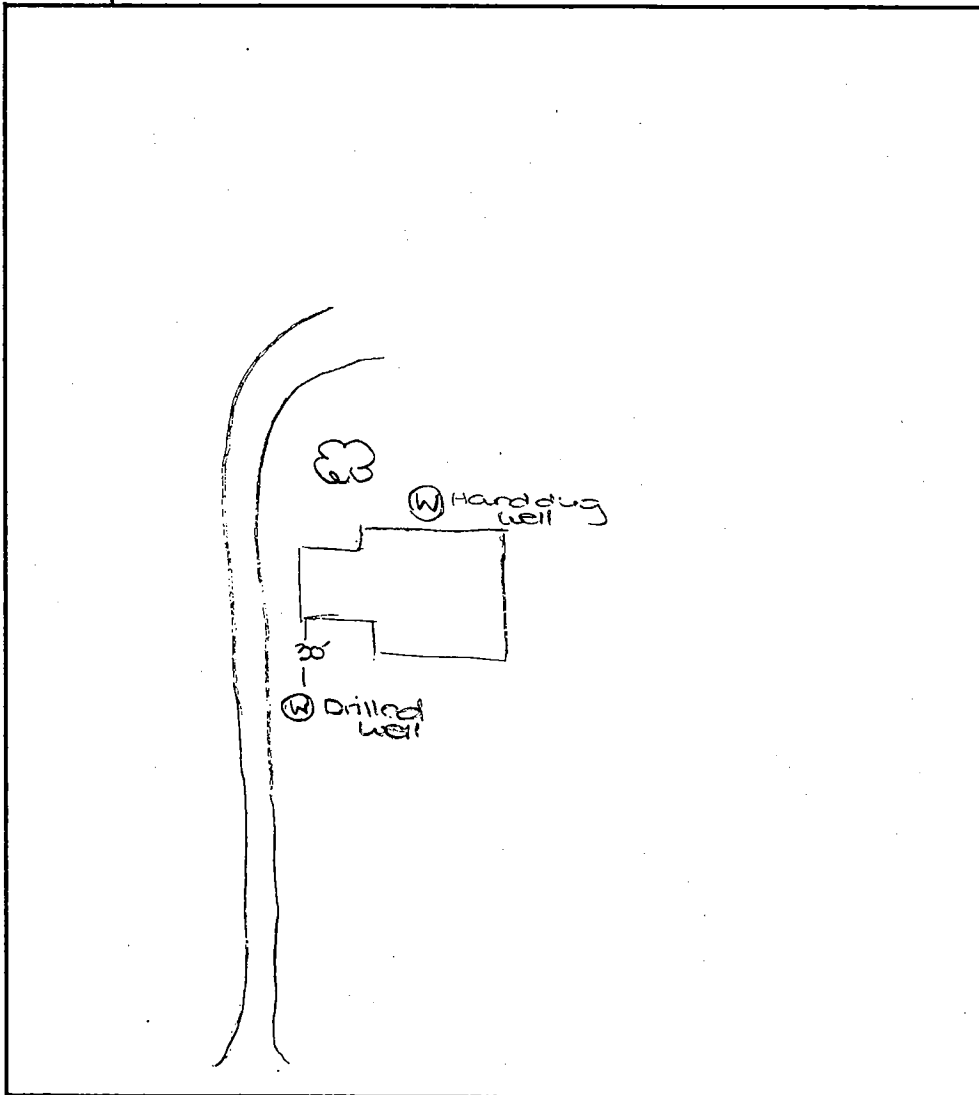

COMMENTS: Abandonment of both water wells
completed according to COMAR.

DATE:

6/26/00

INSPECTOR:

DRS