

3/15/01 10:30 - layout
and later
RPS# 353017

PERMIT
SEWAGE DISPOSAL SYSTEM
HOWARD COUNTY HEALTH DEPARTMENT
BUREAU OF ENVIRONMENTAL HEALTH
410-313-2640

P 514690

A 37387

ISSUE DATE 12/1/2000

APPROVAL DATE 3/15/01

INDEXED

Kenneth Mayne

IS PERMITTED TO INSTALL ☒ ALTER ☐

ADDRESS 11723 Legore Bridge Road, Keymar, MD 21757 PHONE 301-898-0955
SUBDIVISION Dunfarmin Estates LOT NUMBER 16 ADDRESS 5421 Jamesway Court
PROPERTY OWNER Kevin Beacraft PROPERTY OWNER'S ADDRESS 14035 Triadelphia Mill Rd.
SEPTIC TANK CAPACITY 1250 GALLONS Dayton, MD 21036
PUMP CHAMBER CAPACITY N/A GALLONS
NUMBER OF BEDROOMS 4
SQUARE FEET PER BEDROOM 180 ~~270~~ SPECS CHANGED SINCE FINAL SRA
LINEAR FEET OF TRENCH REQUIRED ~~270~~ 180 USES ORIGINAL PERCS (37387)

TRENCHES: Trenches to be 2.0 feet wide. Inlet 4.0 feet below original grade. Bottom maximum depth
8.0 feet below original grade. 4.0 feet of stone below distribution box.
LOCATION: Set the distribution box 45 feet from the left front (341.89) lot line and 165
feet from the left-rear (274.68) lot line. Run trenches along contour
towards the front of the property. 7/27/00 OK AK

PLANS APPROVED Amy Mc Millen DATE 7/24/00

PERMIT VOID AFTER 2 YEARS

NOTE: CONTRACTOR RESPONSIBLE FOR SCHEDULING A PRE-CONSTRUCTION INSPECTION FOR ALL INSTALLATIONS

NOTE: TOP OF SEPTIC TANKS ARE TO BE NO DEEPER THAN 3.0 FEET BELOW FINISH GRADE

NOTE: WATERTIGHT SEPTIC TANKS REQUIRED

NOTE: CLEANOUT REQUIRED EVERY 70 FEET OF SEWER LINE AND/OR AT 90° SWEEPS IN LINES FROM HOUSE TO DRAIN FIELDS, 90° ELBOWS
ARE NOT ACCEPTABLE

NOTE: ALL PARTS OF SEPTIC SYSTEMS (I.E. TANK, DISTRIBUTION BOX, DRAINFIELDS) TO BE 100 FEET FROM ANY WATER WELL UNLESS
OTHERWISE SPECIFICALLY AUTHORIZED

NOTE: NO ABSORPTION TRENCH TO EXCEED 100 FEET IN LENGTH UNLESS SPECIFICALLY AUTHORIZED

NOTE: ALL PIPE FROM HOUSE TO SEPTIC TANK MUST BE CAST IRON OR SCHEDULE 35/40 PVC OR ABS


NOTE: MANHOLE RISERS REQUIRED ON ALL SEPTIC TANKS AND PUMP CHAMBERS

NOTE: DISTRIBUTION BOXES MUST HAVE BAFFLES

NOTE: IF PUMPED SEPTIC SYSTEM REQUIRED, (1) SEPTIC PUMP DETAIL TO BE PROVIDED BY INSTALLER PRIOR TO ISSUANCE OF SEPTIC
PERMIT (2) PUMP PERFORMANCE TEST IS NECESSARY PRIOR TO HEALTH DEPARTMENT APPROVAL OF SEPTIC PERMIT

NEITHER THE HOWARD COUNTY COUNCIL NOR THE HEALTH DEPARTMENT IS RESPONSIBLE FOR THE
SUCCESSFUL OPERATION OF ANY SYSTEM
PERMITTEE RESPONSIBLE FOR OBTAINING FINAL APPROVAL ON THIS PERMIT
CALL 410-313-2640 FOR INSPECTION OF SEPTIC SYSTEM

P 514690

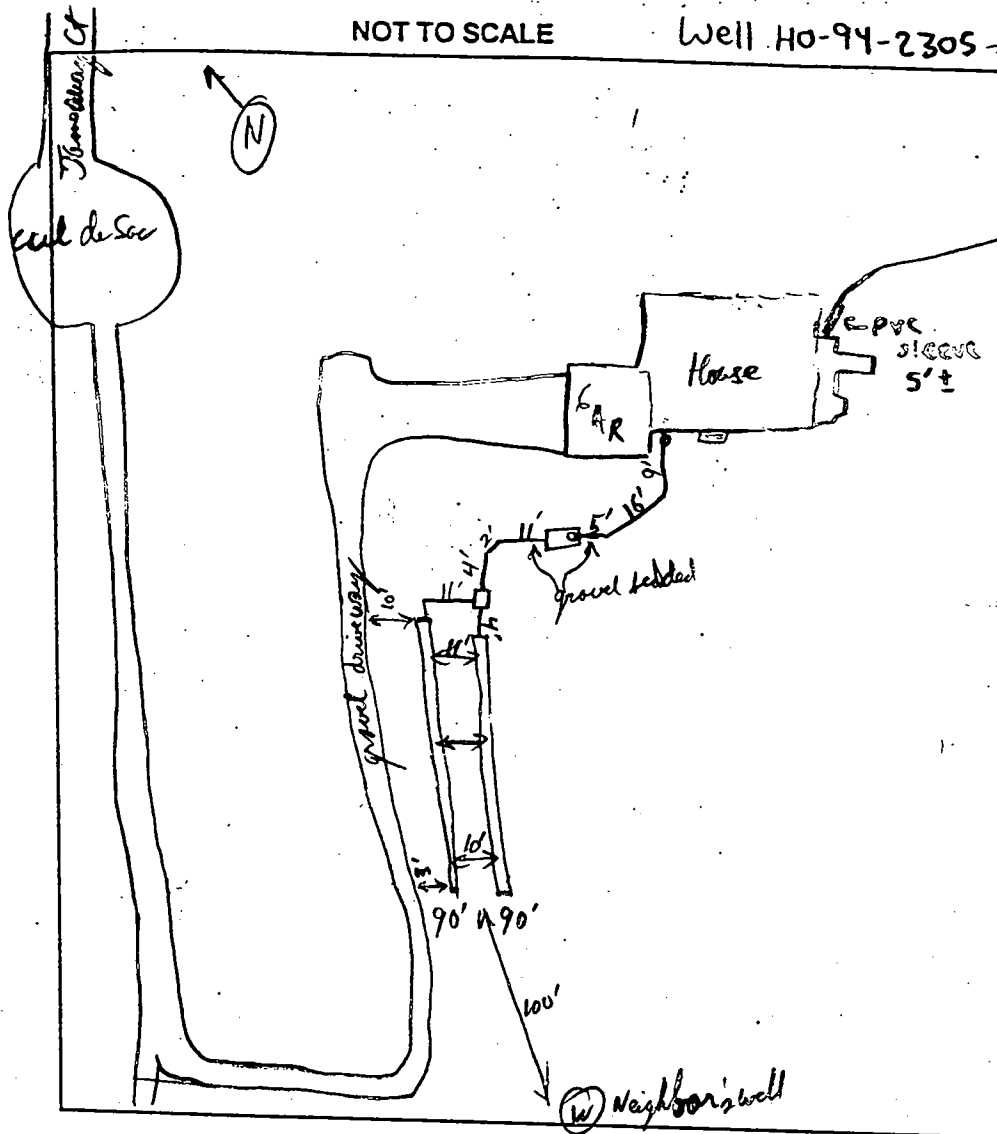

TRENCH DATA

TRENCH WIDTH 2'
 TRENCH INLET DEPTH 4'
 TRENCH BOTTOM DEPTH 8'
 DEPTH OF STONE 4'
 NUMBER OF TRENCHES 2 (90' ea)
 TOTAL TRENCH LENGTH 180 LF
 ABSORBENT AREA 720 sq ft
 DISTRIBUTION BOX LEVEL yes
 BAFFLE IN DISTRIBUTION BOX ☒

SEPTIC TANK DATA

SEPTIC TANK 1250 TB. GALLONS
 MANHOLE RISER NA
 6 INCH INSPECTION PORT ☒

PUMP CHAMBER DATA

PUMP CHAMBER GALLONS NA
 MANHOLE RISER _____
 ALARM _____
 PUMP PERFORMANCE TEST _____

PRE-CONSTRUCTION INSPECTION: Site almost linear, parallel to driveway. should be easy to install. RJP 3/15/01

INSPECTION COMMENTS: House connection OK, ST. OK, Baffles "T" OK, Trench OK, Dist Box OK
OK to cover all work. RJP 3/15/01

INSPECTOR

RJP

DATE SYSTEM APPROVED

3/15/01

APPLICATION

A 37387

SEWAGE DISPOSAL TESTING

P _____

STATE OF MARYLAND - DEPARTMENT OF HEALTH AND MENTAL HYGIENE

HOWARD COUNTY HEALTH DEPARTMENT
ENVIRONMENTAL HEALTH SERVICES
P O BOX 476, ELLICOTT CITY, MARYLAND 21043
TELEPHONE: 465-5000, EXT. 356

DISTRICT 5

DATE 7-14-86

TO: THE COUNTY HEALTH OFFICER
ELLICOTT CITY, MARYLAND

I, HEREBY, APPLY FOR THE NECESSARY TEST IN ORDER TO CONSTRUCT (OR RECONSTRUCT) A SEWAGE DISPOSAL SYSTEM.

PROPERTY OWNER S-Turner Nichols & James S. Nichols

ADDRESS 13270 Trudolphin Mill Road PHONE 531-2505
Clarksville

PROPERTY LOCATION:

SUBDIVISION Dunfarms LOT NO. 17 (16)

ROAD AND DESCRIPTION Fee Simple, pipe stem lot from
New Street - off Ten Oaks Road

SIZE OF LOT 3 Ac TYPE BLDG. _____
NUMBER OF BEDROOMS _____

IF NOT SINGLE RESIDENCE DESCRIBE _____

THE SYSTEM INSTALLED UNDER THIS APPLICATION IS ACCEPTABLE ONLY UNTIL PUBLIC FACILITIES BECOME AVAILABLE.

SIGNATURE OF APPLICANT James S. Nichols


APPROVED BY _____ FOR _____ DATE _____
(KIND OF SYSTEM)

REJECTED BY _____ FOR _____ DATE _____
(KIND OF SYSTEM)

HOLD PENDING FURTHER TESTS _____ DATE _____

REASONS FOR REJECTION OR HOLDING 8-27-86 PERC SATISFACTORY; HOLD FOR Subdivision Plat. S. 866

THIS IS NOT A PERMIT

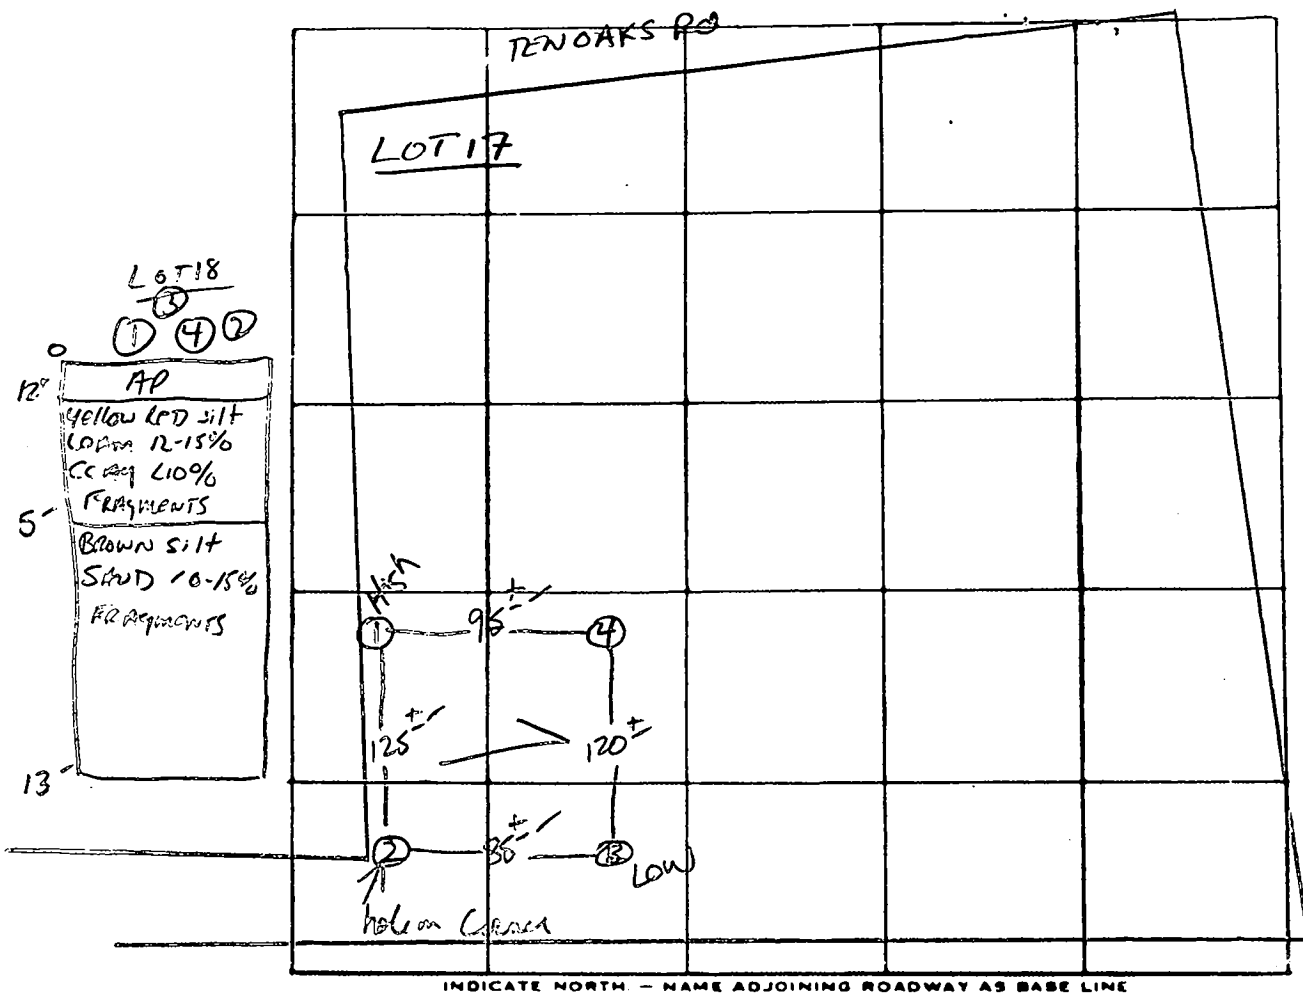

$\bar{x}$ Perc
8 min
INLET 4.5'
BOTTOM 9.0'
180 #/BR

DATE	TEST NO.	DEPTH	PRE-WET		TEST - 1" DROP		TIME
			START	STOP	START	STOP	
8/27/86	1 S M	5'	10:43	10:44	10:44	10:46	2 min
		9'	10:43	10:48	10:48	11:03	15 min
	1 V	13'	UNIFORM	SOIL below 5'			
	2 V	14'	UNIFORM	SOIL below 4.5'			
	3 S V	4' 13.5	10:47 UNIFORM	10:50 SOIL below 4'	10:50	10:59	9 min
	4 S V	4.5' 14	10:44 UNIFORM	10:45 SOIL below 4.5'	10:45	10:46	1 min

REMARKS HUES DIFF THAN PLAT

TYPE OF SOIL Glenn

TESTED BY S. Abel

ALSO PRESENT: J. Flock & Co

11/2/98
10:00

APPLICATION

PERCOLATION TESTING

A 5/1036

P _____

HOWARD COUNTY HEALTH DEPARTMENT

BUREAU OF ENVIRONMENTAL HEALTH

3525-H ELLICOTT MILLS DRIVE/ELLICOTT CITY, MARYLAND 21043
TELEPHONE: 313-2640

Proposal to resubdivide -
w/ Lot 18, but this
potential buyer
ended up not
purchasing Lot 16

DISTRICT _____

DATE 10/14/98

TO: THE COUNTY HEALTH OFFICER
ELLICOTT CITY, MARYLAND

I HEREBY APPLY FOR THE NECESSARY TEST PRIOR TO APPLICATION FOR PERMIT TO CONSTRUCT (OR RECONSTRUCT) A SEWAGE DISPOSAL SYSTEM.

PROPERTY OWNER Darren A. Lilly

ADDRESS 5405 Jamesway Ct. Clarksville MD. 21029 PHONE 410-336-0790

AGENT OR PROSPECTIVE BUYER _____

ADDRESS _____ PHONE _____

PROPERTY LOCATION:

SUBDIVISION Dunfermin Estates LOT NO. 104

ROAD AND DESCRIPTION Jamesway Ct.

TAX MAP 34 PARCEL # 292

SIZE OF LOT 1 acre TYPE BLDG. Single Family Dwelling
(SINGLE FAMILY DWELLING OR COMMERCIAL)

THE SYSTEM INSTALLED UNDER THIS APPLICATION IS ACCEPTABLE ONLY UNTIL PUBLIC FACILITIES BECOME AVAILABLE. I FULLY UNDERSTAND THE FEE CONNECTED WITH THE FILING OF THIS PERC TEST APPLICATION IS NON-REFUNDABLE UNDER ANY CIRCUMSTANCES. I ALSO AGREE TO COMPLY WITH ALL M.O.S.H.A. REQUIREMENTS IN TESTING THIS LOT.

(SIGNATURE OF APPLICANT)

APPROVED BY _____ FOR _____ DATE _____

DISAPPROVED BY _____ FOR _____ DATE _____

HOLD PENDING FURTHER TESTS _____

REASONS FOR REJECTION OR HOLDING _____

PERCOLATION TEST PLAT/PRELIMINARY PLAT - TITLE OR I.D. # _____ DATE _____

SITE DEVELOPMENT PLAN/FINAL PLAT - TITLE OR I.D. # _____ DATE _____

THIS IS NOT A PERMIT

COUNTY #

SOIL PROFILE

All

topsoil

org brn
cl lmpale pk
tan
scl lm
w/mica
flocs25-30%
rock
frags

SOIL PROFILE

INDICATE NORTH - NAME ADJOINING ROADWAY AS BASE LINE.

Jamesway Court

DATE	TEST NO.	DEPTH	PRE-WET		TEST - 1" DROP		TIME
			START	STOP	START	STOP	
11-2-98	1	4.5' S	10:32	10:37	10:37	10:45	8
		12.0' D	Visual	- See	profile		OK
	2	4' 8" S	10:36	10:38.2	10:38.2	10:47.3	9
		12.0' D	Visual	- See	profile		OK
	3	4.5' S	11:00	11:01	slow	→	OK below
		12.0' D	Visual	- See	profile		OK
	4	5' 4" S	10:58	11:03	11:03	11:10	7
		12.5' D	Visual	- See	profile		OK

REMARKS test holes not stacked

TYPE OF SOIL

TESTED BY D. Soe

ALSO PRESENT D. Lilly

TRENCH DESIGN DATA: AVERAGE PERCOLATION TIME 8 TRENCH WIDTH 3

INLET DEPTH 4.0 MAXIMUM BOTTOM DEPTH 6.0 SQ. FT./BEDROOM 210

11/2/98
10:00

APPLICATION

PERCOLATION TESTING

A 5/1036

P _____

HOWARD COUNTY HEALTH DEPARTMENT

BUREAU OF ENVIRONMENTAL HEALTH

3525-H ELLICOTT MILLS DRIVE/ELLICOTT CITY, MARYLAND 21043
TELEPHONE: 313-2640

DISTRICT _____

DATE 10/14/98

TO: THE COUNTY HEALTH OFFICER
ELLICOTT CITY, MARYLAND

I HEREBY APPLY FOR THE NECESSARY TEST PRIOR TO APPLICATION FOR PERMIT TO CONSTRUCT (OR RECONSTRUCT) A SEWAGE DISPOSAL SYSTEM.

PROPERTY OWNER Darren A. Lilly

ADDRESS 5405 Jamesway Ct. Clarksville MD. 21029 PHONE 410-336-0790

AGENT OR PROSPECTIVE BUYER _____

ADDRESS _____ PHONE _____

PROPERTY LOCATION:

SUBDIVISION Dunfermin Estates LOT NO. 1018

ROAD AND DESCRIPTION Jamesway Ct.

TAX MAP 34 PARCEL # 292

SIZE OF LOT 1 acre TYPE BLDG. Single Family Dwelling
(SINGLE FAMILY DWELLING OR COMMERCIAL)

THE SYSTEM INSTALLED UNDER THIS APPLICATION IS ACCEPTABLE ONLY UNTIL PUBLIC FACILITIES BECOME AVAILABLE. I FULLY UNDERSTAND THE FEE CONNECTED WITH THE FILING OF THIS PERC TEST APPLICATION IS NON-REFUNDABLE UNDER ANY CIRCUMSTANCES. I ALSO AGREE TO COMPLY WITH ALL M.O.S.H.A. REQUIREMENTS IN TESTING THIS LOT.

(SIGNATURE OF APPLICANT)

APPROVED BY _____ FOR _____ DATE _____

DISAPPROVED BY _____ FOR _____ DATE _____

HOLD PENDING FURTHER TESTS _____

REASONS FOR REJECTION OR HOLDING _____

PERCOLATION TEST PLAT/PRELIMINARY PLAT - TITLE OR I.D. # _____ DATE _____

SITE DEVELOPMENT PLAN/FINAL PLAT - TITLE OR I.D. # _____ DATE _____

THIS IS NOT A PERMIT

COUNTY #

SOIL PROFILE

⑤

topsoil

red brn
cl Lmpale red
arg
sa Lm
w/mica
flocs15-20%
rock
frag


⑥

topsoil

red brn
cl Lmpale org
arg
sa Lm
w/mica
flocs25-30%
rock
frag

⑦

topsoil

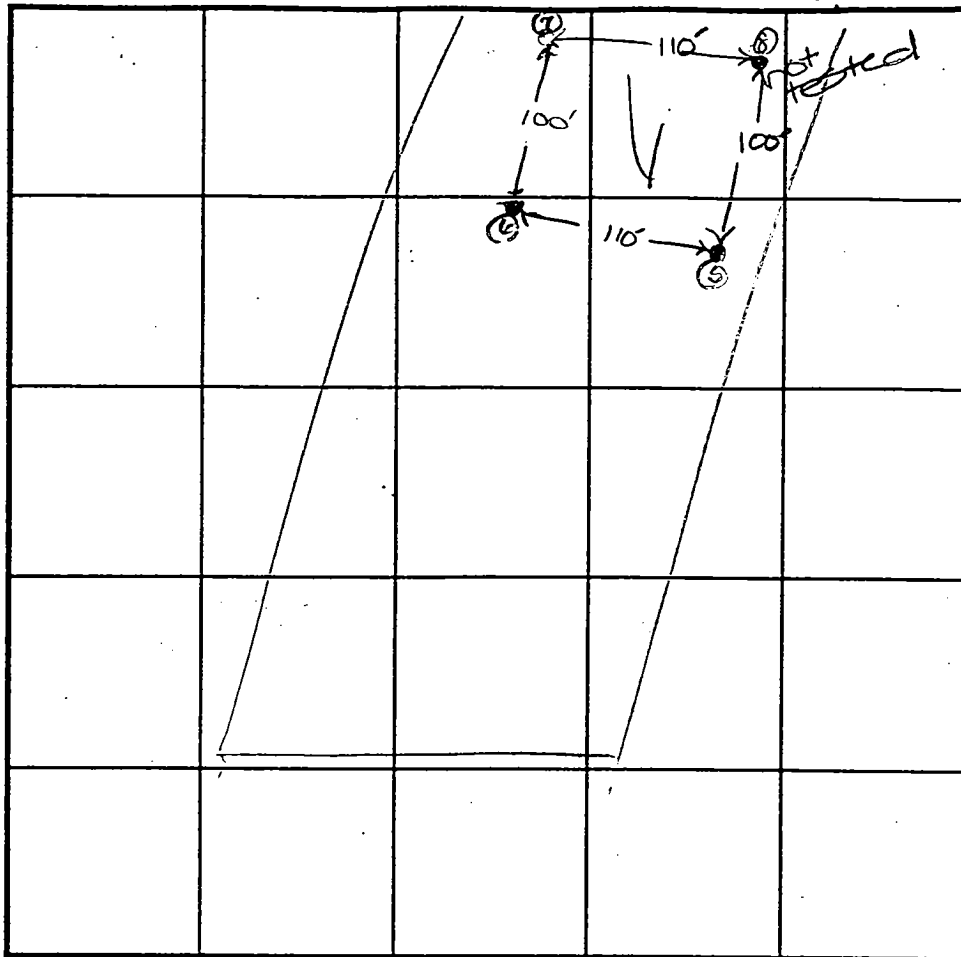red org
brn
cl Lmdk pk
brn
sa Lm
w/mica
flocs
(moist)

SOIL PROFILE

INDICATE NORTH - NAME ADJOINING ROADWAY AS BASE LINE.

DATE	TEST NO.	DEPTH	PRE-WET		TEST - 1" DROP		TIME
			START	STOP	START	STOP	
11-2-98	5	5.0' S	11:44	11:48	11:48	11:52	4
		14.0' D	Visual	- See	profile		Hold
	6	5.0' S	12:21	slow			→
		13'9" D	Visual	- See	profile		Hold
	7	5.0' S	11:06	slow			→
		14.0' D					Hold

(Hold for wet season)

REMARKS test holes not stated (all measurements are approx.)

TYPE OF SOIL

TESTED BY D. Sue ALSO PRESENT D. Lilly

TRENCH DESIGN DATA: AVERAGE PERCOLATION TIME TRENCH WIDTH

INLET DEPTH MAXIMUM BOTTOM DEPTH SQ. FT./BEDROOM

THE MINIMUM OWNERSHIP WIDTHS AND
AND STATE DEPARTMENT OF HEALTH

MATCH

D.C. BURG
L.1109 F.256

S 15°-59'-35" E 476.00'

441.00'

BRIT

LOT 16

3847 Ac.±

F 88-96

B.R.

N 00°

B.R.I.

LOT 17


3.001 Ac.±

B.R.L

S 15°-25'-20" E 396.15'

S 15°-25'-20" E 431.75'

MATCH LINE SEE

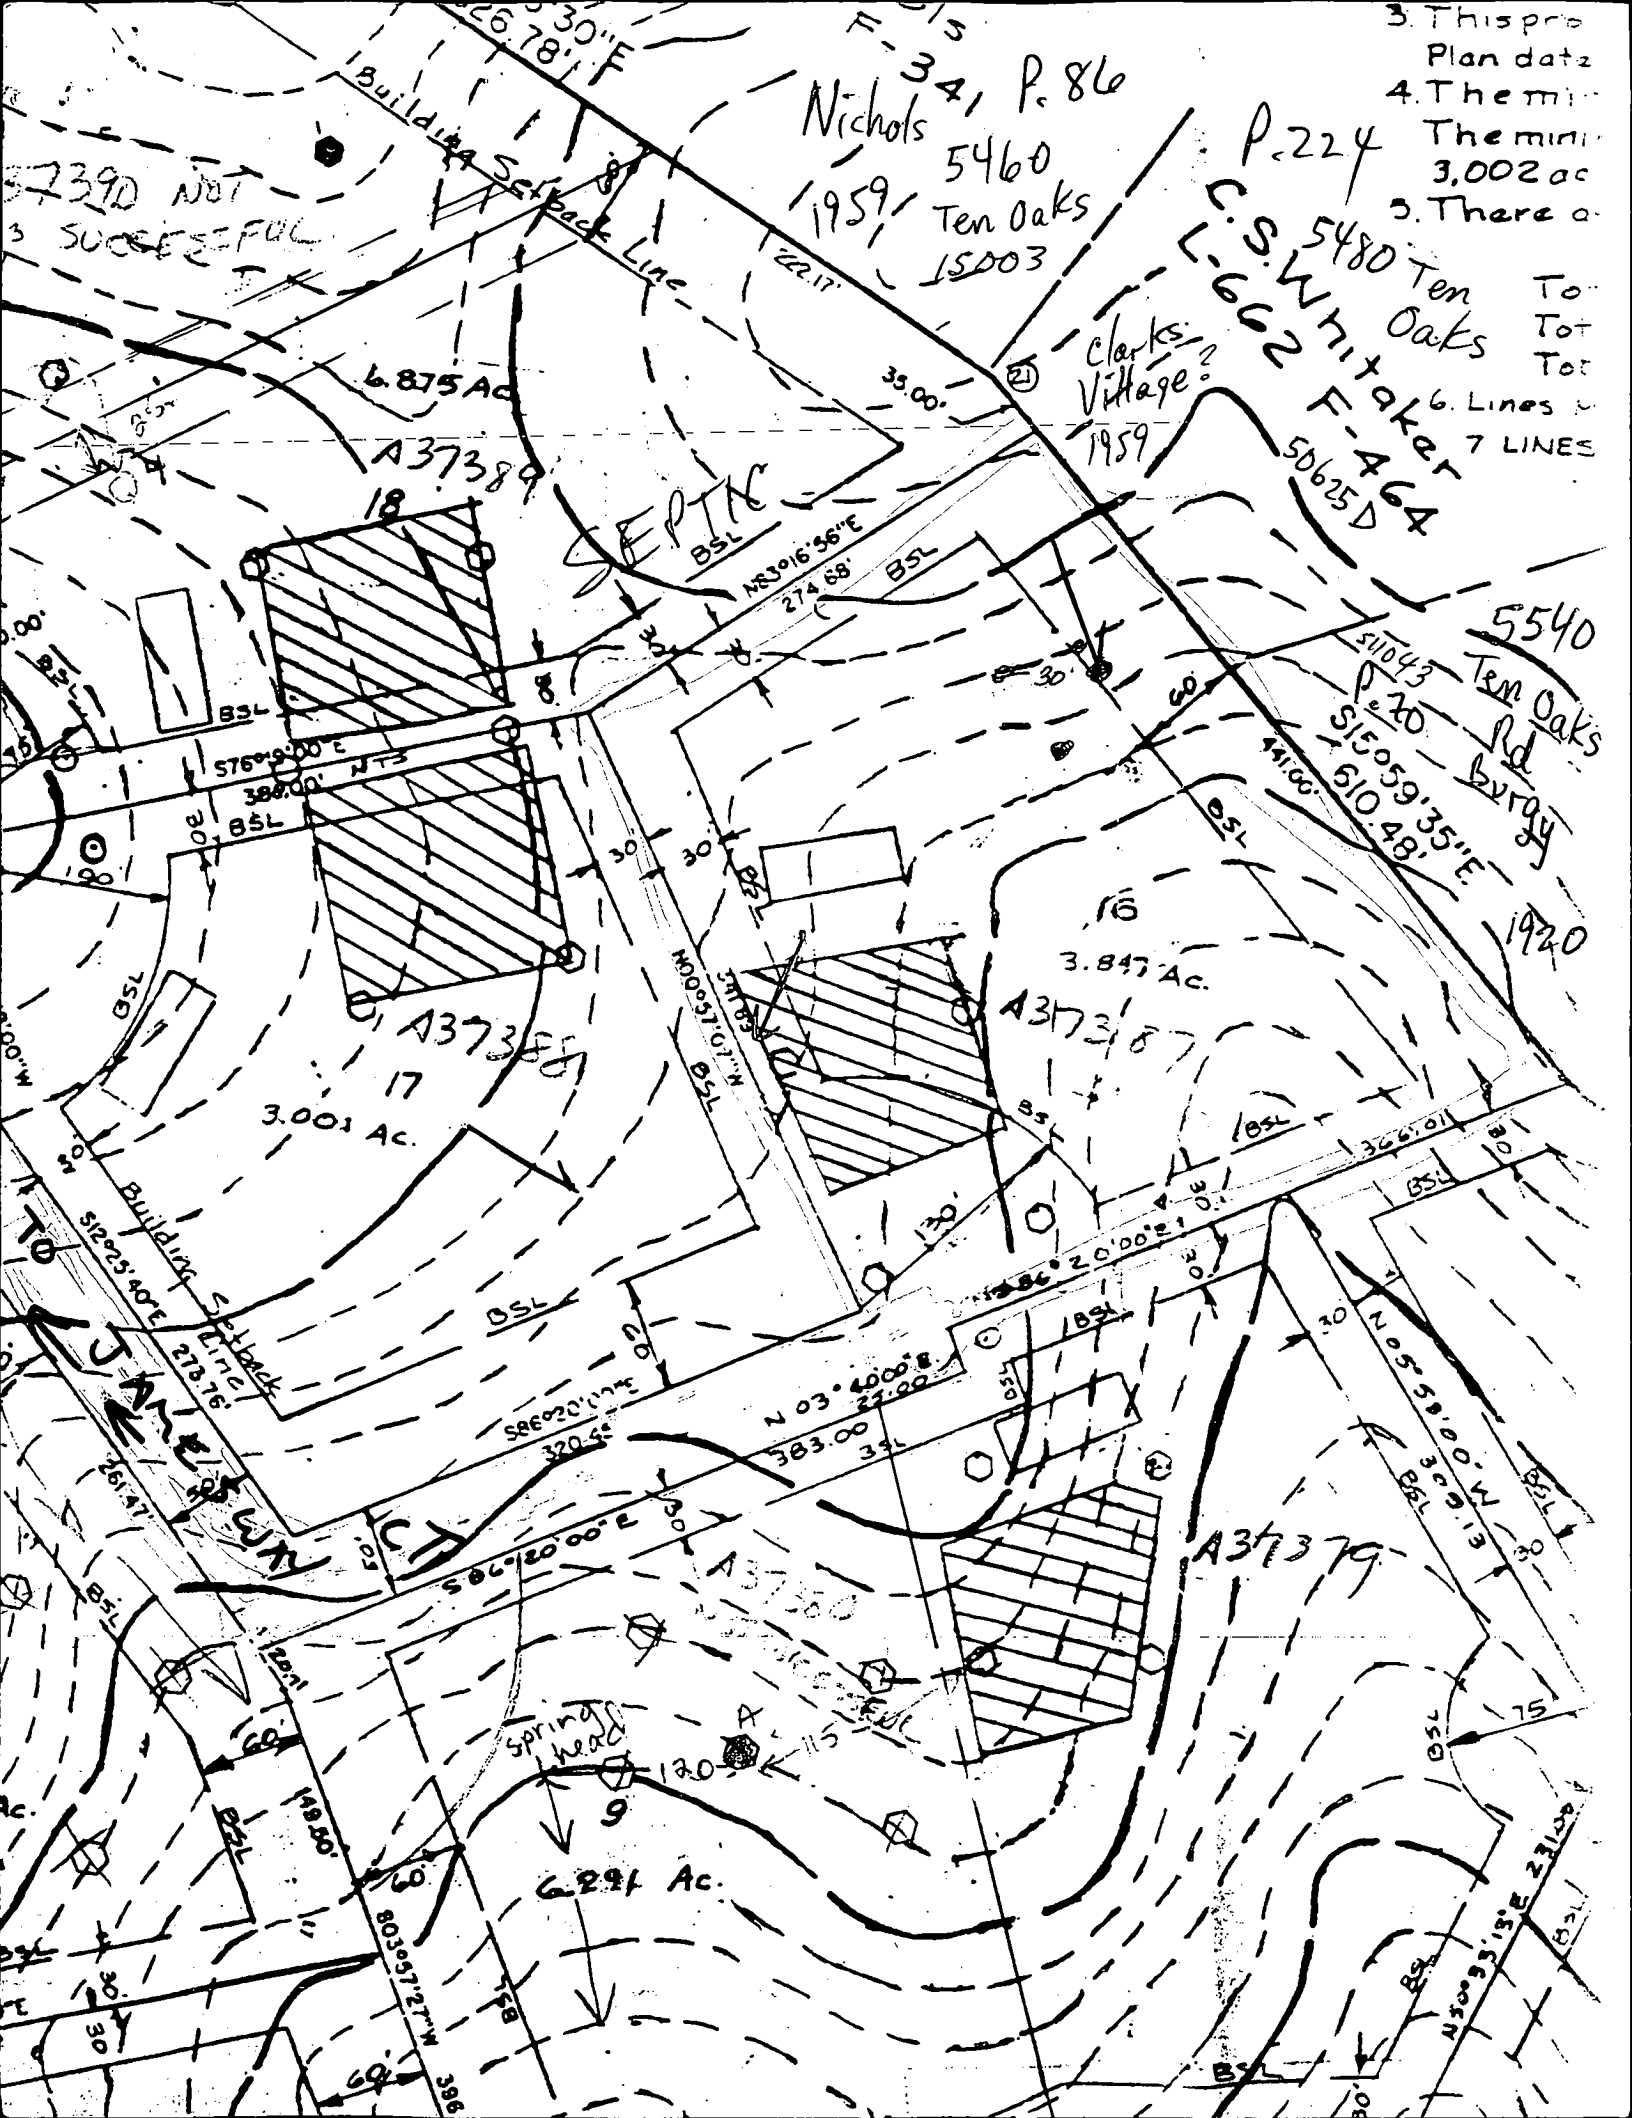

11/2/98
10:00

APPLICATION

PERCOLATION TESTING

A 5/1036

P _____

HOWARD COUNTY HEALTH DEPARTMENT

BUREAU OF ENVIRONMENTAL HEALTH

3525-H ELLICOTT MILLS DRIVE/ELLICOTT CITY, MARYLAND 21043
TELEPHONE: 313-2640

DISTRICT _____

DATE 10/14/98

TO: THE COUNTY HEALTH OFFICER
ELLICOTT CITY, MARYLAND

I HEREBY APPLY FOR THE NECESSARY TEST PRIOR TO APPLICATION FOR PERMIT TO CONSTRUCT (OR RECONSTRUCT) A SEWAGE DISPOSAL SYSTEM.

PROPERTY OWNER Darren A. Lilly

ADDRESS 5405 Jamesway Ct. Clarksville MD. 21029 PHONE 410-336-0790

AGENT OR PROSPECTIVE BUYER _____

ADDRESS _____ PHONE _____

PROPERTY LOCATION:

SUBDIVISION Dunfermin Estates LOT NO. _____

ROAD AND DESCRIPTION Jamesway Ct.

TAX MAP 34 PARCEL # 292

SIZE OF LOT 1 acre TYPE BLDG. Single Family Dwelling
(SINGLE FAMILY DWELLING OR COMMERCIAL)

THE SYSTEM INSTALLED UNDER THIS APPLICATION IS ACCEPTABLE ONLY UNTIL PUBLIC FACILITIES BECOME AVAILABLE. I FULLY UNDERSTAND THE FEE CONNECTED WITH THE FILING OF THIS PERC TEST APPLICATION IS NON-REFUNDABLE UNDER ANY CIRCUMSTANCES. I ALSO AGREE TO COMPLY WITH ALL M.O.S.H.A. REQUIREMENTS IN TESTING THIS LOT. _____
(SIGNATURE OF APPLICANT)

APPROVED BY _____ FOR _____ DATE _____

DISAPPROVED BY _____ FOR _____ DATE _____

HOLD PENDING FURTHER TESTS _____

REASONS FOR REJECTION OR HOLDING _____

PERCOLATION TEST PLAT/PRELIMINARY PLAT - TITLE OR I.D. # _____ DATE _____

SITE DEVELOPMENT PLAN/FINAL PLAT - TITLE OR I.D. # _____ DATE _____

THIS IS NOT A PERMIT

COUNTY #

SOIL PROFILE

(9)

topsoil


org brn
cl lmpale
org tan
sil m
w mica
flecs25%
rock
frag

(10)

topsoil

red org
brn
cl lmpale pk
tan
sil m
w few
mica
flecs20%
rock
frag

SOIL PROFILE

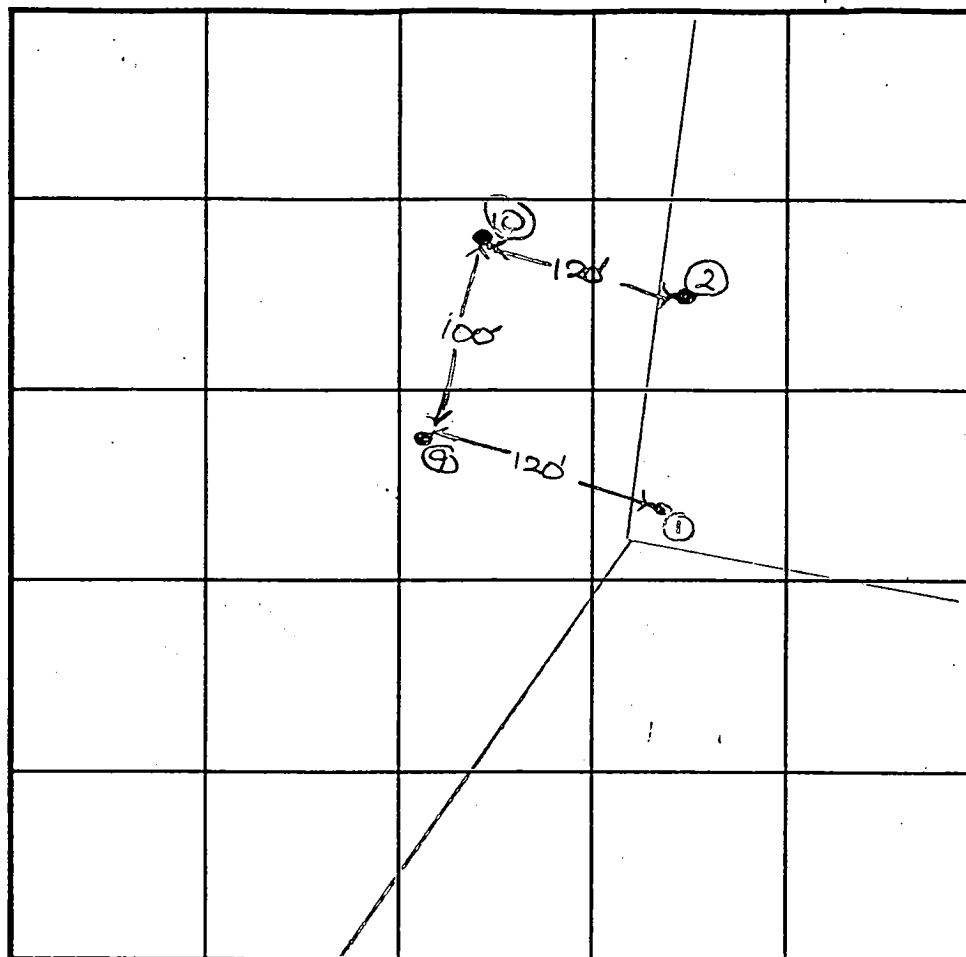

INDICATE NORTH - NAME ADJOINING ROADWAY AS BASE LINE.

Jamesway Court

DATE	TEST NO.	DEPTH	PRE-WET		TEST - 1" DROP		TIME
			START	STOP	START	STOP	
11-2-98	9	4.0'S	3:30	3:35	3:35	3:40	5
		11.0'D	Visual	- See	profile		OK
	10	11.0'D	Visual	- See	profile		OK

REMARKS test holes not started

TYPE OF SOIL _____

TESTED BY D. SaxeALSO PRESENT D. Lilly

TRENCH DESIGN DATA: AVERAGE PERCOLATION TIME

5

TRENCH WIDTH

3INLET DEPTH 3.5

MAXIMUM BOTTOM DEPTH

5.5

SQ. FT./BEDROOM

180

3/20/01
3/19/01
Q.M.

HOWARD COUNTY HEALTH DEPARTMENT
Bureau of Environmental Health
3525-H Ellicott Mills Drive
Ellicott City, MD 21043
461-9933

APPLICATION FOR PITLESS ADAPTER, WELL PUMP AND PRESSURE TANK INSTALLATION

New Installation X
Replacement _____

Receipt # _____

Date 3/19/01

Name of Installer T&R Plumbing And Heating

Telephone 301-725-2392

License Number 7079

Certified Well Pump Installer _____

Well Driller _____

Registered Plumber X

Name of Property Owner Kevin Becraft

Telephone 301-854-2005

Subdivision Dunfarm Estates Lot # 16

Well Tag # HD-94-2305

Site Address 5421 Jamesway Ct., Clarksville, MD 21029

Pump

1. Type

a. Deep well jet _____

b. Shallow well jet _____

c. Submersible X

2. Make Gould

3. Model # _____

4. Capacity 5 GPM

5. Pump exceeds well capacity Yes ✓ No _____

6. If Yes, is low pressure cutoff switch installed? Yes ✓ No _____

7. What methods are used to protect the pump and electrical wiring from vibrations? Torque arrestors ✓ Cable guards _____ Other _____

Motor

1. Horsepower 3/4

2. RPM _____

3. Voltage _____

a. 110 _____

b. 220 X

Pitless Adapter

1. Make Harvard

2. Model # _____

3. Depth 4'

Tank

1. Capacity 250 gal equiv.

2. Pressure relief valve? Yes

Piping

1. Type Crestlon

2. Size 1"

3. NSF and/or BOCA Code approved yes

4. Depth of supply line 4'

Well data

1. Depth 350 ft.

2. Yield 2 GPM

3. Static water level 23 ft.

4. Will water supply be disinfected by installer? NO

I understand that it is my responsibility to notify the Howard County Health Department when the installation is ready for inspection (otherwise this permit is null and void).

All information given above is true to the best of my knowledge.

3/20/01-WPI OK

except electrical

conduit. Installer used

well pipe instead of PVC.

Told Builder and Installer to fix (SRN)

Signature of Applicant: _____

Date: 3-19-01

Note: A sticker indicating approval/status of the installation will be placed on the well casing at the time of the inspection.

HD-215

4/6/01-CONDUIT FIXED

WPI FINALED - (SRN)

C1 06610 SEQUENCE NO. (MDE USE ONLY)

STATE OF MARYLAND
WELL COMPLETION REPORT
FILL IN THIS FORM COMPLETELY
PLEASE PRINT OR TYPE

THIS REPORT MUST BE SUBMITTED WITHIN 45 DAYS AFTER WELL IS COMPLETED.

COUNTY NUMBER A37387

ST/CO USE ONLY DATE Received MM - DD YY 8 - 30 - 99 DATE WELL COMPLETED 15 - 30 - 99 Depth of Well 22 350 26 (TO NEAREST FOOT) PERMIT NO. FROM "PERMIT TO DRILL WELL" 40-94-2305

OWNER Recraft Liz + Kevin last name STREET OR RFD Jamesway CR TOWN Clarksville SUBDIVISION DUNFARMIN SECTION LOT 16

WELL LOG		
Not required for driven wells		
STATE THE KIND OF FORMATIONS PENETRATED, THEIR COLOR, DEPTH, THICKNESS AND IF WATER BEARING		
DESCRIPTION (Use additional sheets if needed)	FEET	check if water bearing
	FROM TO	
Brown mica soil	0 20'	
Light Brown mica	20' 40'	
Dark Brown mica	40' 50'	
Soft tan weathered mica rock	50' 55'	
Med Hard Gray mica rock	55' 350'	
	73 ✓	

GROUTING RECORD

WELL HAS BEEN GROUTED (Circle Appropriate Box) YES ☒ NO ☐

TYPE OF GROUTING MATERIAL (Circle one) CEMENT ☒ BENTONITE CLAY ☐

NO. OF BAGS 45 15 NO. OF POUNDS 140 40

GALLONS OF WATER 90

DEPTH OF GROUT SEAL (to nearest foot) from 0 ft. to 60 ft. (enter 0 if from surface)

CASING RECORD

types insert appropriate code below

STEEL ☒ CONCRETE ☐ PLASTIC ☐ OTHER ☐

MAIN CASING TYPE PT

Nominal diameter top (main) casing (nearest inch) 60

Total depth of main casing (nearest foot) 60

OTHER CASING (if used) diameter inch depth (feet) from to

PUMPING TEST

HOURS PUMPED (nearest hour) 6

PUMPING RATE (gal. per min.) 2

METHOD USED TO MEASURE PUMPING RATE: Watch Puckett

WATER LEVEL (distance from land surface) BEFORE PUMPING 23 ft. WHEN PUMPING 20 ft.

TYPE OF PUMP USED (for test) A air P piston T turbine C centrifugal R rotary O other (describe below) J jet S submersible

Dry Hole Sealed with Rock Cutting & cement grout

SCREEN RECORD

screen type or open hole insert appropriate code below

STEEL ☒ BRASS ☐ OPEN HOLE ☐ PLASTIC ☐ OTHER ☐

PUMP-INSTALLED

DRILLER WILL INSTALL PUMP (CIRCLE) (YES or NO) YES NO

IF DRILLER INSTALLS PUMP, THIS SECTION MUST BE COMPLETED FOR ALL WELLS.

TYPE OF PUMP INSTALLED PLACE (A,C,J,P,R,S,T,O) IN BOX 29

CAPACITY: GALLONS PER MINUTE (to nearest gallon) 31 35

PUMP HORSE-POWER 37 40

PUMP COLUMN LENGTH (nearest ft.) 43 47

CASING HEIGHT (circle appropriate box and enter casing height) + above } LAND SURFACE - below } 2 (nearest foot)

NUMBER OF UNSUCCESSFUL WELLS 1

WELL HYDROFRACTURED yes ☒ no ☐

DEPTH (nearest ft.) 60 350

E A C H S R E E N

8 9 11 15 17 21

23 24 26 30 32 36

38 39 41 45 47 51

SLOT SIZE 1 2 3

DIAMETER OF SCREEN (NEAREST INCH) 56 60 from to


CIRCLE APPROPRIATE LETTER

A A WELL WAS ABANDONED AND SEALED WHEN THIS WELL WAS COMPLETED

E ELECTRIC LOG OBTAINED

P TEST WELL CONVERTED TO PRODUCTION WELL

I HEREBY CERTIFY THAT THIS WELL HAS BEEN CONSTRUCTED IN ACCORDANCE WITH COMAR 26.04.04 "WELL CONSTRUCTION" AND IN CONFORMANCE WITH ALL CONDITIONS STATED IN THE ABOVE CAPTIONED PERMIT, AND THAT THE INFORMATION PRESENTED HEREIN IS ACCURATE AND COMPLETE TO THE BEST OF MY KNOWLEDGE.

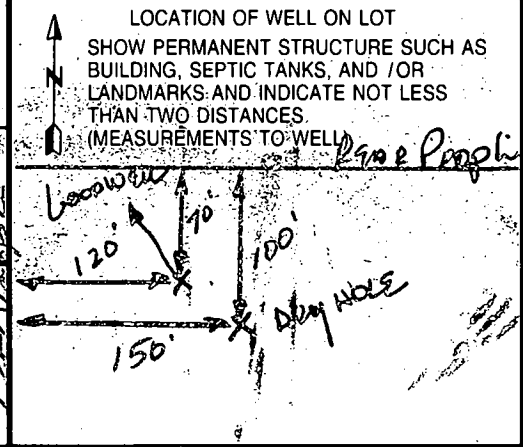

DRILLERS LIC. NO. M 355

DRILLERS SIGNATURE (MUST MATCH SIGNATURE ON APPLICATION)

LIC. NO. 1 M 46 549

SITE SUPERVISOR (sign. of driller or journeyman responsible for sitework if different from permittee)

GRAVEL PACK IF WELL DRILLED WAS FLOWING WELL INSERT F IN BOX 68

MDE USE ONLY (NOT TO BE FILLED IN BY DRILLER)

T (E.R.O.S.) W Q

70 72 74 75 76

TELESCOPE CASING LOG INDICATOR OTHER DATA

Page 1 of 2
Date 10-30-99

Review OK 7/12/99 DCS

FIELD DATA SHEET
HOWARD COUNTY WELL YIELD TEST

Well Permit No. HO - 94-2305
Location of property (road) JAMESWAY CT
Subdivision DUN FARMIN Lot 16 Block Plat Sec.
Well Driller BARLOW Owner BECRAFT LIZ/KEVIN

Depth of well 350
Distance of measuring point (M.P.) above ground
Static water level (S.W.L.) below M.P.

I. High rate pumping -- reservoir drawdown

Time pump started Pumping rate 2
Total time to reach pumping water level ft. below M.P.



II. Recovery pump test data - observations to be recorded every 15 minutes

TIME (in 15 minute intervals)	WATER LEVEL below M.P.	PUMPING RATE time to fill 5 gallon bucket	FLOW METER READING (if used)	CALCULATED FLOW (gallons per minute)
7:30	23'	6 sec		10
7:45	64'	6 sec		10
8:00	73'	8 sec		7.5
8:15	102'	8 sec		7.5
8:30	137'	12 sec		5
8:45	202'	30 sec		2
9:00	202'	30 sec		2
9:15	202'	30 sec		2
9:30	202'	30 sec		2
9:45	202'	30 sec		2
10:00	202'	30 sec		2
10:15	202'	30 sec		2
10:30	202'	30 sec		2
10:45	202'	30 sec		2
11:00	202'	30 sec		2
11:15	202'	30 sec		2
11:30	202'	30 sec		2
11:45	202'	30 sec		2
12:00	202'	30 sec		2
12:15	202'	30 sec		2
12:30	202'	30 sec		2
12:45	202'	30 sec		2
1:00	202'	30 sec		2
1:15	202'	30 sec		2

301-854-2005

EMERGENCY/TEMP NO. IF ANY

W511903 ✓

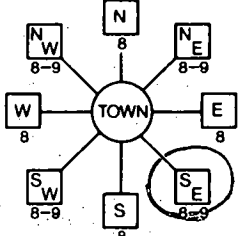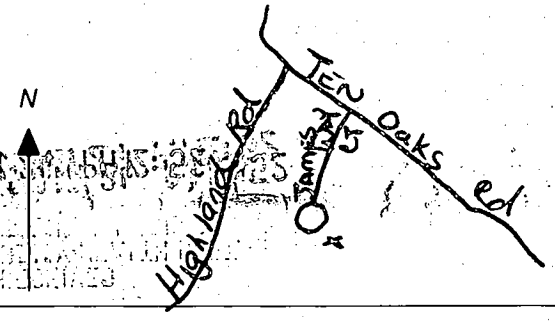B 1 16610 1 2 3 4 5 6	SEQUENCE NO. (MDE USE ONLY)	STATE OF MARYLAND PERMIT TO DRILL WELL please print or type	STATE PERMIT NUMBER H0-94-2305 70 fill in this form completely 79
Date Received (APA) 05 24 99 8 MM DD YY 13 BE CRAFT LIZ & KEVIN 15 Last Name Owner First Name 34 14035 Triadelphia Mill Rd 36 Street or RFD 55 DAYTON MD 21036 57 Town 70 State 72 Zip 76		B 3 Howard LOCATION OF WELL 8 COUNTY 21 Dunfarmin 23 SUBDIVISION 42 SECTION 16 LOT 16 44 46 48 50 DAYTON Clarksville 52 NEAREST TOWN 71 MILES FROM TOWN (enter 0 if in town) 3 M I 73 76 77 78	
DRILLER INFORMATION MICHAEL BARLOW MW D 355 Driller's Name 76 License No. 81 MICHAEL BARLOW Well Drilling Svc Inc Firm Name 912 Fawn Court Joppa, MD 21085 Address [Signature] 5/21/99 Signature Date		B 4 Jamesway CT 11 NEAR WHAT ROAD 30 ON WHICH SIDE OF ROAD (CIRCLE APPROPRIATE BOX) 34 800 37 DISTANCE FROM ROAD FT. ENTER FT OR MI 38 39 TAX MAP: 28 BLK: 21 PARCEL: 292	
B 2 WELL INFORMATION 1 2 APPROX. PUMPING RATE (GAL. PER MIN.) 5 8 12 AVERAGE DAILY QUANTITY NEEDED (GAL. PER DAY) 500 14 20		DIRECTION OF WELL FROM TOWN (CIRCLE BOX)  ON WHICH SIDE OF ROAD (CIRCLE APPROPRIATE BOX)  ENTER FT OR MI FT. TAX MAP: 28 BLK: 21 PARCEL: 292	
USE FOR WATER (CIRCLE APPROPRIATE BOX) ☒ DOMESTIC POTABLE SUPPLY & RESIDENTIAL IRRIGATION ☐ FARMING (LIVESTOCK WATERING & AGRICULTURAL IRRIGATION) ☐ INDUSTRIAL, COMMERCIAL, DEWATERING ☐ PUBLIC WATER SUPPLY WELL ☐ TEST, OBSERVATION, MONITORING ☐ GEO-THERMAL		NOT TO BE FILLED IN BY DRILLER HEALTH DEPARTMENT APPROVAL Howard A37387 COUNTY NAME COUNTY NO. STATE SIGNATURE Mark E. Ripkin INSERT S → DATE ISSUED 06 25 99 41 43 MM DD YY 48 CO SIGNATURE EXP. DATE NORTH GRID 504 000 EAST GRID 0808 000 50 55 57 63	
APPROXIMATE DEPTH OF WELL 300 FEET 24 28 APPROXIMATE DIAMETER OF WELL 6" NEAREST INCH METHOD OF DRILLING (circle one) BORED (or Augered) JETTED Jetted & DRIVEN AIR-ROTARY AIR-PERCUSSION ROTARY (Hydraulic Rotary) CABLE REVERSE-ROTARY Drive-POINT other		SHOW MAJOR FEATURES OF BOX & LOCATE WELL WITH AN X SOURCES OF DRILLING WATER 1. 2. 3. WRITE THE BOX NUMBER FROM THE MAP HERE E 8008 N 5X004 000 000	
REPLACEMENT OR DEEPEMED WELLS (CIRCLE APPROPRIATE BOX) ☒ THIS WELL WILL NOT REPLACE AN EXISTING WELL ☐ THIS WELL WILL REPLACE A WELL THAT WILL BE ABANDONED AND SEALED ☐ THIS WELL WILL REPLACE A WELL THAT WILL BE USED AS A STANDBY-CONTACT LOCAL APPROVING AUTHORITY FOR POLICY ON STANDBY WELLS ☐ THIS WELL WILL DEEPEMED AN EXISTING WELL PERMIT NUMBER OF WELL TO BE REPLACED OR DEEPEMED (IF AVAILABLE) 41 _____ 52		DRAW A SKETCH BELOW SHOWING LOCATION OF WELL IN RELATION TO NEARBY TOWNS AND ROADS AND GIVE DISTANCE FROM WELL TO NEAREST ROAD JUNCTION 	
Not to be filled in by driller (MDE OR COUNTY USE ONLY)			
APPROP. PERMIT NUMBER 54 H0-94-2305 63 PERMIT No. 70 71 72 73 74 75 76 77 78 79			
SPECIAL CONDITIONS NOTE - APPROVING AUTHORITIES SHOULD USE SEPARATE SHEET IF NEEDED			

Well Permit No. HO - 94-2305
Location of property (road) Jamesway Ct
Subdivision DUNEARMIN Lot 16 Block Plat Sec.
Well Driller Barlow Owner Becraft, Liz / Kevin

Depth of well _____
Distance of measuring point (M.P.) above ground _____
Static water level (S.W.L.) below M.P. _____

Time pump started _____ Pumping rate _____
Total time _____ to reach pumping water level _____ ft. below M.P.

[illegible]

COMPREHENSIVE
MINIMUM OWNERSHIP WIDTHS AND
STATE DEPARTMENT OF HEALTH

C.S. WHITAKER
L. 852 F. 484

D. 100
L. 100

CHOLS
F. 341
30" E

566.04'

6/29/99
3rd site
OK

S 55° 59' 35" E 41'

74

E 808500

N 504000

HIGHLIGHTED
TEST HOLES
FAILED

2 WELLSITES
OK MR 6/25/99

I WAS TOLD
2 OF THIS AREA
WORK BETTER
FOR A WELL

SEE

MATCH LINE

Liz & Kevin
Becraft
301-854-2005


934
846

N 504000

CLRT

39

70

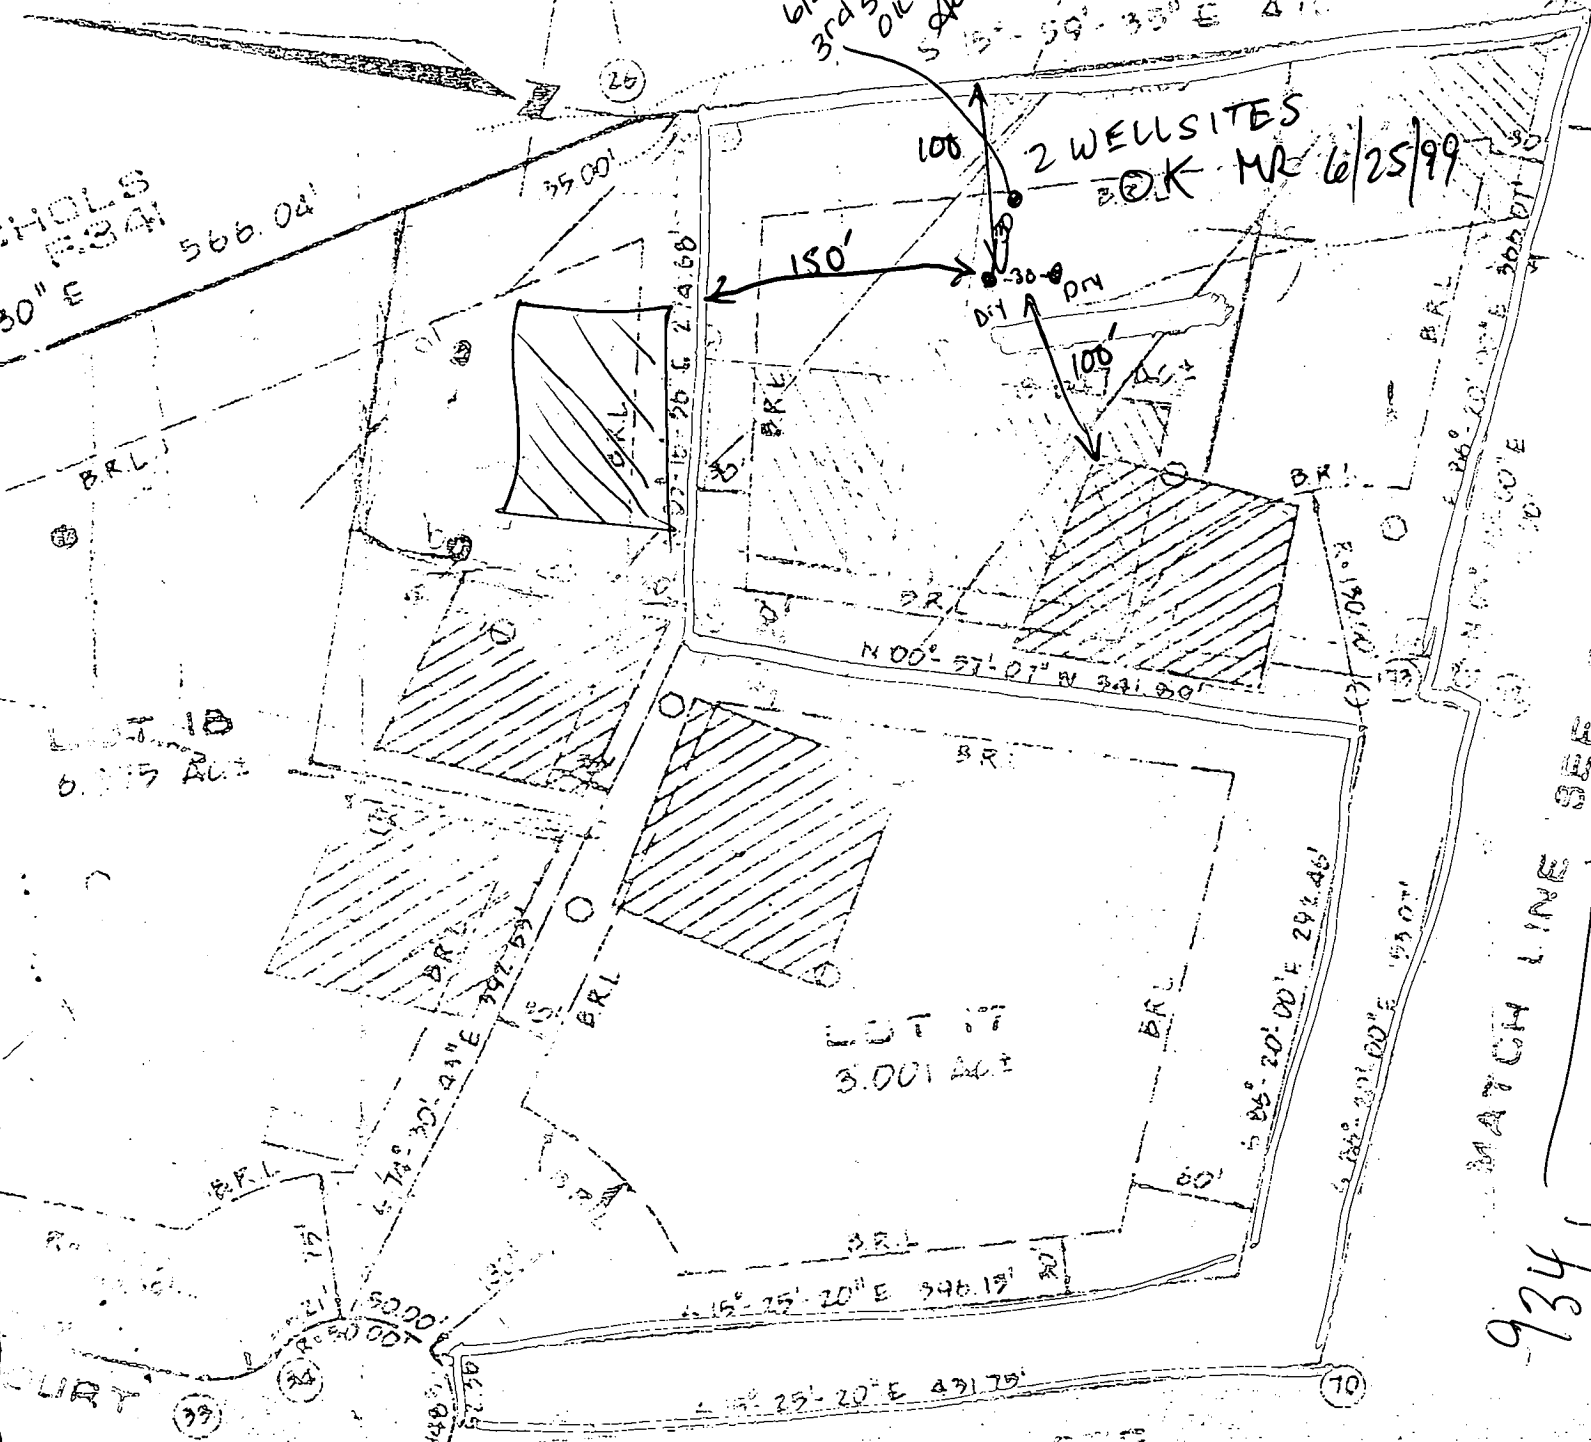



FROM : HoCo EnvHealth

FAX NO. : 4103152046

Feb. 08 2001 12:45PM P2

BPD BEARING	DELTA ANGLE	TANGENT
74°34'03" E	58°59'43"	28.86'

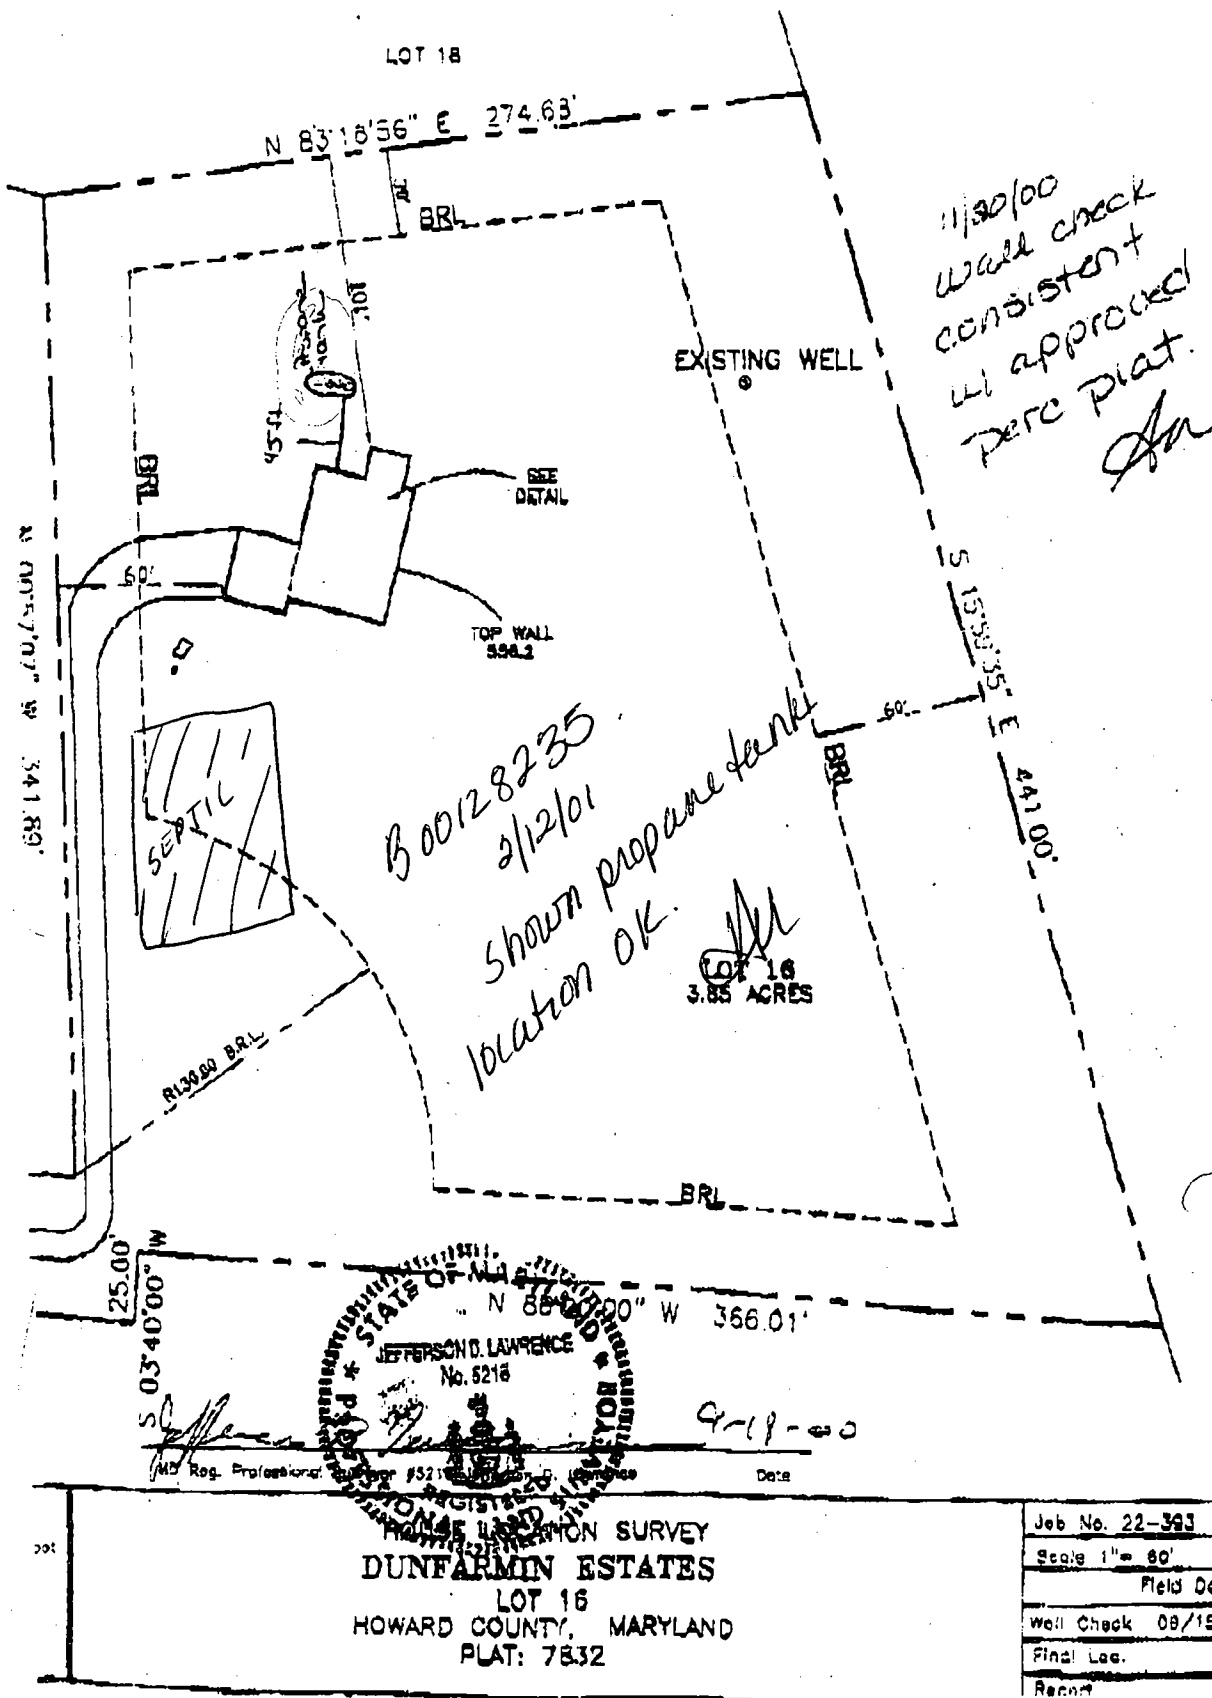

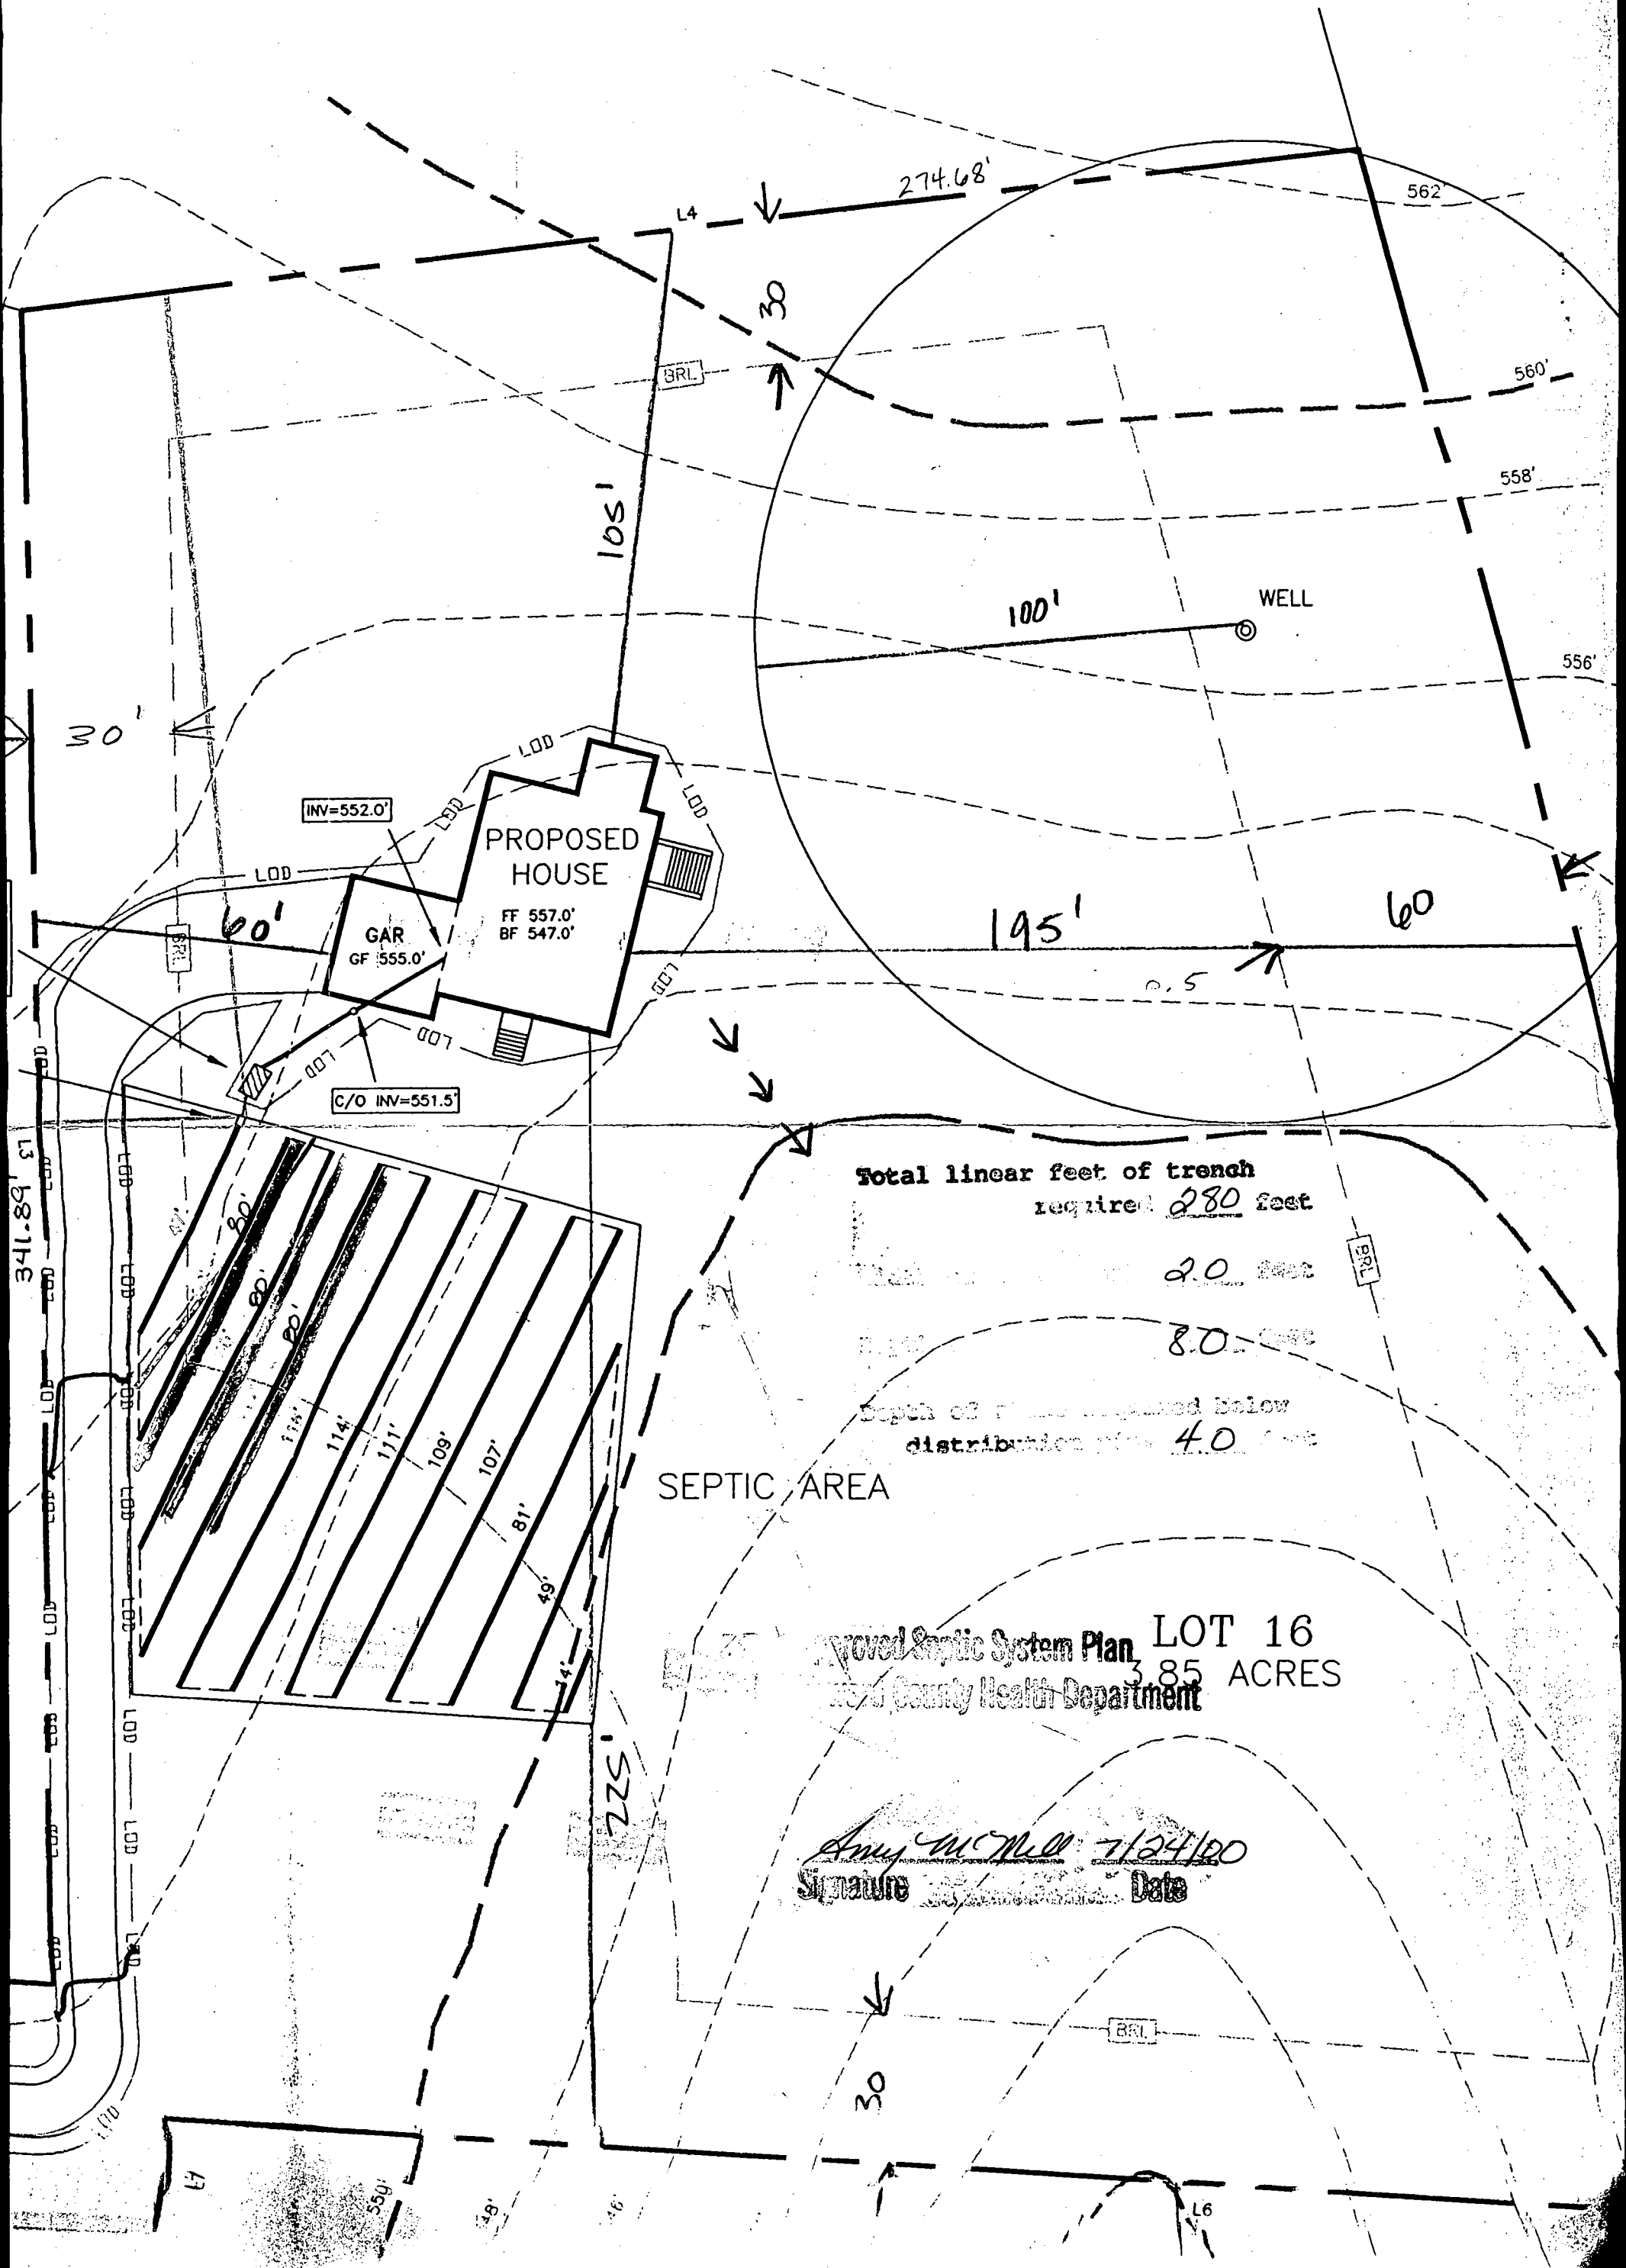

Total linear feet of trench required 280 feet

2.0 feet

8.0 feet

Depth of trench required below distribution pipe 40 feet

SEPTIC AREA

Approved Septic System Plan LOT 16
3.85 ACRES
Rock County Health Department

Amy McMillan 7/24/00
Signature Date