

COUNTY #

SOIL PROFILE

0' Heavy red/orange SiCL

2' Heavy red brown CL

4' Heavy Brown L w/ < 5% Saprolite

11' Tan loam SL


14' (57A) red brown CL
↓
red brown L w/ 10% Saprolite

4 1/2' Fine tan SL w/ 10-15% Saprolite

14' (58) Heavy red brown SiCL
↓
CL

6' Brown tan SL/L w/ < 5% Saprolite

14

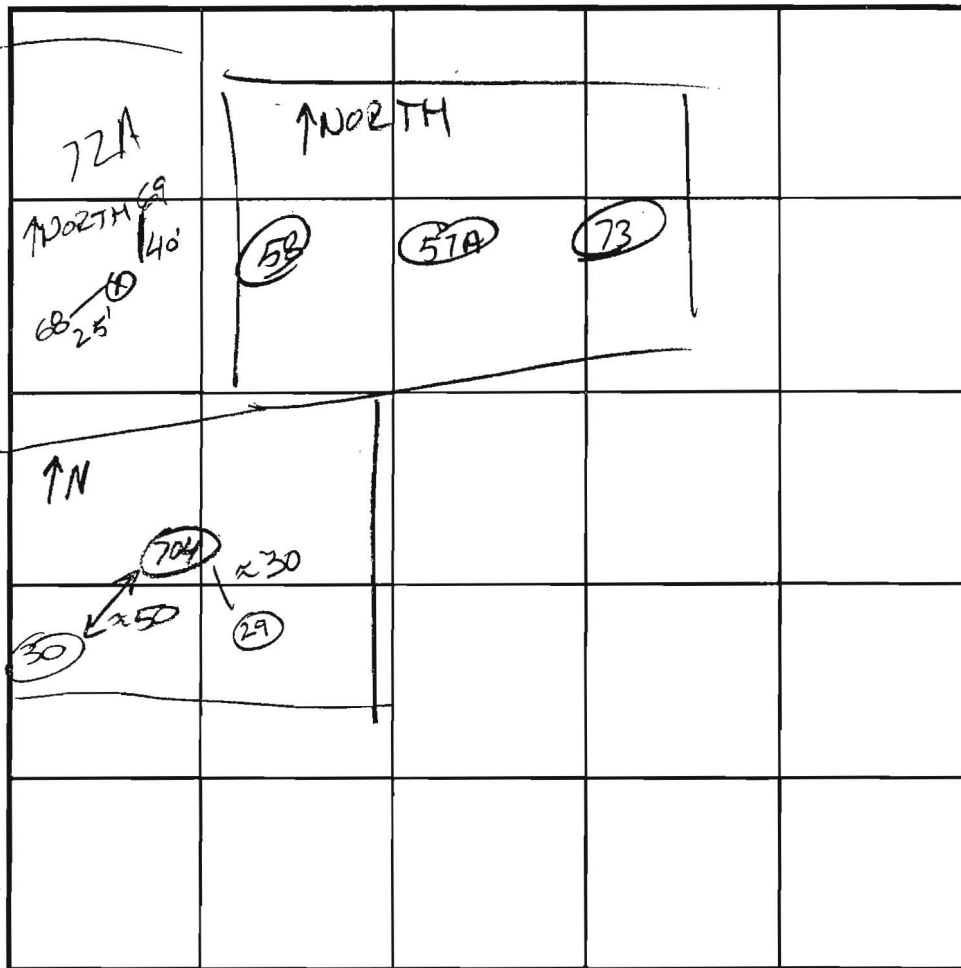

INDICATE NORTH - NAME ADJOINING ROADWAY AS BASE LINE.

SOIL PROFILE

0' 704
Brown CL w/ < 5% gravelly frags

3 1/2' tan/brown SiCL w/ 15-20% gravelly + some red clay

7' Fine tan SL w/ < 5% Mn nodules

13' Slight red clay

Must Holes

DATE	TEST NO.	DEPTH	PRE-WET		TEST - 1" DROP		TIME
			START	STOP	START	STOP	
11/1/02	72A	4 1/2 / 14	9:13:45	9:21:45	9:21:45	9:35:30	14 min
11/1/02	57A	5 / 14	9:15:45	9:19:00	9:19:00	9:23:00	4 min
	58	6 x 12	Only tested needal profile				OK
11/1/02	704	4 / 13	10:00:30	test stopped e		10:16:30	F

REMARKS Holes on this sheet were done as confirmation test + will be matched to a lot later

TYPE OF SOIL _____

TESTED BY J. Boris ALSO PRESENT _____

TRENCH DESIGN DATA: AVERAGE PERCOLATION TIME _____ TRENCH WIDTH _____

INLET DEPTH _____ MAXIMUM BOTTOM DEPTH _____ SQ. FT/BEDROOM _____

COUNTY #

SOIL PROFILE

0' 68
Brown
SCL

2' red/orange
SCL

4' L

5 1/2' red/orange
SL w/
5-10%
Cobbly
frags

14'

71

71

72


Brown L
4 1/2' - 8' clay

2' red/orange
CL

4 1/2' orange red
heavy
SCL w/
Mn nodules

6 1/2' Heavy
red/orange
L

15'

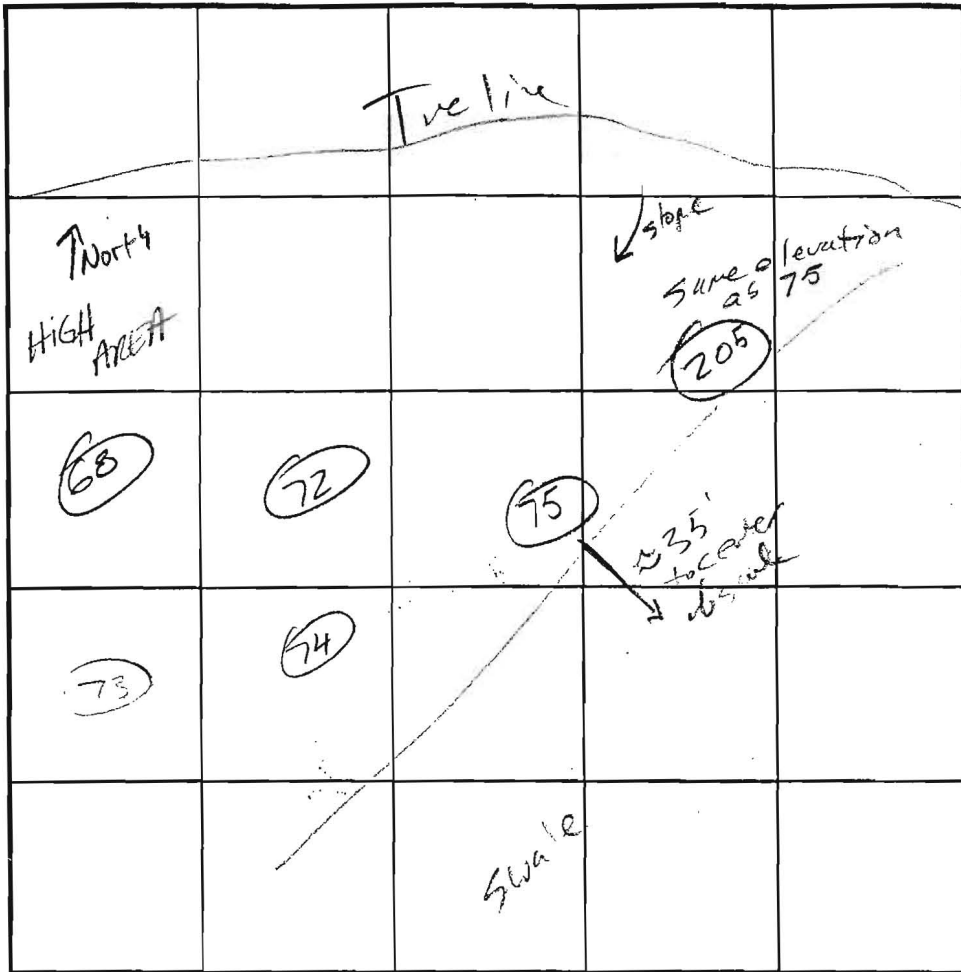

SOIL PROFILE

0' 73
Brown
SCL

W

red/orange
SCL

5' red brown
L

6 1/2'

SL

13'

INDICATE NORTH - NAME ADJOINING ROADWAY AS BASE LINE.

DATE	TEST NO.	DEPTH	PRE-WET		TEST - 1" DROP		TIME	
			START	STOP	START	STOP		
10/8/02	68	4 1/2 14	12:33:30	12:44:00	12:44:00	1:06:00	22	ok
		GV material OK					2-7	ok
ON LOT 155 NOTES	71							
10/8/02	72	8 15	12:28:30	stopped @ 1:15	P. 200' L	Slow	F	
10/8/02	73	6 1/2 13	1:16:00	1:24:15	1:24:15	1:45:30	20 min	ok

REMARKS: Holes dug per plan 74

TYPE OF SOIL _____

TESTED BY: J. Boris ALSO PRESENT: Dave W.

TRENCH DESIGN DATA: AVERAGE PERCOLATION TIME _____ TRENCH WIDTH _____

INLET DEPTH _____ MAXIMUM BOTTOM DEPTH: 10' 2" SQ. FT./BEDROOM _____

CgB2

P.152
VAN W. JOHNSON
& BABETTE B. JOHNSON
L.2563/F.0499
ZONE: RRDEO USE: R
LOT 4

ChB2

P.153
BRUCE R. KENDALL
& VALERIE L. KENDALL
L.04195/F.0616
ZONE: RRDEO USE: R
LOT 5

ChB2

SHARED
C RESERVE
AREA
(1000 S.F.)

GIB2

P.154
CHARLES R. SOMMERLOCK
& REGINA C. SOMMERLOCK
L.02293/F.0500
ZONE: RRDEO USE: R
LOT 6

RYON

EXISTING AIRSTRIP

NO WELLS OR SEPTICS WITHIN 200'

