

Permits: 410-313-2455  
Inspections: 410-313-1810  
Automated Line: 410-313-3800

Howard County Building/Fire Permit Application  
Department of Inspections, Licenses & Permits  
3430 Court House Drive  
Ellicott City, MD 21043

Permit Number:

Building Address: <u>1067 West Wintersville Rd.</u> <u>Wt Airy MD 21771</u>		Property Owner's Name: <u>Christopher M. Winters</u> Address: <u>1067 West Wintersville Rd</u> City: <u>Wt Airy</u> State: <u>MD</u> Zip Code: <u>21771</u> Home Phone: <u>301-589-3953</u> Work Phone: <u>410-313-8506</u>	
Suite/Apt. # _____ SDP/WP/BA #: _____		Applicant's Name & Mailing Address, (if other than stated herein): _____	
Census Tract: _____ Subdivision: _____		Phone: _____ Fax: _____	
Section: _____ Area: _____ Lot: _____		Email: _____	
Tax Map: <u>2</u> Parcel: <u>247</u> Grid: _____		Contractor Company: <u>CB Structures, Inc.</u> Contact Person: <u>Jamie Reifer</u> Address: <u>202 Orion Road</u> City: <u>New Holland</u> State: <u>PA</u> Zip Code: <u>17557</u> License No.: _____ Phone: <u>1800-554-9464</u> Fax: _____ Email: _____	
Zoning: _____ Map Coordinates: _____ Lot Size: <u>2.4134</u>		Engineer/Architect Company: <u>CB Structures Inc.</u> Responsible Design Prof.: _____ Address: <u>202 Orion Road</u> City: <u>New Holland</u> State: <u>PA</u> Zip Code: <u>17557</u> Phone: <u>1800-554-9464</u> Fax: _____ Email: _____	
Existing Use: <u>Single family home</u>			
Proposed Use: <u>Storage barn</u>			
Estimated Construction Cost: <u>\$9800</u>			
Description of Work: <u>20' x 24' Pole Barn</u> <u>with steel roof and board and batten</u> <u>sides - Building 10' tall</u>			
Occupant or Tenant: _____			
Was tenant space previously occupied? <input type="checkbox"/> Yes <input type="checkbox"/> No			
Contact Name: _____			
Address: _____			
City: _____ State: _____ Zip Code: _____			
Phone: _____ Fax: _____			
Email: _____			

BUILDING DESCRIPTION - COMMERCIAL	
Building Characteristics	Utilities
Height: _____	<u>Water Supply</u>
No. of stories: _____	<input type="checkbox"/> Public
Gross area, sq. ft./floor: _____	<input type="checkbox"/> Private
	<u>Sewage Disposal</u>
Area of construction (sq. ft.): _____	<input type="checkbox"/> Public
	<input type="checkbox"/> Private
Use group: _____	Electric: <input type="checkbox"/> Yes <input type="checkbox"/> No
	Gas: <input type="checkbox"/> Yes <input type="checkbox"/> No
<u>Construction type:</u>	<u>Heating System</u>
<input type="checkbox"/> Reinforced Concrete	<input type="checkbox"/> Electric <input type="checkbox"/> Oil
<input type="checkbox"/> Structural Steel	<input type="checkbox"/> Natural Gas <input type="checkbox"/> Propane Gas
<input type="checkbox"/> Masonry	<u>Sprinkler System:</u>
<input type="checkbox"/> Wood Frame	<input type="checkbox"/> N/A
<input type="checkbox"/> State Certified Modular	<input type="checkbox"/> Full
<input checked="" type="checkbox"/> Roadside Tree Project Permit	<input type="checkbox"/> Partial
<input type="checkbox"/> Yes <input type="checkbox"/> No	<input type="checkbox"/> Other Suppression
Roadside Tree Project Permit # _____	No. of Heads: _____

BUILDING DESCRIPTION - RESIDENTIAL	
Building Characteristics	Utilities
<input checked="" type="checkbox"/> SF Dwelling <input type="checkbox"/> SF Townhouse	<u>Water Supply</u>
Depth: _____ Width: _____	<input type="checkbox"/> Public
1 <sup>st</sup> floor: <u>34.25' x 48.6'</u>	<input type="checkbox"/> Private
2 <sup>nd</sup> floor: <u>34.25' x 48.6'</u>	<u>Sewage Disposal</u>
Basement: _____	<input type="checkbox"/> Public
<input type="checkbox"/> Finished Basement	<input type="checkbox"/> Private
<input type="checkbox"/> Unfinished Basement	Electric: <input checked="" type="checkbox"/> Yes <input type="checkbox"/> No
<input type="checkbox"/> Crawl Space	Gas: <input checked="" type="checkbox"/> Yes <input type="checkbox"/> No
<input type="checkbox"/> Slab on Grade	<u>Heating System</u>
No. of Bedrooms: <u>4</u>	<input type="checkbox"/> Electric
<u>Multi-family Dwelling</u>	<input type="checkbox"/> Oil
No. of efficiency units: _____	<input type="checkbox"/> Natural Gas
No. of 1 BR units: _____	<input checked="" type="checkbox"/> Propane Gas - <u>Propane</u>
No. of 2 BR units: _____	
No. of 3 BR units: _____	
Other Structure: _____	
Dimensions: _____	
Footings: _____	<input checked="" type="checkbox"/> Roadside Tree Project Permit
Roof: _____	<input type="checkbox"/> Yes <input type="checkbox"/> No
<input type="checkbox"/> State Certified Modular	Roadside Tree Project Permit # _____
<input type="checkbox"/> Manufactured Home	

THE UNDERSIGNED HEREBY CERTIFIES AND AGREES AS FOLLOWS: (1) THAT HE/SHE IS AUTHORIZED TO MAKE THIS APPLICATION; (2) THAT THE INFORMATION IS CORRECT; (3) THAT HE/SHE WILL COMPLY WITH ALL REGULATIONS OF HOWARD COUNTY WHICH ARE APPLICABLE THERETO; (4) THAT HE/SHE WILL PERFORM NO WORK ON THE ABOVE REFERENCED PROPERTY NOT SPECIFICALLY DESCRIBED IN THIS APPLICATION; (5) THAT HE/SHE GRANTS COUNTY OFFICIALS THE RIGHT TO ENTER ONTO THIS PROPERTY FOR THE PURPOSE OF INSPECTING THE WORK PERMITTED AND POSTING NOTICES.

Applicant's Signature: Christopher M. Winters  
Email Address: christopher.winters@hccss.org  
Title/Company: \_\_\_\_\_

Print Name: Christopher M. Winters  
Date: 10/27/11

Checks Payable to: DIRECTOR OF FINANCE OF HOWARD COUNTY

\*\*PLEASE WRITE NEATLY & LEGIBLY\*\*

-FOR OFFICE USE ONLY-

AGENCY	DATE	SIGNATURE OF APPROVAL
State Highways		
Building Officials		
PSZA (Zoning)		
PSZA (Engineering)		
Health	10-27-11	Michael Satt
Fire Protection		



Is Sediment Control approval required for issuance? ☐ Yes ☐ No  
☐ CONTINGENCY CONSTRUCTION START  
☐ ONE STOP SHOP

DPZ SETBACK INFORMATION	
Front:	
Rear:	
Side:	
Side St.:	
All minimum setbacks met?	<input type="checkbox"/> Yes <input type="checkbox"/> No
Is Entrance Permit Required?	<input type="checkbox"/> Yes <input type="checkbox"/> No
Historic District?	<input type="checkbox"/> Yes <input type="checkbox"/> No
Lot Coverage for New Town Zone:	
SDP/Red-line approval date:	

Filing Fee	\$
Permit Fee	\$
Tech Fee	\$
Excise Tax	\$
PSFS	\$
Guaranty Fund	\$
Add'l per Fee	\$
Total Fees	\$
Sub-Total Paid	\$
Balance Due	\$

Distribution of Copies: White: Building Officials Green: PSZA, Zoning Yellow: PSZA, Engineering Pink: Health Gold: SHA  
T:\Operations\Updated Forms\New building app 11.10.2010.docx

- COMPANY OR ITS AGENT IN CONNECTION WITH CONTEMPLATED TRANSFER, FINANCING OR REFINANCING.
- THIS PLAT IS NOT TO BE RELIED UPON FOR THE ESTABLISHMENT OR LOCATION OF FENCES, GARAGES, BUILDINGS OR OTHER EXISTING OR FUTURE IMPROVEMENTS.
  - THIS PLAT DOES NOT PROVIDE FOR ACCURATE IDENTIFICATION OF PROPERTY BOUNDARY LINES, BUT SUCH IDENTIFICATION MAY NOT BE REQUIRED FOR THE TRANSFER OF TITLE OR SECURING FINANCING OR REFINANCING.
  - THIS PROPERTY IS NOT LOCATED WITHIN A FLOOD HAZARD AREA ACCORDING TO THE NATIONAL FLOOD INSURANCE PROGRAM FLOOD INSURANCE RATE MAP, COMMUNITY PANEL NUMBER 240044 0002B.
  - THE EXISTING WELL(S) SHOWN ON THIS PLAN HO-95-1062 HAS BEEN FIELD LOCATED BY VANMAR ASSOCIATES, INC., PROFESSIONAL LAND SURVEYORS AND ACCURATELY SHOWN.

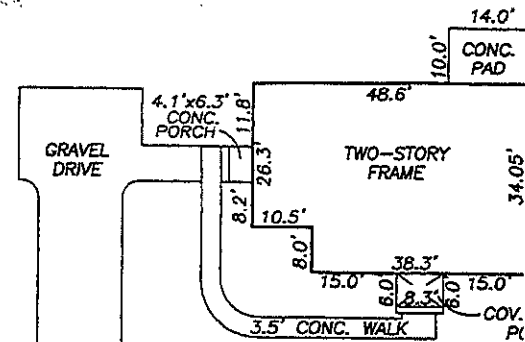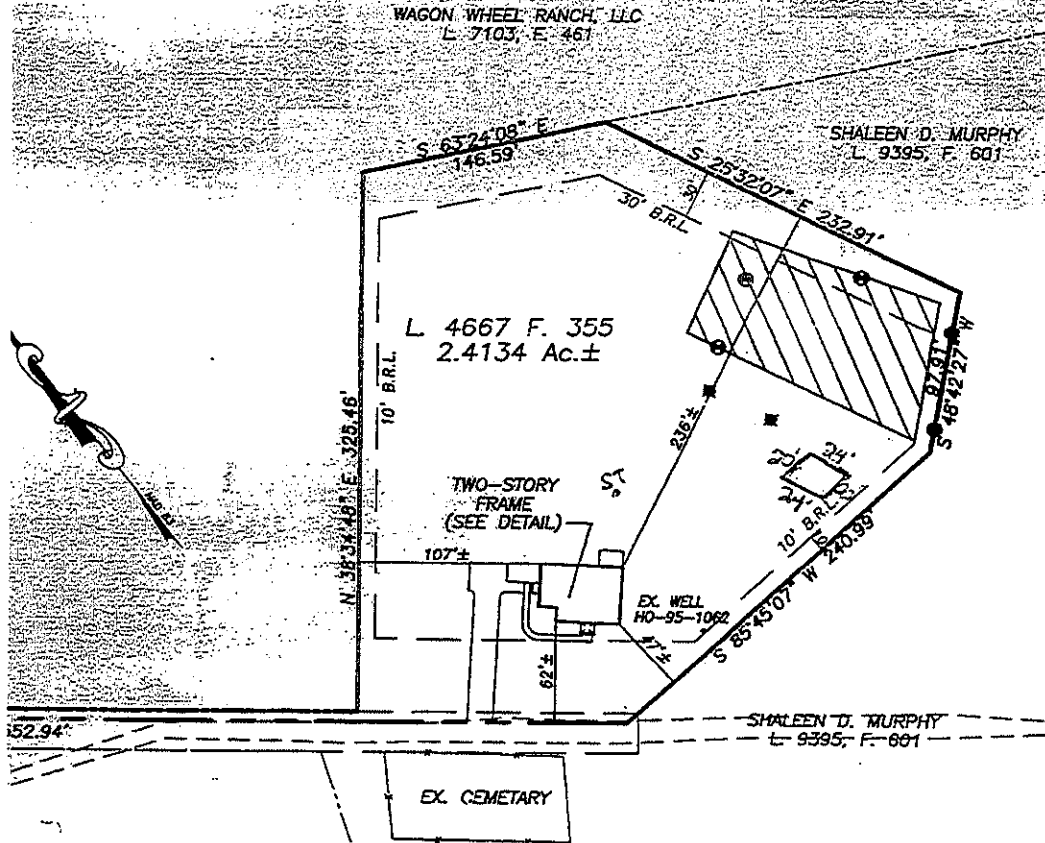

HOUSE DETAIL  
1"=30'

APPROVED

WALK-THRU BUILDING PERMIT

BP# \_\_\_\_\_ A# 58096

APP. SAN 148 DATE: 10-27-11

DESC. OF WORK 20' x 24' pole barn

DATE	REVISIONS

## HOUSE LOCATION DRAWING SHARP PROPERTY

LIBER 4667 FOLIO 355

#667 WEST WATERSVILLE ROAD  
ELECTION DISTRICT No. 4  
HOWARD COUNTY, MARYLAND  
SCALE: 1" = 100' OCTOBER, 2007

VANMAR ASSOCIATES, INC.

IT IS THE RESULT  
ON DATA FOUND AMONG  
UNTY, MARYLAND, AS

*Wm* 10/11/07