

PERMIT

SEWAGE DISPOSAL SYSTEM

MARYLAND STATE DEPARTMENT OF HEALTH

HOWARD COUNTY

ELLICOTT CITY

DISTRICT 3rd

DATE 10/4/77

INDEXED

03-304272

Bollinger Brothers

IS PERMITTED TO INSTALL ☒ ALTER ☐

ADDRESS Bollinger Road, Westminster, Maryland

PHONE

A SEWAGE DISPOSAL-SYSTEM LOCATED AT

SUBDIVISION Annandale

ROAD 1711 Underwood Road

LOT 4

PROPERTY OWNER Fred J. Pipes L. Jerry Lewis

ADDRESS 13555 Old Frederick Road, Sykesville, Md. 21784

SPECIFICATIONS

DRAIN FIELD DEPTH FEET, BOTTOM AREA SQ. FT.

SEEPAGE PITS ABSORBENT SIDE-WALL AREA SQ. FT.

SEPTIC TANK CAPACITY GALLONS

FOR GARBAGE GRINDER, INCREASE DISPOSAL AREA 22% & TANK CAPACITY 50%.

OTHER DRY WELL AND TRENCH --Dry well to have 350 sq. ft. absorbent sidewall area. Inlet at 4 ft. below original grade and maximum depth 11 ft. below original grade. Locate dry well 10 ft. from right property line and 125 ft. from front of lot (near Underwood Road). If 3 bedroom trench to be 30 ft. long for a total sidewall area of 210 sq. ft. If 4 bedroom trench to be 55 ft. long for a total sidewall area of 385 sq. ft. Trench to run from dry well towards lot 3 with contour, parallel to Underwood Road.

NOTE: CALL FOR INSPECTION OF TRENCH BEFORE PLACING STONE IN TRENCH. NOTE: ALL PIPE FROM HOUSE TO DISPOSAL AREA MUST BE CAST IRON. PERMIT VOID AFTER THREE YEARS.

NOTE: INSTALL STAND PIPE ON SEPTIC TANK AND DRY WELL. STAND PIPES MUST BE 6 INCHES IN DIAMETER. CAST IRON, CONCRETE OR TERRA COTTA ACCEPTED.

PLANS APPROVED BY David J. O'Neill DATE 9/10/76

FILL SEPTIC TANK AND DISTRIBUTION BOX WITH WATER BEFORE CALLING FOR AN INSPECTION. COVER NO WORK UNTIL INSPECTED AND APPROVED.

NEITHER THE HOWARD COUNTY COMMISSIONERS NOR THE HEALTH DEPARTMENT IS RESPONSIBLE FOR THE SUCCESSFUL OPERATION OF ANY SYSTEM.


Bollinger reports possible rock - if rock 8' deep or less
Run towards Underwood Rd if rock 8' or deeper.
Cover with 2' soil - run trench longer for 1 side area

BLDG. PERMIT SIGNED

AND RETURNED 6/25/85

Serial H65507

24592

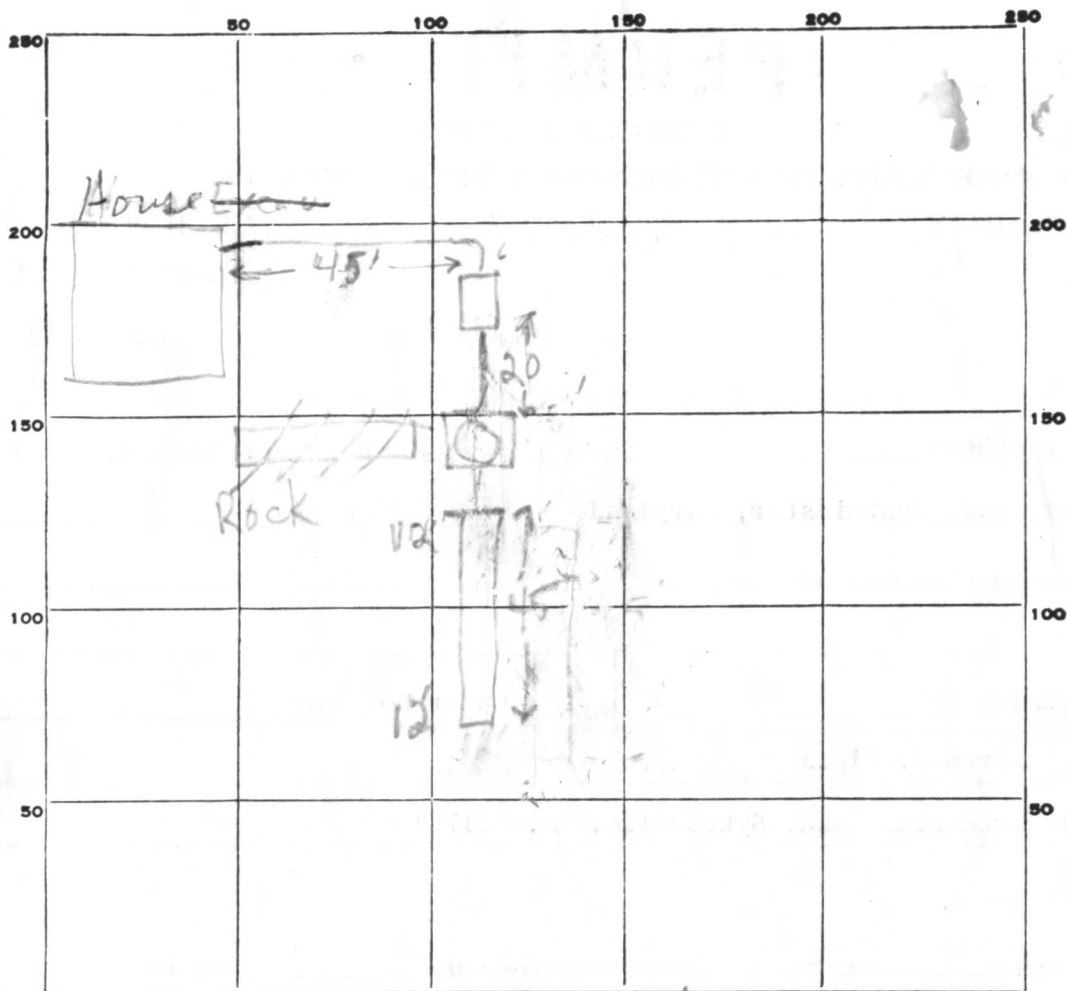

INDICATE NORTH. - NAME ADJOINING ROADWAY AS BASE LINE.

Underwood Road,

PERMIT CARD ☒

SEPTIC TANK, LEVEL ☒

CLEANOUTS ☒ ST/DW

DISTRIBUTION BOX, LEVEL ☐

TILE FIELD, DEPTH 12 FT. TRENCH WIDTH 3 FT.

GRAVEL DEPTH IN. TOTAL LENGTH 45 FT.

NUMBER OF TRENCHES 1 TOTAL BOTTOM AREA

SEEPAGE PITS, INSIDE DIAMETER FT. DEPTH BELOW INLET FT.

ABSORBENT AREA SQ. FT.

REMARKS a. to add stone to trench. OK to cover up to

Originally 10/14/77 T.S.O.

4/11/78 Final connection made to house

DATE SYSTEM APPROVED 4/11/78 INSPECTOR T.S.O.glb

RECEIVED

SEP 6 9 12 AM '77

HOWARD COUNTY
HEALTH DEPT.
ELLCOTT CITY, MD.

STATE OF MARYLAND
DEPARTMENT OF HEALTH
DIVISION OF PUBLIC HEALTH
ELLCOTT CITY, MARYLAND

preliminary
4-13' holes
on 10,000. #

APPLICATION

A 24592

SEWAGE DISPOSAL TESTING

P. _____

STATE OF MARYLAND - DEPARTMENT OF HEALTH AND MENTAL HYGIENE

HOWARD COUNTY HEALTH DEPARTMENT
ENVIRONMENTAL HEALTH SERVICES
P. O. BOX 476, ELLICOTT CITY, MARYLAND 21043
TELEPHONE: 465-5000, EXT. 356

DISTRICT 3rd

DATE 9/24/76

TO: THE COUNTY HEALTH OFFICER
ELLICOTT CITY, MARYLAND

I, HEREBY, APPLY FOR THE NECESSARY TEST IN ORDER TO CONSTRUCT (OR RECONSTRUCT) A SEWAGE DISPOSAL SYSTEM.

PROPERTY OWNER Fred James Pipes

ADDRESS 13555 Old Frederick Road, Sykesville, Md. PHONE 21784

PROPERTY LOCATION:

SUBDIVISION Annandale LOT NO. 27

ROAD AND DESCRIPTION Underwood Road

SIZE OF LOT 42,350 sq. ft. TYPE BLDG. 3 or 4

IF NOT SINGLE RESIDENCE DESCRIBE _____
NUMBER OF BEDROOMS
single family dwelling

THE SYSTEM INSTALLED UNDER THIS APPLICATION IS ACCEPTABLE ONLY UNTIL PUBLIC FACILITIES BECOME AVAILABLE.

SIGNATURE OF APPLICANT /s/ Fred James Pipes

APPROVED BY [Signature] FOR DW + Tug DATE 8/16/76
(KIND OF SYSTEM)


REJECTED BY _____ FOR _____ DATE _____
(KIND OF SYSTEM)

HOLD PENDING FURTHER TESTS _____ DATE _____

REASONS FOR REJECTION OR HOLDING _____

THIS IS NOT A PERMIT

27

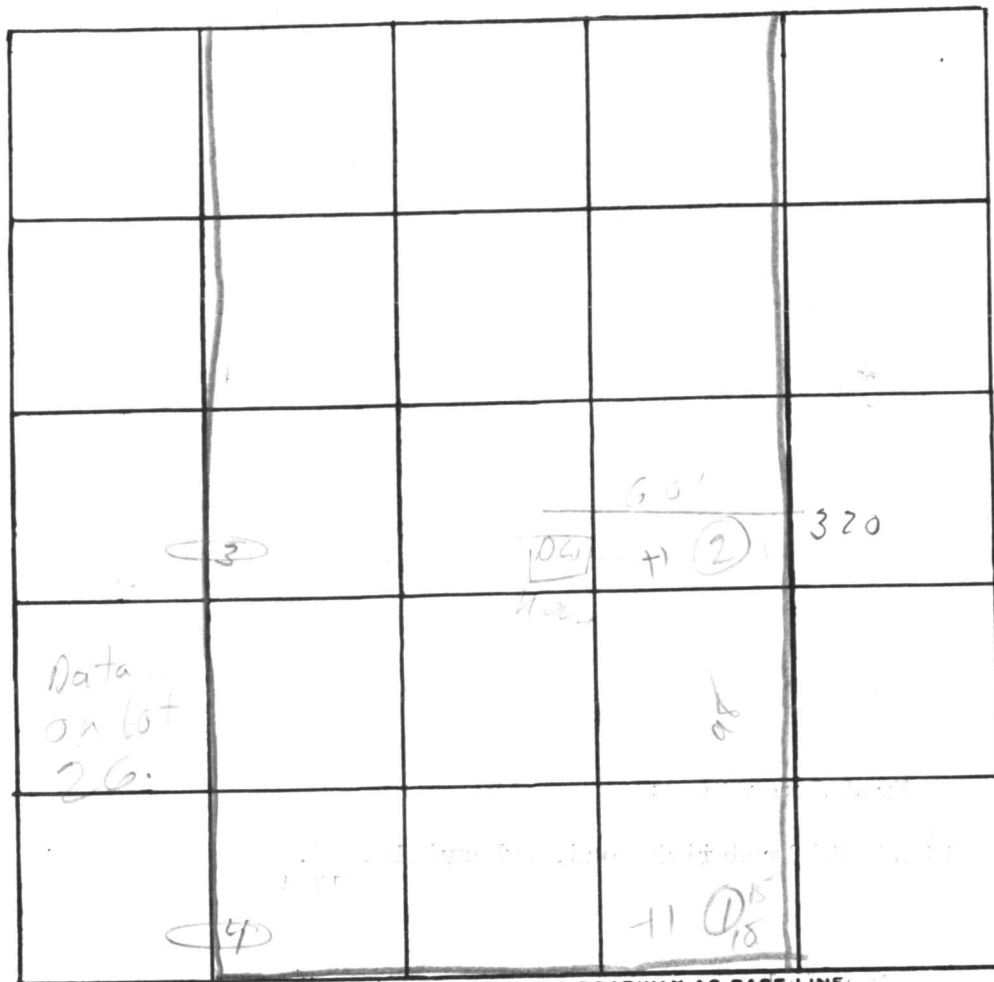

INDICATE NORTH. - NAME ADJOINING ROADWAY AS BASE LINE:

Underwood 125 Road

DATE	TEST NO.	DEPTH	PRE-WET		TEST - 1" DROP		TIME
			START	STOP	START	STOP	
7/10	15	4'	10 ¹⁵	10 ²⁵	10 ²⁵	40	15
		13'	10 ¹⁹	10 ²⁵	10 ¹⁵	10 ³⁴	12
	25	4'	10 ²⁴	10 ³⁴	10 ³⁴	10 ⁴⁹	15
		13'	10 ³⁸	10 ⁵⁰	10 ⁵⁰	11 ¹⁰	20
	3	6'-12'					1 hr 20 min
	4	2 1/2'-13'					13 min 11 hours

REMARKS _____

TYPE OF SOIL _____

TESTED BY _____ ALSO PRESENT: _____

411° 28' 21" E
81.38'

ONE

584°13'02"E

F.F. EL. 591.00
BASMT. EL.
582.17

LINE.UM

3'x55'x7'
TRENCH

INV. 584.60

DRIVEWAY

EL. @ PERC
588.50

- - 1254

15x7'
DRY WELL

N84°13'02" W

N07°11'00"E
59.04'

SECTION 4.11

HOUSE:
4 BEDROOM
2STY

OK DJ 07
8/22/11


PLOT PLAN

LOT 4
SECTION ONE
ANNANDALE

Change to
Elevation
Septic

Aug 22, 77

SCALE: 1"=50'

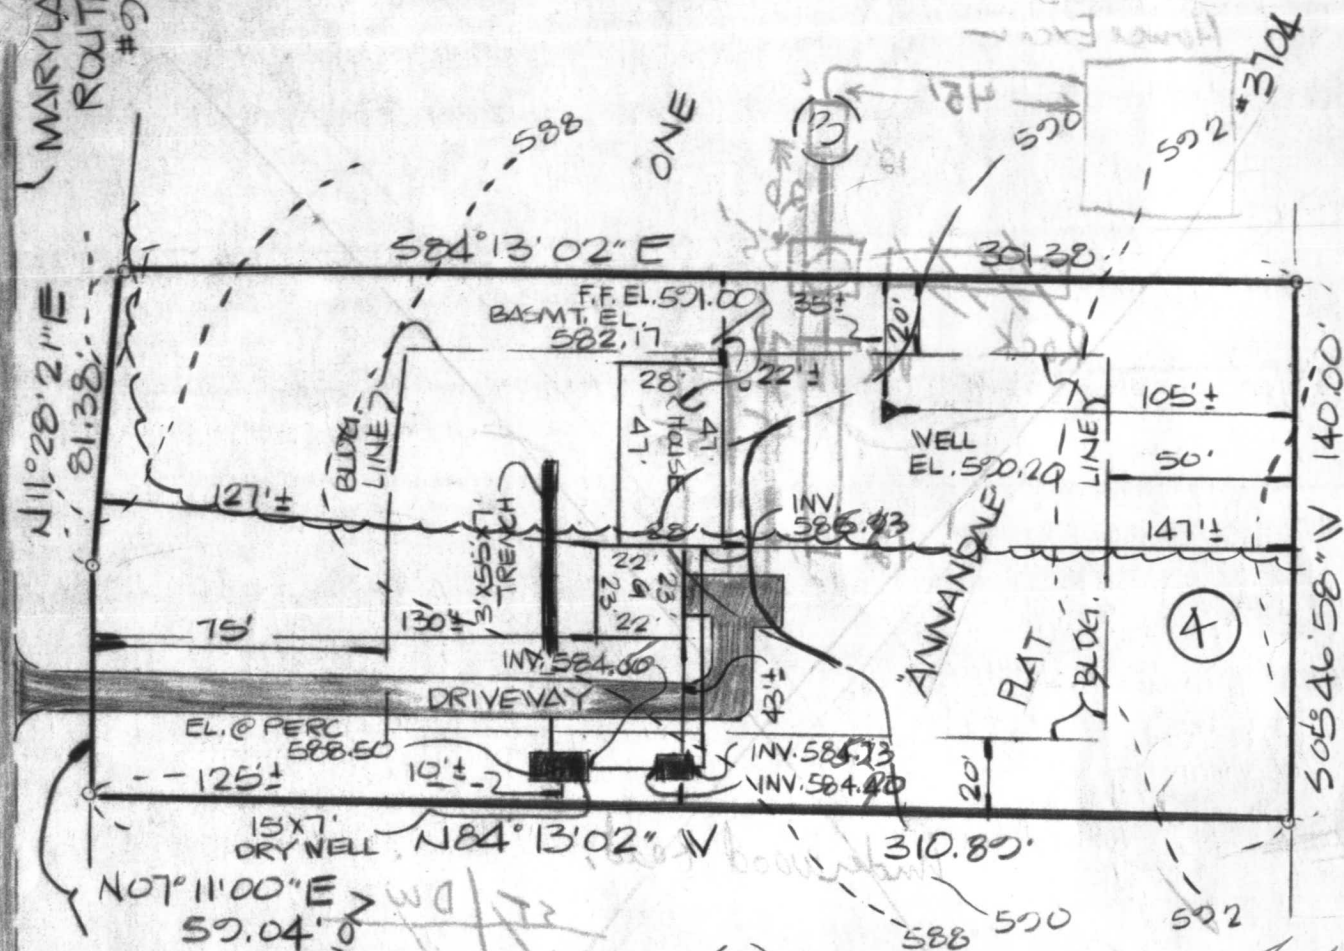

Property known as: LOT 4
SECTION ONE ANNANDALE
PLAT # 5104 3RD ELECTION DIST. HOWARD CO. MD
#1711 UNDERWOOD ROAD

THIS PLAT CAN NOT BE USED TO ESTABLISH PROPERTY
LINES OR CORNERS.

6-25-85
PROPOSED ADDITION DOES
NOT IMPACT ON SEPTIC
SYSTEM OR RESTRICTION AREA, OR
WELL SITE AND LINE.
NO EVIDENCE OF FAILURE.
JAL

