

7-M.
if possible
1/17/80

Approved 1/17/80
J. Stayer

PERMIT

SEWAGE DISPOSAL SYSTEM

MARYLAND STATE DEPARTMENT OF HEALTH

HOWARD COUNTY

ELLICOTT CITY

DISTRICT _____

DATE 1/16/80

INDEXED

TAXED # 01-171836

Cecil Crenshaw

IS PERMITTED TO INSTALL ALTER X

ADDRESS _____

PHONE _____

SUBDIVISION _____

ROAD

4935 Wharf Lane

LOT _____

PROPERTY OWNER Mrs. Madaline Lawson

LENORE HUFFMAN - 410-788-9090

ADDRESS 4935 Wharf Lane

SPECIFICATIONS 3 bedrooms

SEPTIC TANK CAPACITY 1000 GALLONS

DRAIN FIELD _____ DEPTH _____ FEET, BOTTOM AREA _____ SQ. FT.

DEEP TRENCH _____ DEPTH _____ FEET, BOTTOM AREA _____ SQ. FT.

SEEPAGE PITS _____ ABSORBENT SIDE-WALL AREA _____ SQ. FT.

INLET PIPE _____ FT. BELOW ORIGINAL GRADE. MAXIMUM DEPTH _____ FT. BELOW ORIGINAL GRADE

EFFECTIVE DEPTH AT _____ FT. BELOW ORIGINAL GRADE.

LOCATE DISPOSAL AREA _____ FT. FROM _____ LOT LINE AND _____ FT. FROM _____ LOT LINE AS SEEN WHEN
FACING LOT FROM

REPAIR-REPLACEMENT OF SEPTIC TANK ONLY.

BUILDING PERMIT SIGNED

AND RETURNED

9-9-84-000150284-DECK W/STEB
10-4-84 000150779-BARN

BLDG. PERMIT SIGNED
AND RETURNED 3/3/92
Serial # B00109188
Shed

PLANS APPROVED BY Palmer Wine

DATE 1/16/80

COVER NO WORK UNTIL INSPECTED AND APPROVED.

NEITHER THE HOWARD COUNTY COUNCIL NOR THE HEALTH DEPARTMENT IS RESPONSIBLE FOR THE SUCCESSFUL OPERATION OF ANY SYSTEM.

NOTE: IF TRENCH IS USED CALL FOR INSPECTION BEFORE PLACING GRAVEL IN TRENCH.

NOTE: NO DRY WELL SHALL EXCEED 15 FOOT IN DIAMETER.

NOTE: ALL PIPE FROM HOUSE TO DISPOSAL AREA MUST BE CAST IRON.

PERMIT VOID AFTER THREE YEARS.

NOTE: INSTALL STAND PIPE ON SEPTIC TANK AND DRY WELL. STAND PIPES MUST BE 6 INCHES IN DIAMETER. CAST IRON, CONCRETE OR TERRA
COTTA ACCEPTED.

BLDG. PERMIT SIGNED
AND RETURNED 4/3/87
Serial # 10627-Shed


***INSTALLER IS RESPONSIBLE FOR OBTAINING FINAL APPROVAL ON THIS PERMIT.**

HD - 23

BLDG. PERMIT SIGNED
AND RETURNED 4/7/94
Serial # 53354-
enclosed summary

BLDG. PERMIT SIGNED
AND RETURNED 12/29/94
Serial # 9416

P 30484

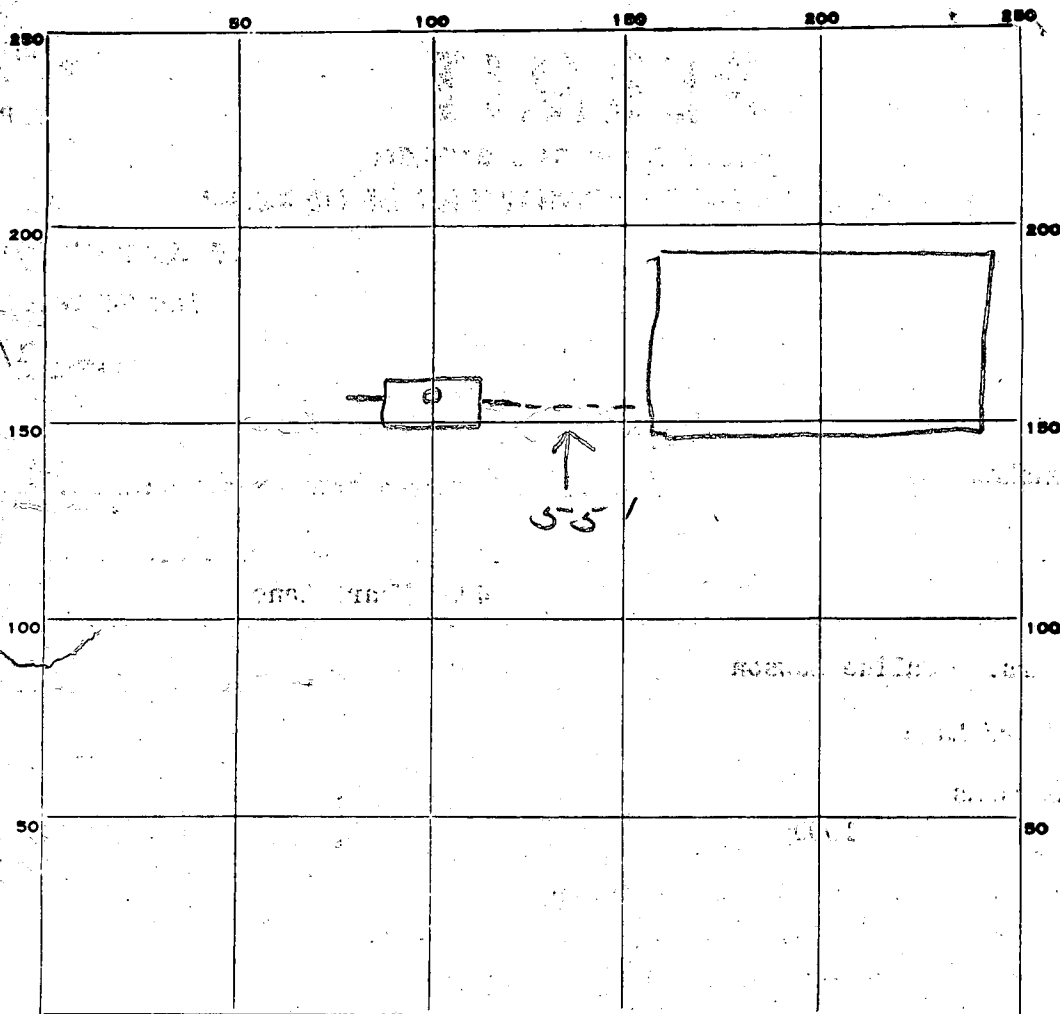

INDICATE NORTH - NAME ADJOINING ROADWAY AS BASE LINE.

PERMIT CARD ☒ Wharf Lane

SEPTIC TANK, LEVEL ☒

CLEANOUTS ST

DISTRIBUTION BOX, LEVEL ☒

TILE FIELD, DEPTH _____ FT. TRENCH WIDTH _____ FT.

GRAVEL DEPTH _____ IN. TOTAL LENGTH _____ FT.

NUMBER OF TRENCHES _____ TOTAL BOTTOM AREA _____

SEEPAGE PITS, INSIDE DIAMETER _____ FT. DEPTH BELOW INLET _____ FT.

ABSORBENT AREA _____ SQ. FT.

REMARKS 1/17/80 - OK to cover work of

DATE SYSTEM APPROVED


1/17/80

INSPECTOR

[Signature]

56/600

446/118

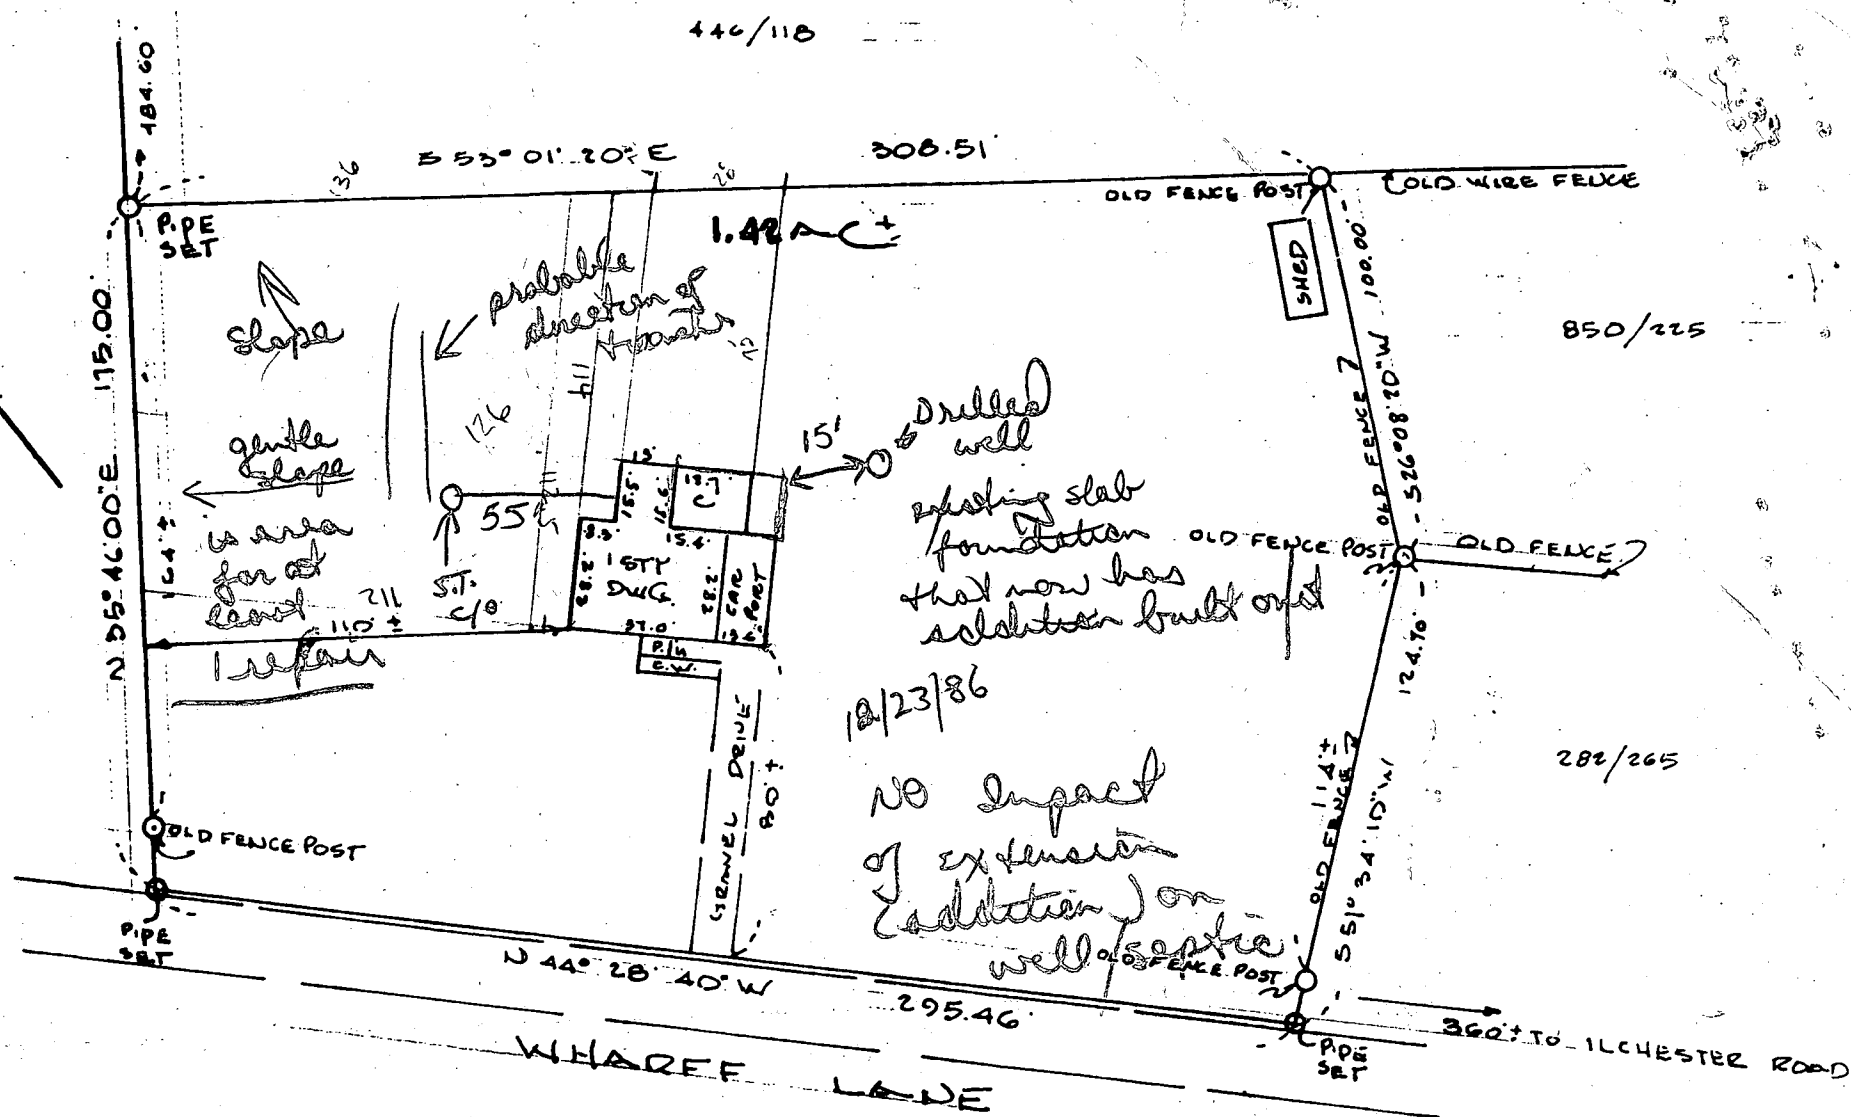

Handwritten signature: Axel F. Loen

AXEL F. LOEN PROF. L.S. # 9724
10312 CURRYCOMP COURT
COLUMBIA, MD 21044

Red shows addition

PROPERTY SURVEY
4935 WHARFF LANE
1ST ELECTION DISTRICT HOWARD CO. MD
SCALE 1" = 50' AUG. 25, 1981



HOWARD COUNTY HEALTH DEPARTMENT

Joyce M. Boyd, M.D., County Health Officer

D R A F T

Reply to:

DATE April 8, 1994

letter
NOT SENT
T/C w/
OWNER
4/11/94

MEMORANDUM

TO: Lenore Huffman
4935 Wharff Lane
Ellicott City, MD 21043

FROM: Amy McMillen
Water and Sewerage Program
Bureau of Environmental Health

RE: Building Permit Application Number: 53354
Proposed Use: enclosed sunroom
Address: 4935 Wharff Lane
Ellicott City, MD 21043


This is to confirm that the above referenced building permit application was recommended for approval subject to the following conditions and/or cautions:

- the integrity of the pipe running from house to tank shall be maintained during excavation and construction of the proposed addition.

These conditions were discussed with you Lenore Huffman
on April 1994.

This office's recommendation for approval of the building permit application was based upon your acceptance of these conditions.

446/118

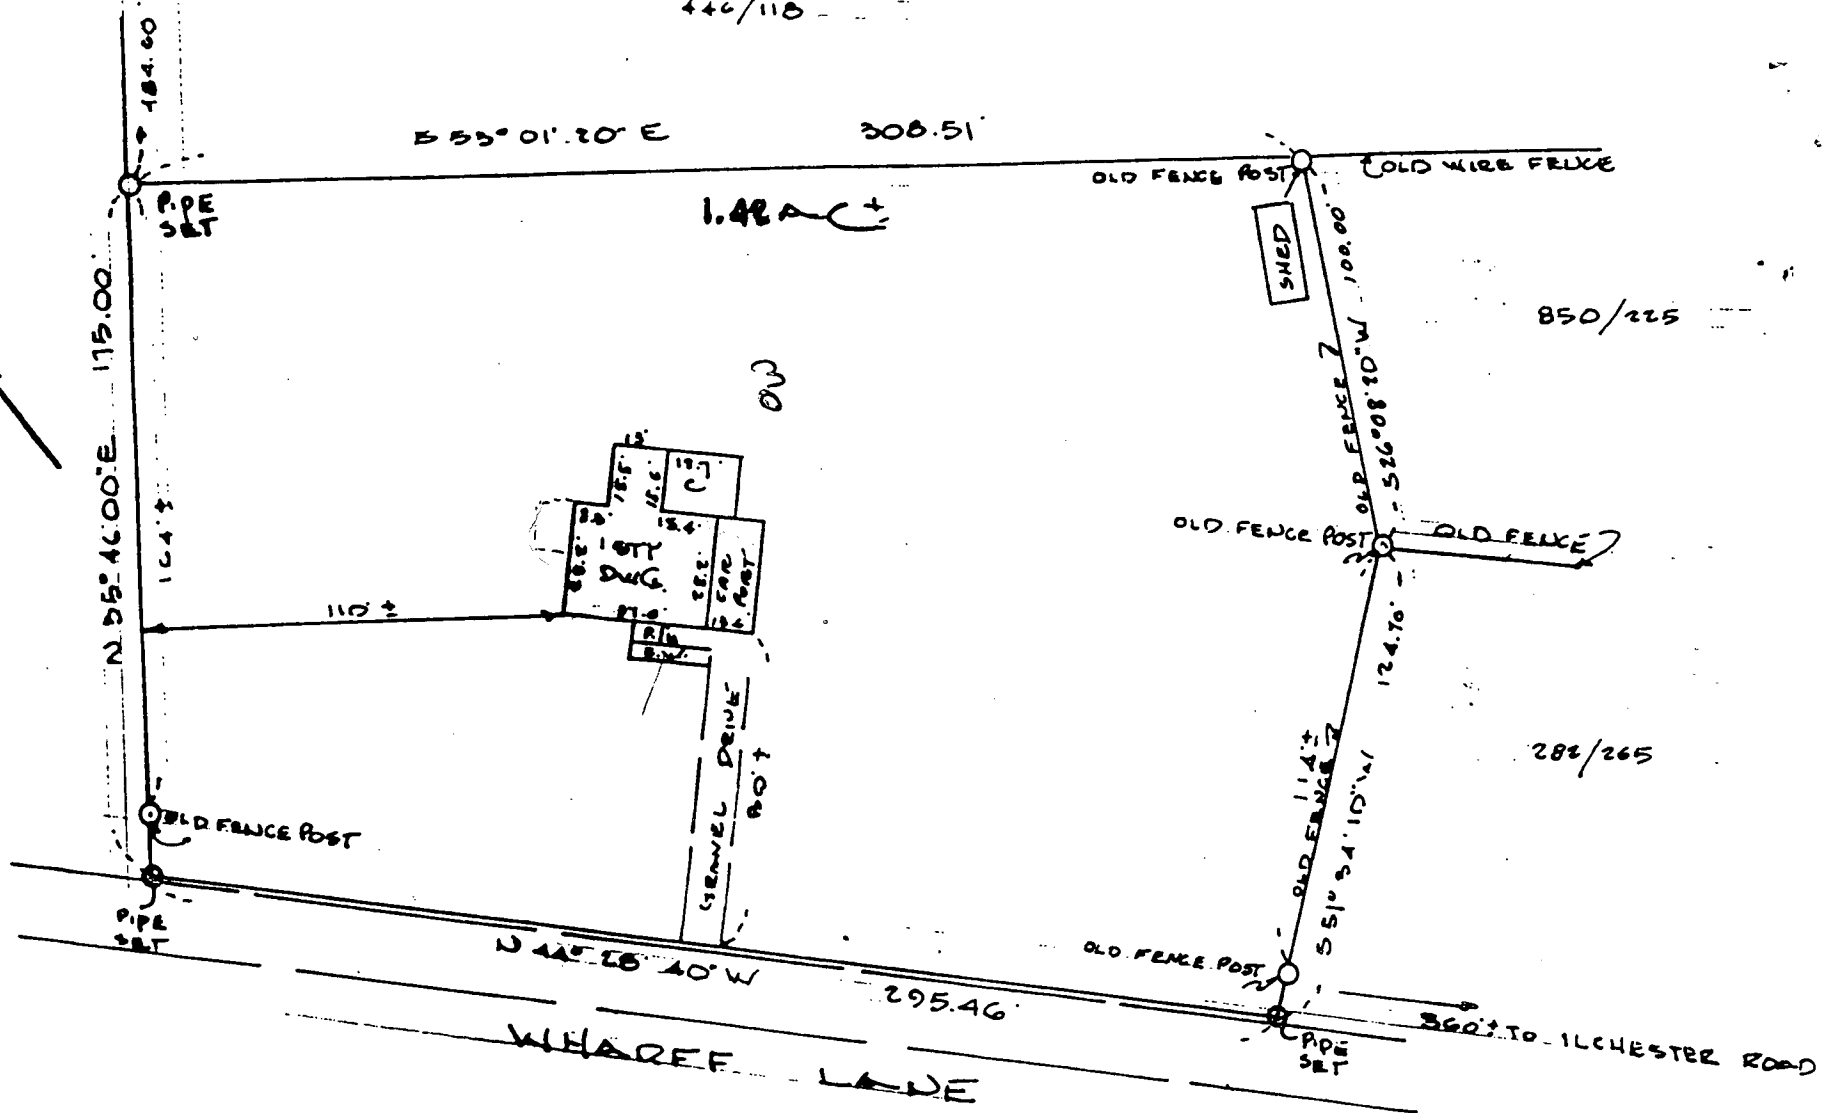

850/225

282/265


AKEL F. LOEN
 AKEL F. LOEN PROF. L.S. # 9724
 10312 CURRYCOMB COURT
 COLUMBIA, MD 21044

3/3/97
 Proposed addition
 2000 ABEAM
 (D/S)

PROPERTY SURVEY
 # 4935 WHARFF LANE
 1ST ELECTION DISTRICT HOWARD CO. MD
 SCALE 1" = 50' AUG. 25, 1981

856/600

446/118

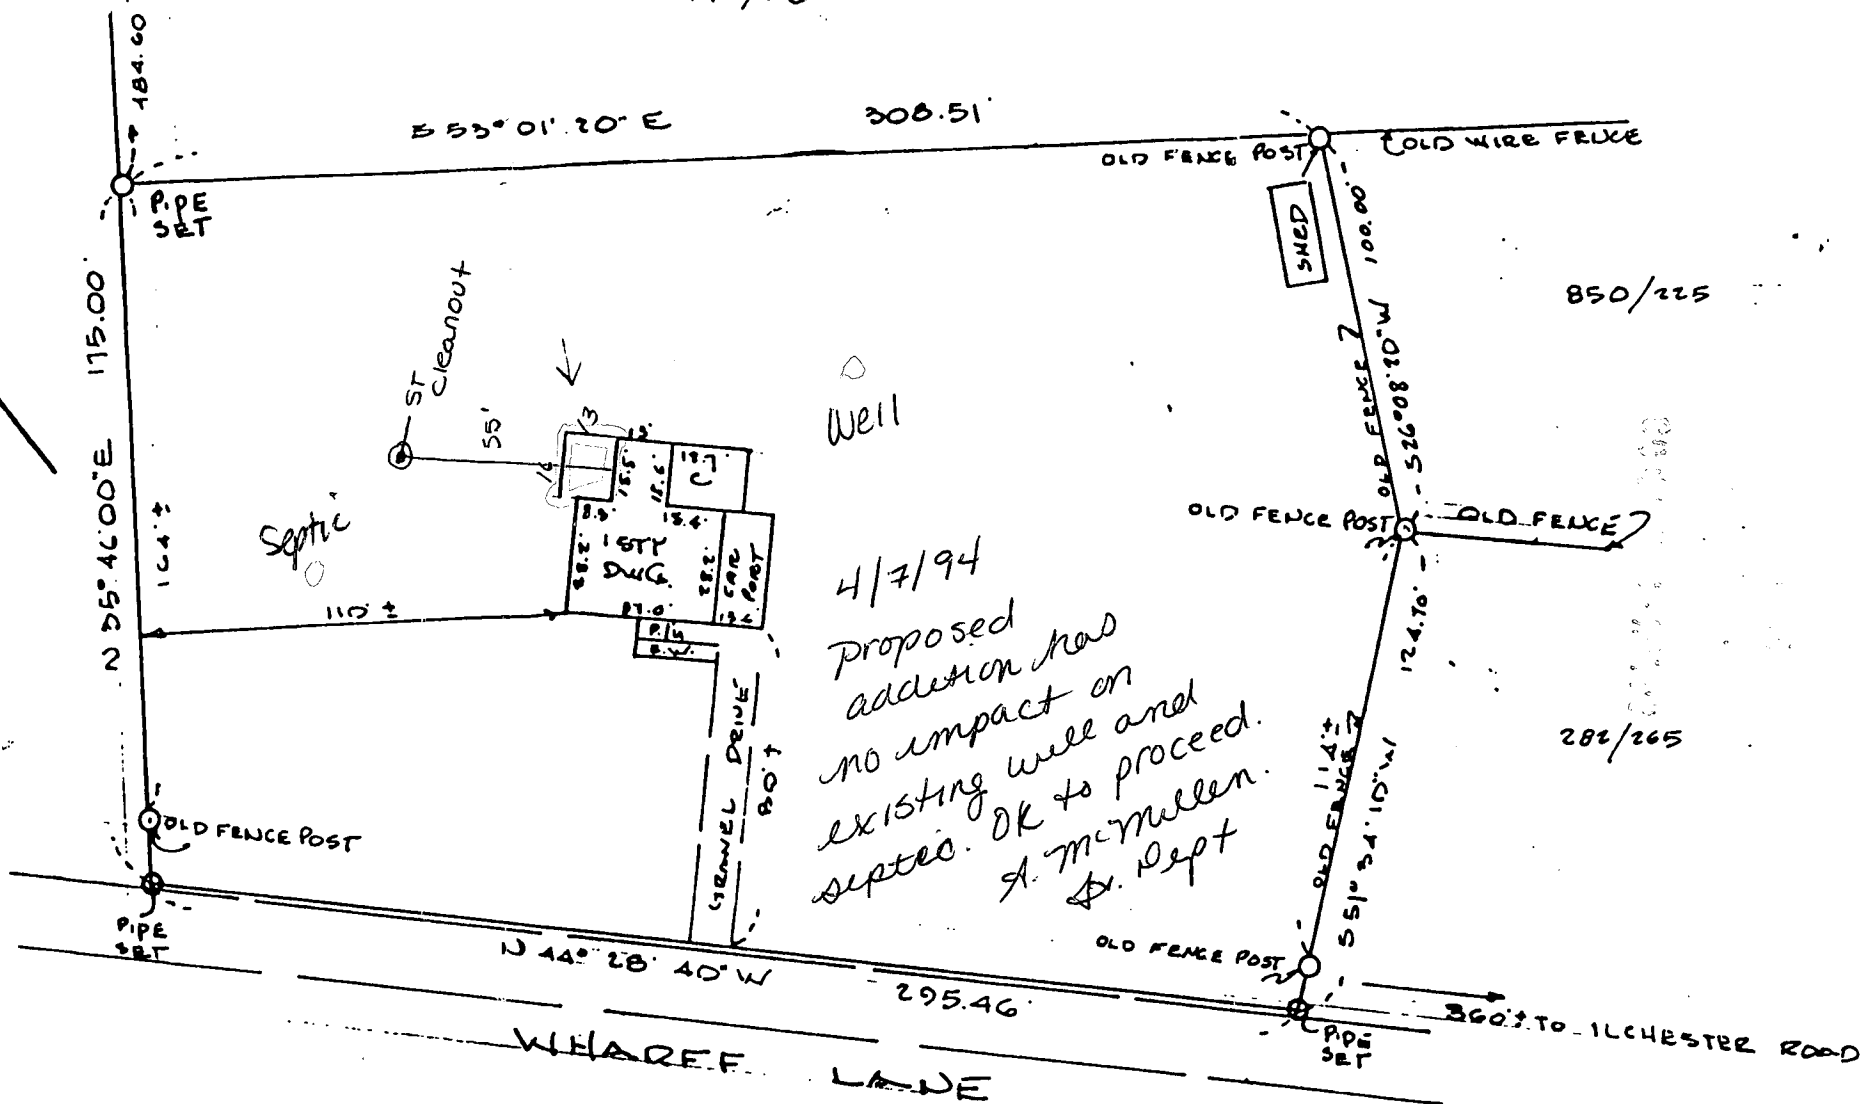


R. F. Loen

AXEL F. LOEN PROF. L.S. # 9724
10372 CURRYCOMB COURT
COLUMBIA, MD 21044

PROPERTY SURVEY
4935 WHARFF LANE
1ST ELECTION DISTRICT HOWARD CO. MD
SCALE 1" = 50' AUG. 25, 1981

Lenore HUFFMAN

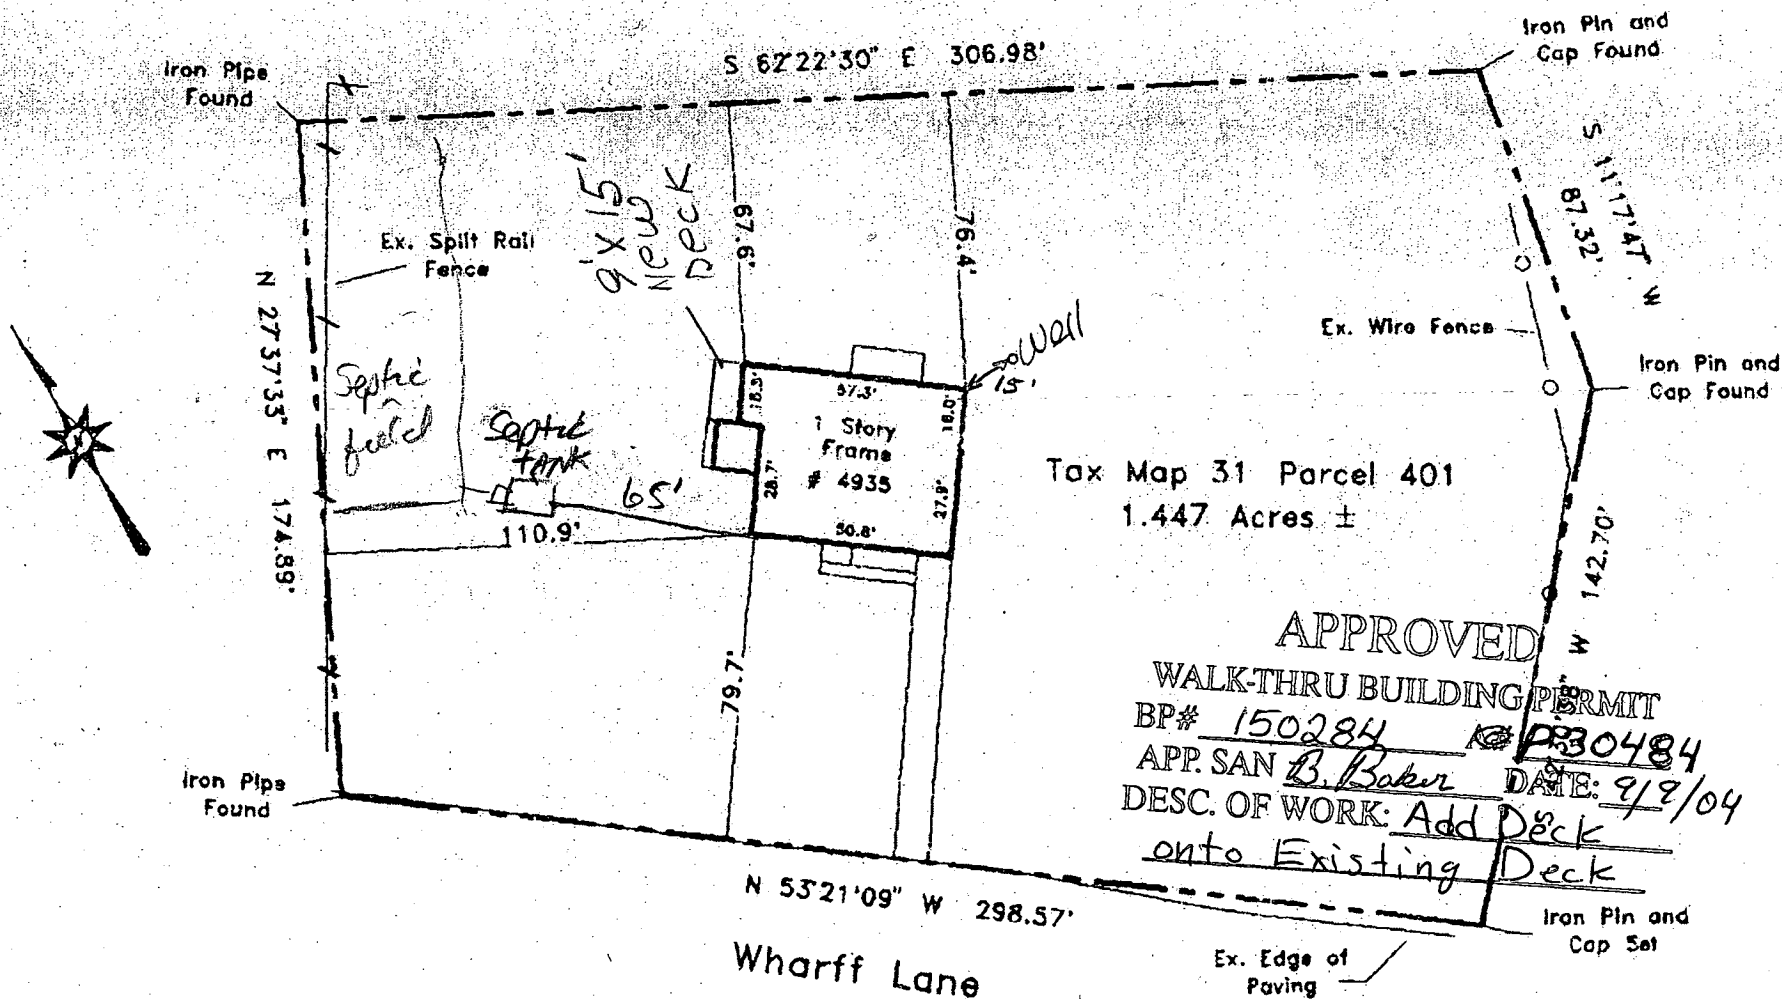

This is to certify that I have surveyed the property shown hereon,
being known as 4935 Wharff Lane

and recorded among the Land Records of Howard County,
Maryland in Liber 1060, folio 640
for the purpose of locating or setting the corners thereof.

Subject property is shown in Zone C
on the FIRM Map of Howard County
Maryland on Community Panel
240044 0029 B Effective December 4, 1986



J. Carl Hudgins PLS #96

PLAT OF SURVEY

4935 Wharff Lane

Howard County, Maryland

NTT Associates, Inc.

16205 Old Frederick Road
Mt. Airy, Maryland 21771
Ph. (410)442-2031
Fax No. (410)442-1315

Scale: 1" = 50'

Date: April 15, 2003

Field By: JLM/JCH

Drawn By: JLM

Drawing # Misc6006

APPROVED

WALK-THRU BUILDING PERMIT


BP# 60015779 A#

APP. SANX

DESC. OF WORK:

10x30 Pick Room

DATE: 12/2/20

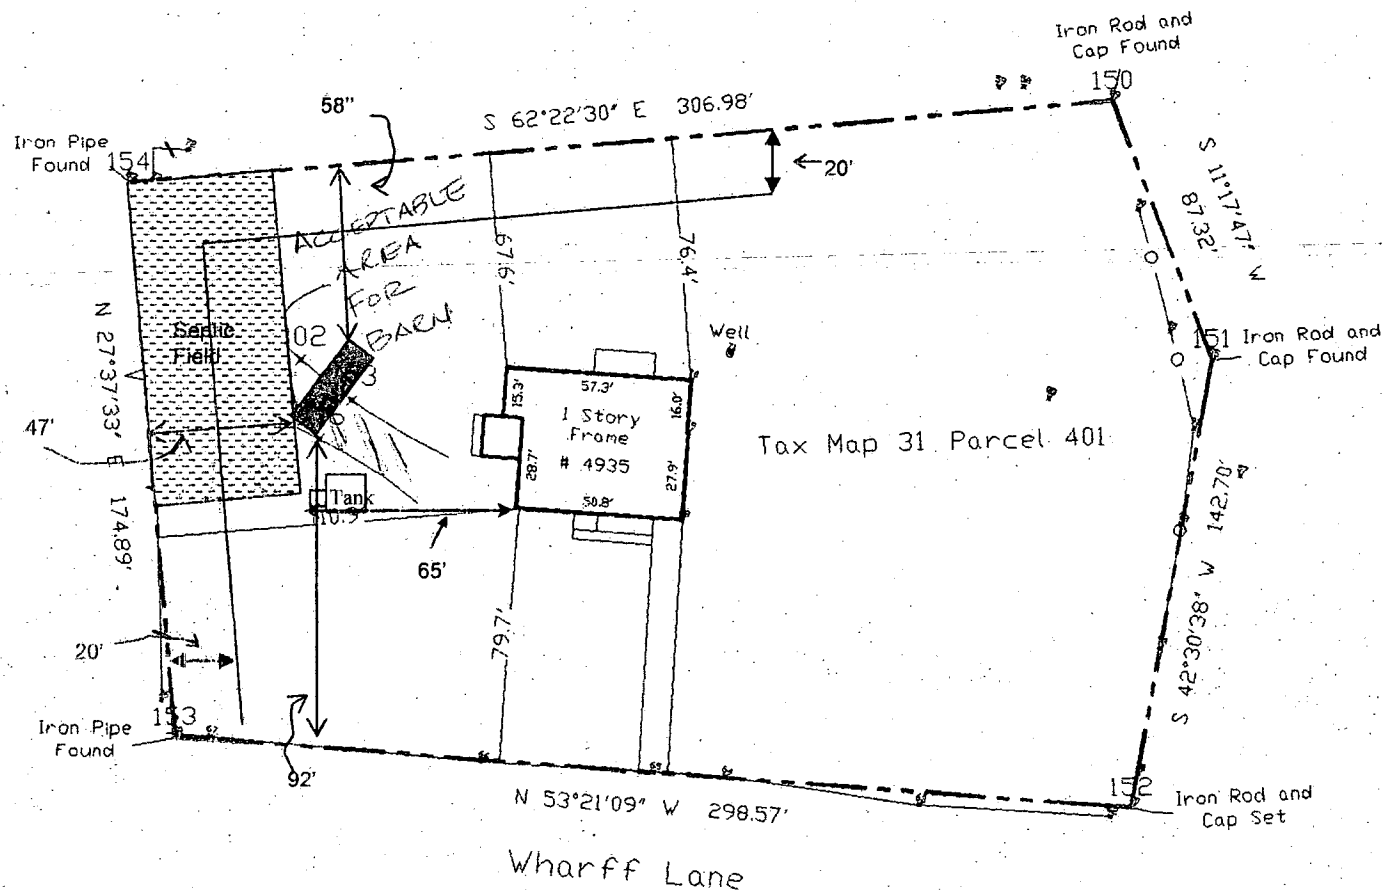

SHED 10' X 30'

50'

Lenore Huffman
4935 Wharff Lane
Ellicott City, MD 21043
Tax Map 31, Parcel 401, Zoning R-20
Lot Size 1.3 acres

Lenore Huffman Property – Plot Plan
4935 Wharff Lane
Ellicott City, MD 21043

