

PERMIT

SEWAGE DISPOSAL SYSTEM

DEPARTMENT OF HEALTH AND MENTAL HYGIENE

HOWARD COUNTY HEALTH DEPARTMENT

BUREAU OF ENVIRONMENTAL HEALTH

313-2640

INDEXED

P 49434

A 30331

DISTRICT 3rd

DATE 7/2/93

DATE SYSTEM APPROVED 7/30/93

INSPECTOR M. R. Fkin

Paul Schissler/South Carroll Backhoe

IS PERMITTED TO INSTALL ☒ ALTER

ADDRESS 4410 Salem Bottom Road, Westminster, Maryland 21157 PHONE 875-4197

SUBDIVISION Wynfield, Section 2 LOT 4 ROAD 2760 Wynfield Road

PROPERTY OWNER Altieri Homes

ADDRESS

BUILDING PERMIT SIGNED

AND RETURNED

SEPTIC TANK CAPACITY 1250 GALLONS

NUMBER OF BEDROOMS 4

210 SQUARE FEET PER BEDROOM

LINEAR FEET OF TRENCH REQUIRED 212

TRENCHES - Trench to be 2 feet wide. Inlet 4 feet below original grade. Bottom maximum depth 8 feet below original grade. Effective area begins at 4 feet below original grade. 4 feet of stone below distribution pipe.

LOCATION - Place the distribution box 280 feet down the left lot line (511.00') and 90 feet off that line as seen when facing the lot from Wynfield Road. Run trenches on contour toward the left lot line. MAINTAIN A MINIMUM OF 100 FEET FROM THE WELL.

NOTES - No trench to exceed 100 feet in length. Provide 6" - 8" diameter cleanout and cap to grade or above on septic tank. OK 7/9/93 RIT

PLANS APPROVED BY Jane Nadeau/Raymond Hodges

REVISED DATE 10/31/91

COVER NO WORK UNTIL INSPECTED AND APPROVED

NEITHER THE HOWARD COUNTY COUNCIL NOR THE HEALTH DEPARTMENT IS RESPONSIBLE FOR THE SUCCESSFUL OPERATION OF ANY SYSTEM

NOTE: CLEANOUT REQUIRED EVERY 70 FEET OF SEWER LINE AND/OR AT 90° SWEEPS IN LINES FROM HOUSE TO DRAIN FIELDS, 90° ELBOWS NOT ACCEPTABLE.

NOTE: ALL PARTS OF SEPTIC SYSTEMS (I.E. TANK, DISTRIBUTION BOX TRENCHES) TO BE 100 FEET FROM WELL (UNLESS OTHERWISE SPECIFICALLY AUTHORIZED)

NOTE: IF DEEP TRENCH(ES) ARE USED CALL FOR INSPECTION BEFORE AND AFTER PLACING GRAVEL IN TRENCH(ES)

NOTE: NO DRY WELL SHALL EXCEED 15 FOOT IN DIAMETER NO ABSORPTION TRENCH TO EXCEED 100 FEET IN LENGTH

NOTE: ALL PIPE FROM HOUSE TO SEPTIC TANK MUST BE CAST IRON OR SCHEDULE 35/40 PVC OR ABS


PERMIT VOID AFTER TWO YEARS

NOTE: INSTALL STAND PIPE ON SEPTIC TANK AND DRY WELL STAND PIPES MUST BE 6 INCHES IN DIAMETER CAST IRON. CONCRETE OR TERRA COTTA OR PVA OR ABS ACCEPTED. IF TOP OF SEPTIC TANK IS DEEPER THAN 3 FEET. MANHOLE TO GRADE REQUIRED.

NOTE: DISTRIBUTION BOXES MUST HAVE BAFFLES

***INSTALLER IS RESPONSIBLE FOR OBTAINING FINAL APPROVAL ON THIS PERMIT**

A 30331

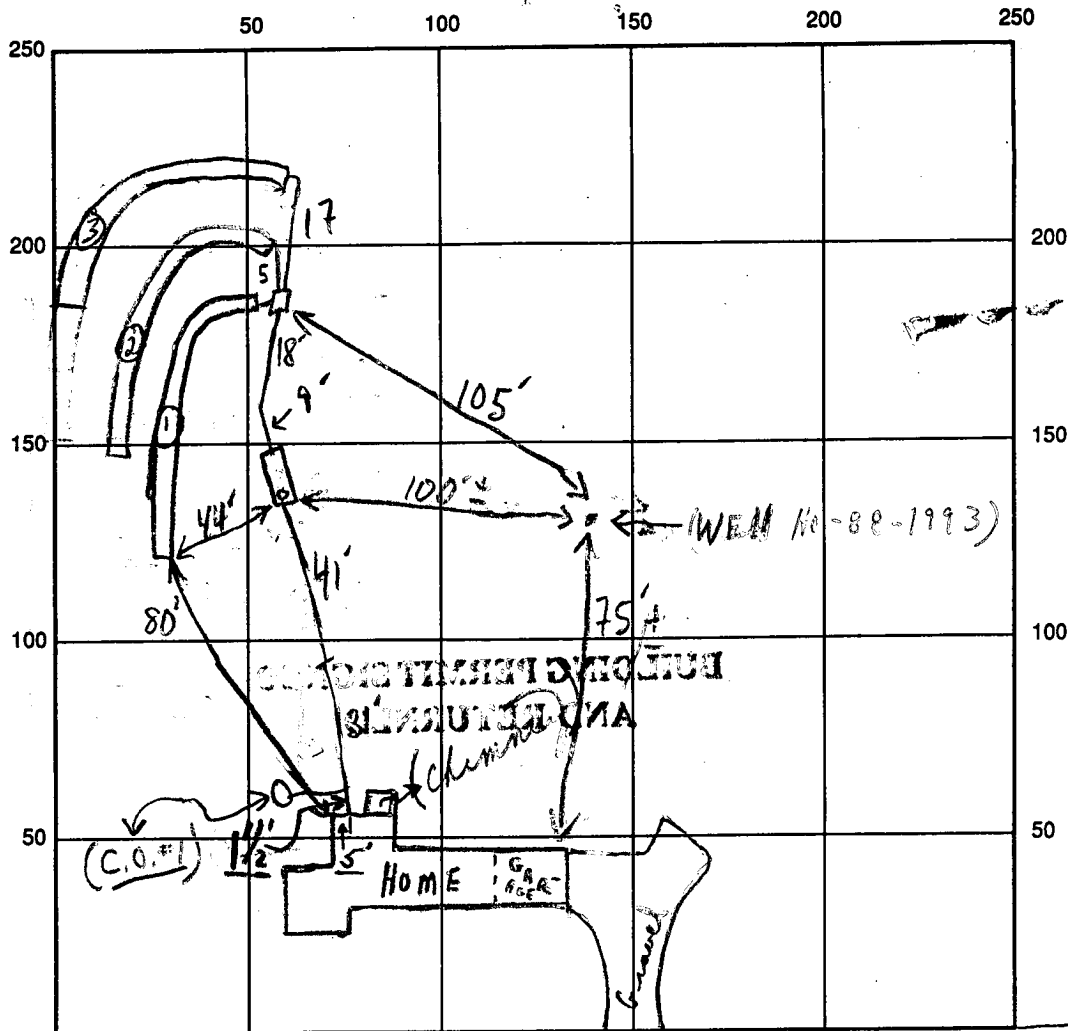

INDICATE NORTH - NAME ADJOINING ROADWAY AS BASE LINE

SEPTIC TANK LEVEL 1500 GAL-OK WYNFIELD ROAD S.T. C.O.#1
 DISTRIBUTION BOX LEVEL OK Billerica IN
 DRAIN FIELD/TITLE DEPTH 8' 1/2' 3' FT. TRENCH WIDTH 2 FT. INLET DEPTH 4' 1/2' 3' FT.
 EFFECTIVE GRAVEL DEPTH 4' 1/2' 3' FT. TOTAL LENGTH 275 FT. 270 FT. 272 FT.
 NUMBER OF TRENCHES 3 ONE SIDEWALL/AREA 2300 SQ. FT. 2292 SQ. FT. 2280 SQ. FT.
 DRYWALL INSIDE DIAMETER FT. EFFECTIVE DEPTH BELOW INLET FT.

ABSORBENT AREA 872 SQ. FT.

REMARKS: (3:00 P.M.) 7/28/93 Partial ok to cover from house to tank - only;
7/28 No trenches yet; 7/28/93 HOLD FOR A CALL C.B.
7/29/93 #1 OK TO CONTINUE MR 7/29/93 #2 TOPO NOT PER
PLAN; HIGH TRENCH TO BE OUT OF SDA, BUT SOIL OK
PER INSTALLER'S DESCRIPTION OF S.T. HOLE; CONTINUE MR
7/28 No W.P.I. C.B. 7/29 P.A. OK 4' B.G. MR 7/30/93 OK TO COVER MR
 DATE SYSTEM APPROVED 7/30/93 INSPECTOR H. Rifkin
L. Feeler

PRELIMINARY

APPLICATION

SEWAGE DISPOSAL TESTING

STATE OF MARYLAND - DEPARTMENT OF HEALTH AND MENTAL HYGIENE

A 30331
P _____HOWARD COUNTY HEALTH DEPARTMENT
ENVIRONMENTAL HEALTH SERVICESP.O. BOX 476 ELLICOTT, MARYLAND 21043
TELEPHONE 992-2330DISTRICT 3rd.DATE 10/31/79TO: THE COUNTY HEALTH OFFICER
ELLICOTT CITY, MARYLAND

I, HEREBY, APPLY FOR THE NECESSARY TEST IN ORDER TO CONSTRUCT (OR RECONSTRUCT) A SEWAGE DISPOSAL SYSTEM.

PROPERTY OWNER Land Associates Walt + Sue Camp - Altieri Homes
Tom Munz - 792-2242
ADDRESS 3450 Ft. Meade Rd., No. 206, Laurel, Md. 20810 PHONE or Ted Snovell - 265-6543PROPERTY LOCATION WYNFIELD 4 sect 2 on final
SUBDIVISION Hoffman property LOT NO. 30
30 or segn prelROAD AND DESCRIPTION Route 144 2760 Wynfield RoadSIZE OF LOT 3 acres plus TYPE BLDG. 3 or 4 bedrooms

THE SYSTEM INSTALLED UNDER THIS APPLICATION IS ACCEPTABLE ONLY UNTIL PUBLIC FACILITIES BECOME AVAILABLE.

I FULLY UNDERSTAND THE FEE CONNECTED WITH THE FILING OF THIS PERC TEST APPLICATION IS NON-REFUNDABLE UNDER ANY CIRCUMSTANCES.

SIGNATURE OF APPLICANT /s/ Ted Snovell for Land AssociatesAPPROVED BY R.D. & D.W.M. FOR DRAINFIELDS 3-8' DATE 12/17/79

REJECTED BY _____ FOR _____ DATE _____

HOLD PENDING FURTHER TESTS _____ DATE _____

REASONS FOR REJECTION OR HOLDING 11/9/79 - more tests slow

BLDG. PERMIT SIGNED


AND RETURNED 11/29/79Serial # 47951 - SFD4 Bedrooms

BLDG. PERMIT SIGNED

AND RETURNED 9/5/89Serial # 28582SFD - 3 Bedrooms

THIS IS NOT A PERMIT

A hand-drawn stratigraphic column. The top section is labeled 'CLAY' and the bottom section is labeled 'HARD SANDY'. A horizontal line separates the two layers. The number '3' is written to the left of the line, and '14' is written at the bottom left corner.

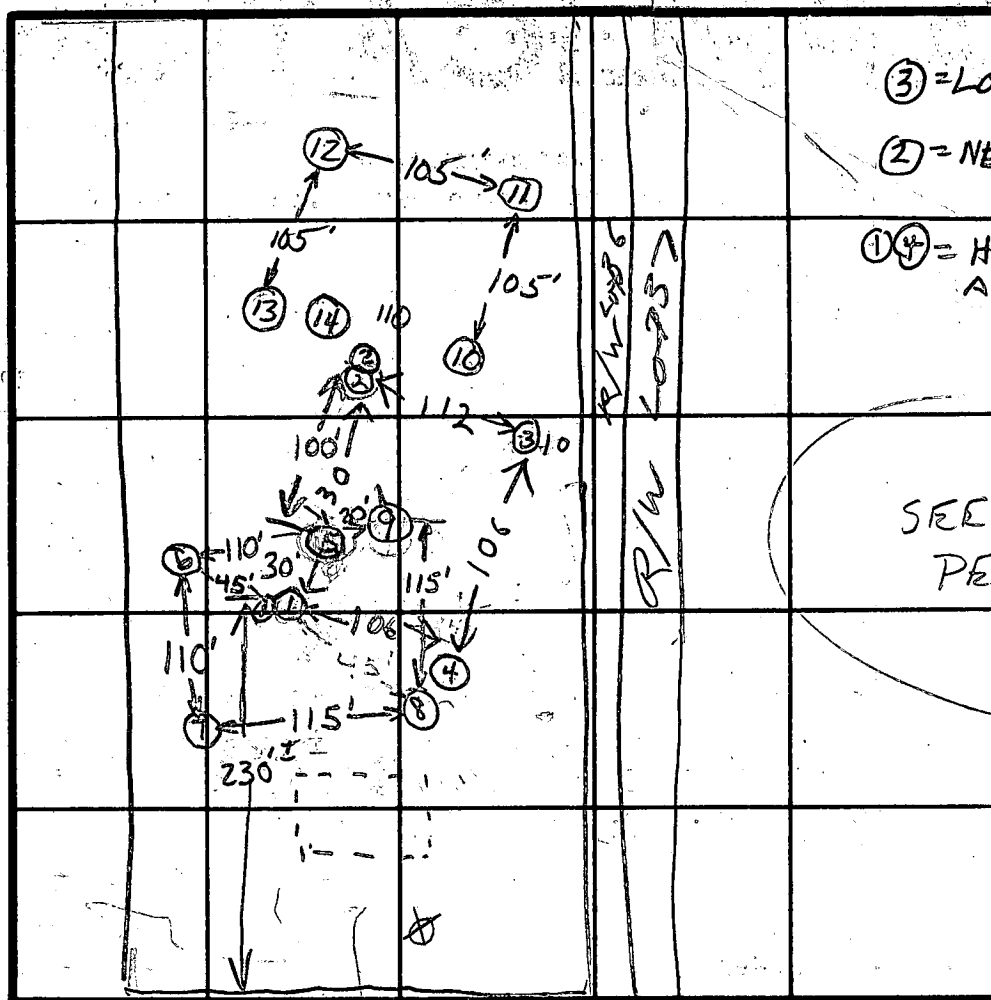

(2) = NEXT LOWEST

①④ = HIGH
ABOUT SAME

SEE NEW
PERC SOAP
ATTACHED

(use 1, 2, 3, 4, 9)

 $\bar{x} = 12 \text{ min}$
$$Inlet = 4.0 \text{ ft}$$

Bottom = 8.0 ft

210 sq ft / bdrm

INDICATE NORTH - NAME ADJOINING ROADWAY AS BASE LINE

PROPOSED BILL

HOLE 5

CLAY - 4
SANDY
CLAY

-148

DATE	TEST NO.	DEPTH	PRE-WET		TEST - 1" DROP		TIME
			START	STOP	START	STOP	
11/9/79	1 S	5 1/2	1201	1203	1203	1208	5
11/9/79	1 D	14	1202	1235	instruct 33	FAIL	—
	2 S	5 1/2	1212	1216	1216	1225	9
	2 D	14	1215	1247	SLOW	FAIL	—
	3 S	4 1/2	1219	1220	1220	1223	3
	3 D	14	1223	1235	1235	1254	19
	4 S	4 1/2	1229	1231	1231	1234	3
11/9/79	4 D	14 1/2	1230	1245	1245	1113	28
11/9/79	RETEST 1 S	5	9:38	9:40	9:40	9:43	3
	1 D	13 1/2	9:39	9:58	9:58	10:13	15
	RETEST 2 D	13 1/2	9:50	9:59	9:59	FAILED 2nd INCH	X

11/19/79	5D	14 1/2'	3106	FAILED 1ST INCH	OK
REMARKS	RETESTED HOLES 1 & 2 WITHIN 15' OF ORIG. HOLES.				
					11/19/79

TYPE OF SOIL HOLE # 2-SANDY WITH WEATHERED LOOSE ROCK

TESTED BY

214

11/19/79
R.D.

ALSO PRESENT

JIM DUSZYNSKI


LOT 30

HOTTEMAN PROP

DATE	TEST NO.	DEPTH	START	STOP START	STOP	TIME
11/29/79	6S	5'	2:19	2:21	2:23	2
	6D	13'	2:20	2:24	2:32	8
	7S	4'	2:35	FAILED 1 ST INCH		
	7D	14 1/2'	2:35	2:46	3:03	17
	7M	6 1/2'	2:59	FAILED 1 ST INCH -		
	8S	4 1/2'	2:50	2:52	2:55	3
	8D	13 1/2'	2:51	3:16	FAILED 2 ND INCH	
	9S	5'	3:43	3:46	3:52	6
	9D	13 1/2'	2:56	3:06	3:32	24
J.S. & R.D. 12/14/79	10S	4'	2:06	2:08	2:12	4
	10D	14'	2:06	2:12	2:21	9
	11S	3'	2:07	2:08	2:09	1
	11D	14'	2:07	2:11	2:17	6
	12S	4'	2:10	2:11	2:12	1
	12D	14'	2:10	2:12	2:14	2
	13S	4'	2:18	2:19	2:21	2
	13D	13'	2:18	2:25	2:36	11



SANDY - NO ROCK

ALL SAND

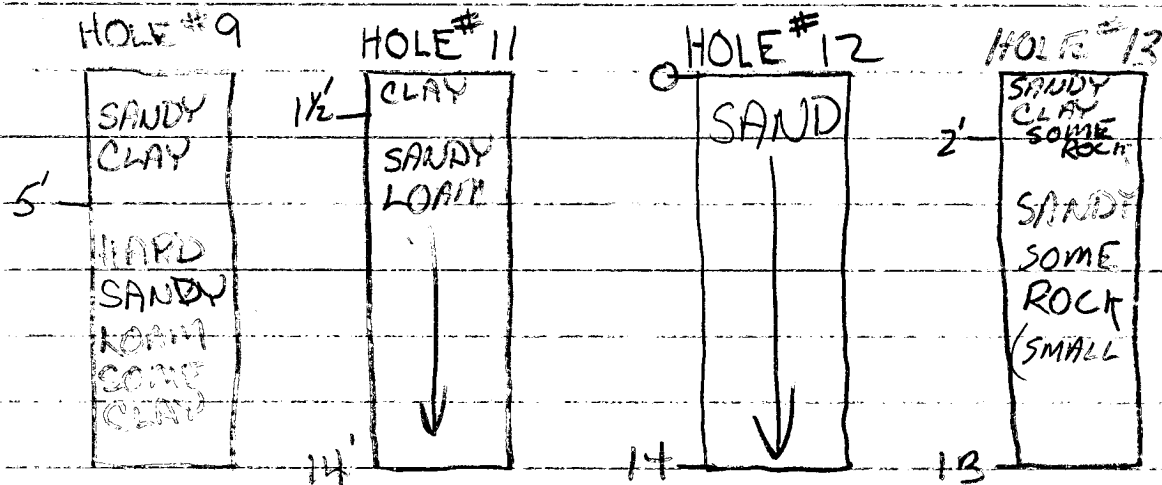

LEGEND

Contour Interval 2 Ft.
 Existing Contour 390
 Proposed Contour 390
 Spot Elevation 98±
 Direction of Drainage
 Walk-Out Basement

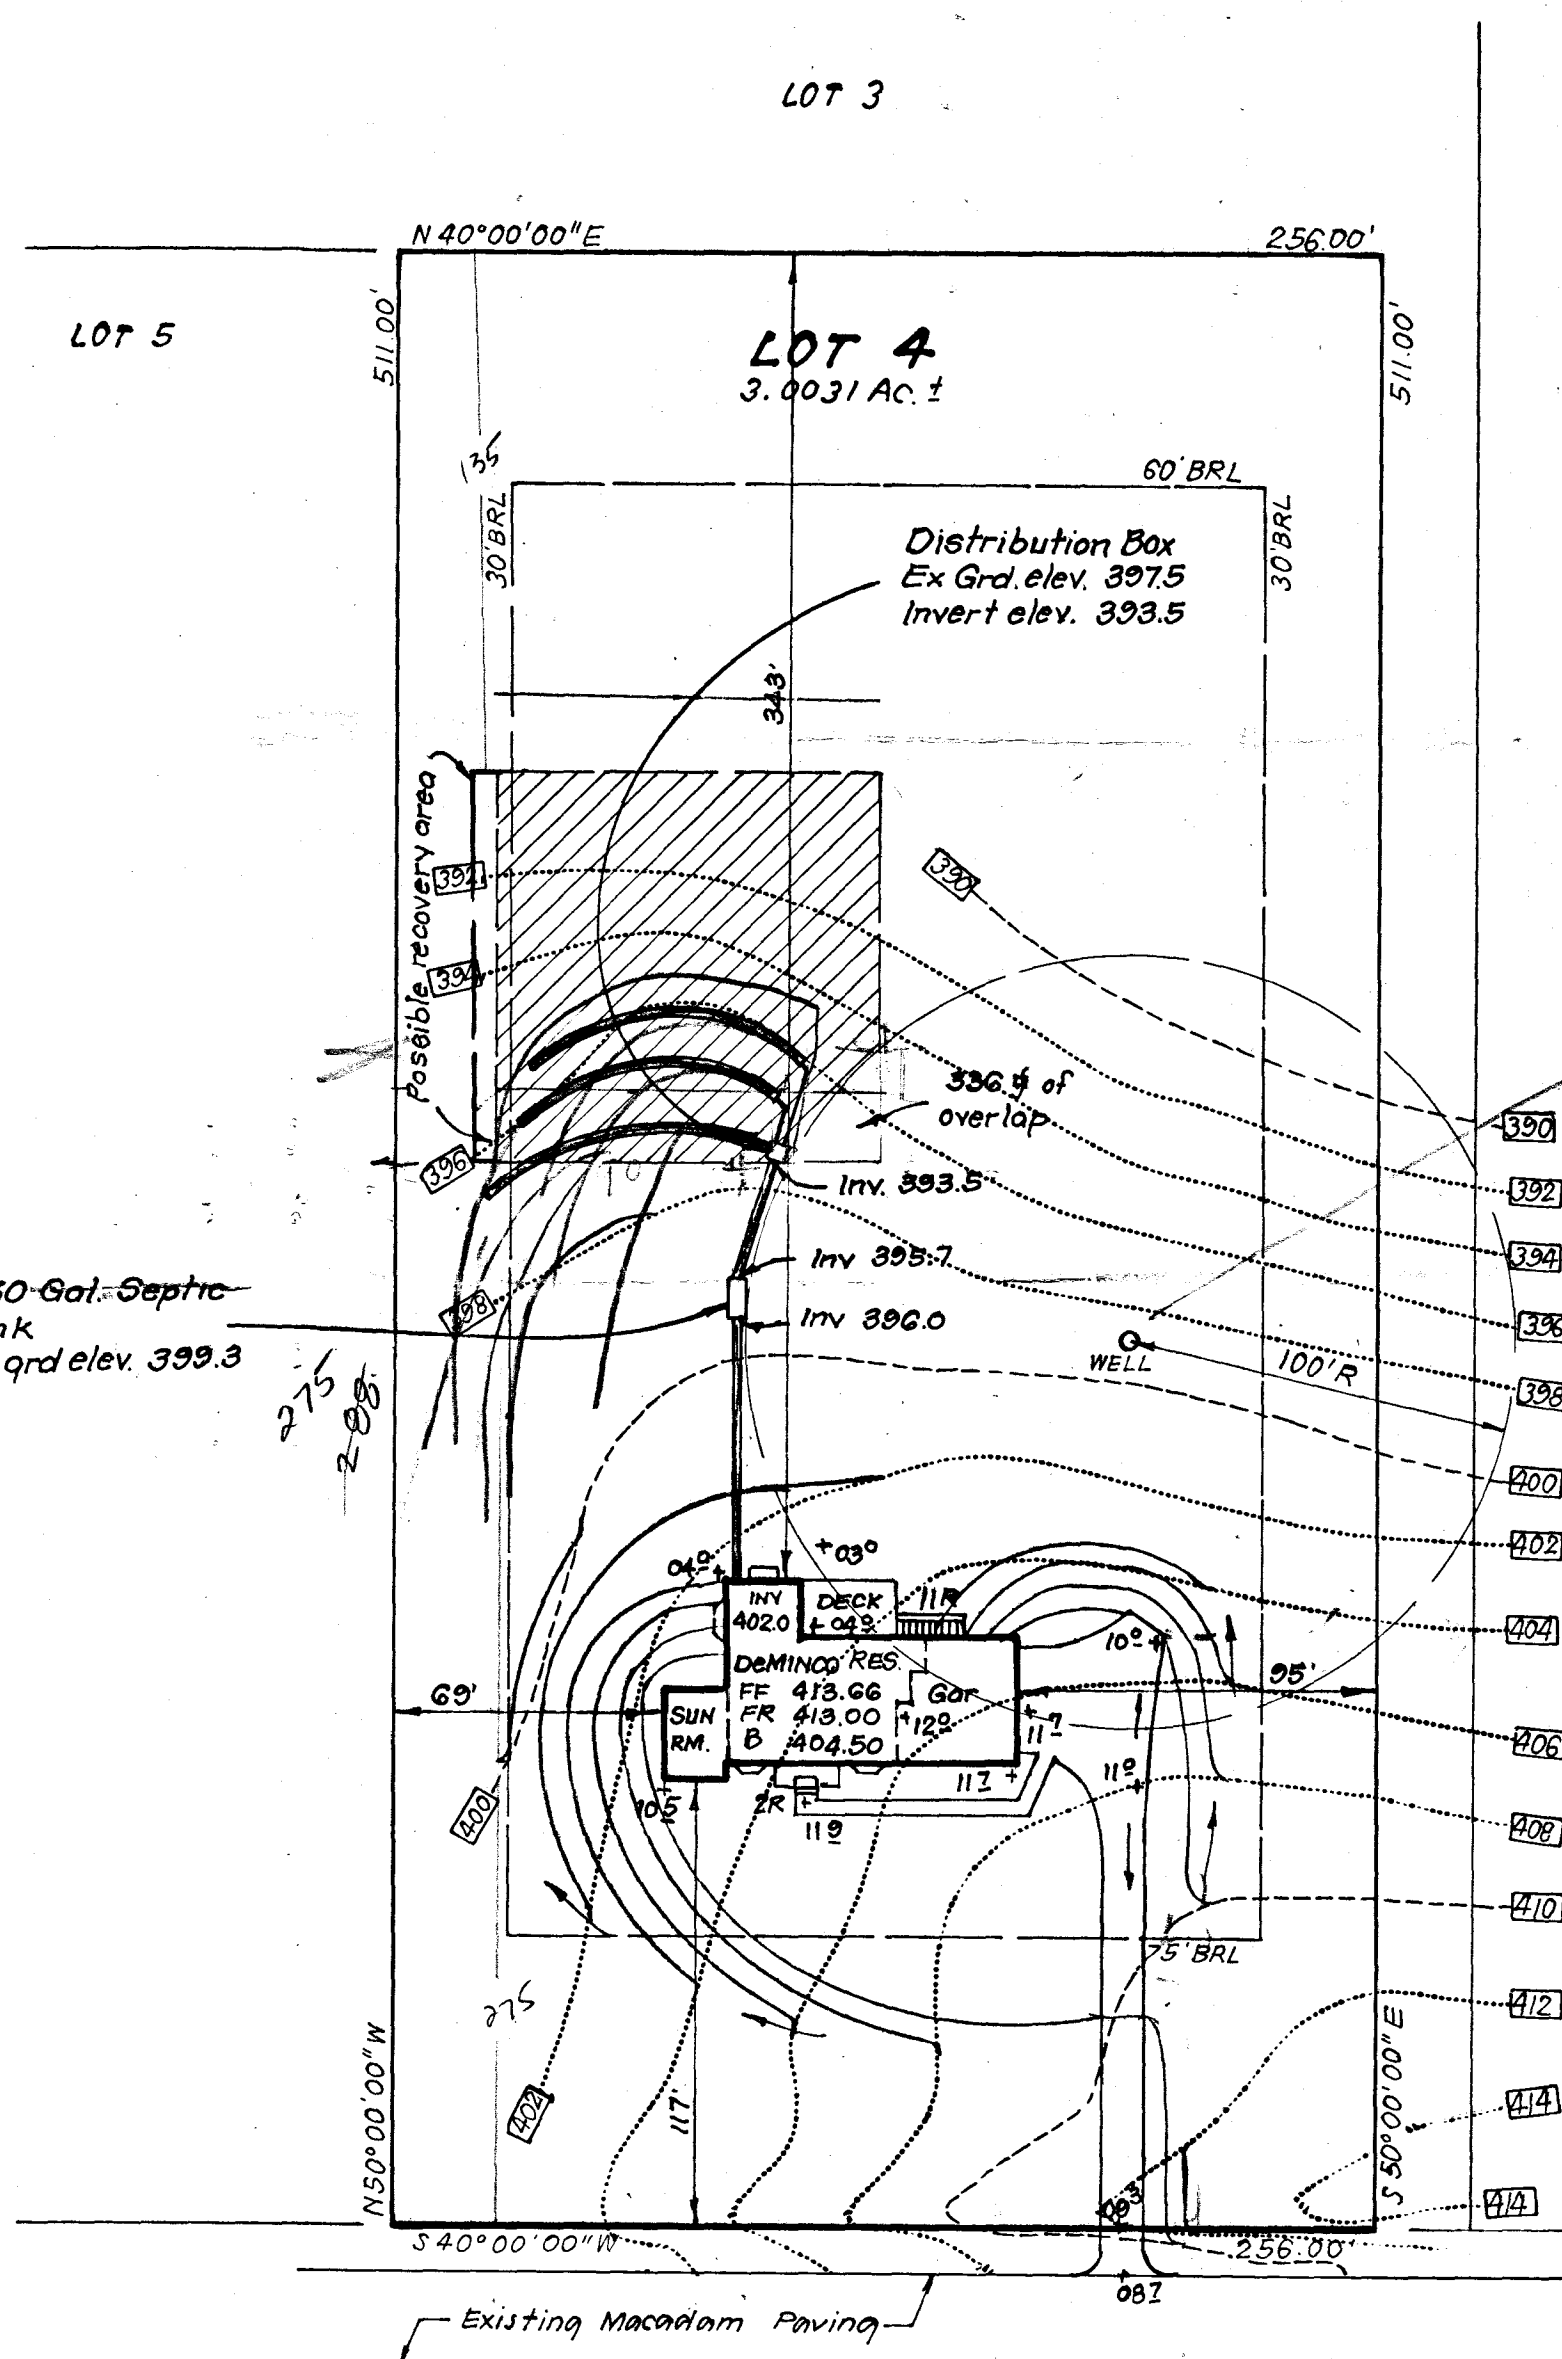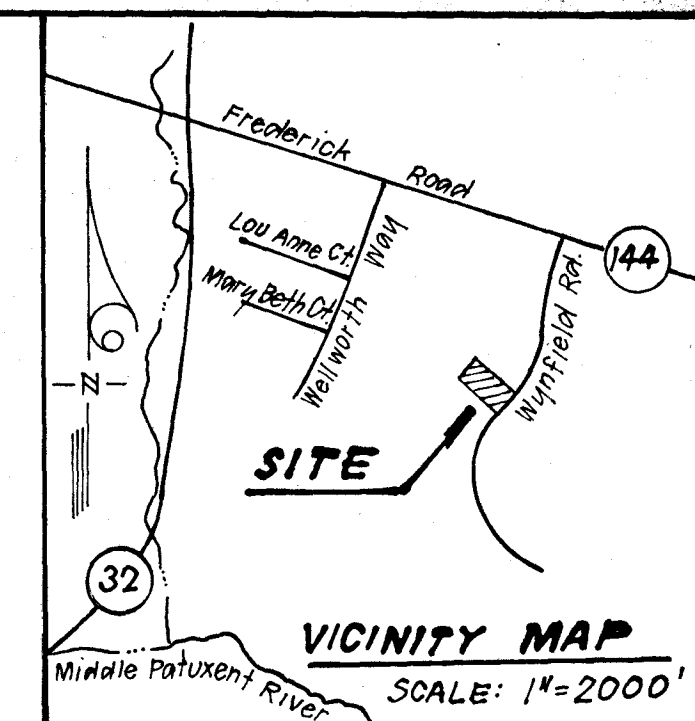

PLAN SCALE

1" = 50'

Check well location
 with Engineer

GENERAL NOTES

1. Reference Plat Number 5457.
2. Subject Property is Zoned R.
3. Topography taken from survey by Clark, Finetrock & Sackett, Inc. dated 3-31-93
4. Length of trench to be determined at time of permit issuance.

4/30/93
 PLANS OK
 ENGINEER CONFIRMED
 WELL LOCATION
 BP 4M951
 RH

WYNFIELD ROAD
 50' R/W

4 Bedrooms

 CLARK • FINEFROCK & SACKETT, INC. ENGINEERS • PLANNERS • SURVEYORS 715 MINISTREET WAY • COLUMBIA, MD 21045 • (410) 381-7500 • BALTO • (410) 621-8800 • WASH		
DESIGNED J.M.E.	SITE DEVELOPMENT PLAN LOT 4 WYNFIELD SECTION 2 LOTS No 1 THRU No 15 3RD ELECTION DISTRICT HOWARD COUNTY, MARYLAND	SCALE 1" = 50'
DRAWN JTR		DRAWING 1 OF 1
CHECKED J.M.E.		JOB NO. 93-069
DATE 4-5-93		FILE NO. 93-069-X
FOR: ALTIERI ENTERPRISES, INC. 7349 Gardenvue Drive Elkridge, Maryland 21227		

N 40°00'00"E

256.00'

511.00'

511.00'


LOT 4
3.0031 AC. ±

LOT 1

30' BRL

60' BRL

30' BRL

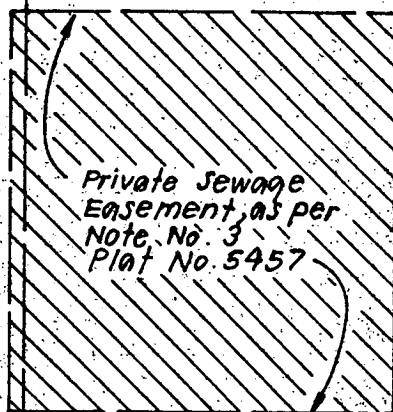

75' BRL

X

septic line w/ tank
dies here 70' away

New Deck

Existing deck steps
to be replaced

#2680

84' ±

80' ±

75' BRL

117' ±

S 0°00'00"W


S 0°00'00"E

5/19/04

proposed
Deck location
OK. No well
or septic
issues

KN

BP00148287

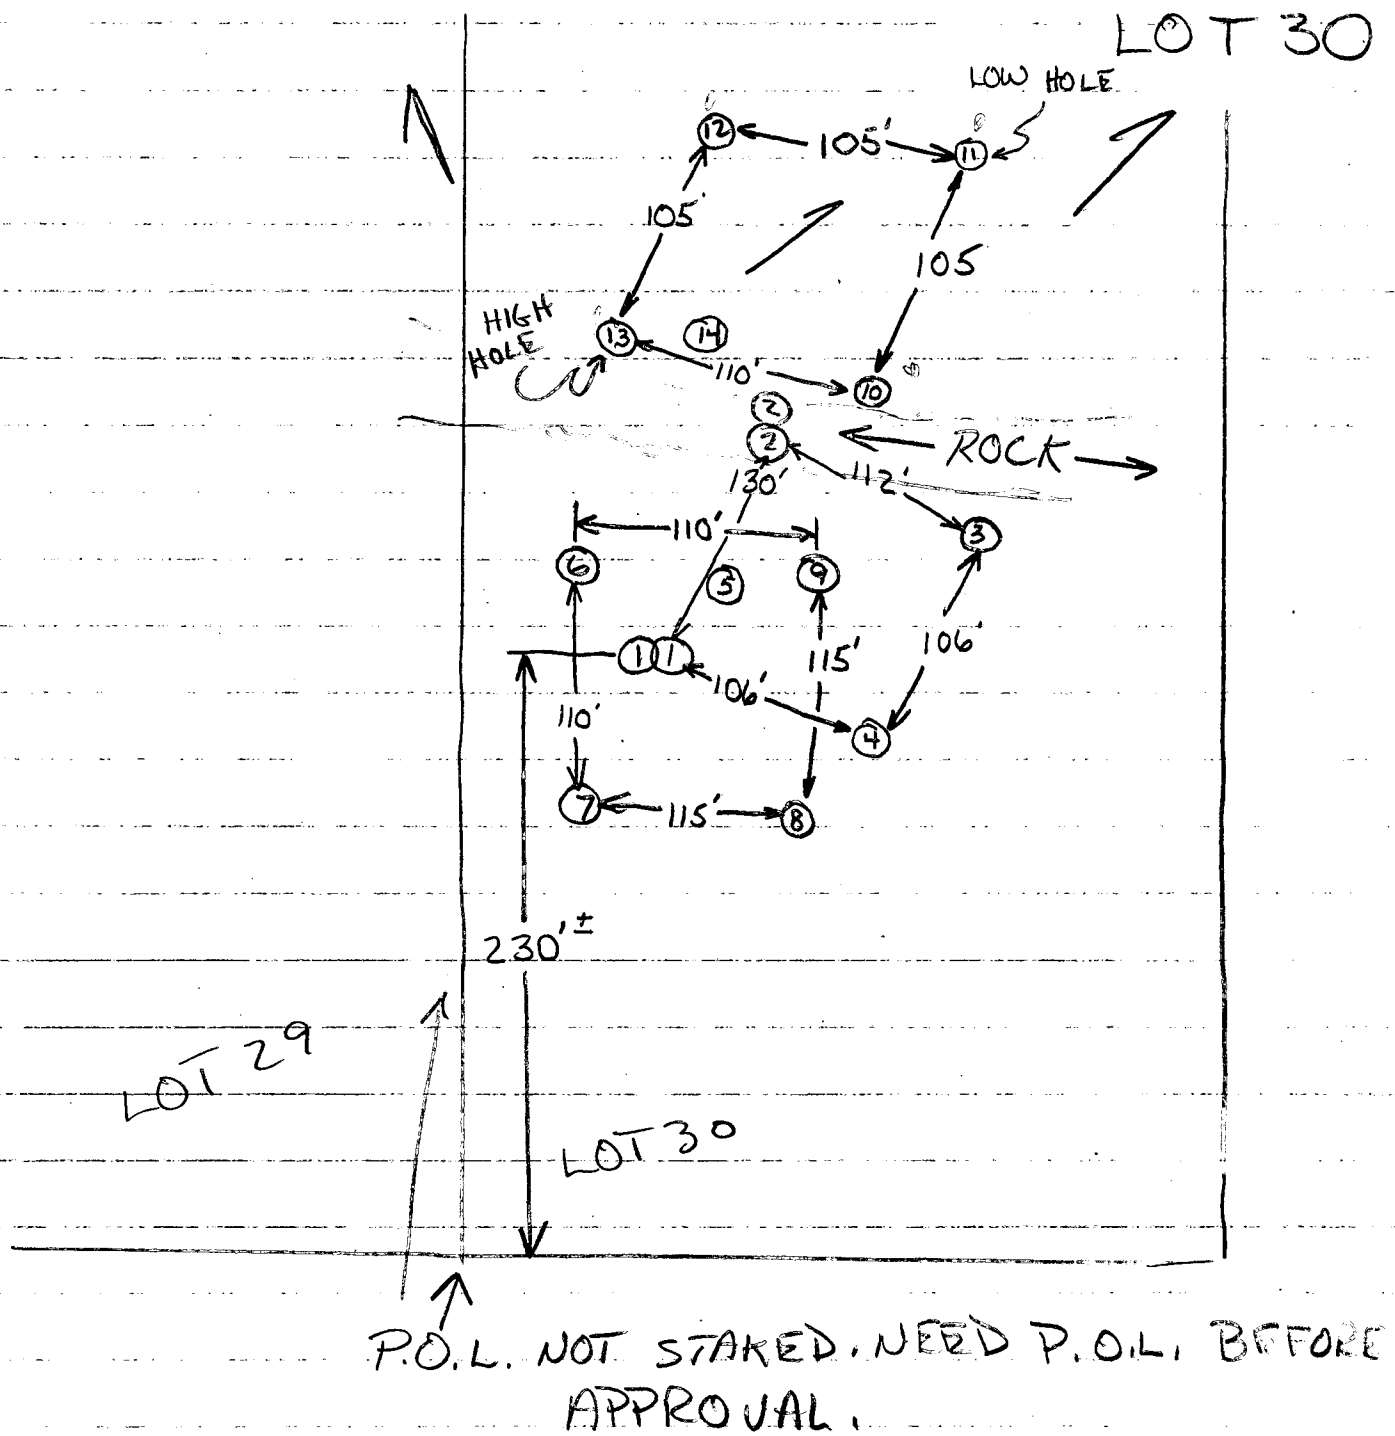

②

③



**BUILDING
RESTRICTION
LINE**



①
3.0031 Act

④

MR (4) Site
11/1/91 Radius OK
3.0031 Ac.

3.0031 A.C.

BUILDING RESTRICTION than

ROAD

SH.3 OF 3 SECT 2 WYNFIELD
250

We, Ballenger Creek Ass

L.C.B.
S 34° 00' 00" W 287.45
S 32° 21' 36" W 230.00

DTAL SECT. 2

15

C1		4656		SEQUENCE NO. (DENV USE ONLY)		OF MARYLAND COMPLETION REPORT		THIS REPORT MUST BE SUBMITTED WITHIN 45 DAYS AFTER WELL IS COMPLETED.	
(THIS NUMBER IS TO BE PUNCHED IN COLS. 3-6 ON ALL CARDS)		DATE WELL COMPLETED		Depth of Well / (TO NEAREST FOOT)		COUNTY NUMBER		PERMIT NO.	
ST/CO USE ONLY DATE Received		11/12/91		320		A 30331		FROM "PERMIT TO DRILL WELL"	
OWNER		last name		first name		TOWN		LOT	
STREET OR RFD		SUBDIVISION		SECTION		LOT			
WELL LOG		GROUTING RECORD		PUMPING TEST		C3			
Not required for driven wells		WELL HAS BEEN GROUTED (Circle Appropriate Box)		HOURS PUMPED (nearest hour)		1		2	
STATE THE KIND OF FORMATIONS PENETRATED, THEIR COLOR, DEPTH, THICKNESS AND IF WATER BEARING		TYPE OF GROUTING MATERIAL		PUMPING RATE (gal. per min. to nearest gal.)		3		8	
DESCRIPTION (Use additional sheets if needed)		CEMENT CM BENTONITE CLAY BC		METHOD USED TO MEASURE PUMPING RATE		Bucket		15	
FEET FROM TO		NO. OF BAGS NO. OF POUNDS		WATER LEVEL (distance from land surface)		BEFORE PUMPING		WHEN PUMPING	
Top Soil 0 2		GALLONS OF WATER DEPTH OF GROUT SEAL (to nearest foot)		TYPE OF PUMP USED (for test)		A air P piston T turbine			
Sandy 2 50		from 0 ft to 50 ft		C centrifugal R rotary O other (describe below)		J jet S submersible			
Sand Stone 50 55		Casing Record		PUMP INSTALLED		DRILLER WILL INSTALL PUMP (YES NO)			
MICKA 55 75		casing types insert appropriate code below		CAPACITY: GALLONS PER MINUTE (to nearest gallon)		IF DRILLER INSTALLS PUMP, THIS SECTION MUST BE COMPLETED FOR ALL WELLS EXCEPT HOME USE			
Sand Stone 75 80		MAIN CASING TYPE Nominal diameter top (main) casing (nearest inch) Total depth of main casing (nearest foot)		PUMP HORSE POWER		TYPE OF PUMP INSTALLED PLACE (A,C,J,P,R,S,O) IN BOX - SEE ABOVE			
MICKA 80 215		P L 6 65		PUMP COLUMN LENGTH (nearest ft.)		CAPACITY: GALLONS PER MINUTE (to nearest gallon)			
Sand Stone 215 220		OTHER CASING (if used) diameter inch depth (feet) from to		CASING HEIGHT (circle appropriate box and enter casing height)		PUMP HORSE POWER			
MICKA 220 320		EACH CASING		LAND SURFACE (nearest foot)		PUMP COLUMN LENGTH (nearest ft.)			
		screen type or open hole insert appropriate code below		LOCATION OF WELL ON LOT		SHOW PERMANENT STRUCTURE SUCH AS BUILDING, SEPTIC TANKS, AND/OR LANDMARKS AND INDICATE NOT LESS THAN TWO DISTANCES (MEASUREMENTS TO WELL)			
		ST BR HO STEEL BRASS OPEN HOLE PL BRONZE HOLE OT PLASTIC OTHER		SLOT SIZE 1 2 3		DIAMETER OF SCREEN (NEAREST INCH)			
		C2		GRAVEL PACK IF WELL DRILLED WAS FLOWING WELL INSERT F IN BOX 68		OEP USE ONLY (NOT TO BE FILLED IN BY DRILLER)			
		CIRCLE APPROPRIATE LETTER		TELESCOPE CASING LOG INDICATOR OTHER DATA		T (E.R.O.S.) W Q			
		A A WELL WAS ABANDONED AND SEALED WHEN THIS WELL WAS COMPLETED				70 72 74 75 76			
		E ELECTRIC LOG OBTAINED							
		P TEST WELL CONVERTED TO PRODUCTION WELL							
		I HEREBY CERTIFY THAT THIS WELL HAS BEEN CONSTRUCTED IN ACCORDANCE WITH COMAR 26.04.04 "WELL CONSTRUCTION" AND IN CONFORMANCE WITH ALL CONDITIONS STATED IN THE ABOVE CAPTIONED PERMIT, AND THAT THE INFORMATION PRESENTED HEREIN IS ACCURATE AND COMPLETE TO THE BEST OF MY KNOWLEDGE							
		DRILLERS IDENT. NO. 213							
		DRILLERS SIGNATURE							
		SITE SUPERVISOR (sign of driller or journeyman responsible for sitework if different from permittee)							

Page _____ of _____
Date NOV 12 1991

Review MR OK 1/23/92

FIELD DATA SHEET
HOWARD COUNTY WELL YIELD TEST

Well Permit No. HO - 88-1993
Location of property (road) Wynfield Rd
Subdivision WYNFIELD Sec 2 Lot 4 Block _____ Plat _____ Sec. _____
Well Driller R Mayne Owner Demineo, Paul

Depth of well 320
Distance of measuring point (M.P.) above ground 2 ft
Static water level (S.W.L.) below M.P. 33 ft



I. High rate pumping -- reservoir drawdown

Time pump started 8:00 Pumping rate 10 GPM
Total time 30 min to reach pumping water level 114 ft. below M.P.

II. Recovery pump test data - observations to be recorded every 15 minutes

TIME (in 15 minute intervals)	WATER LEVEL below M.P.	PUMPING RATE time to fill 1 gallon bucket	FLOW METER READING (if used)	CALCULATED FLOW (gallons per minute)
8:30	114 ft	20 Sec		3 GPM
8:45	114 ft	20 Sec		3 GPM
9:00	114 ft	20 Sec		3 GPM
9:15	114 "	20 "		3 "
9:30	114 "	20 "		3 "
9:45	114 "	20 "		3 "
10:00	114 ft	20 Sec		3 GPM
10:15	114 ft	20 Sec		3 GPM
10:30	114 ft	20 Sec		3 GPM
10:45	114 "	20 "		3 "
11:00	114 "	20 "		3 "
11:15	114 "	20 "		3 "
11:30	114 ft	20 Sec		3 GPM
11:45	114 ft	20 Sec		3 GPM
12:00	114 ft	20 Sec		3 GPM
12:15	114 "	20 "		3 "
12:30	114 "	20 "		3 "
12:45	114 "	20 "		3 "
1:00	114 ft	20 Sec		3 GPM
1:15	114 ft	20 Sec		3 GPM
1:30	114 ft	20 Sec		3 GPM
1:45	114 "	20 "		3 "
2:00	114 "	20 "		3 "
2:15	114 ft	20 Sec		3 GPM
HD-2242:30	114 ft	20 Sec		3 GPM

65 ft casing
50 ft new
15 ft old

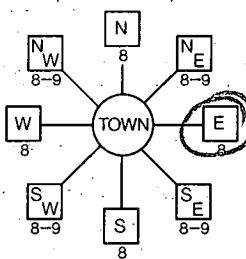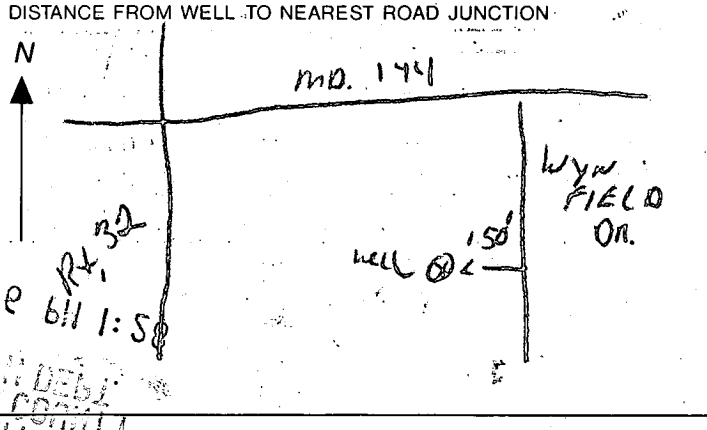B 1 6163	SEQUENCE NO. (DP USE ONLY) THIS NUMBER IS TO BE PUNCHED IN COLS. 3-6 ON ALL CARDS)	STATE OF MARYLAND APPLICATION FOR PERMIT TO DRILL WELL please print or type	STATE PERMIT NUMBER HO-88-1993 fill in this form completely
Date Received (APA) 10/16/91		B 3 LOCATION OF WELL	
OWNER INFORMATION 15 Last Name DEMINGO Owner First Name PAUL 36 Street or RFD 9279 BROKEN TIMBER 57 Town COLUMBIA 70 State 72 MD Zip 76 21045		8 COUNTY HOWARD 21 23 SUBDIVISION WYNFIELD 42 SECTION 2 44 LOT 4 48 50 52 NEAREST TOWN WEST FRIENDSHIP 71 MILES FROM TOWN (enter 0 if in town) 1 73 M 76 I 77 78	
DRILLER INFORMATION Driller's Name Ralph MAYNE 77 License No. 80 273 Firm Name Ralph Mayne Well Drilling Address 9120 Brown Church Rd. Mt. Airy Signature Ralph Mayne Date 10/11/91		B 4 DIRECTION OF WELL FROM TOWN (CIRCLE BOX) 	
B 2 WELL INFORMATION APPROX. PUMPING RATE (GAL. PER MIN.) 5 8 12 AVERAGE DAILY QUANTITY NEEDED (GAL. PER DAY) 590 14 20		11 WYNFIELD DRD 30 NEAR WHAT ROAD ON WHICH SIDE OF ROAD (CIRCLE APPROPRIATE BOX)  34 150 37 DISTANCE FROM ROAD ENTER FT or MI A+ 38 39	
USE FOR WATER (CIRCLE APPROPRIATE BOX) ☒ D HOME (SINGLE OR DOUBLE HOUSEHOLD UNIT ONLY) ☐ F FARMING (LIVESTOCK WATERING & AGRICULTURAL IRRIGATION) ☐ I INDUSTRIAL, COMMERCIAL, STATE AND FEDERAL GOV. OTHER (REQUIRES APPROPRIATION PERMIT) ☐ P PUBLIC OR PRIVATE WATER COMPANY (REQUIRES APPROPRIATION PERMIT AND STATE HEALTH DEPARTMENT APPROVAL) ☐ T TEST, OBSERVATION, MONITORING (MAY REQUIRE APPROPRIATION PERMIT)		NOT TO BE FILLED IN BY DRILLER HEALTH DEPARTMENT APPROVAL Howard A30331 COUNTY NAME COUNTY NO. STATE SIGNATURE Mark E. Riffin INSERT S 5/4/92 DATE ISSUED 43 1110991 48 CO SIGNATURE 532000 55 NORTH GRID EAST GRID 0816000 57 63 SHOW MAJOR FEATURES OF BOX & LOCATE WELL WITH AN X SOURCES OF DRILLING WATER 1. well 2. 3. WRITE THE BOX NUMBER FROM THE MAP HERE E 8106 N 5302	
APPROXIMATE DEPTH OF WELL 150 24 28 FEET APPROXIMATE DIAMETER OF WELL 6" NEAREST INCH		11/12/91 9:30 MR 65' CASING 11/12/91 50' OPEN GROUT 15 BAGS LOC OK 2' CASING A.G. OK GROUT NOT DBS'D ✓ TAG OK	
METHOD OF DRILLING (circle one) 30 BORED (or Augered) <u>JETTED</u> Jetted & DRIVEN 37 AIR-ROTARY AIR-PERCussion ROTARY (Hydraulic Rotary) CABLE REVerse-ROTary Drive-POINT other.		DRAW A SKETCH BELOW SHOWING LOCATION OF WELL IN RELATION TO NEARBY TOWNS AND ROADS AND GIVE DISTANCE FROM WELL TO NEAREST ROAD JUNCTION 	
REPLACEMENT OR DEEPEINED WELLS (CIRCLE APPROPRIATE BOX) ☒ N THIS WELL WILL NOT REPLACE AN EXISTING WELL ☐ Y THIS WELL WILL REPLACE A WELL THAT WILL BE ABANDONED AND SEALED 39 ☐ S THIS WELL WILL REPLACE A WELL THAT WILL BE USED AS A STANDBY ☐ D THIS WELL WILL DEEPEN AN EXISTING WELL PERMIT NUMBER OF WELL TO BE REPLACED OR DEEPEINED (IF AVAILABLE) 41 HO-88-1993 52		Not to be filled in by driller (OEP USE ONLY) APPROP. PERMIT NUMBER G A P 54 63 FORCE MR WRITE INITIALS IN BOX PERMIT No. HO-88-1993 70 71 72 73 74 75 76 77 78 79 SPECIAL CONDITIONS 730-4293 CONTRACT	