

9/23/80  
1:30 p.m.

9/24/80  
late this afternoon  
please

Approved 9/24/80  
Stayer

# PERMIT

P 30895

A Repair

SEWAGE DISPOSAL SYSTEM

MARYLAND STATE DEPARTMENT OF HEALTH

HOWARD COUNTY

ELLICOTT CITY

DISTRICT 5th

INDEXED

DATE 9/8/80

05-349001

Donald Parlette IS PERMITTED TO INSTALL ALTER X

ADDRESS 6575 Route 32, Clarksville, Md. 21029 PHONE 286-2140

SUBDIVISION \_\_\_\_\_ ROAD 6480 Trotter Road LOT \_\_\_\_\_

PROPERTY OWNER Louis W. Earp

ADDRESS 6480 Trotter Road, Clarksville, Md. 21029 Phone: 286-3197

SPECIFICATIONS

SEPTIC TANK CAPACITY \_\_\_\_\_ GALLONS

DRAIN FIELD \_\_\_\_\_ DEPTH \_\_\_\_\_ FEET, BOTTOM AREA \_\_\_\_\_ SQ. FT.

DEEP TRENCH  DEPTH 13 FEET, ON SIDE BOTTOM AREA 360 SQ. FT.

SEEPAGE PITS \_\_\_\_\_ ABSORBENT SIDE-WALL AREA \_\_\_\_\_ SQ. FT.

INLET PIPE \_\_\_\_\_ FT. BELOW ORIGINAL GRADE, MAXIMUM DEPTH \_\_\_\_\_ FT. BELOW ORIGINAL GRADE

EFFECTIVE DEPTH AT \_\_\_\_\_ FT. BELOW ORIGINAL GRADE.

LOCATE DISPOSAL AREA \_\_\_\_\_ FT. FROM \_\_\_\_\_ LOT LINE AND \_\_\_\_\_ FT. FROM \_\_\_\_\_ LOT LINE AS SEEN WHEN FACING LOT FROM

REPAIR - Call for an appointment when ground is opened up and Sanitarian will

recommend the repair system. DEEP DITCH 360 SQ FT SIDE WALL AREA

ONE SIDE (13 FT DEEP, 45 FT LONG, 2 FT WIDE) 8 FT STONE PUMP NEED TO DELIVER SEWAGE TO THE DITCH START THE

PLANS APPROVED BY Palmer F. Wine DATE 9/8/80

COVER NO WORK UNTIL INSPECTED AND APPROVED. DITCH 122 FT FROM THE WELL

NEITHER THE HOWARD COUNTY COUNCIL NOR THE HEALTH DEPARTMENT IS RESPONSIBLE FOR THE SUCCESSFUL OPERATION OF ANY SYSTEM. 33 FT FROM THE RIGHT SIDE

NOTE: IF TRENCH IS USED CALL FOR INSPECTION BEFORE PLACING GRAVEL IN TRENCH. OF THE LOT AS SEEN

NOTE: NO DRY WELL SHALL EXCEED 15 FOOT IN DIAMETER. WHEN FACING THE LOT FROM

NOTE: ALL PIPE FROM HOUSE TO DISPOSAL AREA MUST BE CAST IRON. TROTTER RD & RUN IT

PERMIT VOID AFTER THREE YEARS. TOWARD THE BACK OF THE LOT

NOTE: INSTALL STAND PIPE ON SEPTIC TANK AND DRY WELL. STAND PIPES MUST BE 6 INCHES IN DIAMETER. CAST IRON, CONCRETE OR TERRA COTTA ACCEPTED.

\*INSTALLER IS RESPONSIBLE FOR OBTAINING FINAL APPROVAL ON THIS PERMIT.

30895



4/4/03  
1:00

SITE INSPECTION SHEET


OWNER: Katherine Earp (deceased) <sup>son-Wesley</sup>  
 110-489 7987 DATE REQUESTED: \_\_\_\_\_

PHONE #: \_\_\_\_\_ CONTRACTOR: \_\_\_\_\_

ADDRESS: 6480 Trotter Rd WELL TAG #: \_\_\_\_\_


SON: 7362 Sanner Cl'ville 21029 COUNTY #: \_\_\_\_\_

PROPOSAL: Emerg. Inclusion in Metro District

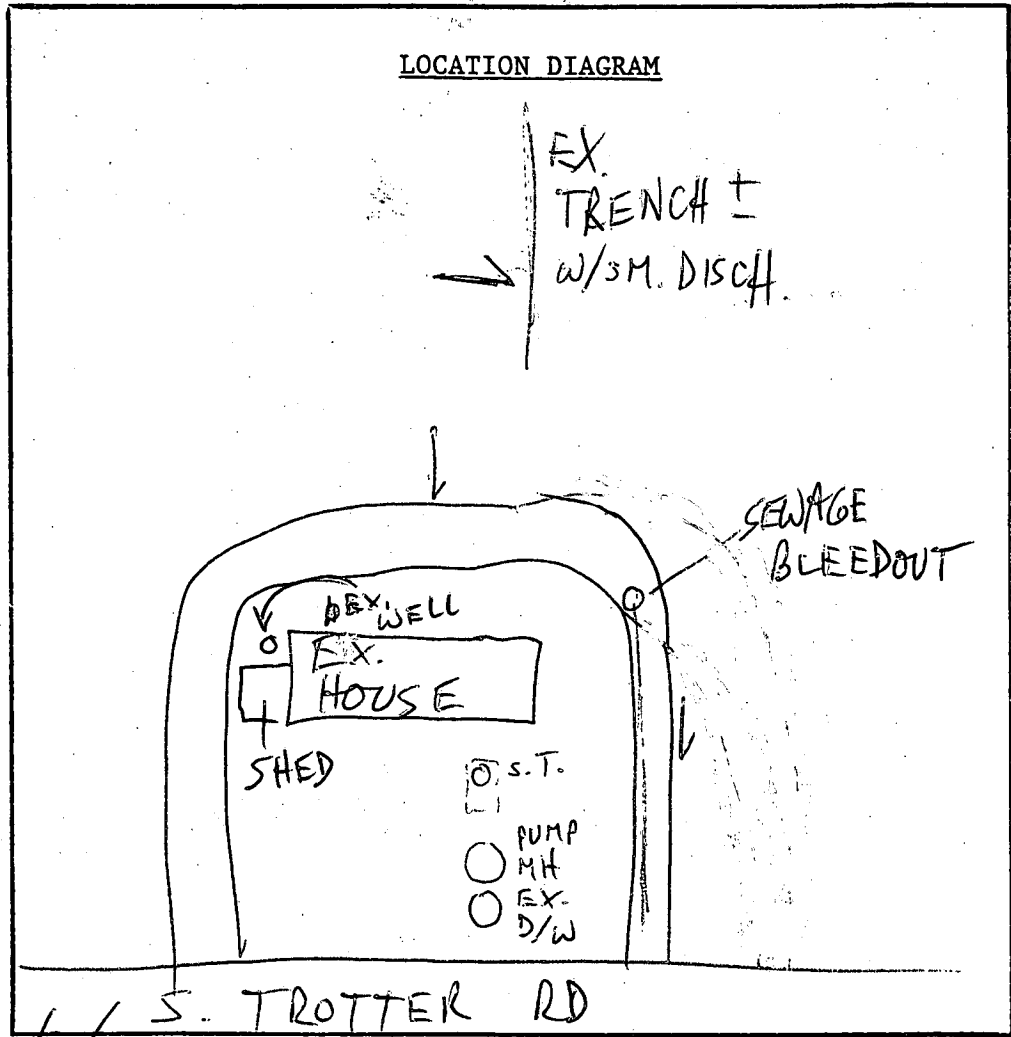

COMMENTS: 4/4/03 MET @ LATE OWNER'S SON WESLEY EARP  
@ SITE ADVISED HIM RECOMMENDATION FOR EM. INCLUSION  
WILL BE ISSUED; HE SHOULD PUMP TANK TO ABATE DISCHARGE  
ASAP (MR)

DATE: \_\_\_\_\_ INSPECTOR: \_\_\_\_\_

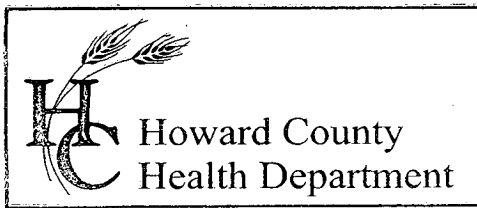

3525 H Ellicott Mills Drive, Ellicott City, MD 21043  
(410) 313-2640 Fax (410) 313-2648  
TDD (410) 313-2323 Toll Free 1-866-313-6300  
website: www.hchealth.org


---

Penny E. Borenstein, M.D., M.P.H., Health Officer

April 4, 2003

MEMORANDUM

TO: Charlotte Dryden

FROM: Mark Rifkin   
Well and Septic Program

RE: Emergency Metro District Inclusion  
6480 Trotter Road  
Map 35, Parcel 186

The Health Department recommends emergency inclusion of the referenced property into the Metropolitan District.

An inspection conducted this date revealed that the septic system, which operates via a pump, is discharging sewage down the driveway toward the road. An alternate means of sewage disposal should be provided immediately.

MR  
cc: File

~~MR~~