

PERMIT

System Final
Connection not
approved
P. 26937
A 25337

XXXXXXXXXXXXXXXXXXXX

XXXXXXXXXXXX

SEPTIC SYSTEM TO BE INSTALLED

FIRST BEFORE

HOWARD COUNTY BE SIGNED.

SEWAGE DISPOSAL SYSTEM

MARYLAND STATE DEPARTMENT OF HEALTH

ELLICOTT CITY

DISTRICT 3rd

DATE 9/26/77

INDEXED

10/3/77
4/30/77
afternoon please
03-288757

See letter
attached.

Westminster Lawn Service

IS PERMITTED TO INSTALL ☒ ALTER ☐

ADDRESS Westminster, Md.

PHONE

A SEWAGE DISPOSAL SYSTEM LOCATED AT

SUBDIVISION

11790 ROAD Triadelphia Road

LOT 1

PROPERTY OWNER

Kyle
Milburn Hopkins

MICHAEL FLANNERY
Milburn & Sheila Hopkins

ADDRESS 2535 Thompson Drive

SPECIFICATIONS 3 bedrooms

DRAIN FIELD DEPTH FEET, BOTTOM AREA SQ. FT.

SEEPAGE PITS ABSORBENT SIDE-WALL AREA SQ. FT.

SEPTIC TANK CAPACITY 1000 GALLONS

BLDG. PERMIT SIGNED
AND RETURNED 10/4/77

Serial No. 33396

FOR GARBAGE GRINDER, INCREASE DISPOSAL AREA 22% & TANK CAPACITY 50%.

OTHER DRY WELL-To have 140 sq. ft. effective absorbent sidewall area per bedroom below first 5 ft. of original soil. Inlet in at 4 ft. and maximum depth 12 ft. Locate the dry well 15 ft. from front property line and 95 ft. from left property line when facing lot from road. (Perc hole 1 & 2) If dry well & trench used need: 5 ft. earth rubber between trench and dry well, and 2 inspections are needed before and after gravel is installed.

NOTE: ALL PIPE FROM HOUSE TO DISPOSAL AREA MUST BE CAST IRON. PERMIT VOID AFTER 3 YEARS.

NOTE: INSTALL STAND PIPES ON SEPTIC TANK AND DRY WELL. STAND PIPES MUST BE 6 INCHES IN DIAMETER. CAST IRON, CONCRETE OR TERRA COTTA ACCEPTED.

PLANS APPROVED BY Charles B. Streaker DATE 9/19/77

FILL SEPTIC TANK AND DISTRIBUTION BOX WITH WATER BEFORE CALLING FOR AN INSPECTION. COVER NO WORK UNTIL INSPECTED AND APPROVED.

NEITHER THE HOWARD COUNTY COMMISSIONERS NOR THE HEALTH DEPARTMENT IS RESPONSIBLE FOR THE SUCCESSFUL OPERATION OF ANY SYSTEM.

Addition - Swimming Pool
BLDG. PERMIT SIGNED
AND RETURNED 6-18-96
Serial # B00100499

BLDG. PERMIT SIGNED
AND RETURNED 7/13/89
Serial # 27946
addition - 1st story

A 25337

C 1	2202	SEQUENCE NO. (WRA USE ONLY)
1 2 3 (SEQ. NO.) 6		
(THIS NUMBER IS TO BE PUNCHED IN COLUMNS 3-6 ON ALL CARDS)		

STATE OF MARYLAND
WATER RESOURCES ADMINISTRATION
TAWES STATE OFFICE BLDG., ANNAPOLIS, MD. 21401
WELL COMPLETION REPORT

THIS REPORT MUST BE SUBMITTED WITHIN 30 DAYS AFTER WELL COMPLETION

FILL IN THIS FORM COMPLETELY

COUNTY
NUMBER **W26801**

DATE RECEIVED (WRA USE ONLY)	Sept 14, 1977 DATE WELL COMPLETED	DEPTH OF WELL 105' 22 (TO NEAREST FOOT) 26	PERMIT NO. FROM "PERMIT TO DRILL WELL" HO-73-2297 28 29 30 31 32 33 34 35 36 37
8-13	15 20	DRILLERS IDENTIFICATION NO. 290	

OWNER LAST NAME Hopkins FIRST NAME High	STREET OR RFD 2325 Thomson Drive POST OFFICE Marriottsville, MD
--	---

WELL LOG STATE THE KIND OF FORMATIONS PENETRATED, THEIR COLOR, DEPTH, THICKNESS AND IF WATER BEARING <table border="1"> <thead> <tr> <th rowspan="2">DESCRIPTION (USE ADDITIONAL SHEETS IF NECESSARY)</th> <th colspan="2">FEET</th> <th rowspan="2">CHECK IF WATER BEARING</th> </tr> <tr> <th>FROM</th> <th>TO</th> </tr> </thead> <tbody> <tr> <td>Over Burden</td> <td>0</td> <td>30'</td> <td></td> </tr> <tr> <td>Hard grey rock</td> <td>30'</td> <td>105'</td> <td></td> </tr> </tbody> </table>		DESCRIPTION (USE ADDITIONAL SHEETS IF NECESSARY)	FEET		CHECK IF WATER BEARING	FROM	TO	Over Burden	0	30'		Hard grey rock	30'	105'		GROUTING RECORD WELL HAS BEEN GROUTED (CIRCLE APPROPRIATE BOX) ☒ Y ☐ N TYPE OF GROUTING MATERIAL (CIRCLE BOX) CEMENT ☒ C ☐ M BENTONITE CLAY ☐ B ☐ C NO. OF BAGS 7 NO. OF POUNDS 658 GALLONS OF WATER 42 DEPTH OF GROUT SEAL (TO NEAREST FOOT) FROM 0 FT. TO 30' FT. (ENTER 0 IF FROM SURFACE)		<table border="1"> <tr> <td>C 3</td> <td>1 2 3 (SEQ. NO.) 6</td> </tr> <tr> <td colspan="2">PUMPING TEST</td> </tr> <tr> <td>HOURS PUMPED (TO NEAREST HOUR)</td> <td>6</td> </tr> <tr> <td>PUMPING RATE (GALLONS PER MINUTE TO NEAREST GALLON)</td> <td>5</td> </tr> <tr> <td>METHOD USED TO MEASURE PUMPING RATE</td> <td>1 gal. bucket</td> </tr> <tr> <td colspan="2">WATER LEVEL: (DISTANCE FROM LAND SURFACE)</td> </tr> <tr> <td>BEFORE PUMPING</td> <td>35' (NEAREST FOOT)</td> </tr> <tr> <td>WHEN PUMPING</td> <td>60' (NEAREST FOOT)</td> </tr> <tr> <td colspan="2">TYPE OF PUMPED USED (CIRCLE APPROPRIATE BOX) (FOR PUMPING TEST)</td> </tr> <tr> <td>☐ A AIR</td> <td>☐ P PISTON</td> </tr> <tr> <td>☐ C CENTRIFUGAL</td> <td>☐ R ROTARY</td> </tr> <tr> <td>☐ J JET</td> <td>☐ S SUBMERSIBLE</td> </tr> </table>	C 3	1 2 3 (SEQ. NO.) 6	PUMPING TEST		HOURS PUMPED (TO NEAREST HOUR)	6	PUMPING RATE (GALLONS PER MINUTE TO NEAREST GALLON)	5	METHOD USED TO MEASURE PUMPING RATE	1 gal. bucket	WATER LEVEL: (DISTANCE FROM LAND SURFACE)		BEFORE PUMPING	35' (NEAREST FOOT)	WHEN PUMPING	60' (NEAREST FOOT)	TYPE OF PUMPED USED (CIRCLE APPROPRIATE BOX) (FOR PUMPING TEST)		☐ A AIR	☐ P PISTON	☐ C CENTRIFUGAL	☐ R ROTARY	☐ J JET	☐ S SUBMERSIBLE
DESCRIPTION (USE ADDITIONAL SHEETS IF NECESSARY)	FEET		CHECK IF WATER BEARING																																							
	FROM	TO																																								
Over Burden	0	30'																																								
Hard grey rock	30'	105'																																								
C 3	1 2 3 (SEQ. NO.) 6																																									
PUMPING TEST																																										
HOURS PUMPED (TO NEAREST HOUR)	6																																									
PUMPING RATE (GALLONS PER MINUTE TO NEAREST GALLON)	5																																									
METHOD USED TO MEASURE PUMPING RATE	1 gal. bucket																																									
WATER LEVEL: (DISTANCE FROM LAND SURFACE)																																										
BEFORE PUMPING	35' (NEAREST FOOT)																																									
WHEN PUMPING	60' (NEAREST FOOT)																																									
TYPE OF PUMPED USED (CIRCLE APPROPRIATE BOX) (FOR PUMPING TEST)																																										
☐ A AIR	☐ P PISTON																																									
☐ C CENTRIFUGAL	☐ R ROTARY																																									
☐ J JET	☐ S SUBMERSIBLE																																									
CASING RECORD INSERT APPROPRIATE CODE BELOW <table border="1"> <tr> <td>☒ S STEEL</td> <td>☐ C CONCRETE</td> </tr> <tr> <td>☐ P PLASTIC</td> <td>☐ O OTHER</td> </tr> </table> MAIN CASING TYPE ☒ S ☐ T NOMINAL DIAMETER TOP (MAIN) CASING (NEAREST INCH) 6" TOTAL DEPTH OF MAIN CASING (NEAREST FOOT) 32'		☒ S STEEL	☐ C CONCRETE	☐ P PLASTIC	☐ O OTHER	PUMP INSTALLED TYPE OF PUMP (WRITE APPROPRIATE LETTER IN BOX - SEE ABOVE: A, C, J, P, R, S, T, O) 29 DRILLER WILL INSTALL PUMP (CIRCLE APPROPRIATE BOX) ☒ Y ☐ N CAPACITY: GALLONS PER MINUTE (TO NEAREST GALLON) 31 35 PUMP HORSE POWER 37 41 PUMP COLUMN LENGTH (NEAREST FOOT) 43 47																																				
☒ S STEEL	☐ C CONCRETE																																									
☐ P PLASTIC	☐ O OTHER																																									
OTHER CASING (IF USED) DIAMETER (INCH) FROM TO <table border="1"> <tr> <td></td> <td></td> <td></td> <td></td> </tr> <tr> <td></td> <td></td> <td></td> <td></td> </tr> </table>										SCREEN RECORD INSERT APPROPRIATE CODE BELOW <table border="1"> <tr> <td>☒ S STEEL</td> <td>☐ B BRASS OR BRONZE</td> <td>☐ H OPEN HOLE</td> </tr> <tr> <td>☐ P PLASTIC</td> <td>☐ O OTHER</td> <td></td> </tr> </table>		☒ S STEEL	☐ B BRASS OR BRONZE	☐ H OPEN HOLE	☐ P PLASTIC	☐ O OTHER																										
☒ S STEEL	☐ B BRASS OR BRONZE	☐ H OPEN HOLE																																								
☐ P PLASTIC	☐ O OTHER																																									
<table border="1"> <tr> <td>C 2</td> <td>1 2 3 (SEQ. NO.) 6</td> </tr> <tr> <td colspan="2">DEPTH (NEAREST WHOLE FOOT)</td> </tr> <tr> <td>FROM 30'</td> <td>TO 105'</td> </tr> <tr> <td>1 H O</td> <td>8 9 11 15 17 21</td> </tr> <tr> <td>2</td> <td>23 24 26 30 32 36</td> </tr> <tr> <td>3</td> <td>38 39 41 45 47 51</td> </tr> <tr> <td colspan="2">SLOT SIZE 1, 2, 3, _____</td> </tr> </table>		C 2	1 2 3 (SEQ. NO.) 6	DEPTH (NEAREST WHOLE FOOT)		FROM 30'	TO 105'	1 H O	8 9 11 15 17 21	2	23 24 26 30 32 36	3	38 39 41 45 47 51	SLOT SIZE 1, 2, 3, _____		CASING HEIGHT (CIRCLE APPROPRIATE BOX AND ENTER CASING HEIGHT) <table border="1"> <tr> <td>☒ + ABOVE</td> <td rowspan="2">LAND SURFACE</td> <td rowspan="2">2' (NEAREST FOOT)</td> </tr> <tr> <td>☐ - BELOW</td> </tr> </table>		☒ + ABOVE	LAND SURFACE	2' (NEAREST FOOT)	☐ - BELOW																					
C 2	1 2 3 (SEQ. NO.) 6																																									
DEPTH (NEAREST WHOLE FOOT)																																										
FROM 30'	TO 105'																																									
1 H O	8 9 11 15 17 21																																									
2	23 24 26 30 32 36																																									
3	38 39 41 45 47 51																																									
SLOT SIZE 1, 2, 3, _____																																										
☒ + ABOVE	LAND SURFACE	2' (NEAREST FOOT)																																								
☐ - BELOW																																										
CIRCLE APPROPRIATE BOXES ☐ A A WELL WAS ABANDONED AND SEALED WHEN THIS WELL WAS COMPLETED ☐ E ELECTRIC LOG OBTAINED ☐ P TEST WELL CONVERTED TO PRODUCTION WELL I HEREBY CERTIFY THAT I HAVE COMPLIED WITH ALL CONDITIONS STATED ON THE ABOVE-CAPTIONED "PERMIT TO DRILL WELL", AND THAT INFORMATION CONTAINED IN THIS REPORT IS TRUE, ACCURATE, AND COMPLETE TO THE BEST OF MY KNOWLEDGE, INFORMATION AND BELIEF. DRILLERS NAME (PLEASE PRINT) C.C. Campbell & Co., Inc SIGNATURE Charles P. Campbell		LOCATION OF WELL ON LOT SHOW PERMANENT STRUCTURE SUCH AS BUILDINGS, SEPTIC TANKS, AND/OR OTHER LAND MARKS AND INDICATE NOT LESS THAN TWO DISTANCES (MEASUREMENTS TO WELL). 																																								
WRA USE ONLY (NOT TO BE FILLED IN BY DRILLER) T ☐ (E.R.O.S.) ☐ W ☐ Q ☐ 70 72 74 75 76 TELESCOPE CASING LOG INDICATOR OTHER DATA AVAILABLE																																										

STATE OF MARYLAND WATER RESOURCES ADMINISTRATION		WRA PERMIT NUMBER 140-73-2291
TAWES STATE OFFICE BLDG., ANNAPOLIS, MARYLAND 21401 APPLICATION FOR PERMIT TO DRILL WELL		FILL IN THIS FORM COMPLETELY
DATE RECEIVED (WRA USE ONLY) 9/13/77 2:00 P.M. OWNER Hopkins Hugh COL 15 LAST NAME FIRST NAME COL. 34 STREET OR RFD 2325 Thomson Drive COL 36 COL. 55 POST OFFICE Marriottsville, MD 21104 COL 57 COL. 76 A25337		
B 1 CONTINUED DRILLER INFORMATION		B 3 LOCATION OF WELL
1 2 3 (SEQ. NO.) 6 DATE Aug. 23, 1977 LICENSE NUMBER 290 77 80 C. C. Campbell & Co., Inc. FIRST NAME DRILLER LAST NAME SIGNATURE Charles C. Campbell		1 2 3 (SEQ. NO.) 6 COUNTY Howard 8 (DO NOT ABBREVIATE COUNTY NAME) 21 SUBDIVISION 23 42 SECTION 44 46 LOT 1 50 NEAREST TOWN Mayfield 71 MILES FROM TOWN (ENTER 0 IF IN TOWN) 1/2 73 76 77 78
B 2 WELL INFORMATION		B 4 DIRECTION FROM TOWN
1 2 3 (SEQ. NO.) 6 MAXIMUM PUMPING RATE (GALLONS PER MINUTE) 5 8 12 AVERAGE DAILY QUANTITY NEEDED (GALLONS PER DAY) 500 14 20 USE FOR WATER (CIRCLE APPROPRIATE BOX) ☒ D HOME (SINGLE OR DOUBLE HOUSEHOLD UNIT ONLY) ☐ F FARMING, AGRICULTURE, IRRIGATION ☐ I INDUSTRIAL, COMMERCIAL, STATE AND FEDERAL GOVERNMENT. ☐ M MUNICIPAL WATER SUPPLY } MUST HAVE STATE HEALTH DEPT. APPROVAL ☐ P PRIVATE WATER COMPANY ☐ T TEST		1 2 3 (SEQ. NO.) 6 ☒ N NORTH ☐ E EAST ☐ NE NORTHEAST ☐ SE SOUTHEAST ☒ S SOUTH ☐ W WEST ☐ NW NORTHWEST ☐ SW SOUTHWEST NEAR WHAT Tridelpia Road ON WHICH SIDE OF ROAD (CIRCLE APPROPRIATE BOX) ☐ N ☐ S ☒ E ☐ W DISTANCE FROM ROAD (ENTER DISTANCE AND CIRCLE APPROPRIATE BOX) 30' 34 37 38 39
APPROXIMATE DEPTH OF WELL 200' 24 28 FEET APPROXIMATE DIAMETER OF WELL 6" (NEAREST INCH) METHOD OF DRILLING USED (CIRCLE APPROPRIATE METHOD) BORED (OR AUGERED) JETTED DRIVEN 30-37 AIR-ROTARY AIR-PERCUSSION ROTARY (HYDRAULIC ROTARY) CABLE REVERSE-ROTARY DRIVE-POINT OTHER (DESCRIBE) _____ REPLACEMENT OR DEEPEINED WELLS (CIRCLE APPROPRIATE BOX) ☒ N THIS WELL WILL NOT REPLACE AN EXISTING WELL ☐ Y THIS WELL WILL REPLACE A WELL THAT WILL BE ABANDONED AND SEALED ☐ S THIS WELL WILL REPLACE A WELL THAT WILL BE USED AS A STANDBY ☐ D THIS WELL WILL DEEPEIN AN EXISTING WELL PERMIT NUMBER OF WELL TO BE REPLACED OR DEEPEINED (IF AVAILABLE) _____ 41 52		DRAW A SKETCH BELOW SHOWING LOCATION OF WELL IN RELATION TO NEARBY TOWNS, ROADS AND STREAMS WITH NORTH IN THE DIRECTION OF THE ARROW, AND GIVE DISTANCE FROM WELL TO NEAREST ROAD JUNCTION OR STREAM CROSSING SHOWN ON THE SKETCH. ALSO SHOW, BY MEANS OF AN "X", THE WELL LOCATION IN THE BOX BELOW AND THE BOX NUMBER FROM THE WELL LOCATION MAP. N ↑ 9/13/77 31' casing 26 1/2' open hole, 18" above grade ~30' of grout pipe put down 7 bags cement. OK. WWZ Note: Well located 10' off left lot line 15' fr edge of road.
NOT TO BE FILLED IN BY DRILLER (WRA USE ONLY) APPROPRIATION PERMIT NUMBER 54 63 65 ENGINEER REVIEW DISTRICT NO. _____ FORCE 67 68 WRITE INITIALS IN BOX CONDITIONS 70 71 72 73 74 75 76 77 78 79		BOX NUMBER E 820 N 530 NORTH COORDINATE 50 51 52 53 54 55 EAST COORDINATE 57 58 59 60 61 62 63 ELEVATION AT WELL HEAD (FEET) 65 66 67 68 0/0 5/0
B 4 CONTINUED HEALTH DEPARTMENT APPROVAL		
1 2 3 (SEQ. NO.) 6 41 S STATE HEALTH (CIRCLE BOX) Howard N26801 MO. DAY YR. 08 24 77 DATE 08 24 77 43 48 Donald W. Monaghan, Sanitarian APPROVED BY		
B 5 SPECIAL CONDITIONS 8-63 (WRA USE ONLY)		
1 2 3 (SEQ. NO.) 6		

APPLICATION

A 25337

SEWAGE DISPOSAL TESTING

P _____

STATE OF MARYLAND - DEPARTMENT OF HEALTH AND MENTAL HYGIENE

HOWARD COUNTY HEALTH DEPARTMENT
ENVIRONMENTAL HEALTH SERVICES

P. O. BOX 476, ELLICOTT CITY, MARYLAND 21043
TELEPHONE: 465-5000, EXT. 356

1-3 Bedrooms 1000 gallons
DISTRICT

DATE 3/2/77

Septic Tank { 4 Bedrooms 1250 gallons

5/12/77

1:30 p.m.

dry well to have 140 sq ft effective
absorbant sidewall area per bedroom below first
5' of original soil. Under in at 4' and maximum
depth 12'. Location 15' from front property line
and 95' from left property line when facing
lot from road per pole (+2)

* dry well + trench used
need:

① 5' earth buffer between
trench and dry well

② 2 inspections of trench
before and after ground
installation.

328-2506
New lot 1

TO: THE COUNTY HEALTH OFFICER
ELLICOTT CITY, MARYLAND

I, HEREBY, APPLY FOR THE NECESSARY TEST IN ORDER TO CONSTRUCT (OR RECONSTRUCT) A SEWAGE
DISPOSAL SYSTEM.

PROPERTY OWNER MILBORN HOPKINS

ADDRESS 2535 THOMPSON DRIVE

PHONE 328-2764

PROPERTY LOCATION:

SUBDIVISION ✓ LOT NO. 6A

ROAD AND DESCRIPTION TRIDELPHIA RD. & Route 144 farthest from
Rt 144

SIZE OF LOT ✓ 3.294 ACRES

TYPE BLDG. ✓ 3

NUMBER OF BEDROOMS

IF NOT SINGLE RESIDENCE DESCRIBE SINGLE RESIDENCE

THE SYSTEM INSTALLED UNDER THIS APPLICATION IS ACCEPTABLE ONLY UNTIL PUBLIC
FACILITIES BECOME AVAILABLE.

SIGNATURE OF APPLICANT Dominic J. Ianninelli

APPROVED BY C. B. Streater FOR dry well + 10' DATE 9/19/77
(KIND OF SYSTEM)


REJECTED BY _____ FOR _____ DATE _____
(KIND OF SYSTEM)

HOLD PENDING FURTHER TESTS C. B. Streater DATE 4/13/77

REASONS FOR REJECTION OR HOLDING 4/15/77 No holes dug at first. Digges
and bays uncertain. (B) of 1/2 High grass - hold
for certified holes only further test
Water problem to hear of lot

Tested in
5/12/77 different
Hold for
certified holes. C.B.S.

THIS IS NOT A PERMIT

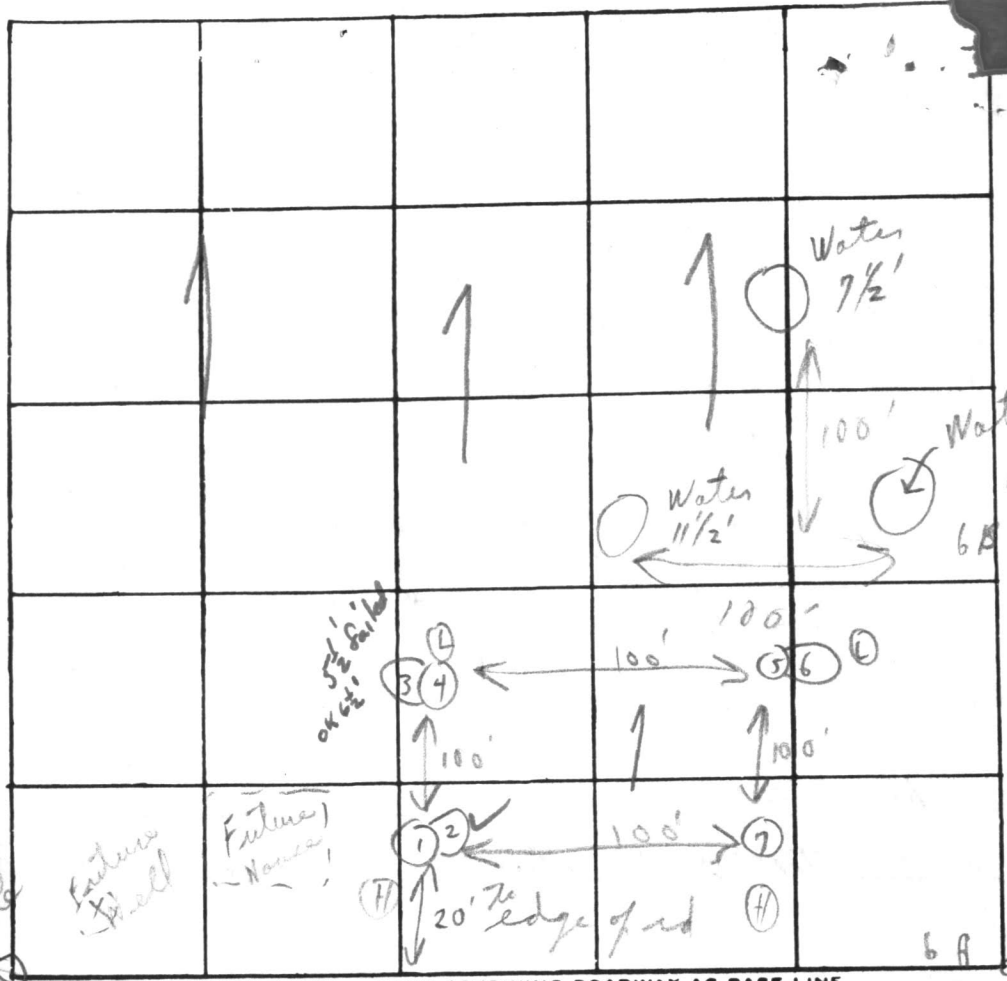

INDICATE NORTH. - NAME ADJOINING ROADWAY AS BASE LINE

90'

Tunadaphen Rd

DATE	TEST NO.	DEPTH	PRE-WET START	PRE-WET STOP	TEST - 1" DROP START	TEST - 1" DROP STOP	TIME
4/15/77	1	5'	4:42	4:46	4:46	5:04	18m
5/12/77	(H) 2	13'	4:42	4:45	4:45	4:50	5m
	(3)	5 1/2'	4:03	lowered peg:			
	(4)	13'	4:32	4:36	4:36	4:48	12
	(E) A	4 1/2'	3:44	lowered shelf:			
	(6)	12'	Water	stayed at 12'	no using		
	(H) 7	12'	Visual	similar to 1 & 2			
	5 B	5' 5 1/2'	4:05	4:08	4:08	4:18	10m
	3	6 1/2'	4:32	4:36	4:36	4:51	15m
							50

REMARKS

TYPE OF SOIL

TESTED BY

High grass

farthest from Rd 144

4/15 No test

5/12/77 No holes dug at time of record

C. B. A

ALSO PRESENT:

4/15 Larry Dabbs

Mr. & Tammiselle

5/12 and new digger

Plus Hopkins

Soil Profile
Sandy
brown
below
log

only 4"
road soil
5'


out

10m


DATA:

EX. ZONING = R-40


REFERENCES = TAX MAP NO. 16,
LOT NO. 6, PARCEL 302
LIBER 660, FOLIO 115

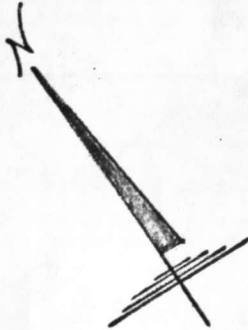

0.170 AC. DEDICATED
TO HOWARD CO. FOR THE
PURPOSE OF PUBLIC ROAD
WIDENING

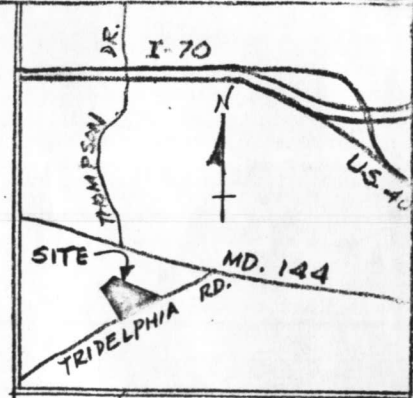

VICINITY MAP
SCALE: NONE

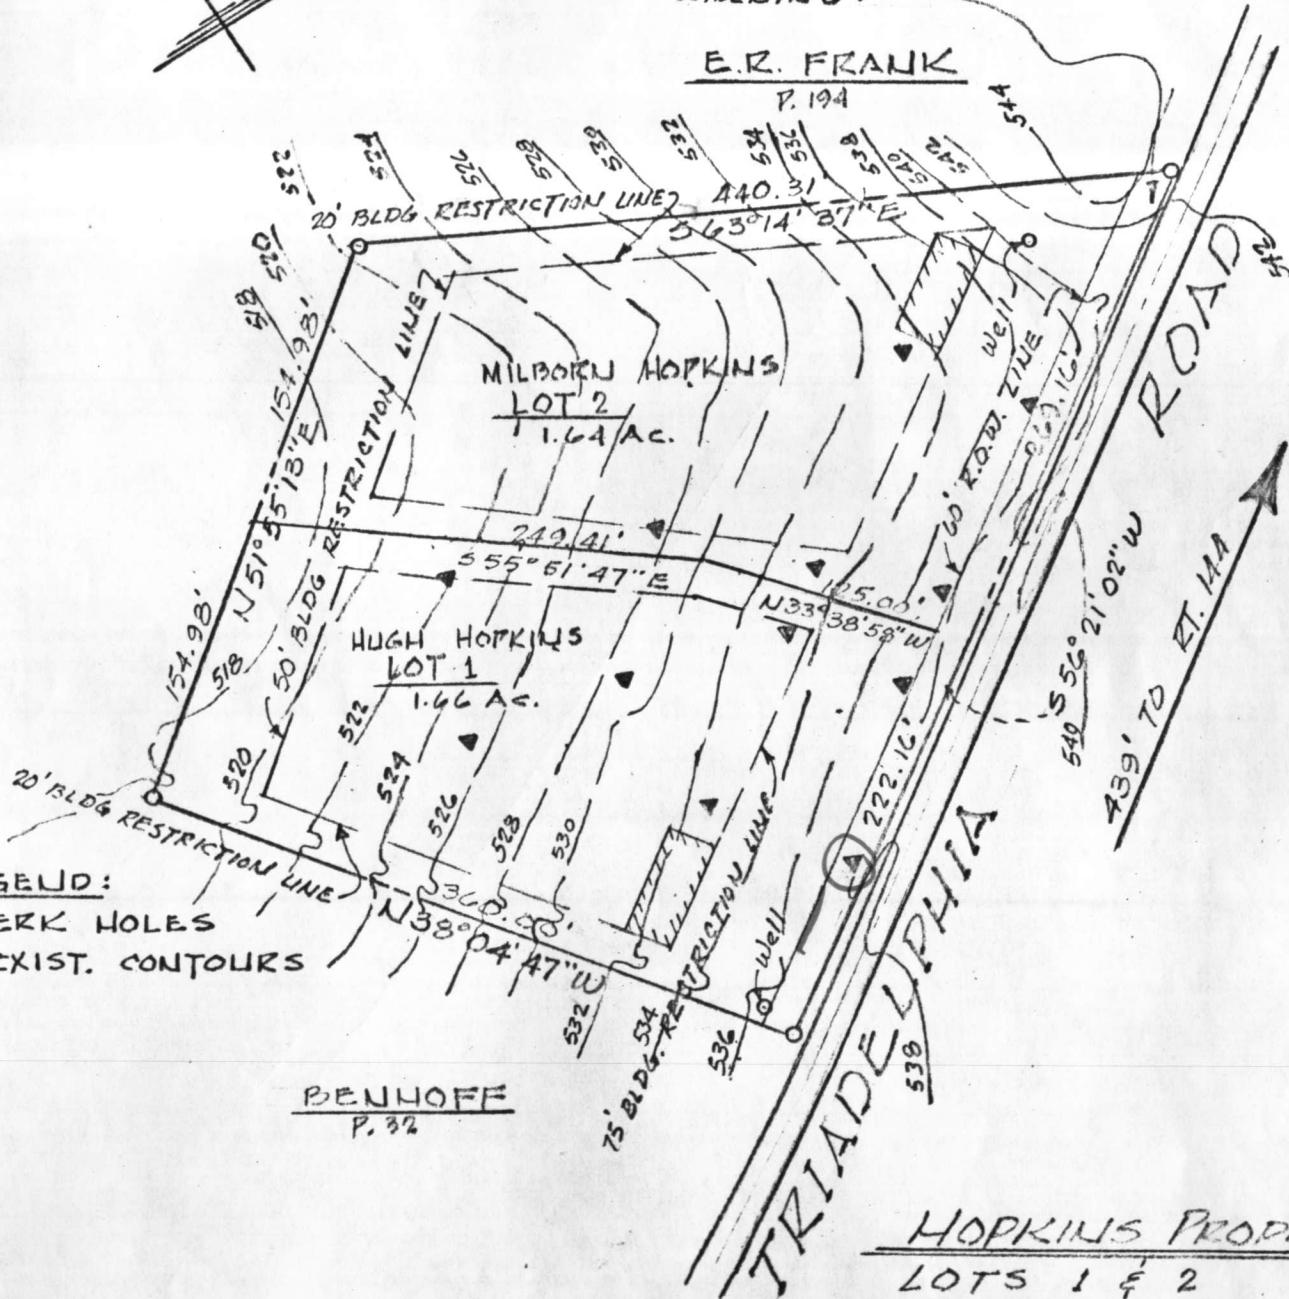

LEGEND:

▲ PERK HOLES

— EXIST. CONTOURS


Sheet 17

EASTERN DEVELOPMENT
1830 YORK ROAD
TIMONIUM, MD. 21093

HOPKINS PROPERTY

LOTS 1 & 2
HOWARD CO. MARYLAND
3RD ELECTION DISTRICT
JUNE 2, 1977
SCALE: 1"=100'

0.170 Ac.
Dedicated to
for the purpo
Public Road

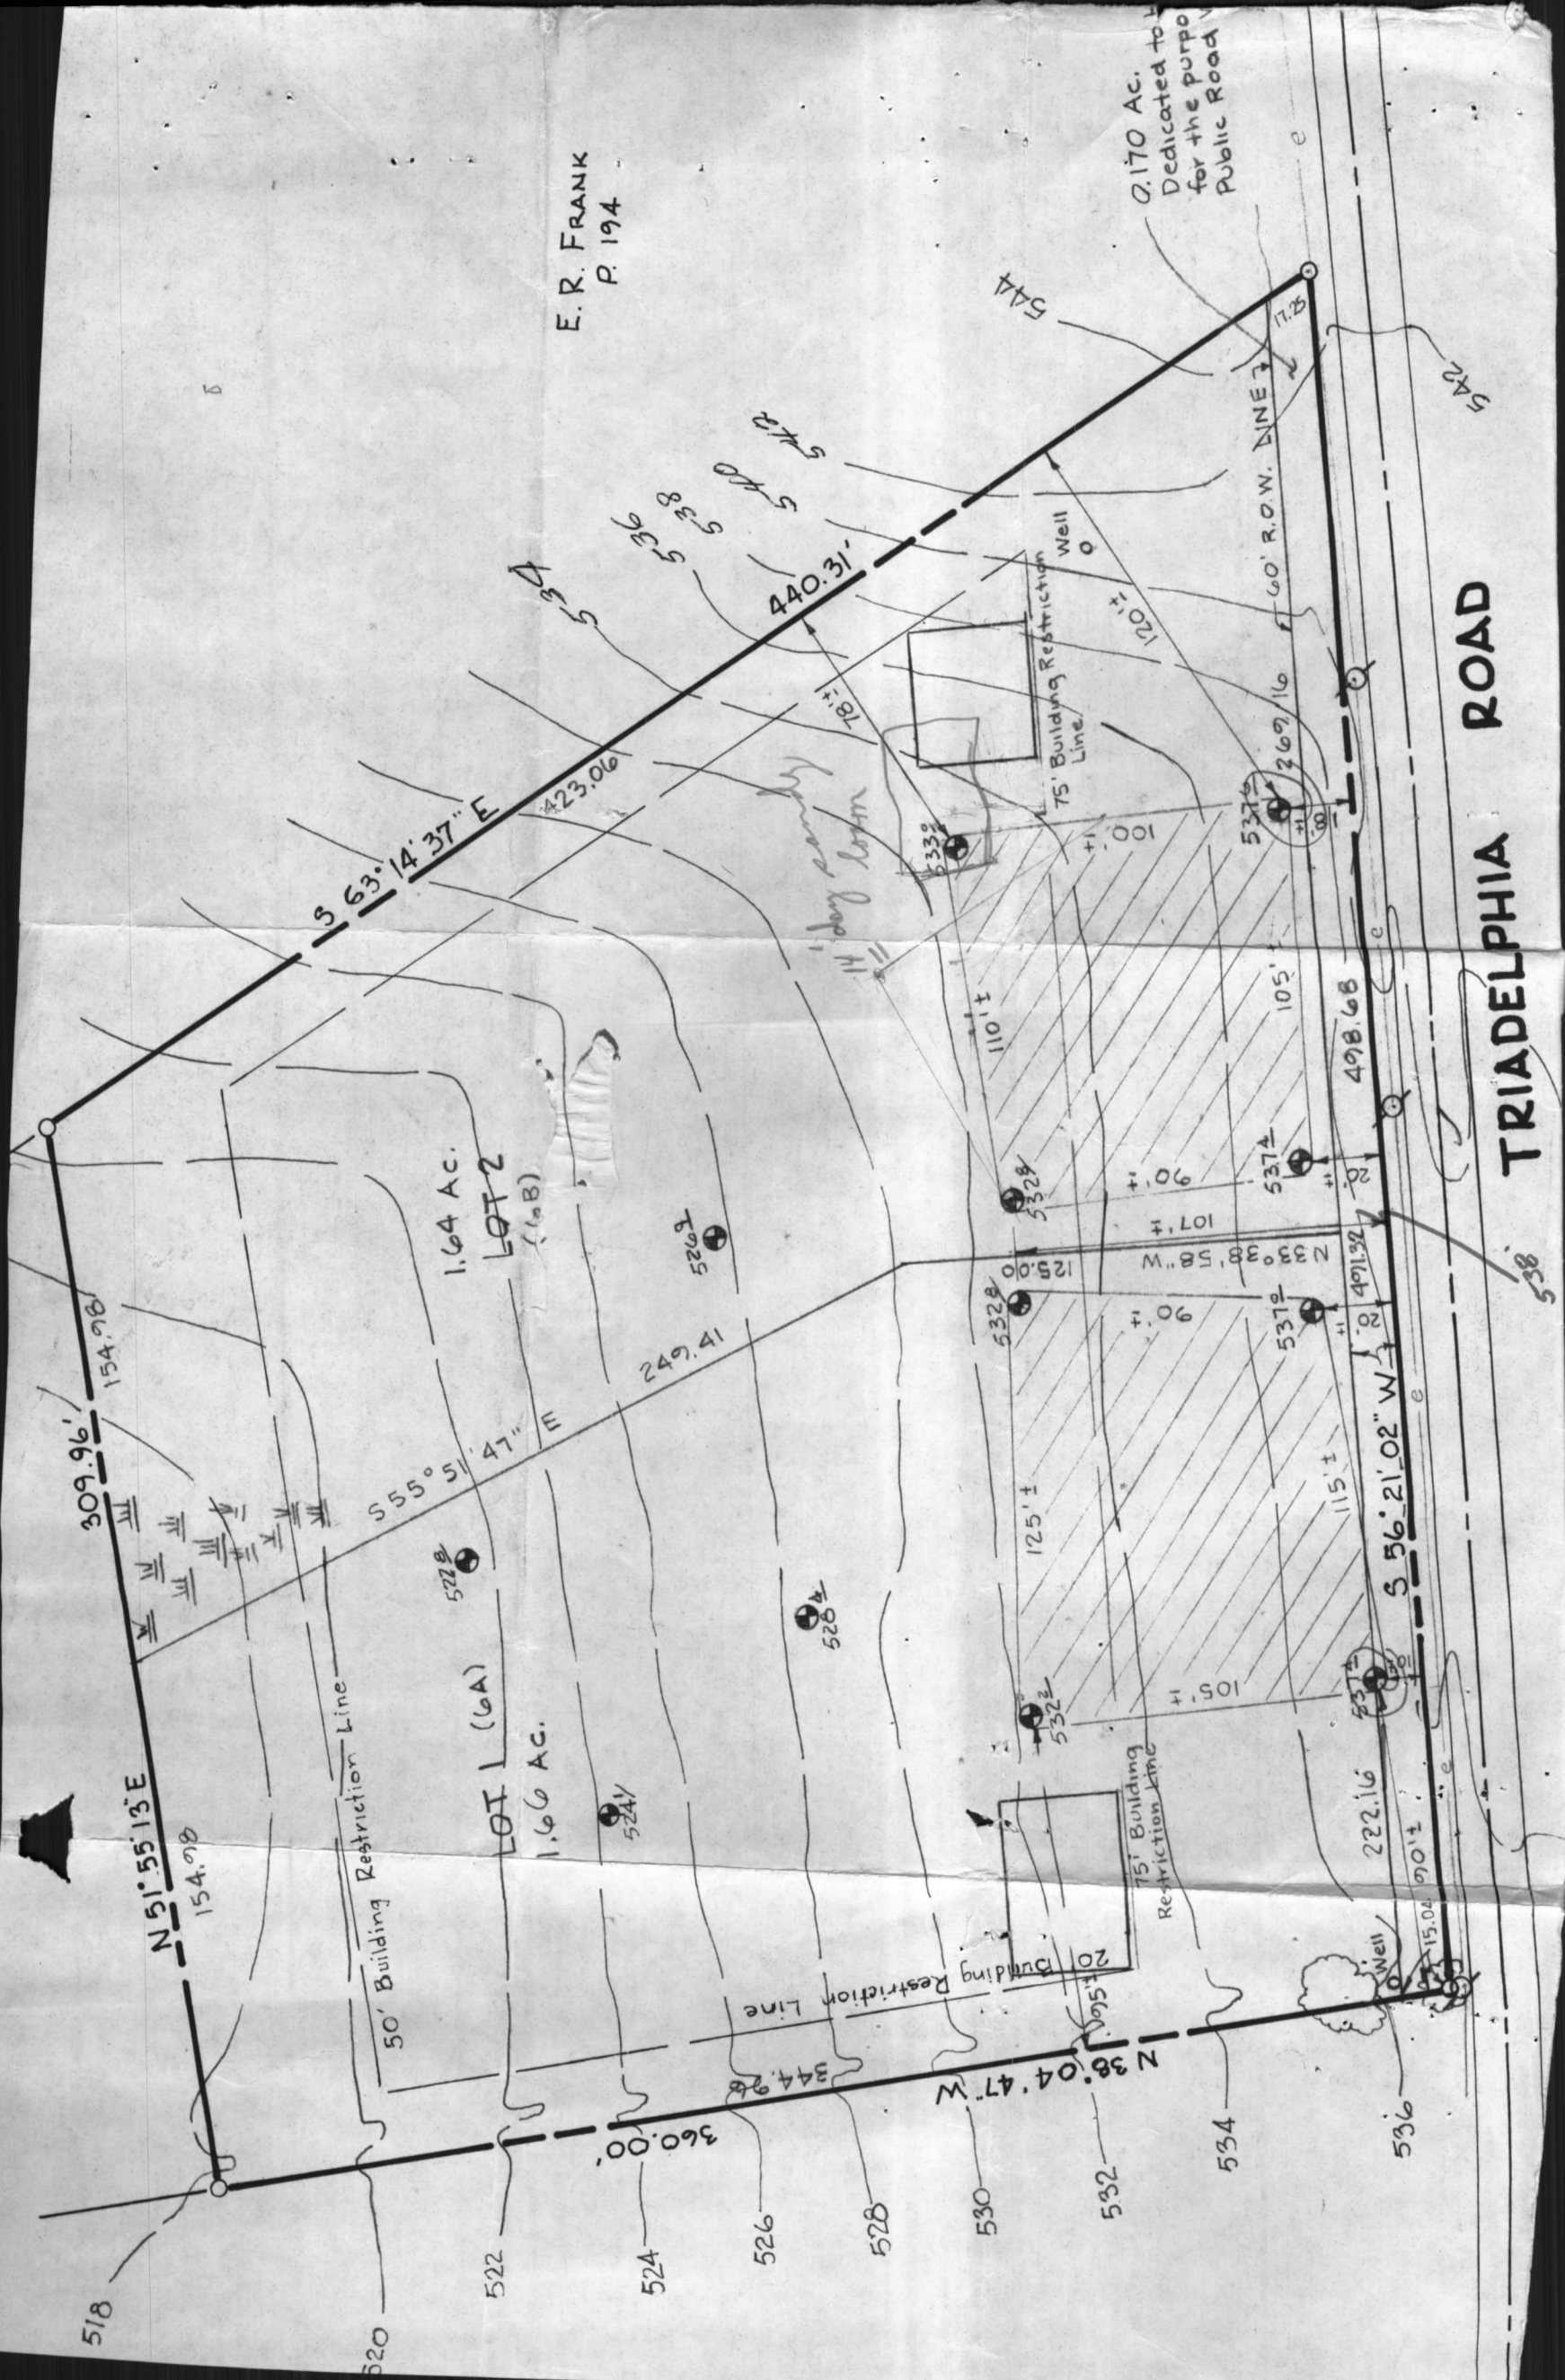

Note: Sheds(2) and Garage Removed
 Zone C on Flood Map of Howard County
 Parcel 16 of 45, Community Panel 2400440016B
 Effective Dec 4, 1986

B00148481

6/18/04

location of Pole Barn
 OK. (KJB)



Tridelfphia Road

Rev. Michael and Darlene Flannery
 11790 Tridelfphia Road
 Ellicott City, MD

Scale 1"=40'

SITE INSPECTION SHEET

OWNER: Mr. & Mrs. Flannery

PHONE #:

ADDRESS: 11790 Philadelphia Rd

CONTRACTOR:


WELL TAG #:

SUBDIVISION: _____ LOT: /

COUNTY #:

PROPOSAL: 2 stalls, tack room

LOCATION DIAGRAM

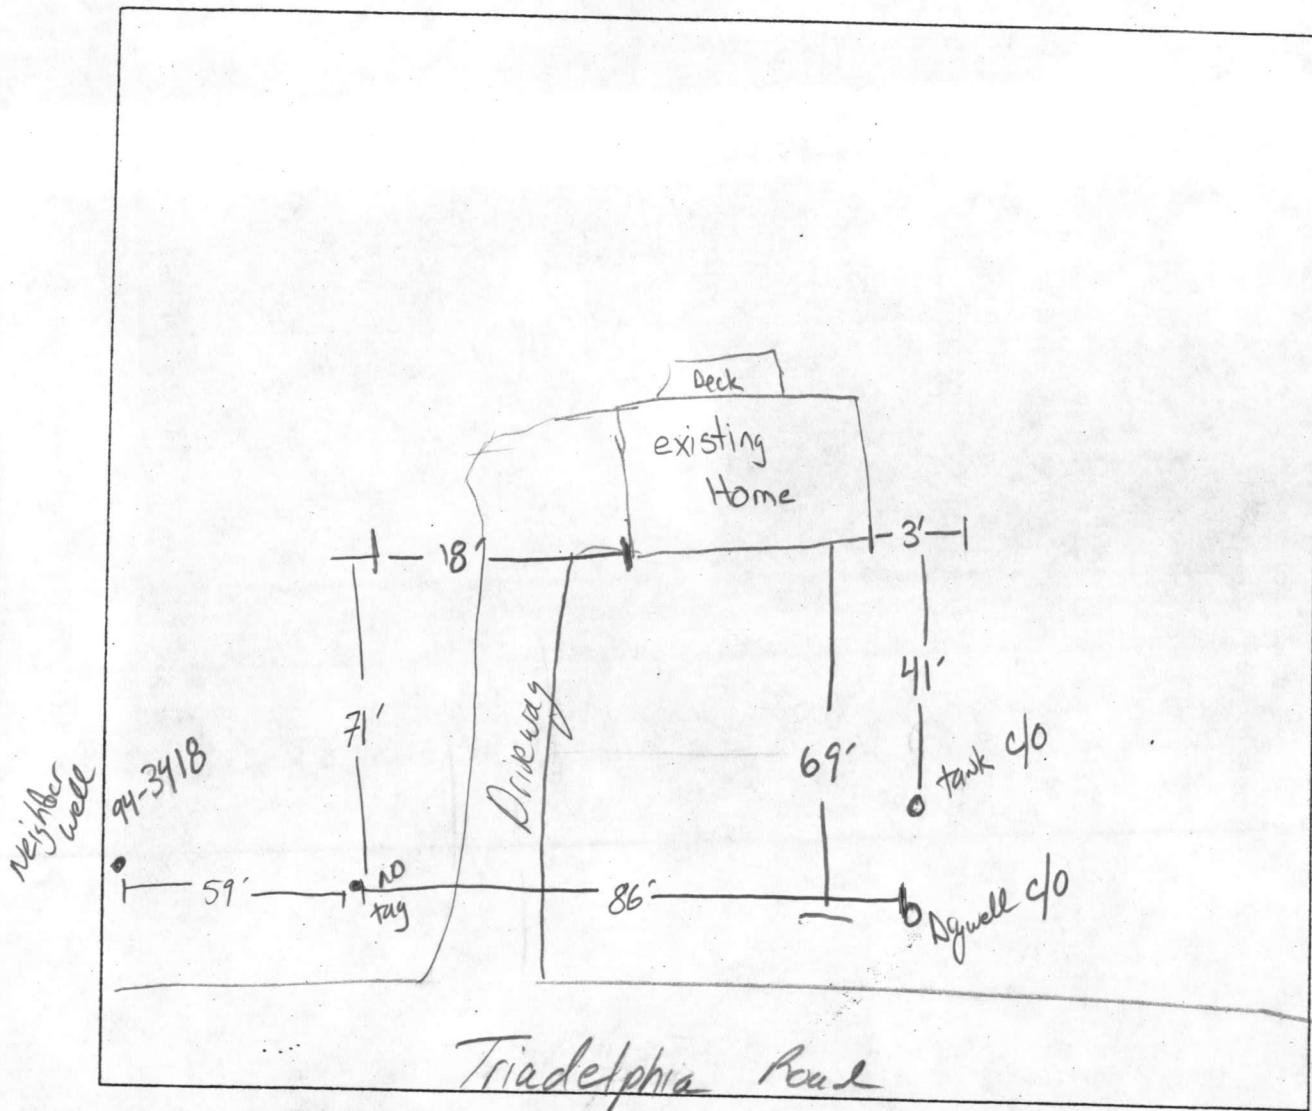


COMMENTS:

DATE: 6/8/04

INSPECTOR:

The map shows a network of roads. Highway 130 runs vertically on the left. Highway 144 runs diagonally from the top right towards the bottom center. Thompson Drive runs horizontally across the middle. A north arrow is located in the upper right quadrant. A square labeled 'SITE' is positioned on Thompson Drive, just south of its intersection with Highway 144.

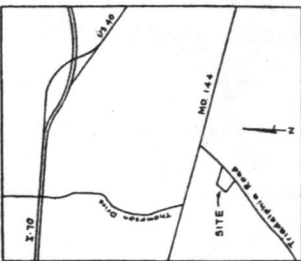


COORDINATE SCHEDULE		
No.	North	East
1	525.45	976.05
2	537.30	968.77
3	606.89	756.01
4	1000.00	1000.00
5	609.54	1377.76
6	601.77	1393.16

Received for Transfer
-S COUNTY

HOWARD CO.
G. R. Baker
Transfer Clerk

OWNER:
Hugh F. and Martha F. Hopkins
2325 Thompson Drive
Marriottsville, Md. 21104

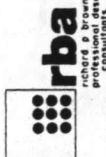

HOPKINS PROPERTY

Tax Map 16
 Sheet 1 of 1
 Third Election District, Howard County, Md.
 Date: 6-10-77
 Scale: 1" = 50'

MSA SSU 1247-1182# 4195

2. Perce Holes. Field located.

Private Sewer Easement of approx. 10,000 sq. ft. as req'd. by the Md. State Dept. of Health for individual sewage disposal. Improvement of any nature in this area are restricted until public sewer is available and serving any residential structure constructed on this building lot. This easement shall become null and void upon connection to public sewage system.

P. 32
R. A. Benhoff
374/155

Tabulation:	
Total No. of Lots and/or Parcels	- 2
Total Area of Lots and/or Parcels	- 3.30 Ac.
Total Area of Roadways to be relocated and/or improved	- 0.17 Ac.
Total Area of Subdivision to be relocated and/or improved	- 3.47 Ac.

APPROVED: For Private Water and Private Sewerage
Systems, Howard County Health Department.

County Health Officer W. J. G. G. G. Date 8-4-77

APPROVED: Howard County Office of Planning and Zoning

1

Director, A.C.A. Date

APPROVED: For Storm Drainage Systems and Public Road
Howard County Dep't of Public Works

10

Director	Date
----------	------

OWNER'S DEDICATION

[illegible]

Walter E. Hopkins Martha F. Hopkins
Signature

1	2	3	100
---	---	---	---	---	---	---	---	---	----	----	-----

SURVEYORS CERTIFICATE

I hereby certify that the Final Plat shown hereon is correct; that it is a subdivision of all of the lands conveyed by Lucile B. Kelly to Boyd E. and Martha F. Hopkins, dated June 2, 1977 and recorded in the Land Records of Howard County, in Liber 825 Folio 551, and that all monuments are in place as shown in accordance with the Annotated Code of Maryland, as amended.

J. Carl Hudgins 096 J. Carl Hudgins 6-10-22
Reg. Land Surveyor Date

11

Maryland State Archives