

11/18/83 approved noon
11/15/83 before lunch
11/17/83 approved for 21.000

03-305570 approved 11/21/83
Stayed

PERMIT

P 33276
A 26031

SEWAGE DISPOSAL SYSTEM
MARYLAND STATE DEPARTMENT OF HEALTH

HOWARD COUNTY
BUREAU OF ENVIRONMENTAL HEALTH
992-2330

ELLICOTT CITY
DISTRICT 3rd
DATE 11/2/83

INDEX

Bob Johnson Plumbing and Heating IS PERMITTED TO INSTALL ALTER
ADDRESS 2410 Woodstream Court, Ellicott City, Md. 21043 PHONE 988-9008
SUBDIVISION Friendship Manor ROAD 2611 Wellworth Way LOT 8
PROPERTY OWNER Joseph and Nancy Stanley
ADDRESS 103 Bourbon Court, Baltimore, Maryland 21234 Phone: ~~222~~ 256-8807

IF GARBAGE GRINDER IS USED INCREASE SEPTIC TANK CAPACITY BY 50% AND ABSORPTION AREA BY 22%.

GARBAGE GRINDER? YES NO


SEPTIC TANK CAPACITY 1250 GALLONS NUMBER OF BEDROOMS 4

DRY WELL AND TRENCH - Dry well to have 150 sq. ft. per bedroom. Inlet 2½ ft. below original grade and maximum depth 8½ ft. below original grade for a total of 288 sq. ft. in dry well. Locate dry well 230 ft. from front of lot and 65 ft. from right lot line. Trench for 4 bedroom home to be 80 ft. long. Inlet at 2½ ft. below original grade and maximum depth 8½ ft. below original grade. Trench to run across lot on contour, downslope from dry well.

PLANS APPROVED BY Robert T. Moorefield DATE 6/30/77

- COVER NO WORK UNTIL INSPECTED AND APPROVED.
- NEITHER THE HOWARD COUNTY COUNCIL NOR THE HEALTH DEPARTMENT IS RESPONSIBLE FOR THE SUCCESSFUL OPERATION OF ANY SYSTEM.
- NOTE: IF TRENCH IS USED CALL FOR INSPECTION BEFORE AND AFTER PLACING GRAVEL IN TRENCH.
- NOTE: NO DRY WELL SHALL EXCEED 15 FOOT IN DIAMETER. NO ABSORPTION TRENCH TO EXCEED 100 FEET IN LENGTH.
- NOTE: ALL PIPE FROM HOUSE TO SEPTIC TANK MUST BE CAST IRON OR SCHEDULE 40 PVC OR ABS.
- PERMIT VOID AFTER THREE YEARS.
- NOTE: INSTALL STAND PIPE ON SEPTIC TANK AND DRY WELL. STAND PIPES MUST BE 6 INCHES IN DIAMETER. CAST IRON, CONCRETE OR TERRA COTTA, OR PVC OR ABS ACCEPTED. IF TOP OF SEPTIC TANK IS DEEPER THAN 3 FEET MANHOLE TO GRADE REQUIRED.

***INSTALLER IS RESPONSIBLE FOR OBTAINING FINAL APROVAL ON THIS PERMIT**

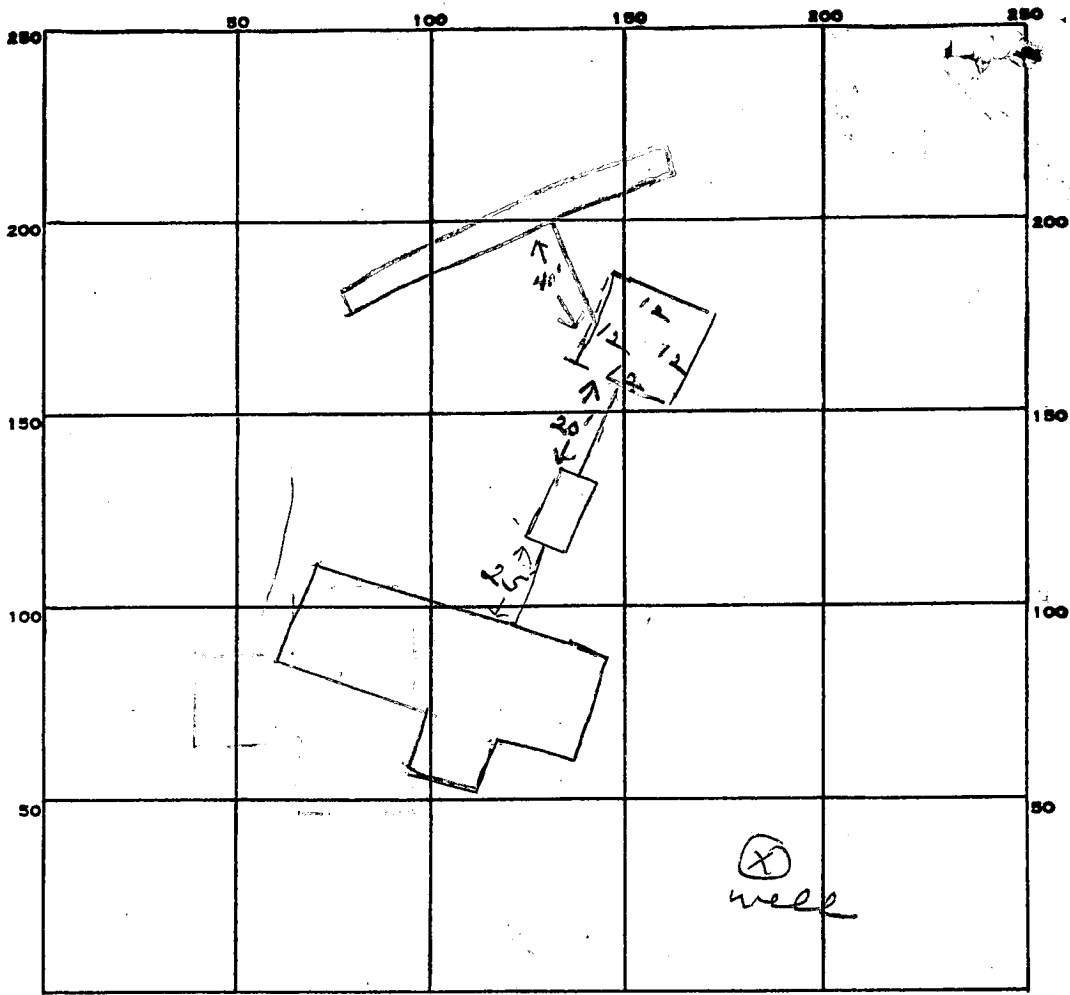

INDICATE NORTH - NAME ADJOINING ROADWAY AS BASE LINE.

Wellworth way

PERMIT CARD ✓

SEPTIC TANK, LEVEL ✓ 1500 gal CLEANOUTS ST | DW

DISTRIBUTION BOX, LEVEL _____

TILE FIELD, DEPTH 8 1/2 FT. TRENCH WIDTH 2 FT.

GRAVEL DEPTH 6' IN. TOTAL LENGTH 62 FT.

NUMBER OF TRENCHES 1 TOTAL BOTTOM AREA 372

SEEPAGE PITS, INSIDE DIAMETER 48 FT. DEPTH BELOW INLET 6 FT.

ABSORBENT AREA 660 SQ. FT.

REMARKS 11/15/83 OK to continue work JS

11/17/83 NOTHING DONE TALKED TO SOMEONE WHO SAID

PIPE TO HOUSE TO TANK WAS INSTALLED & COVERED BUT

DRY WELL HOLE 9 1/2 FT DEEP 11/18/83 OK to add stone

in trench JS

11/21/83 OK to cover all work JS

DATE SYSTEM APPROVED 11/21/83 INSPECTOR SEAMAN

APPLICATION

A 26031

P _____

SEWAGE DISPOSAL TESTING

STATE OF MARYLAND - DEPARTMENT OF HEALTH AND MENTAL HYGIENE

DISTRICT 3rd

HOWARD COUNTY HEALTH DEPARTMENT
ENVIRONMENTAL HEALTH SERVICES
P. O. BOX 476, ELLICOTT CITY, MARYLAND 21043
TELEPHONE: 465-5000, EXT. 356

DATE 6/7/77

TO: THE COUNTY HEALTH OFFICER
ELLICOTT CITY, MARYLAND

I, HEREBY, APPLY FOR THE NECESSARY TEST IN ORDER TO CONSTRUCT (OR RECONSTRUCT) A SEWAGE DISPOSAL SYSTEM.

PROPERTY OWNER William B. Ridgely Joseph & Nancy Stanley

ADDRESS Spring Meadow Farm Cooksville, Md. 21728 PHONE Carol Clark

PROPERTY LOCATION: Baltimore, Md 21234 531-5115
256-8807

SUBDIVISION Ridgely Property (Friendship Manor) LOT NO. 8

ROAD AND DESCRIPTION Rte. 144 - Rte. 32

2611 Wellworth Way

SIZE OF LOT ? TYPE BLDG. 4BR part 52992
4 bedroom
NUMBER OF BEDROOMS

IF NOT SINGLE RESIDENCE DESCRIBE _____

THE SYSTEM INSTALLED UNDER THIS APPLICATION IS ACCEPTABLE ONLY UNTIL PUBLIC FACILITIES BECOME AVAILABLE.

SIGNATURE OF APPLICANT /s/ Albert Scheel

APPROVED BY Rm FOR sew & trunk DATE 6-30-77
(KIND OF SYSTEM)

REJECTED BY _____ FOR _____ DATE _____
(KIND OF SYSTEM)

HOLD PENDING FURTHER TESTS _____ DATE _____

REASONS FOR REJECTION OR HOLDING _____

BLDG. PERMIT SIGNED
AND RETURNED 6/21/77
Serial # 52992

THIS IS NOT A PERMIT

SITE PLAN

520° 06' 25" W 255.00'

471° 49' 10" W 619.38'

LOT B
3.683 Ac.
448'

SEWAGE DISPOSAL
FACILITY

3/21/83
Sketch
J.S.


571° 48' 50" E 626.29'

R. 831.75' L. 72.00'

N 18° 11' 10" E

183.00'

Wellworth Way

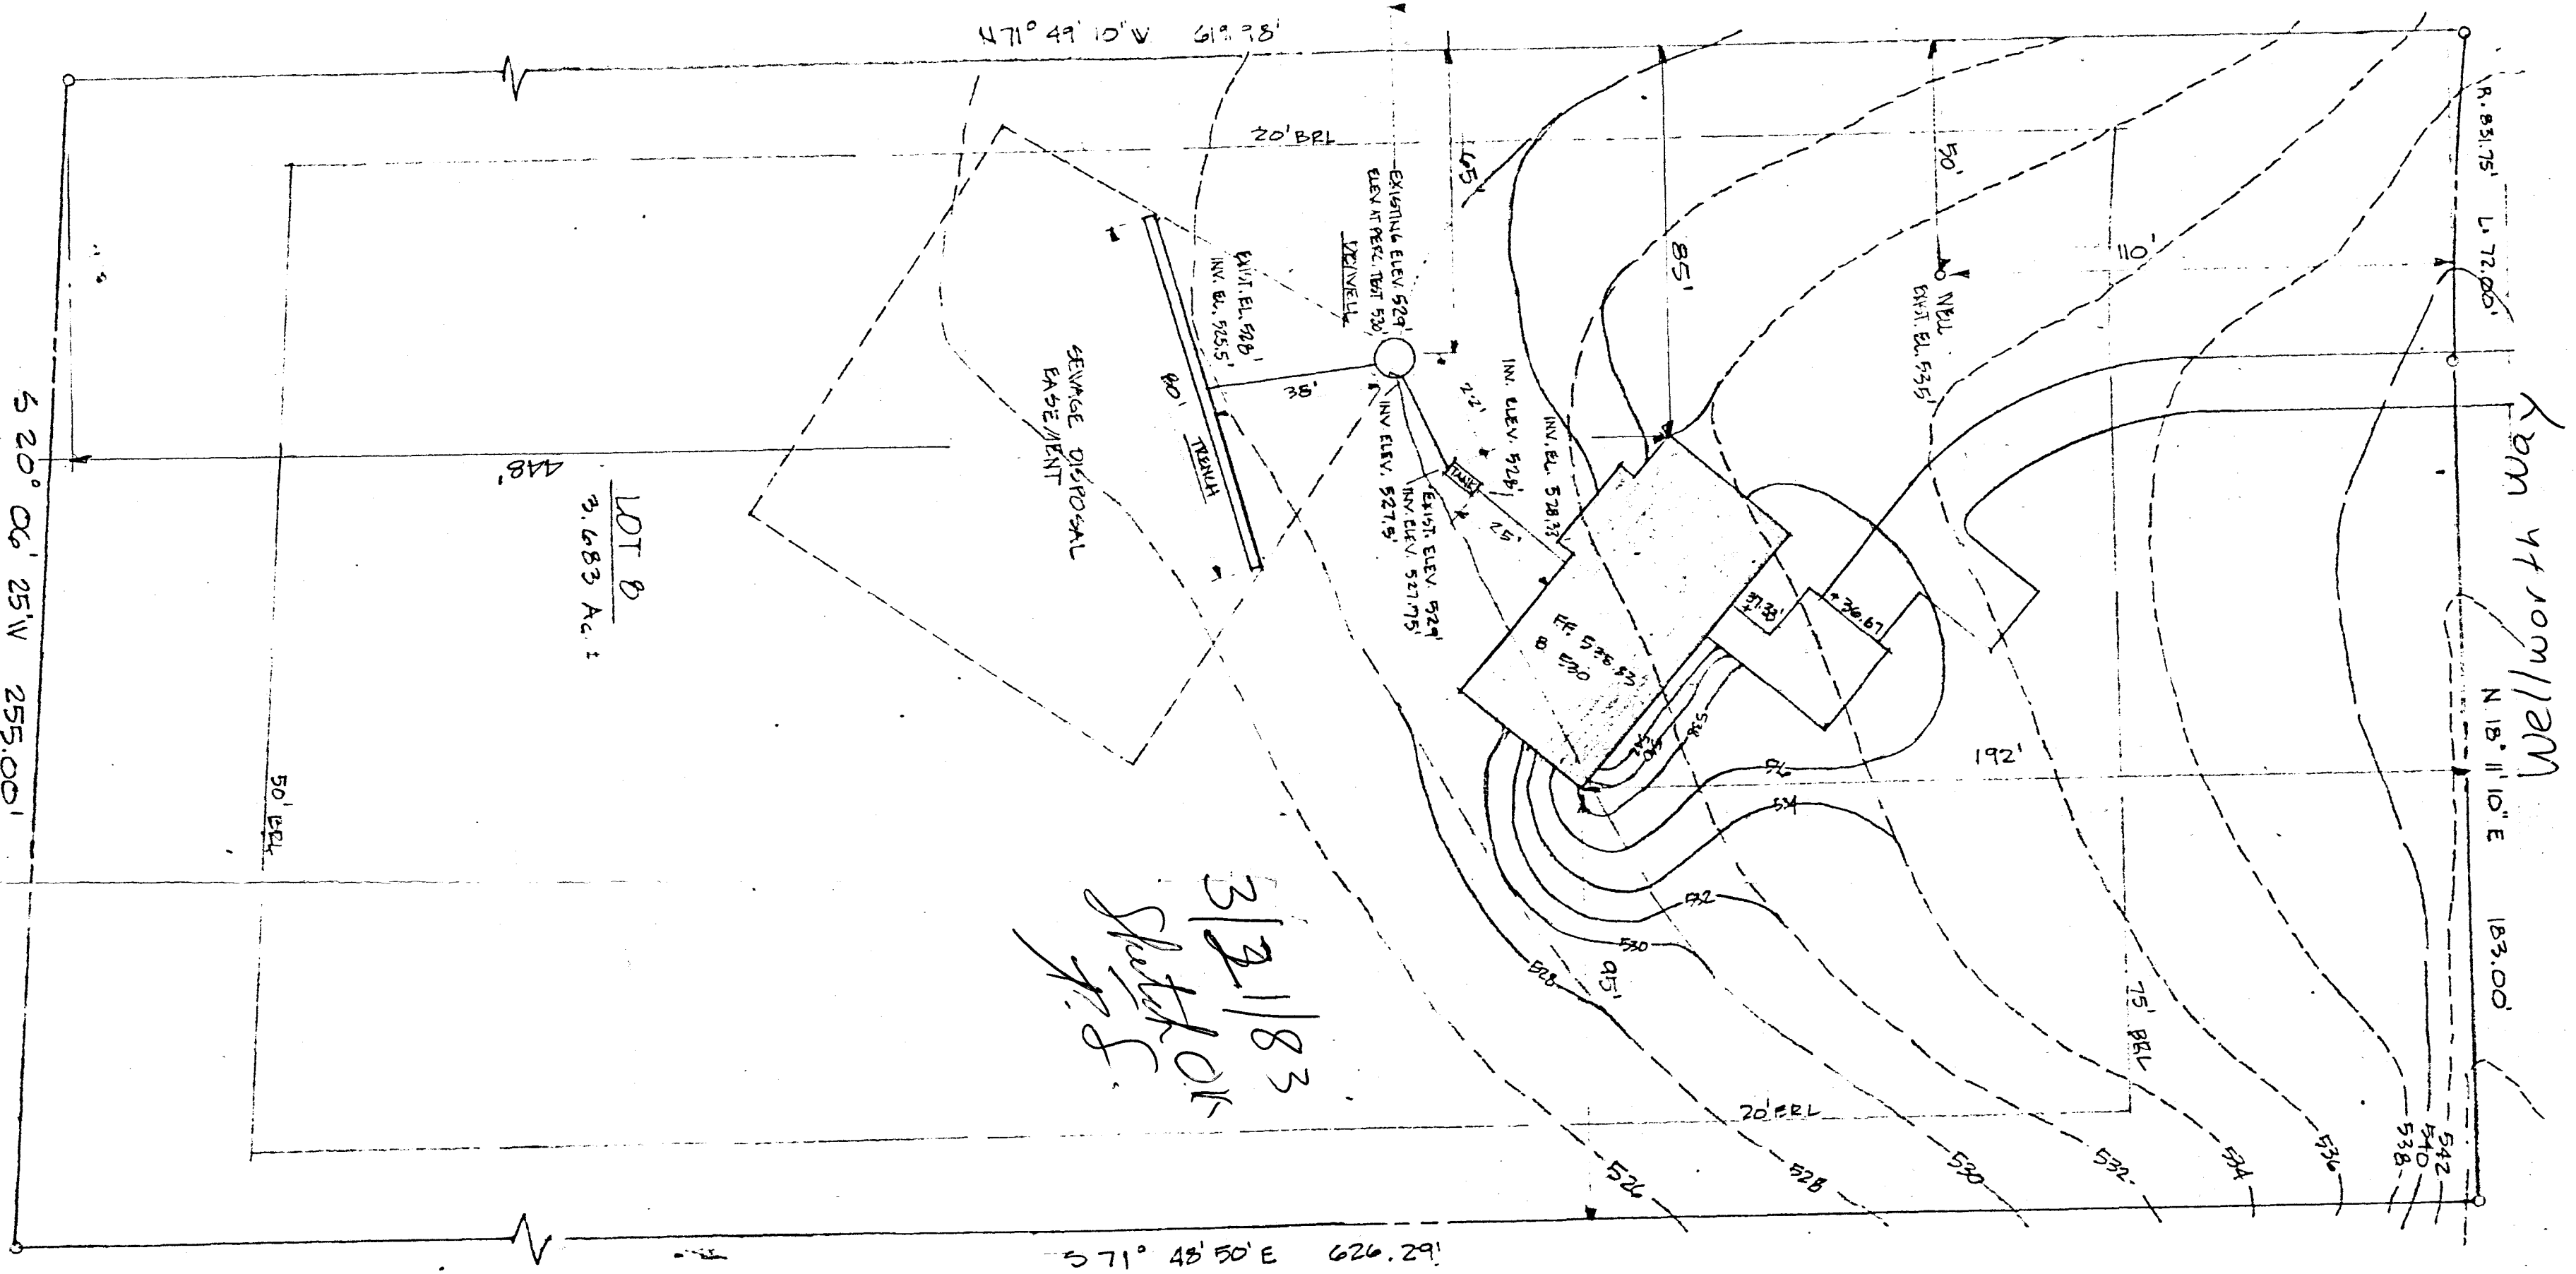

SHEET NO.

SHEET TITLE
SITE PLAN

STANLEY RESIDENCE

2611 Wellworth Way

West Friendship, Maryland

Howard County

Peter Notari - Architect

2919 East Baltimore Street
Baltimore, Maryland 21224
(301) 675-3720

C1 3117 SEQUENCE NO. (OEP USE ONLY)
 (THIS NUMBER IS TO BE PUNCHED IN COLS. 3-6 ON ALL CARDS)

STATE OF MARYLAND
WELL COMPLETION REPORT
 FILL IN THIS FORM COMPLETELY
 PLEASE PRINT OR TYPE

THIS REPORT MUST BE SUBMITTED WITHIN 45 DAYS AFTER WELL IS COMPLETED.
 COUNTY NUMBER **A26031**

Date Received (OEP use only)
DATE WELL COMPLETED
 3 10 82

Depth of Well **140**
 (TO NEAREST FOOT)

PERMIT NO.
 FROM "PERMIT TO DRILL WELL"
HC-13-4124

OWNER **Stanley** last name **Joe** first name
 STREET OR RFD **Wellworth Way** TOWN **West Friendship**
 SUBDIVISION **Friendship Manor** SECTION _____ LOT **8**

WELL LOG
 Not required for driven wells
 STATE THE KIND OF FORMATIONS PENETRATED, THEIR COLOR, DEPTH, THICKNESS AND IF WATER BEARING

DESCRIPTION (Use additional sheets if needed)	FEET		Check if water bearing
	FROM	TO	
TOP SOIL	0	3	
Shaley	3	40	
SANDSTONE	40	58	✓
MICA	58	65	
SANDSTONE	65	75	✓
MICA	75	94	
SANDSTONE	94	108	✓
MICA	108	140	

GROUTING RECORD
 WELL HAS BEEN GROUTED (Circle Appropriate Box) **Y** **N**
 TYPE OF GROUTING MATERIAL
 CEMENT **CM** BENTONITE CLAY **BC**
 NO. OF BAGS **12** NO. OF POUNDS **1200**
 GALLONS OF WATER **100**
 DEPTH OF GROUT SEAL (to nearest foot) from **0** ft. to **36** ft.
 (enter 0 if from surface) BOTTOM **58** ft.

CASING RECORD
 casing types insert appropriate code below
ST **CO**
 STEEL CONCRETE
PL **OT**
 PLASTIC OTHER

MAIN CASING TYPE
 Nominal diameter top(main)casing (nearest inch) **6**
 Total depth of main casing (nearest foot) **49**

OTHER CASING (if used)
 diameter inch. depth (feet) from to

SCREEN RECORD
 screen type or open hole insert appropriate code below
ST **BR** **HO**
 STEEL BRASS BRONZE OPEN HOLE
PL **OT**
 PLASTIC OTHER

C2 (Seq. no.)
 DEPTH (nearest ft.) **47** **140**

CIRCLE APPROPRIATE BOX:
A A WELL WAS ABANDONED AND SEALED WHEN THIS WELL WAS COMPLETED
E ELECTRIC LOG OBTAINED
P TEST WELL CONVERTED TO PRODUCTION WELL

I HEREBY CERTIFY THAT THIS WELL HAS BEEN CONSTRUCTED IN ACCORDANCE WITH COMAR 10.17.13 "WELL CONSTRUCTION" AND IN CONFORMANCE WITH ALL CONDITIONS STATED IN THE ABOVE CAPTIONED PERMIT, AND THAT THE INFORMATION PRESENTED HEREIN IS ACCURATE AND COMPLETE TO THE BEST OF MY KNOWLEDGE.

DRILLERS IDENT. NO. **40**
 DRILLERS/SIGNATURE
 (MUST MATCH SIGNATURE ON APPLICATION)

SITE SUPERVISOR (sign. of driller or journeyman responsible for sitework if different from permittee)


SLOT SIZE 1 _____ 2 _____ 3 _____
 DIAMETER OF SCREEN _____ (NEAREST INCH)
 from _____ to _____

GRAVEL PACK _____
 IF WELL DRILLED WAS FLOWING WELL CIRCLE BOX **F**

OEP USE ONLY (NOT TO BE FILLED IN BY DRILLER)
 T _____ (E.R.O.S.)
 W Q _____
 TELESCOPE LOG OTHER DATA
 CASING INDICATOR

C3 (Seq. no.)
PUMPING TEST
 HOURS PUMPED (nearest hour) **3**
 PUMPING RATE (gal. per min. to nearest gal.) **10**
 METHOD USED TO MEASURE PUMPING RATE **BUCKET**
 WATER LEVEL (distance from land surface) BEFORE PUMPING **34** WHEN PUMPING **45**
 TYPE OF PUMP USED (for test) **A** air **P** piston **T** turbine **C** centrifugal **R** rotary **O** other (describe below) **J** jet **S** submersible

PUMP INSTALLED YES **Y** NO **N**
 DRILLER WILL INSTALL PUMP (CIRCLE APPROPRIATE BOX)
 IF DRILLER INSTALLS PUMP, THIS SECTION MUST BE COMPLETED FOR ALL WELLS EXCEPT HOME USE
 TYPE OF PUMP (WRITE APPROPRIATE LETTER IN BOX - SEE ABOVE: (A, C, J, P, R, S, T, O))
 CAPACITY: GALLONS PER MINUTE (to nearest gallon) _____
 PUMP HORSE POWER _____
 PUMP COLUMN LENGTH (nearest ft.) _____
 CASING HEIGHT (circle appropriate box and enter casing height) **+** above **-** below
 LAND SURFACE **2** (nearest foot)

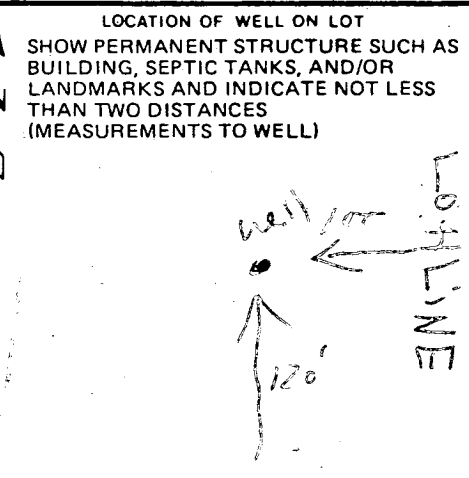

Roob

