

3/12/80 FILE APPROV
C.B.V.

PERMIT

SEWAGE DISPOSAL SYSTEM

MARYLAND STATE DEPARTMENT OF HEALTH

HOWARD COUNTY

ELLICOTT CITY

DISTRICT 6th.

DATE 1/28/80

INDEXED

Paul Schuler

~~Burgemeister-Bell~~

IS PERMITTED TO INSTALL ☒ ALTER

ADDRESS

PHONE 363-0885 795-2642

SUBDIVISION Laupert Property

ROAD 6122 Waterloo Road

LOT

PROPERTY OWNER William Laupert

PHONE: 465-5476

ADDRESS 3910 C Town & County Blvd., Ellicott City, Md. 21043

SPECIFICATIONS 3 Bedrooms

SEPTIC TANK CAPACITY 1000 GALLONS

DRAIN FIELD DEPTH FEET, BOTTOM AREA SQ. FT.

DEEP TRENCH DEPTH FEET, BOTTOM AREA SQ. FT.

Dry Well

SEEPAGE PITS ☒ ABSORBENT SIDE-WALL AREA 130 SQ. FT. per bedroom

INLET PIPE 3 FT. BELOW ORIGINAL GRADE, MAXIMUM DEPTH 9 FT. BELOW ORIGINAL GRADE

EFFECTIVE DEPTH AT FT. BELOW ORIGINAL GRADE.

LOCATE DISPOSAL AREA 72 FT. FROM Front LOT LINE AND 163 FT. FROM right LOT LINE AS SEEN WHEN

FACING LOT FROM

Okay to run a ditch off dry well - 10 feet deep filled with 6 foot of stone if additional absorbent area needed. NOTE: Leave 5 ft. earth buffer between trench and dry well. Trench to follow contour of the land.

PLANS APPROVED BY Raymond Hodges

DATE 11/15/79

COVER NO WORK UNTIL INSPECTED AND APPROVED.

NEITHER THE HOWARD COUNTY COUNCIL NOR THE HEALTH DEPARTMENT IS RESPONSIBLE FOR THE SUCCESSFUL OPERATION OF ANY SYSTEM.

NOTE: IF TRENCH IS USED CALL FOR INSPECTION BEFORE PLACING GRAVEL IN TRENCH.

NOTE: NO DRY WELL SHALL EXCEED 15 FOOT IN DIAMETER.


NOTE: ALL PIPE FROM HOUSE TO DISPOSAL AREA MUST BE CAST IRON.

PERMIT VOID AFTER THREE YEARS.

NOTE: INSTALL STAND PIPE ON SEPTIC TANK AND DRY WELL. STAND PIPES MUST BE 6 INCHES IN DIAMETER. CAST IRON, CONCRETE OR TERRAZZO ACCEPTED.

***INSTALLER IS RESPONSIBLE FOR OBTAINING FINAL APPROVAL ON THIS PERMIT.**

A 26433

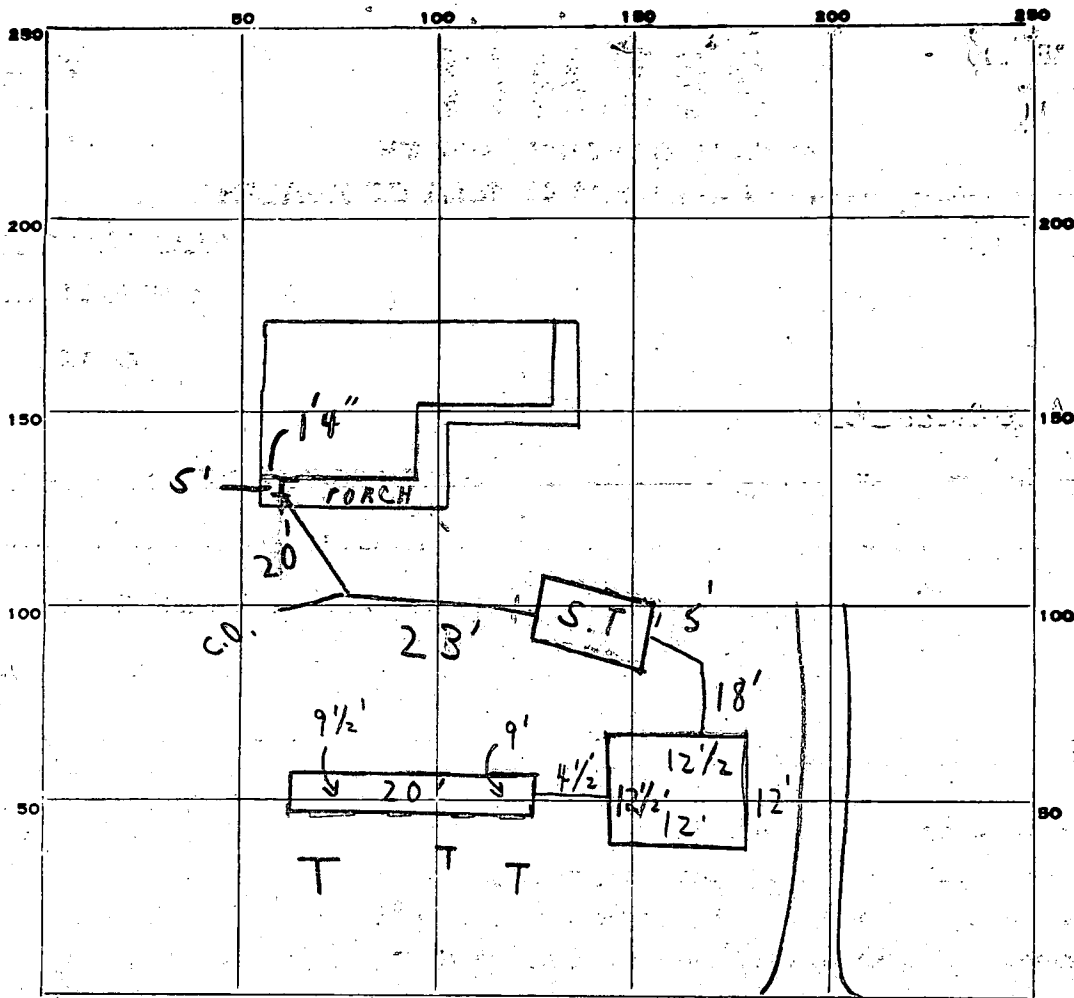

INDICATE NORTH. - NAME ADJOINING ROADWAY AS BASE LINE.

WATERLOO ROAD

PERMIT CARD ☒

SEPTIC TANK, LEVEL ☒

CLEANOUTS ☒ S.T. ☒ D.W. ☒

DISTRIBUTION BOX, LEVEL ☐

TILE FIELD, DEPTH 9' FT. TRENCH WIDTH 2 FT.

GRAVEL DEPTH 6 IN. TOTAL LENGTH 20 FT. 120

NUMBER OF TRENCHES 1 TOTAL BOTTOM AREA 120

SEEPAGE PITS, INSIDE DIAMETER 49 FT. DEPTH BELOW INLET 6 FT. 294

ABSORBENT AREA 414 SQ. FT.

REMARKS A.M. 3/12/80 CHECKED - TRENCH DUG @ TIME OF INSPECTION,
↓ PIPE IN FROM HOUSE TO 2' OF TANK; NEED CLEANOUT @ SECOND CHANGE
OF DIRECTION FROM HOUSE.; 3/12/80 P.M. SYSTEM COMPLETE
C.B.S.

DATE SYSTEM APPROVED 3/12/80 INSPECTOR C.B. Shesher

Recorded

APPLICATION

A 26433

P _____

SEWAGE DISPOSAL TESTING

*8/4/77 A.M.
9:30*

STATE OF MARYLAND - DEPARTMENT OF HEALTH AND MENTAL HYGIENE

HOWARD COUNTY HEALTH DEPARTMENT
ENVIRONMENTAL HEALTH SERVICES

DISTRICT 6th

P. O. BOX 476, ELLICOTT CITY, MARYLAND 21043
TELEPHONE: 465-5000, EXT. 356

DATE 7/18/77

TO: THE COUNTY HEALTH OFFICER
ELLICOTT CITY, MARYLAND

I, HEREBY, APPLY FOR THE NECESSARY TEST IN ORDER TO CONSTRUCT (OR RECONSTRUCT) A SEWAGE DISPOSAL SYSTEM.

PROPERTY OWNER Laupert property (Contract Purchaser - Robert Zenoble)
Apt. 104

ADDRESS 8777 Contee Road, Laurel, Md. 20810 PHONE 776-1345

PROPERTY LOCATION:

SUBDIVISION _____ LOT NO. 3 & 4 (to be combined as one lot)

ROAD AND DESCRIPTION Route 175 (Now Route 108) ^{near} Pfeiffer's Corner - on right hand side going towards Route 1

SIZE OF LOT approx. 3/4 acre TYPE BLDG. 3 or 4 bedrooms

NUMBER OF BEDROOMS _____

IF NOT SINGLE RESIDENCE DESCRIBE _____

THE SYSTEM INSTALLED UNDER THIS APPLICATION IS ACCEPTABLE ONLY UNTIL PUBLIC FACILITIES BECOME AVAILABLE.

SIGNATURE OF APPLICANT *Robert Zenoble*


APPROVED BY _____ FOR _____ DATE _____
(KIND OF SYSTEM)

REJECTED BY _____ FOR _____ DATE _____
(KIND OF SYSTEM)

HOLD PENDING FURTHER TESTS or fail as is F. Skinner & D.W.M. DATE 8/4/77

REASONS FOR REJECTION OR HOLDING high water table; see A 22193; tested also on 10/3/75 water table has dropped considerably. Hold for wet season testing F.S. 11/21/77 Mrs. Laupert discusses P.F.W. & F.S. Hold for wet season test March 1 F.S.

THIS IS NOT A PERMIT

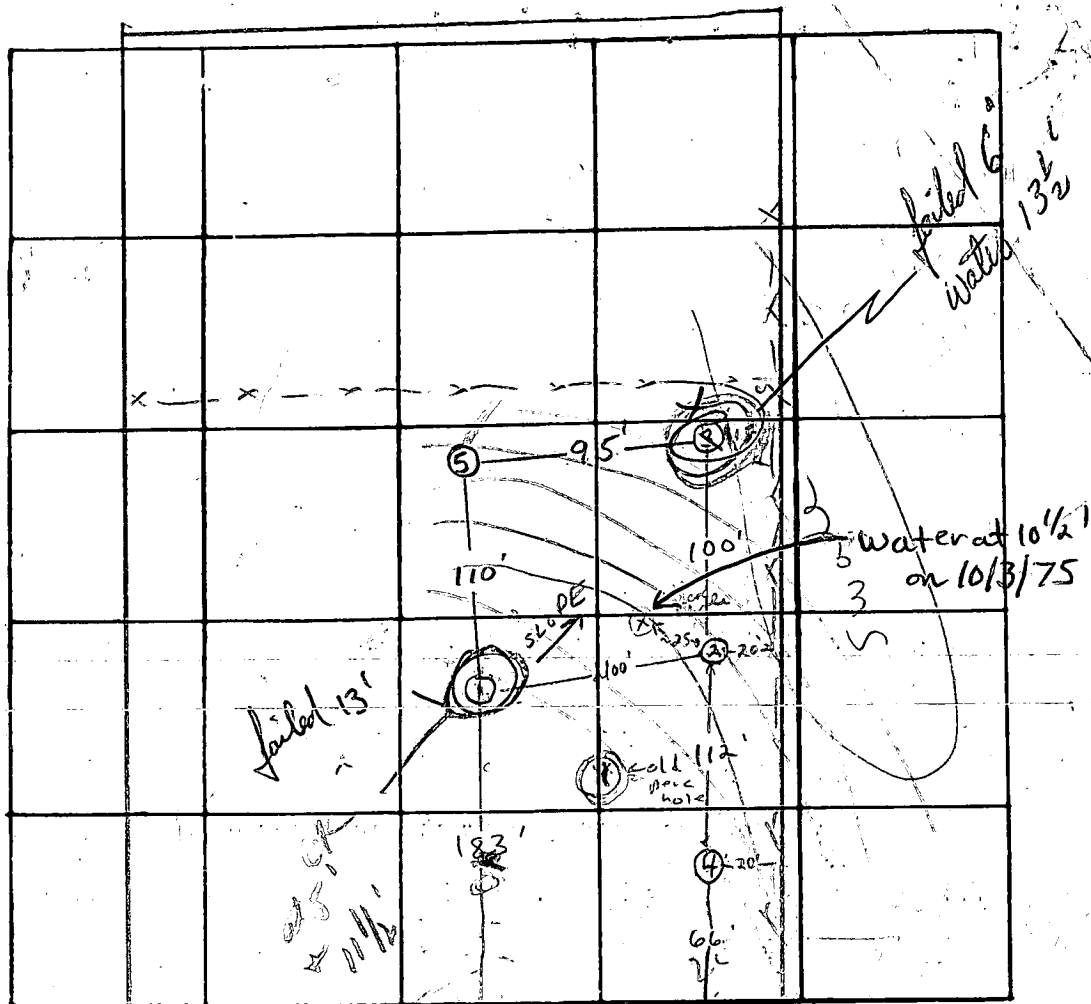

INDICATE NORTH. - NAME ADJOINING ROADWAY VS. BASE LINE
Rte. 108 (formerly Rte 75)

Rte. 108 (formerly Rte 175)

DATE	TEST NO.	DEPTH	PRE-WET		TEST - 1" DROP		TIME
			START	STOP	START	STOP	
8/4/77	1 high	5'	10:05	10:06	10:06	10:07	1 min
	1A	13'	10:05	10:22	10:22	10:56	34 min
	2A	12'	10:12	10:14	10:14	10:18	4 min
	2	4'	10:33	10:35	10:35	10:39	4 min
	3	6'	10:26	10:59	10:59	pulled peg 1/4" drop	11:30 FAILS
	3A	14'	Water	at 13'	Clayey to	6-7'	
	4	14'	Clay & gravel	to 5'	gravel & sand	5-7'	
	1B	11 1/2'	11:37	11:40	11:40	11:44	4 min
	5	3 1/2'	11:33	11:33	11:33	11:34	1 min
	5A	12'	clayey to	3'	sand below		Day

REMARKS

~ 8 loop from $(5) \rightarrow 0$

TYPE OF SOIL

Layer of gravel to 3-5' sand & gravel & calc. ls. bank below


TESTED BY

F.S.

Mr. & Mrs. Bob Metz - Brittingham
ALSO PRESENT: few

ALSO PRESENT

ROUTE 175
Now 108

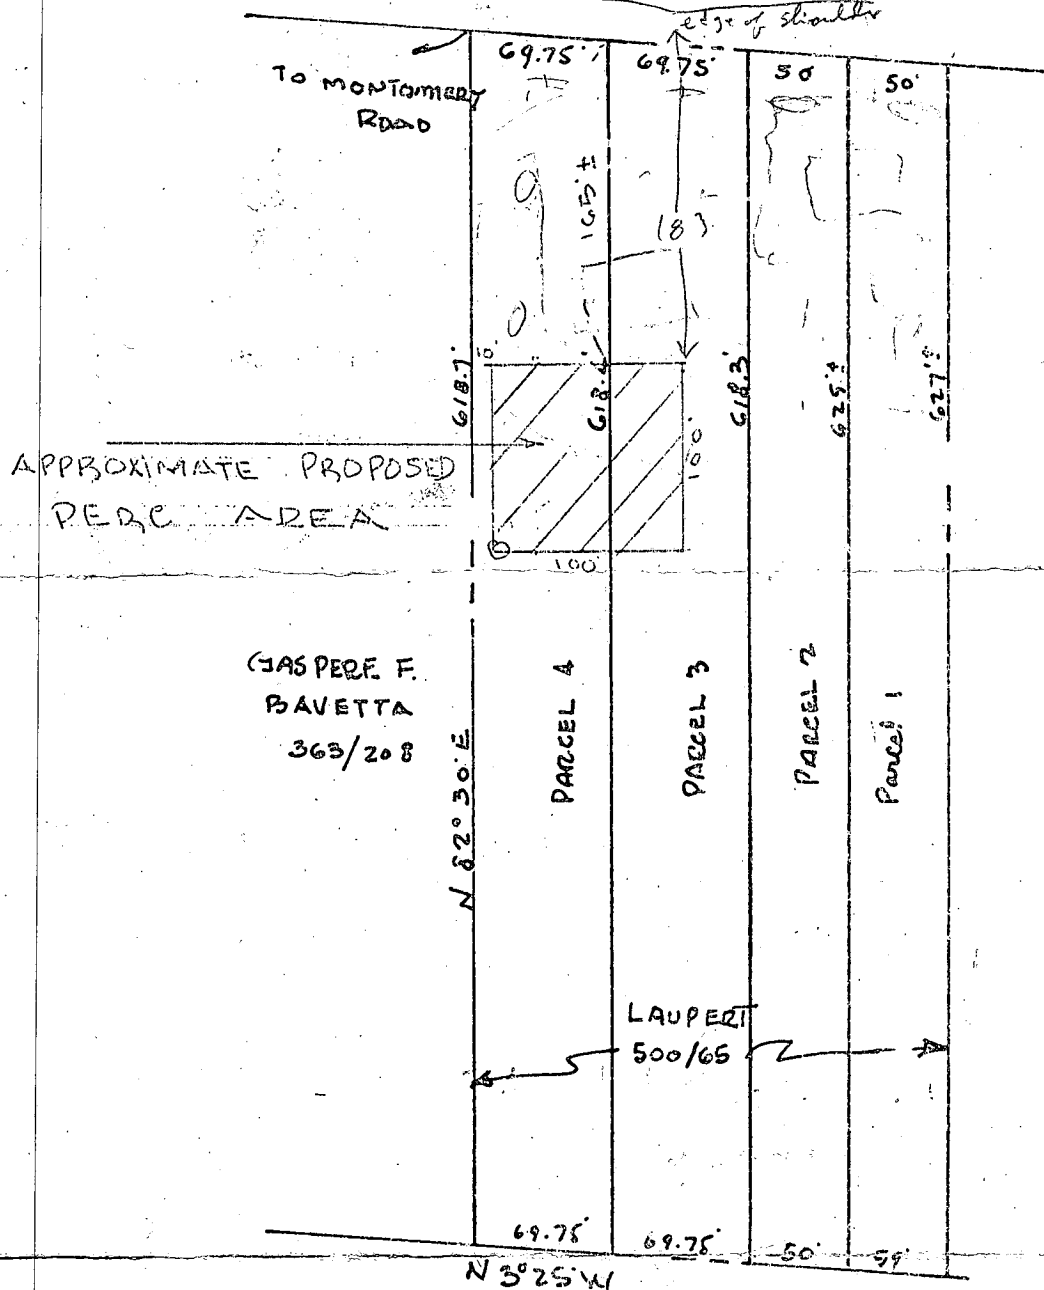

H.R.D.

TAX MAP 37
PARCEL 242

NO EXISTING HOUSE ON PROPERTY

SCALE 1"=100' DEED PLOTTING ONLY

26731

RECORDED

APPLICATION

PAGE 2

SEWAGE DISPOSAL TESTING

STATE OF MARYLAND - DEPARTMENT OF HEALTH AND MENTAL HYGIENE

A 26433

P _____

HOWARD COUNTY HEALTH DEPARTMENT
ENVIRONMENTAL HEALTH SERVICES
P.O. BOX 476 ELLICOTT, MARYLAND 21043
TELEPHONE: 992-2330

DISTRICT 6TH

DATE 7/18/77

March 3 & 10

DRY

500

31

TO: THE COUNTY HEALTH OFFICER
ELLICOTT CITY, MARYLAND

I, HEREBY, APPLY FOR THE NECESSARY TEST IN ORDER TO CONSTRUCT (OR RECONSTRUCT) A SEWAGE DISPOSAL SYSTEM.

PROPERTY OWNER LAUREPT PROPERTY

BILL LAUREPT

ADDRESS _____

PHONE 465 5476

PROPERTY LOCATION 6122 WATERLOO RD

8910-C
TOWN & COUNTRY BAY

SUBDIVISION _____

LOT NO. _____

ROAD AND DESCRIPTION Rt 108 near Pfeffer's Corner on Right
side going toward Route 1

SIZE OF LOT _____

TYPE BLDG. _____

THE SYSTEM INSTALLED UNDER THIS APPLICATION IS ACCEPTABLE ONLY UNTIL PUBLIC FACILITIES BECOME AVAILABLE.

I FULLY UNDERSTAND THE FEE CONNECTED WITH THE FILING OF THIS PERC TEST APPLICATION IS NON-REFUNDABLE UNDER

ANY CIRCUMSTANCES.

SIGNATURE OF APPLICANT _____

APPROVED BY _____

FOR 51 1/8

DATE _____

REJECTED BY _____

FOR _____

DATE _____

HOLD PENDING FURTHER TESTS _____

DATE _____


REASONS FOR REJECTION OR HOLDING 6/19/79 HOLD FOR REVIEW

WITH SUPERVISOR RIT copy given to



Bill Laupert 6/21/79 6/21/79 - REVIEWED
DM SAID PERC OIL CERTIFIED SEPTIC SYSTEM
& SEWAGE ARE PLAN NEEDED

THIS IS NOT A PERMIT

Called Laupert No answer

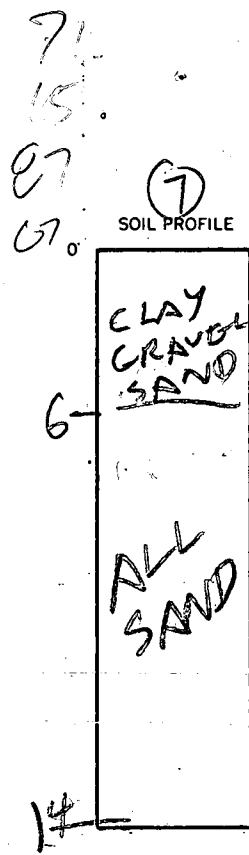


SEE
PLAT
FOR
ELEVATIONS

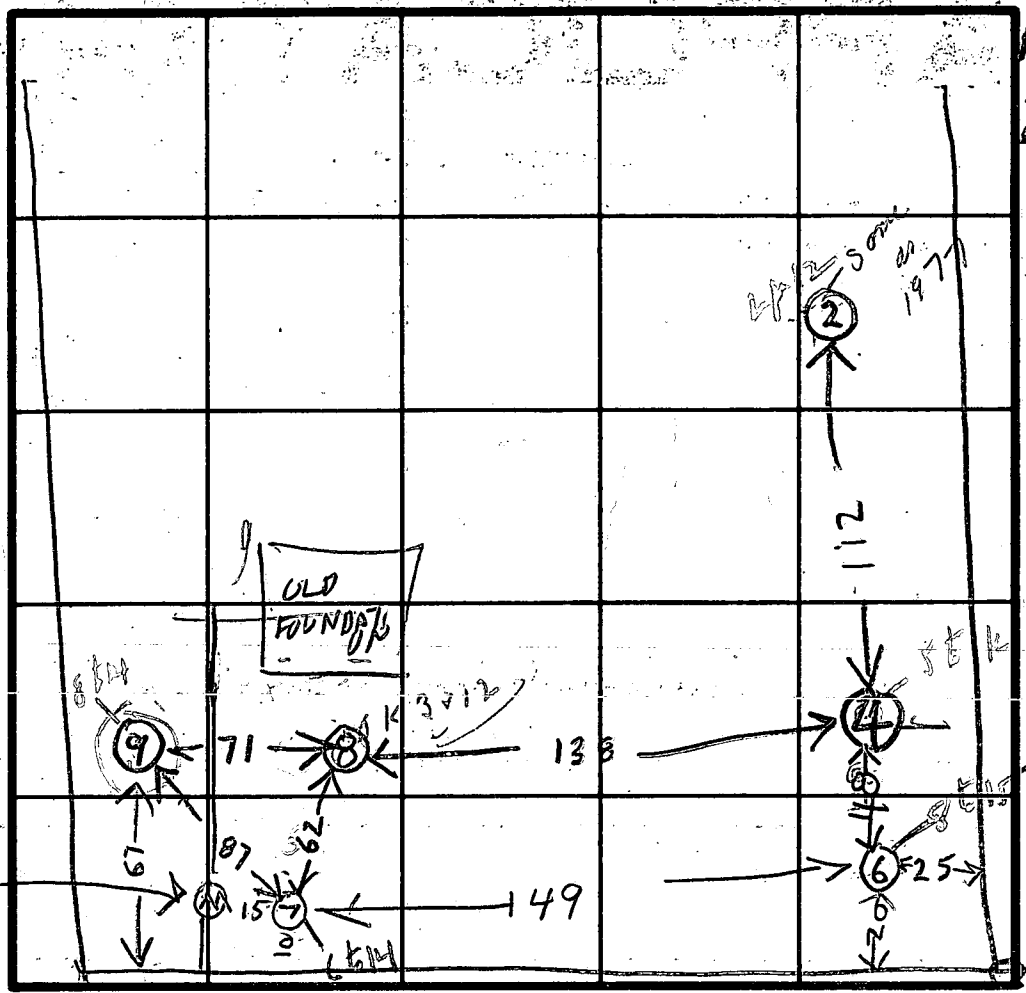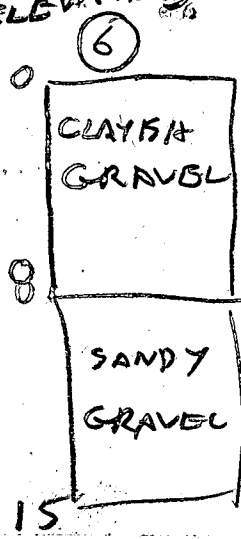

INDICATE NORTH - NAME ADJOINING ROADWAY AS BASE LINE.

ROUTE 108 (FORMERLY RT 175)


TO ELLICOTT CITY

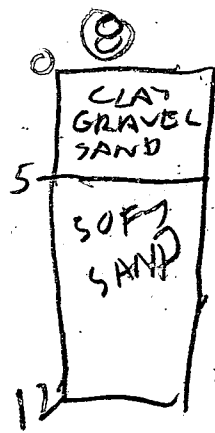

DATE	TEST NO.	DEPTH	PRE-WET		TEST - 1" DROP		TIME
			START	STOP	START	STOP	
6/19/79	6D	15	1038	1043	1043	1048	6
	6S	6 1/2	1107	1142	1st inch	35	FAIL
	7D	12	1139	1140	1140	1141	1
	7S	8	1154	1155	1155	1156	1
	8S	3	1215	1217	1217	1224	7
6/19/79	8V	12	SEE SOIL PROFILE NOT TESTED SOFT SAND				
	9V	14	SEE SOIL PROFILE				
	7V	14	SEE SOIL PROFILE				

LOWEST

HIGHEST

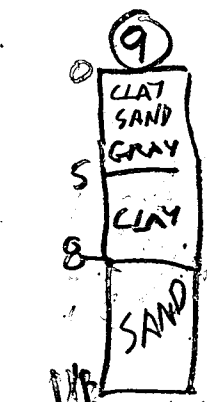


REMARKS

TYPE OF SOIL

TESTED BY B. HODGES

BILL LAUPERT
ALSO PRESENT PAUL GREGOR

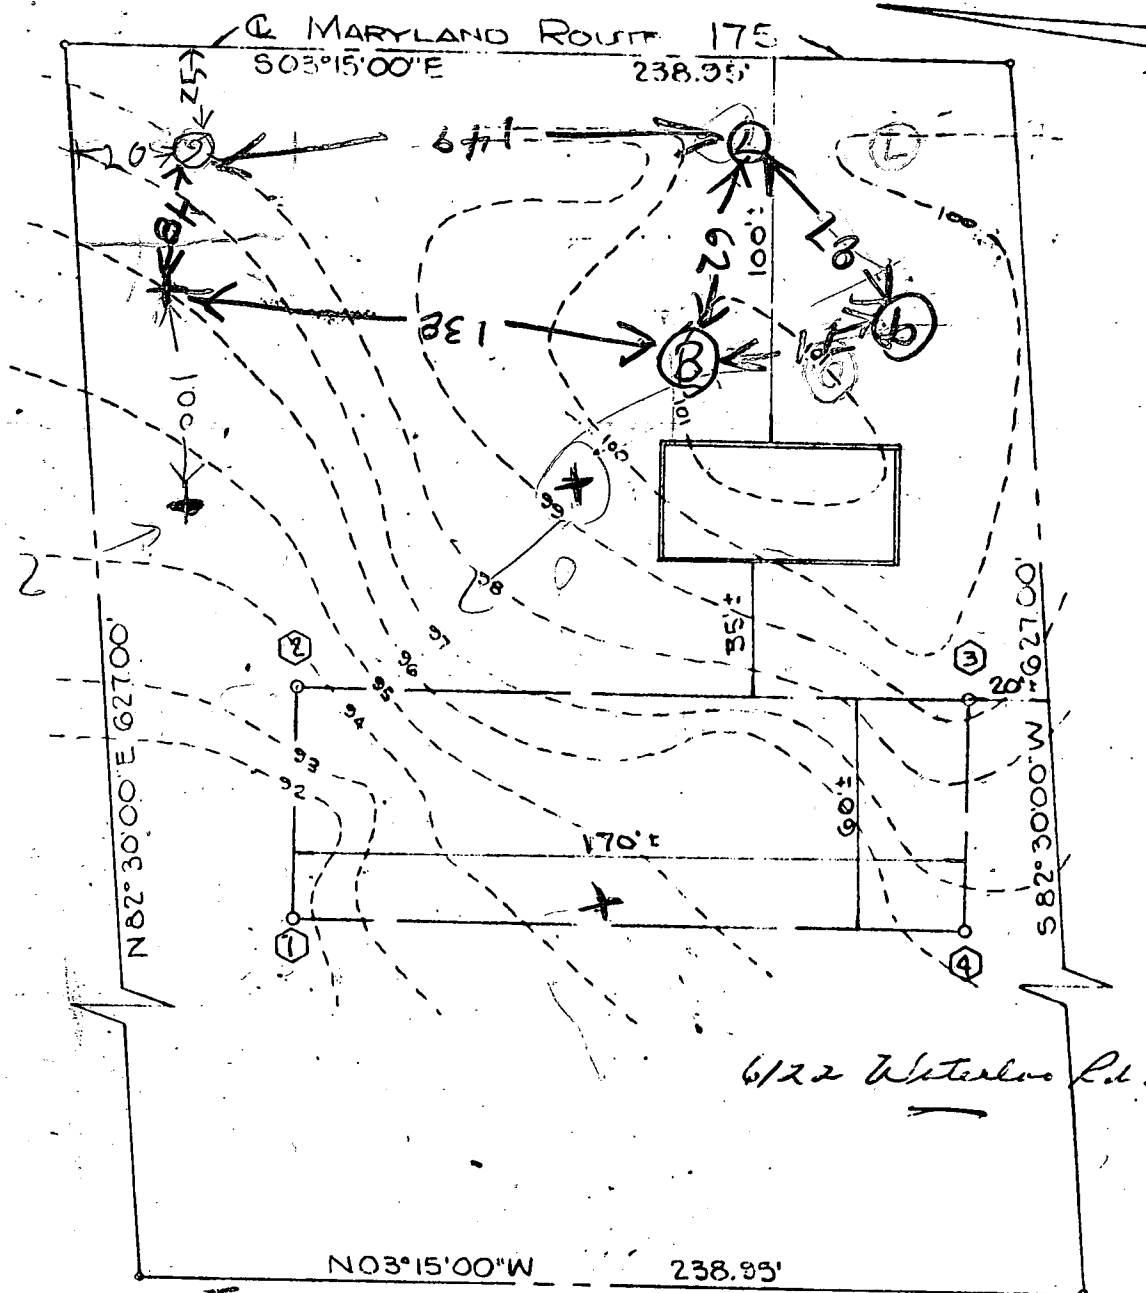

The lot shown hereon complies with the minimum ownership width and lot areas as required by the Maryland State Dept. of Health.

I hereby certify that I have field located the holes as shown hereon and the elevations as shown and that they are located correctly.

John B. Gary, P.L.S. 66 Date
Gary & Associates, Inc.
Builders Engineers and Surveyors
616 Old Edmondson Avenue
Catonsville, Maryland 21228
788-2618

APPROVED: Public Water
and private sewer system.

Howard County Health Officer


Percolation Test Plat

Parcel 242
Waterloo Road
Election District No. 6
Howard County, Maryland
Scale 1" = 50' Sept. 15, 1975

THIS AREA DESIGNATES A PRIVATE EASEMENT OF APPROXIMATELY 10,000 SQUARE FEET AS REQUIRED BY THE MARYLAND STATE DEPARTMENT OF HEALTH AND MENTAL HYGIENE FOR INDIVIDUAL SEWAGE DISPOSAL. IMPROVEMENTS OF ANY NATURE IN THIS AREA ARE RESTRICTED UNTIL PUBLIC SEWAGE IS AVAILABLE AND SERVING ANY RESIDENTIAL STRUCTURE CONSTRUCTED ON THESE BUILDING SITES. THIS EASEMENT SHALL BECOME NULL AND VOID UPON CONNECTION TO A PUBLIC SEWAGE SYSTEM.

APPROVED: PUBLIC WATER AND PRIVATE SEWAGE DISPOSAL SYSTEM.

Joseph Byler 8-21-79
HOWARD COUNTY HEALTH OFFICER DATE

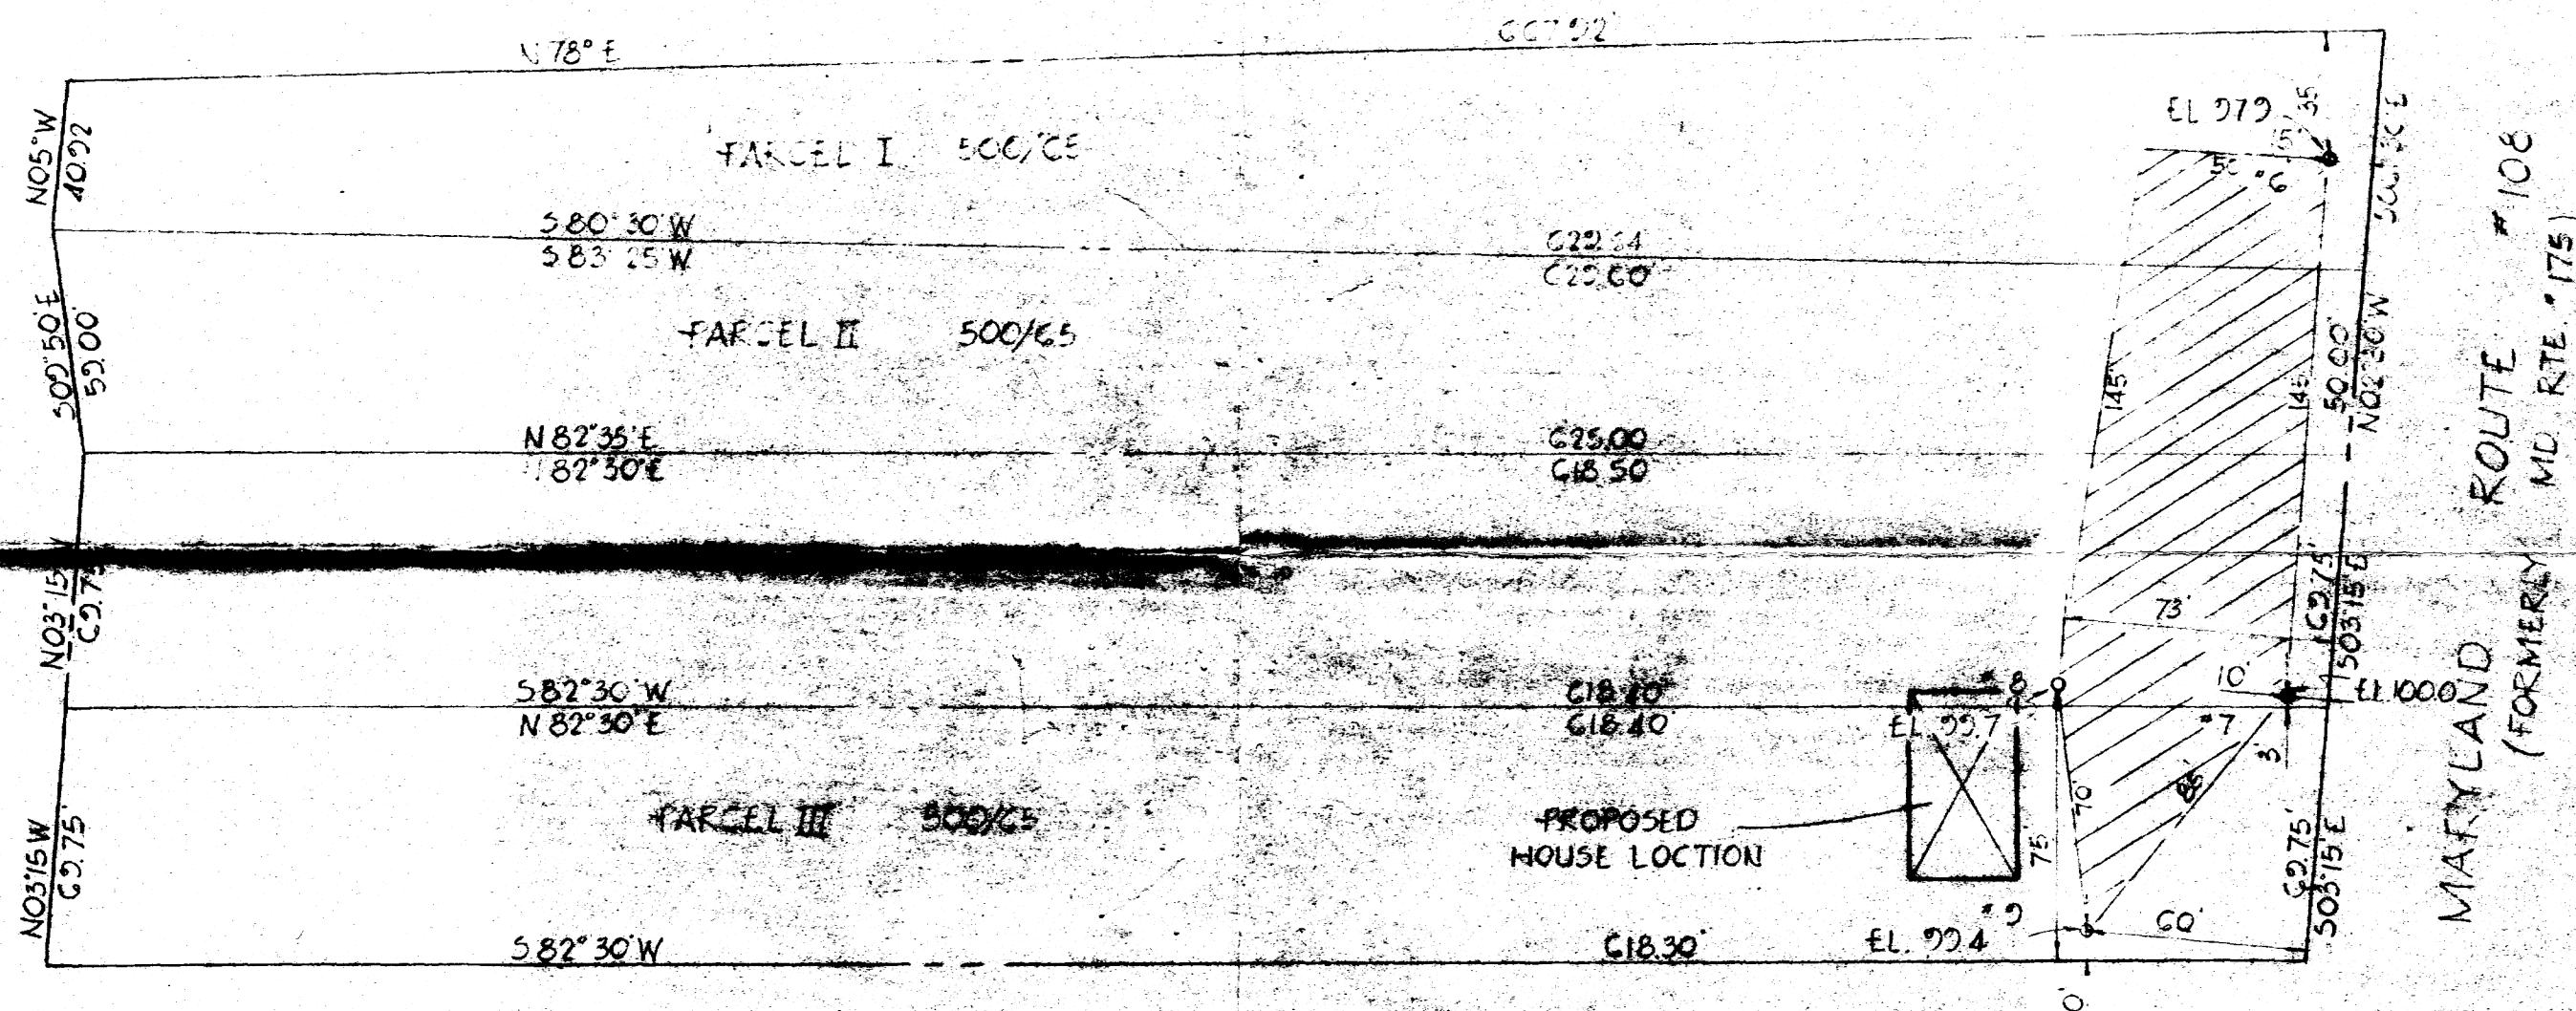

THE PROPERTY SHOWN HEREON COMPLIES WITH THE MINIMUM OWNERSHIP AND LOT AREA AS REQUIRED BY THE MARYLAND STATE DEPARTMENT OF HEALTH AND MENTAL HYGIENE.

FISHER, COLLINS & CARTER, Inc.
Consulting Engineers & Land Surveyors
8388 Court Avenue
Ellicott City, Maryland 21043

PERCOLATION TEST LOCATION
PROPERTY OF
WILLIAM LAUPERT
FIRST ELECTION DISTRICT HOWARD COUNTY, MD.
SCALE: 1"=50' JULY 18, 1979

APPROVED: **PUBLIC WATER AND PRIVATE
SEWAGE DISPOSAL SYSTEM.**

DATE _____



FISHER, COLLINS & CARTER, Inc.
Consulting Engineers & Land Surveyors
8388 Court Avenue
Ellicott City, Maryland 21043

I CERTIFY THE ABOVE MEASUREMENTS AND ELEVATIONS
ARE ACTUAL AND CORRECT FOR THIS PROPERTY.

ABSORPTION TRENCH
20' LONG-10' DEEP
BACKFILL W/ STONE
FIRST 6' OF TRENCH

Revised Plans OK
One elevation changed after
talking to Mr Carter

11/11/79
PLOT PLAN TO ACCOMPANY
APPLICATION FOR
BUILDING PERMIT
WILLIAM LAUPERT PROP.
1ST. ELECT. DIST. • HOWARD CO., MD.
SCALE: 1"=50' OCTOBER 24, 1979


11/15/79 DM said Revised Plans O.K. RH

THIS AREA DESIGNATES A PRIVATE EASEMENT OF APPROXIMATELY 10,000 SQUARE FEET AS REQUIRED BY THE MARYLAND STATE DEPARTMENT OF HEALTH AND MENTAL HYGIENE FOR INDIVIDUAL SEWAGE DISPOSAL. IMPROVEMENTS OF ANY NATURE IN THIS AREA ARE RESTRICTED UNTIL PUBLIC SEWAGE IS AVAILABLE AND SERVICING ANY RESIDENTIAL STRUCTURE CONSTRUCTED ON THESE BUILDING SITES. THIS EASEMENT SHALL BECOME NULL AND VOID UPON CONNECTION TO A PUBLIC SEWAGE SYSTEM.

APPROVED: PRIVATE WATER AND PRIVATE SEWAGE DISPOSAL SYSTEM.

HOWARD COUNTY HEALTH OFFICER

DATE

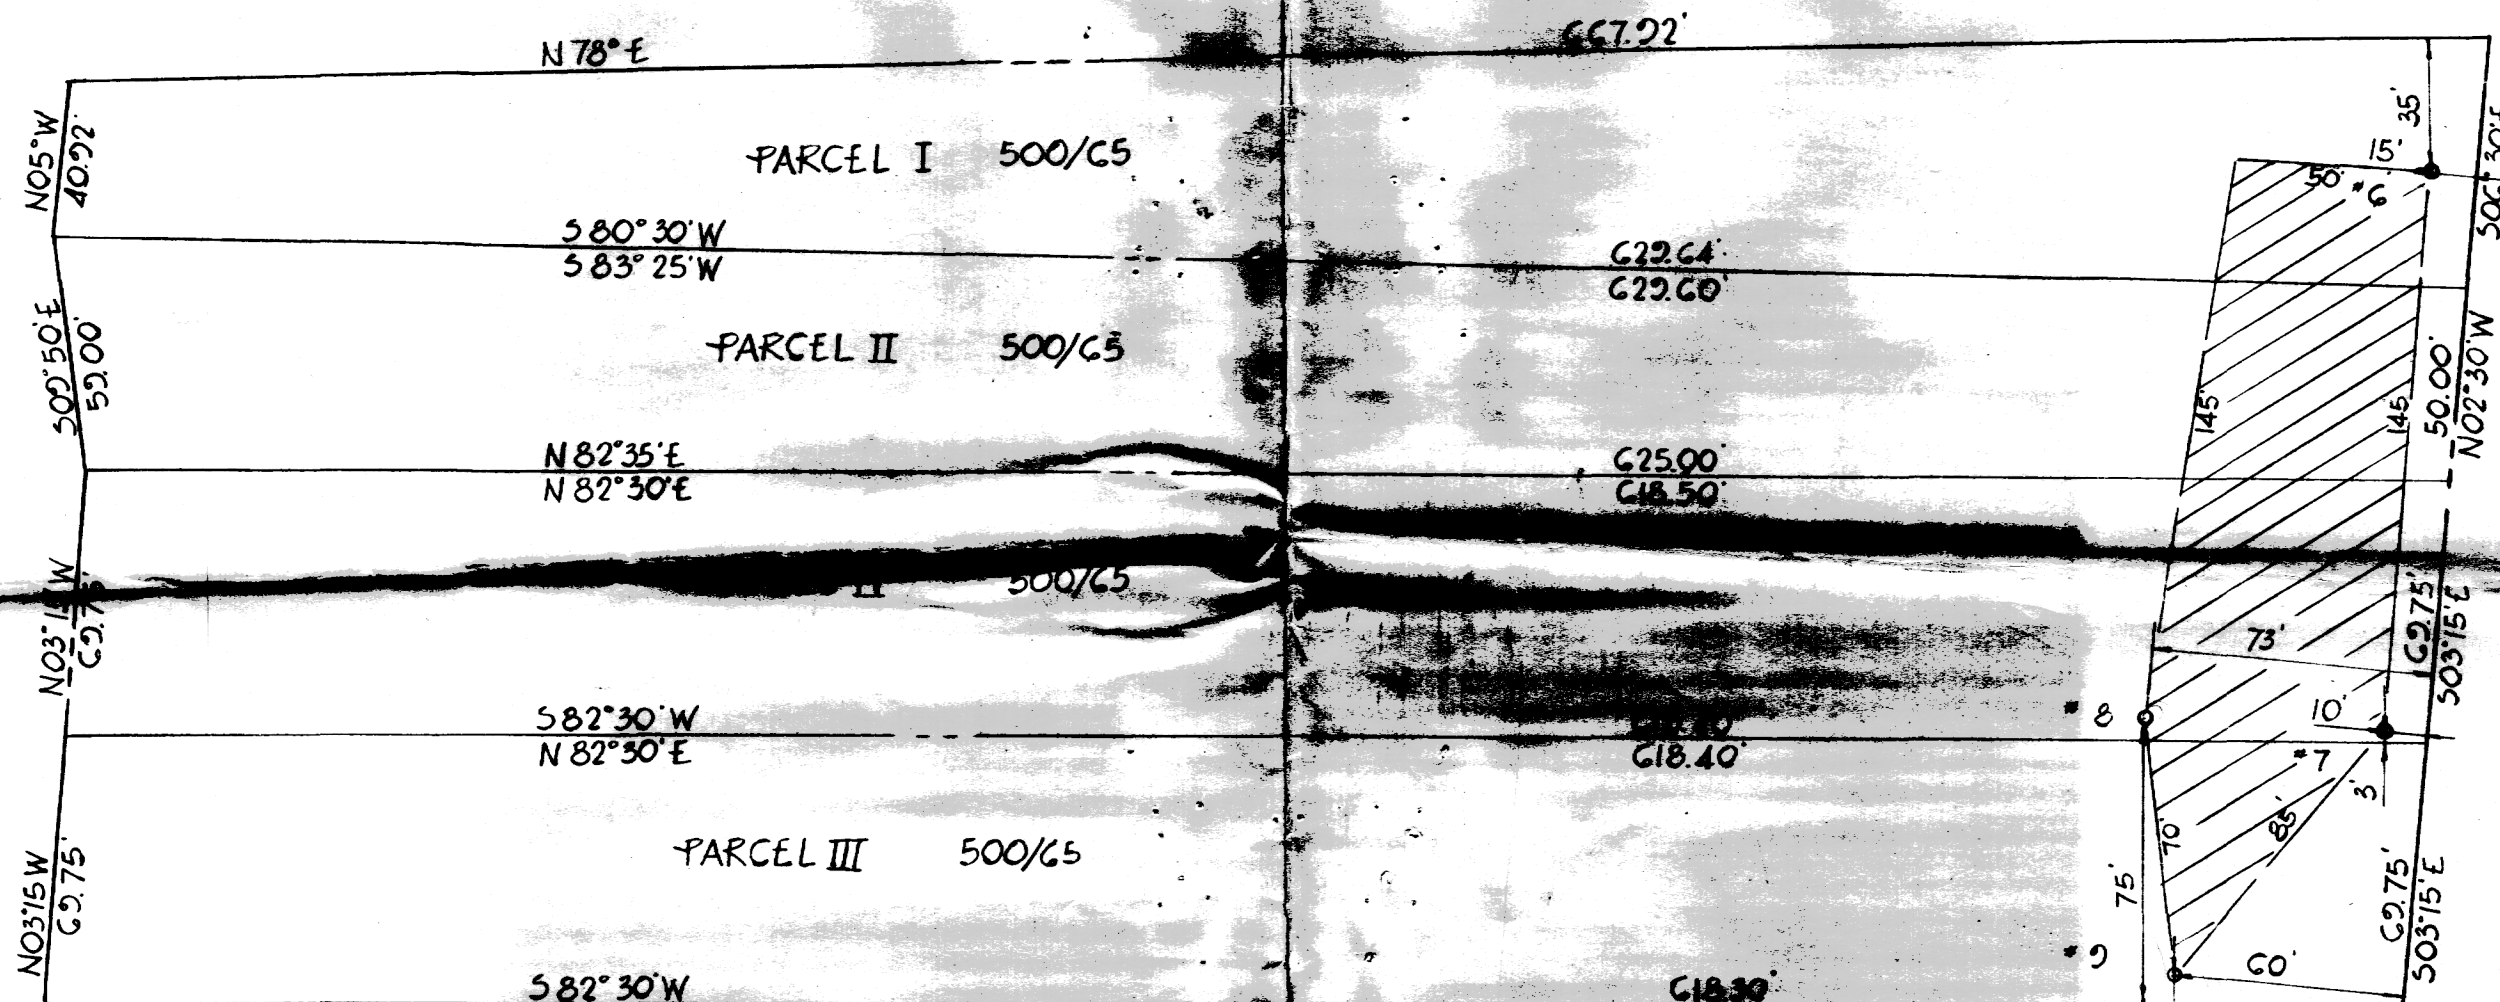

MARYLAND ROUTE #108
(FORMERLY MD. RTE. #175)

PERCOLATION TEST HOLES SHOWN
HEREON HAVE BEEN FIELD LOCATED.

THE PROPERTY SHOWN HEREON COMPLIES WITH THE MINIMUM OWNERSHIP AND LOT AREA AS REQUIRED BY THE MARYLAND STATE DEPARTMENT OF HEALTH AND MENTAL HYGIENE.

FISHER, COLLINS & CARTER, Inc.
Consulting Engineers & Land Surveyors
8388 Court Avenue
Ellicott City, Maryland 21043



PERCOLATION TEST LOCATION
PROPERTY OF
WILLIAM LAUPERT
FIRST ELECTION DISTRICT HOWARD COUNTY, MD.
SCALE: 1"=50' JULY 18, 1979