

02-263483

PERMIT

SEWAGE DISPOSAL SYSTEM

MARYLAND STATE DEPARTMENT OF HEALTH*

HOWARD COUNTY

ELLICOTT CITY

DISTRICT 2nd

INDEXED

DATE 4/26/79

Emerson Feaga

IS PERMITTED TO INSTALL X ALTERADDRESS Old Frederick Road, Woodstock, Md. 21163PHONE 465-5167SUBDIVISION Mt. HebronROAD 9432 Tiller DriveLOT 39 14, Sec. 16PROPERTY OWNER Thornbrook CorporationCHARLES and PAT MULLENADDRESS 2106 Mt. Hebron Drive, Ellicott City, Md.SPECIFICATIONS 3 bedrooms (2 bedrooms in house)SEPTIC TANK CAPACITY 1000 GALLONS

DRAIN FIELD _____ DEPTH _____ FEET, BOTTOM AREA _____ SQ. FT.

DEEP TRENCH _____ DEPTH _____ FEET, BOTTOM AREA _____ SQ. FT.

SEEPAGE PITS X ABSORBENT SIDE-WALL AREA 140 SQ. FT. sidewall area per bedroom.INLET PIPE 3 FT. BELOW ORIGINAL GRADE. MAXIMUM DEPTH 10 FT. BELOW ORIGINAL GRADE

EFFECTIVE DEPTH AT _____ FT. BELOW ORIGINAL GRADE.

LOCATE DISPOSAL AREA 100 FT. FROM front LOT LINE AND 20 FT. FROM right LOT LINE AS SEEN WHEN
FACING LOT FROM Tiller Drive.PLANS APPROVED BY Frank SkinnerDATE 12/13/78

COVER NO WORK UNTIL INSPECTED AND APPROVED.

NEITHER THE HOWARD COUNTY COUNCIL NOR THE HEALTH DEPARTMENT IS RESPONSIBLE FOR THE SUCCESSFUL OPERATION OF ANY SYSTEM.

NOTE: IF TRENCH IS USED CALL FOR INSPECTION BEFORE PLACING GRAVEL IN TRENCH.

NOTE: NO DRY WELL SHALL EXCEED 15 FOOT IN DIAMETER.

NOTE: ALL PIPE FROM HOUSE TO DISPOSAL AREA MUST BE CAST IRON.

PERMIT VOID AFTER THREE YEARS.

NOTE: INSTALL STAND PIPE ON SEPTIC TANK AND DRY WELL. STAND PIPES MUST BE 6 INCHES IN DIAMETER. CAST IRON, CONCRETE OR TERRA
COTTA ACCEPTED.

*INSTALLER IS RESPONSIBLE FOR OBTAINING FINAL APPROVAL ON THIS PERMIT.


OLD PERMIT SIGNED

AND RETURNED

5-2-97

Sent #B70105784
Sealed per instructions
Shirley

A 26764

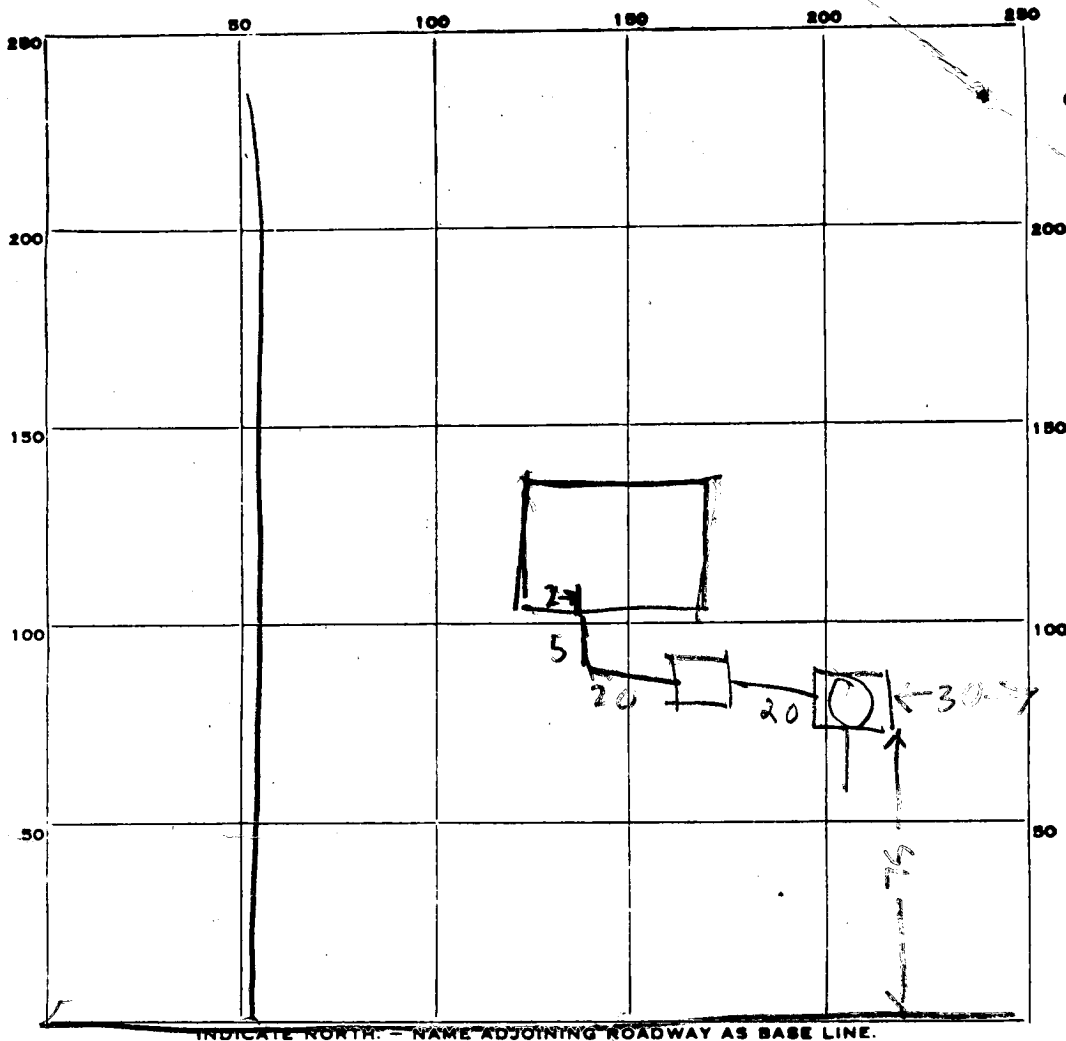

PERMIT CARD _____

SEPTIC TANK, LEVEL OK TOP 2 FT BELOW GRADE CLEANOUTS ST | DV
1000 GAL OK | OK

DISTRIBUTION BOX, LEVEL _____

TILE FIELD, DEPTH 10 FT. TRENCH WIDTH 2 1/2 FT.

GRAVEL DEPTH 7 IN. TOTAL LENGTH 10 FT.

NUMBER OF TRENCHES 1 TOTAL BOTTOM AREA 70

SEEPAGE PITS, INSIDE DIAMETER PERIMETER 59 FT. DEPTH BELOW INLET 7 FT.

ABSORBENT AREA 413 SQ. FT.

REMARKS 5/3/79 DRY WELL INLET 3 FT BELOW ORIGINAL
GRADE & 4 FT BELOW NEW GRADE
CITY WATER

DATE SYSTEM APPROVED 5/3/79 INSPECTOR Raymond Hodges

PRELIMINARY

APPLICATION

A 26764

SEWAGE DISPOSAL TESTING

P. _____

STATE OF MARYLAND - DEPARTMENT OF HEALTH AND MENTAL HYGIENE

HOWARD COUNTY HEALTH DEPARTMENT 3 B.R. 4 B.R. DISTRICT 2nd
 ENVIRONMENTAL HEALTH SERVICES 1000 gal. septic tank 1250 gal. septic tank DATE 8/19/77
 P. O. BOX 476, ELLICOTT CITY, MARYLAND 21043 Drywell (or Drywell and trench if 4 Bedroom)
 TELEPHONE: 465-5000, EXT. 356

to have 140 SQ. FT. effective sidewall absorption area per bedroom to begin below the first 3 ft. of non-porous soil. Maximum depth permitted for drywell or trench is 10 ft. below original grade. Place the drywell ¹⁰⁰125 ft. from the front lot line and ²⁰25 ft. from the right side line as seen when facing the property from Tiller Drive.

TO: THE COUNTY HEALTH OFFICER
 ELLICOTT CITY, MARYLAND

I, HEREBY, APPLY FOR THE NECESSARY TEST IN ORDER TO CONSTRUCT (OR RECONSTRUCT) A SEWAGE DISPOSAL SYSTEM.

PROPERTY OWNER Thornbrook Corporation

ADDRESS 2106 Mt. Hebron Drive, Ellicott City, Md. PHONE 465-2869

PROPERTY LOCATION:

SUBDIVISION Mt. Hebron LOT NO. 14, Sec. 16

ROAD AND DESCRIPTION 9432 Tiller Drive

SIZE OF LOT 28,000 sq. ft. TYPE BLDG. 3 or 4 bedrooms

NUMBER OF BEDROOMS

IF NOT SINGLE RESIDENCE DESCRIBE _____

THE SYSTEM INSTALLED UNDER THIS APPLICATION IS ACCEPTABLE ONLY UNTIL PUBLIC FACILITIES BECOME AVAILABLE.

SIGNATURE OF APPLICANT /s/ H. J. Baker, Jr. BLDG. PERMIT SIGNED AND RETURNED 2/9/79
Serial No. 38366


APPROVED BY Frank Skinner FOR drywell (+ trench) DATE 12/13/78
 (KIND OF SYSTEM)

REJECTED BY _____ FOR _____ DATE _____
 (KIND OF SYSTEM)

HOLD PENDING FURTHER TESTS _____ DATE _____

REASONS FOR REJECTION OR HOLDING _____

THIS IS NOT A PERMIT

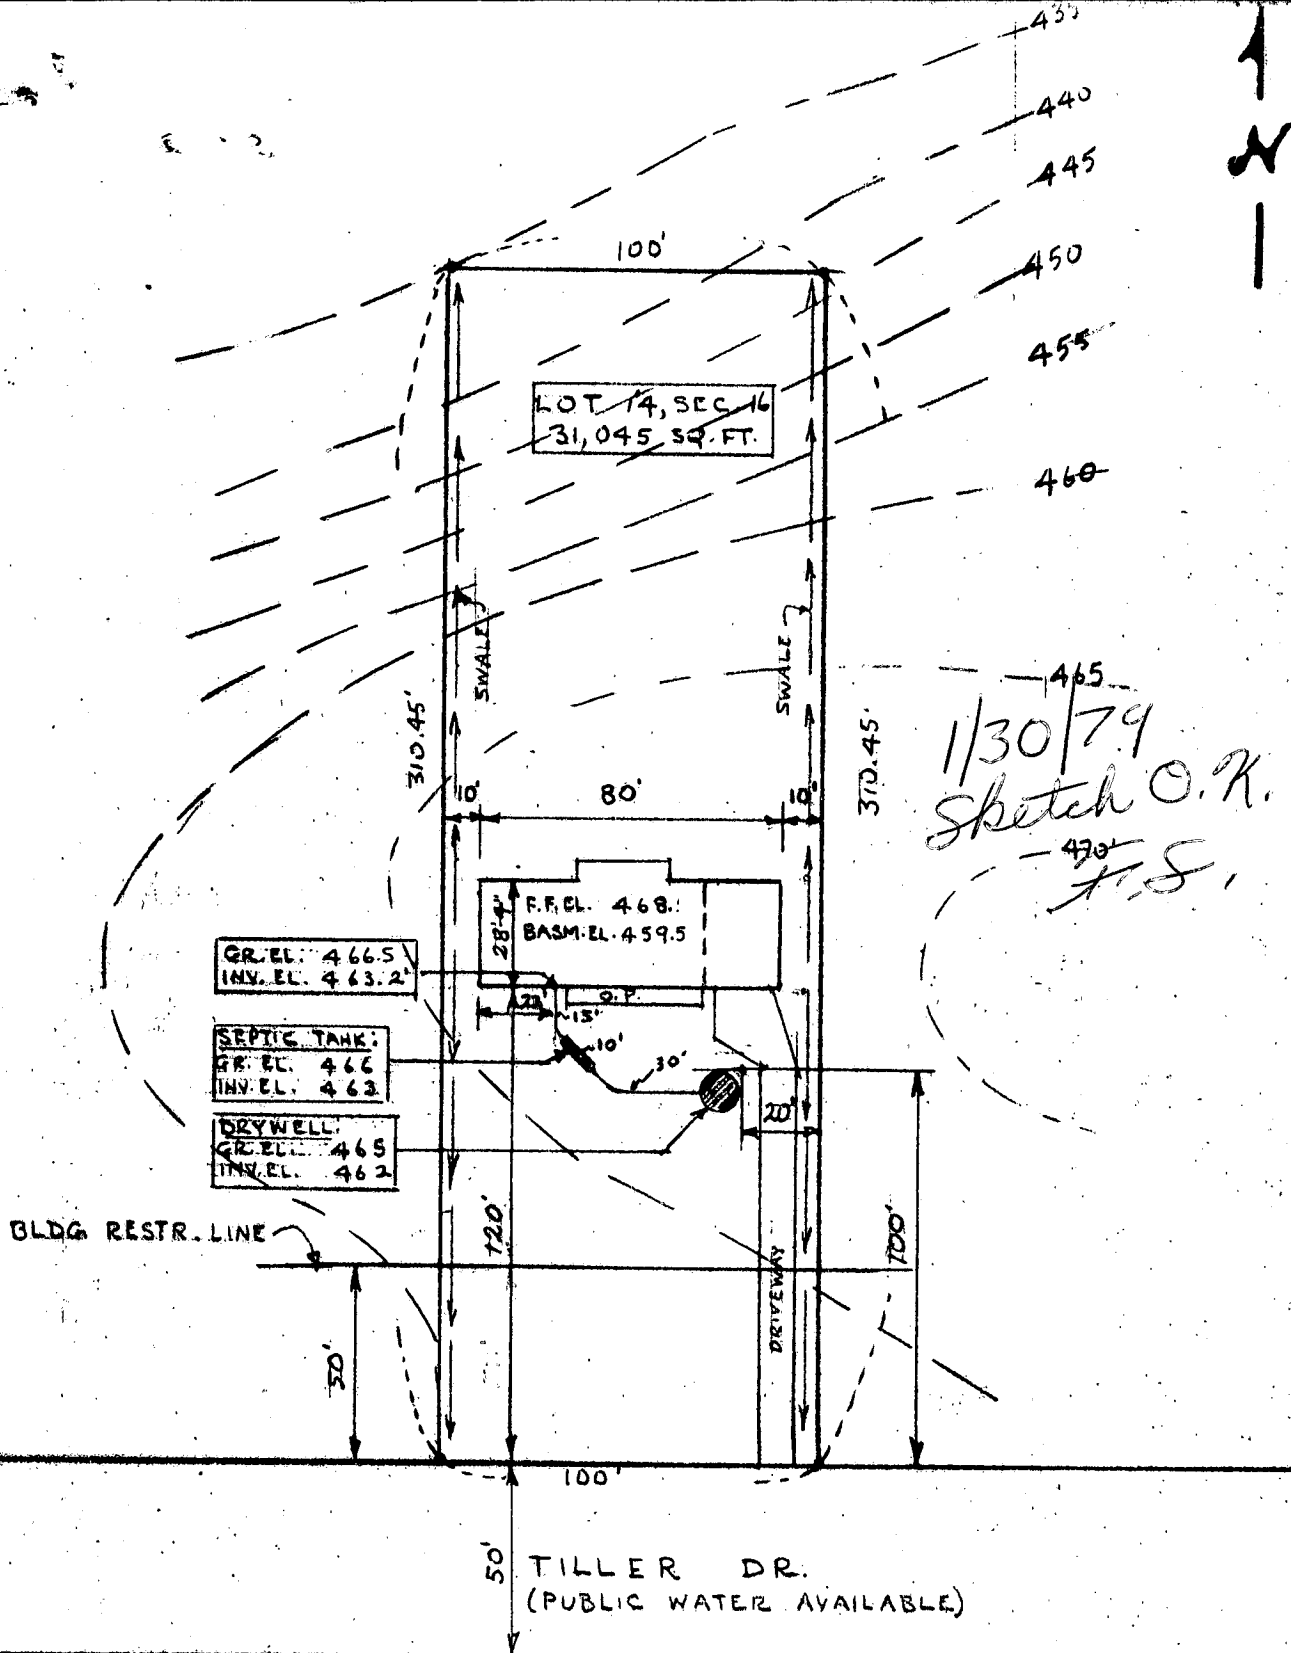

9432 TILLER DR.
"MT. HEBRON"

PREPARED BY: C. N. BURGESS - 465-9044 OR
CALL H. J. BAKER - 465-2869
THORNBROOK CORP.
2106 MT. HEBRON DR.
ELICOTT CITY, MD.


SCALE: 1"=50'
PARR RES.

JAN. 30, 1979

properly known as

LOT 39
9432 TILLETZ DRIVE
MT. HEBRON SECTION 15
2ND ELECTION DISTRICT PLAT NO. 5239
HOWARD COUNTY, MARYLAND

THIS PLAT CAN NOT BE USED TO ESTABLISH PROPERTY LINES OR CORNERS.

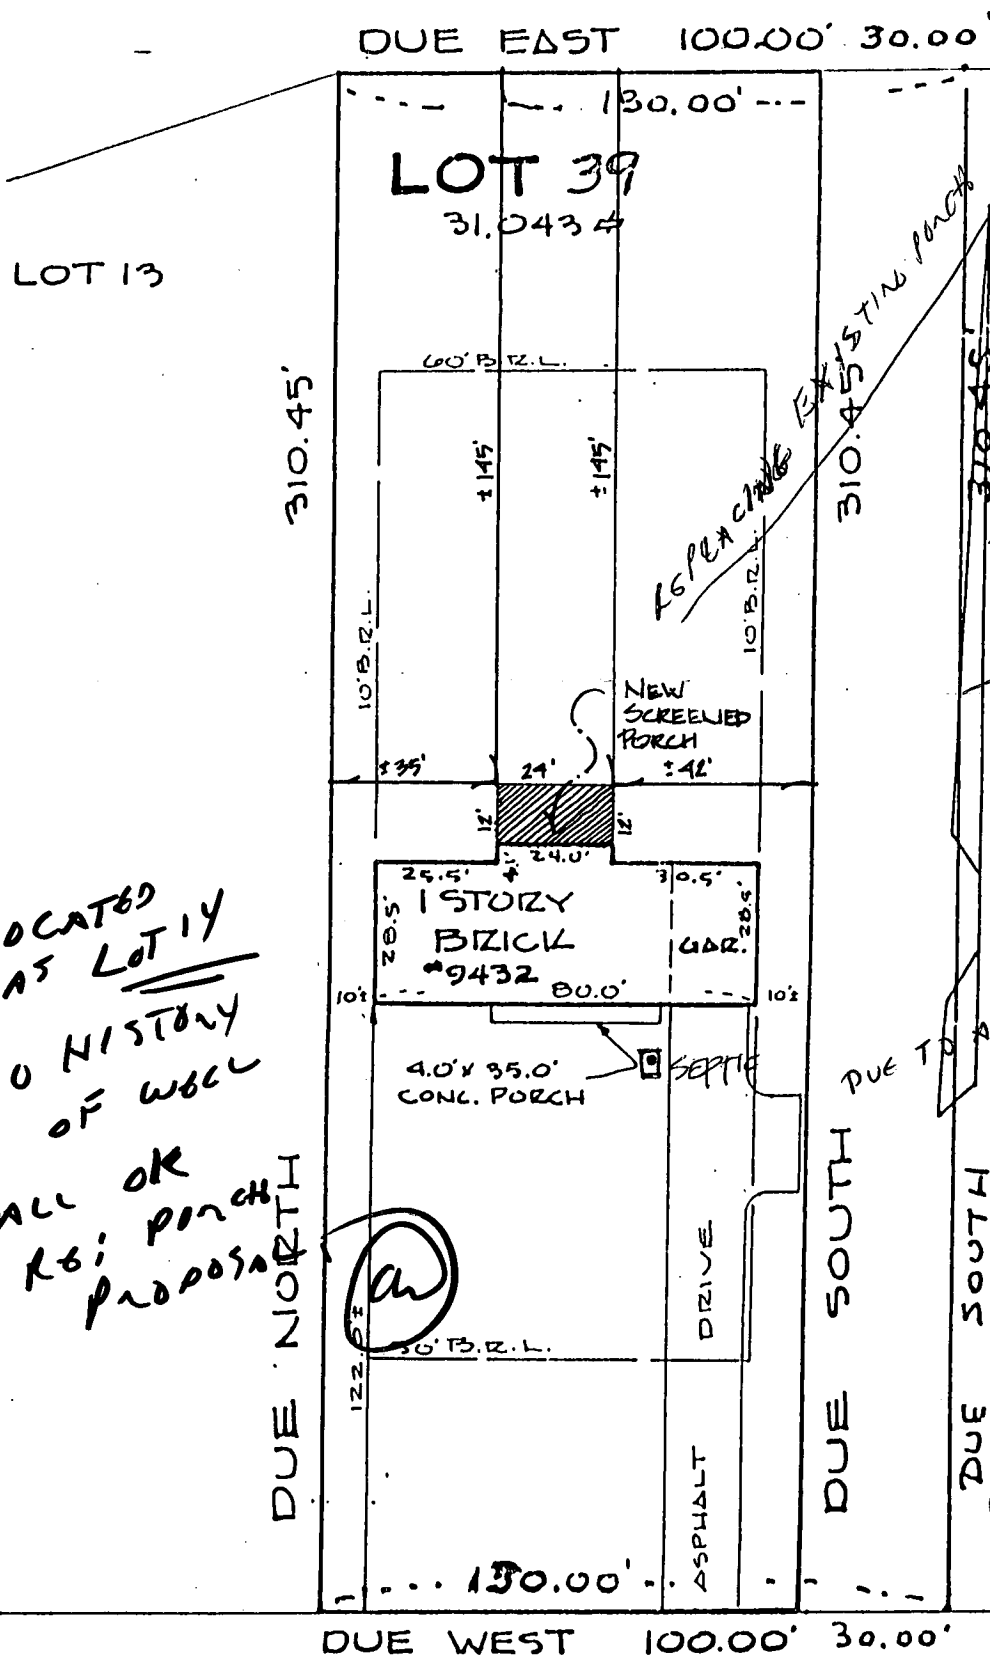

* LOCATED AS LOT 14
NO HISTORY OF WELL
ALL OK
RE: PORCH PROPOSAL

BOO105084
OK TO PROCEED
C. J. Hill
NO IMPACT TO SEPTIC
IS ON PUBLIC WATER AT THIS TIME,
BUT UNCLEAR IF PROPERTY WAS ORIGINALLY SERVED BY WELL OR NOT
AGE - WELL WOULD HAVE BEEN BELOW GRADE.
NO REASONABLE METHOD TO CONFIRM PROPER ABANDONMENT IF A WELL EVER EXISTED
(ONLY REASON FOR ALL THIS CONCERN IS THAT MOST PROBABLE LOCATION FOR WELL WOULD BE WHERE PORCH IS LOCATED)

LOCATION SURVEY PLAT

CERTIFICATION	SEAL	SCALE 1"=40' DATE 9-4-86
is to certify that I have surveyed properly known as: LOT 39 9432 TILLETZ DRIVE		PHONE: 828-9060 TOWSON 730-9060 COLUMBIA HUDKINS ASSOCIATES, INC. Surveyors and Subdivision Designers SUITE 231, JOSEPH SQUARE 5485 HARPERS FARM ROAD COLUMBIA, MARYLAND 21044 # 5539