

11/12/80

11/12/80 File
APPROVED
C.B.R.

PERMIT

P 31014
A 26770

SEWAGE DISPOSAL SYSTEM

MARYLAND STATE DEPARTMENT OF HEALTH

HOWARD COUNTY

ELLICOTT CITY

INDEXED

DISTRICT 2nd

02-263521

DATE 11/6/80

Emerson Feaga IS PERMITTED TO INSTALL X ALTER

ADDRESS Old Frederick Road, Woodstock, Md. 21163 PHONE 465-5167

SUBDIVISION Mt. Hebron ROAD 9429 Tiller Drive LOT 18, Sec. 16

PROPERTY OWNER Thornbrook Corporation Chuck + Debbie DiVenti

ADDRESS 2106 Mt. Hebron Drive, Ellicott City, Md. 21043 Phone: 465-2869

SPECIFICATIONS 3 bedrooms

SEPTIC TANK CAPACITY 1000 GALLONS

DRAIN FIELD _____ DEPTH _____ FEET, BOTTOM AREA _____ SQ. FT.

DEEP TRENCH _____ DEPTH _____ FEET, BOTTOM AREA _____ SQ. FT.

SEEPAGE PITS _____ ABSORBENT SIDE-WALL AREA _____ SQ. FT.

INLET PIPE _____ FT. BELOW ORIGINAL GRADE. MAXIMUM DEPTH _____ FT. BELOW ORIGINAL GRADE

EFFECTIVE DEPTH AT _____ FT. BELOW ORIGINAL GRADE.

LOCATE DISPOSAL AREA _____ FT. FROM _____ LOT LINE AND _____ FT. FROM _____ LOT LINE AS SEEN WHEN
FACING LOT FROM

TRENCHES - Inlet maximum 4 ft.; total depth maximum 8 ft. below original grade. Trenches to start 195 ft. from rear property line and 15 ft. from left property line and running ~~towards~~ on a constant elevation more or less parallel with the left side line toward the rear lot line. 150 sq. ft. per bedroom. 4 ft. of stone under the pipe - trenches minimum 8 ft. apart. Inspection of trench ~~half~~ before stone is added and after stone is added.

PLANS APPROVED BY Fred Frommelt DATE 7/21/80

COVER NO WORK UNTIL INSPECTED AND APPROVED.

NEITHER THE HOWARD COUNTY COUNCIL NOR THE HEALTH DEPARTMENT IS RESPONSIBLE FOR THE SUCCESSFUL OPERATION OF ANY SYSTEM.

NOTE: IF TRENCH IS USED CALL FOR INSPECTION BEFORE PLACING GRAVEL IN TRENCH.

NOTE: NO DRY WELL SHALL EXCEED 15 FOOT IN DIAMETER.

NOTE: ALL PIPE FROM HOUSE TO DISPOSAL AREA MUST BE CAST IRON.

PERMIT VOID AFTER THREE YEARS.

NOTE: INSTALL STAND PIPE ON SEPTIC TANK AND DRY WELL. STAND PIPES MUST BE 6 INCHES IN DIAMETER. CAST IRON, CONCRETE OR TERRA COTTA ACCEPTED.

*INSTALLER IS RESPONSIBLE FOR OBTAINING FINAL APPROVAL ON THIS PERMIT.

BLDG. PERMIT SIGNED
AND RETURNED 5/17/91
Serial # 37862 - pruch

A 26770

PRELIMINARY

APPLICATION

lot. 18

A 26770

P _____

SEWAGE DISPOSAL TESTING

STATE OF MARYLAND - DEPARTMENT OF HEALTH AND MENTAL HYGIENE

HOWARD COUNTY HEALTH DEPARTMENT
ENVIRONMENTAL HEALTH SERVICES

DISTRICT 2nd

P. O. BOX 476, ELLICOTT CITY, MARYLAND 21043
TELEPHONE: 465-5000, EXT. 356

DATE 8/22/77

5 to 100 gal.
A.R. 1250 gal.

trenches: inlet max. 4 ft; total depth max. 8 ft below original grade
 starting 195 ft. from rear property line and running on a constant
 elevation more or less parallel with the left side line
 toward the rear lot line, 150 sq. ft. per. below

TO: THE COUNTY HEALTH OFFICER
ELLICOTT CITY, MARYLAND

4' stone under the pipe - trenches min. 8' apart
 in sp. of trench before stone added

I, HEREBY, APPLY FOR THE NECESSARY TEST IN ORDER TO CONSTRUCT (OR RECONSTRUCT) A SEWAGE
DISPOSAL SYSTEM.

BLDG. PERMIT SIGNED
 AND RETURNED 8/15/80
 Serial # 43983

PROPERTY OWNER Thornbrook CorporationADDRESS 2106 Mt. Hebron Drive, Ellicott City, Md.PHONE 465-2869

PROPERTY LOCATION:

SUBDIVISION Mt. HebronLOT NO. 18, Sec. 16ROAD AND DESCRIPTION Tiller DriveSIZE OF LOT 34,100 sq. ft.

TYPE BLDG. 3 or 4 bedrooms
 NUMBER OF BEDROOMS

IF NOT SINGLE RESIDENCE DESCRIBE _____

THE SYSTEM INSTALLED UNDER THIS APPLICATION IS ACCEPTABLE ONLY UNTIL PUBLIC
FACILITIES BECOME AVAILABLE.SIGNATURE OF APPLICANT /s/ H. J. Baker, Jr.

APPROVED BY Fred Frommelt FOR Trenches DATE 7/21/80
 (KIND OF SYSTEM)


REJECTED BY _____ FOR _____ DATE _____
 (KIND OF SYSTEM)

HOLD PENDING FURTHER TESTS _____ DATE _____

REASONS FOR REJECTION OR HOLDING _____

THIS IS NOT A PERMIT

Lot #18

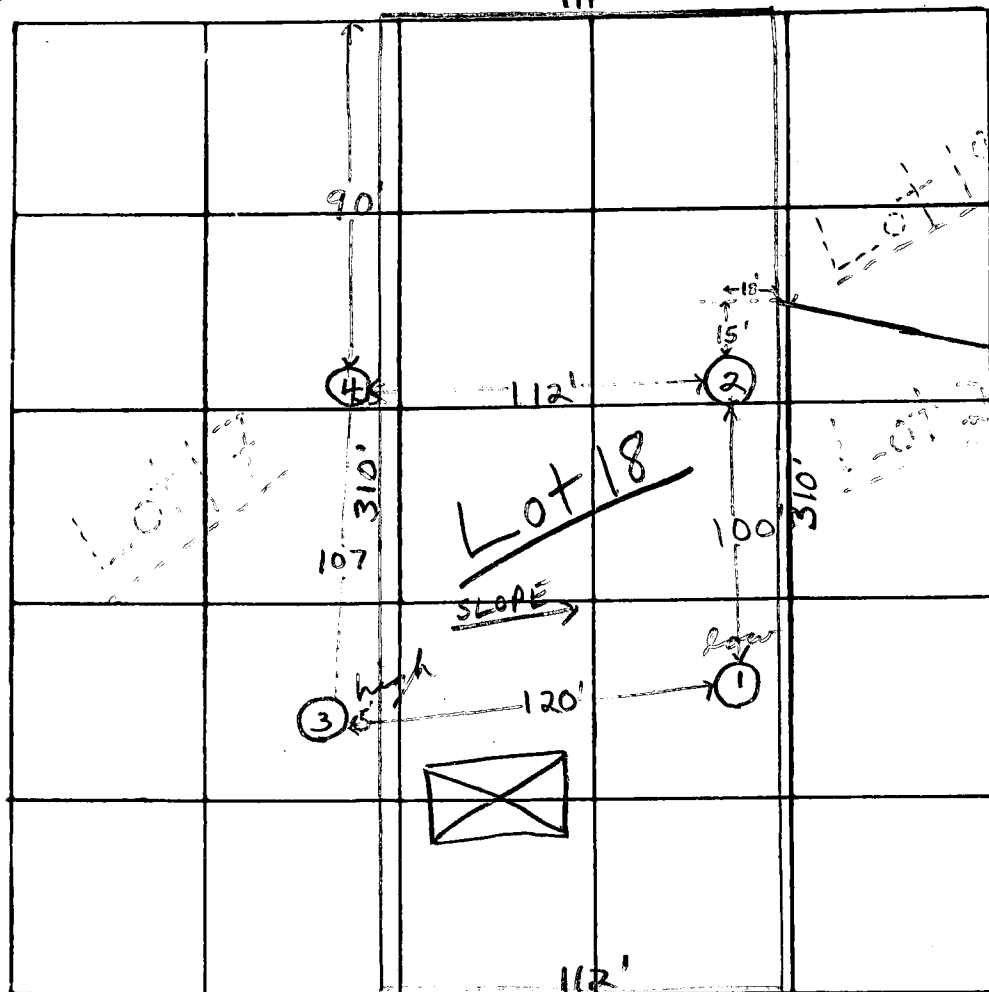

OK.

INDICATE NORTH - NAME ADJOINING ROADWAY AS BASE LINE

Tiller Drive

DATE	TEST NO.	DEPTH	PRE-WET		TEST - 1" DROP		TIME
			START	STOP	START	STOP	
9/7/77	1 low	4 1/2'	10:41	10:42	10:42	10:44	2 min
	1A	11'	Packed sandy loam to sand below				
	2	11'	Clayey to 4' mixed 4-7' sandy loam below				
	3 high	4	10:22	10:27	10:27	10:48	21 min
	3A	11 1/2'	10:20	10:24	10:24	10:32	8 min
	4	5 1/2'	10:33	—	—	10:45	~9 min
	4A	12'	10:32	10:46	10:46	11:20	34 min


clayey to 3'
harder at 11'
below
net 3 1/2'

REMARKS Lot 18 0 & 10 - same elevation

TYPE OF SOIL sandy loam below top 3-4' clayey soil

TESTED BY F.S.

ALSO PRESENT: H.J. Baker & Co. (E.F. Co.)

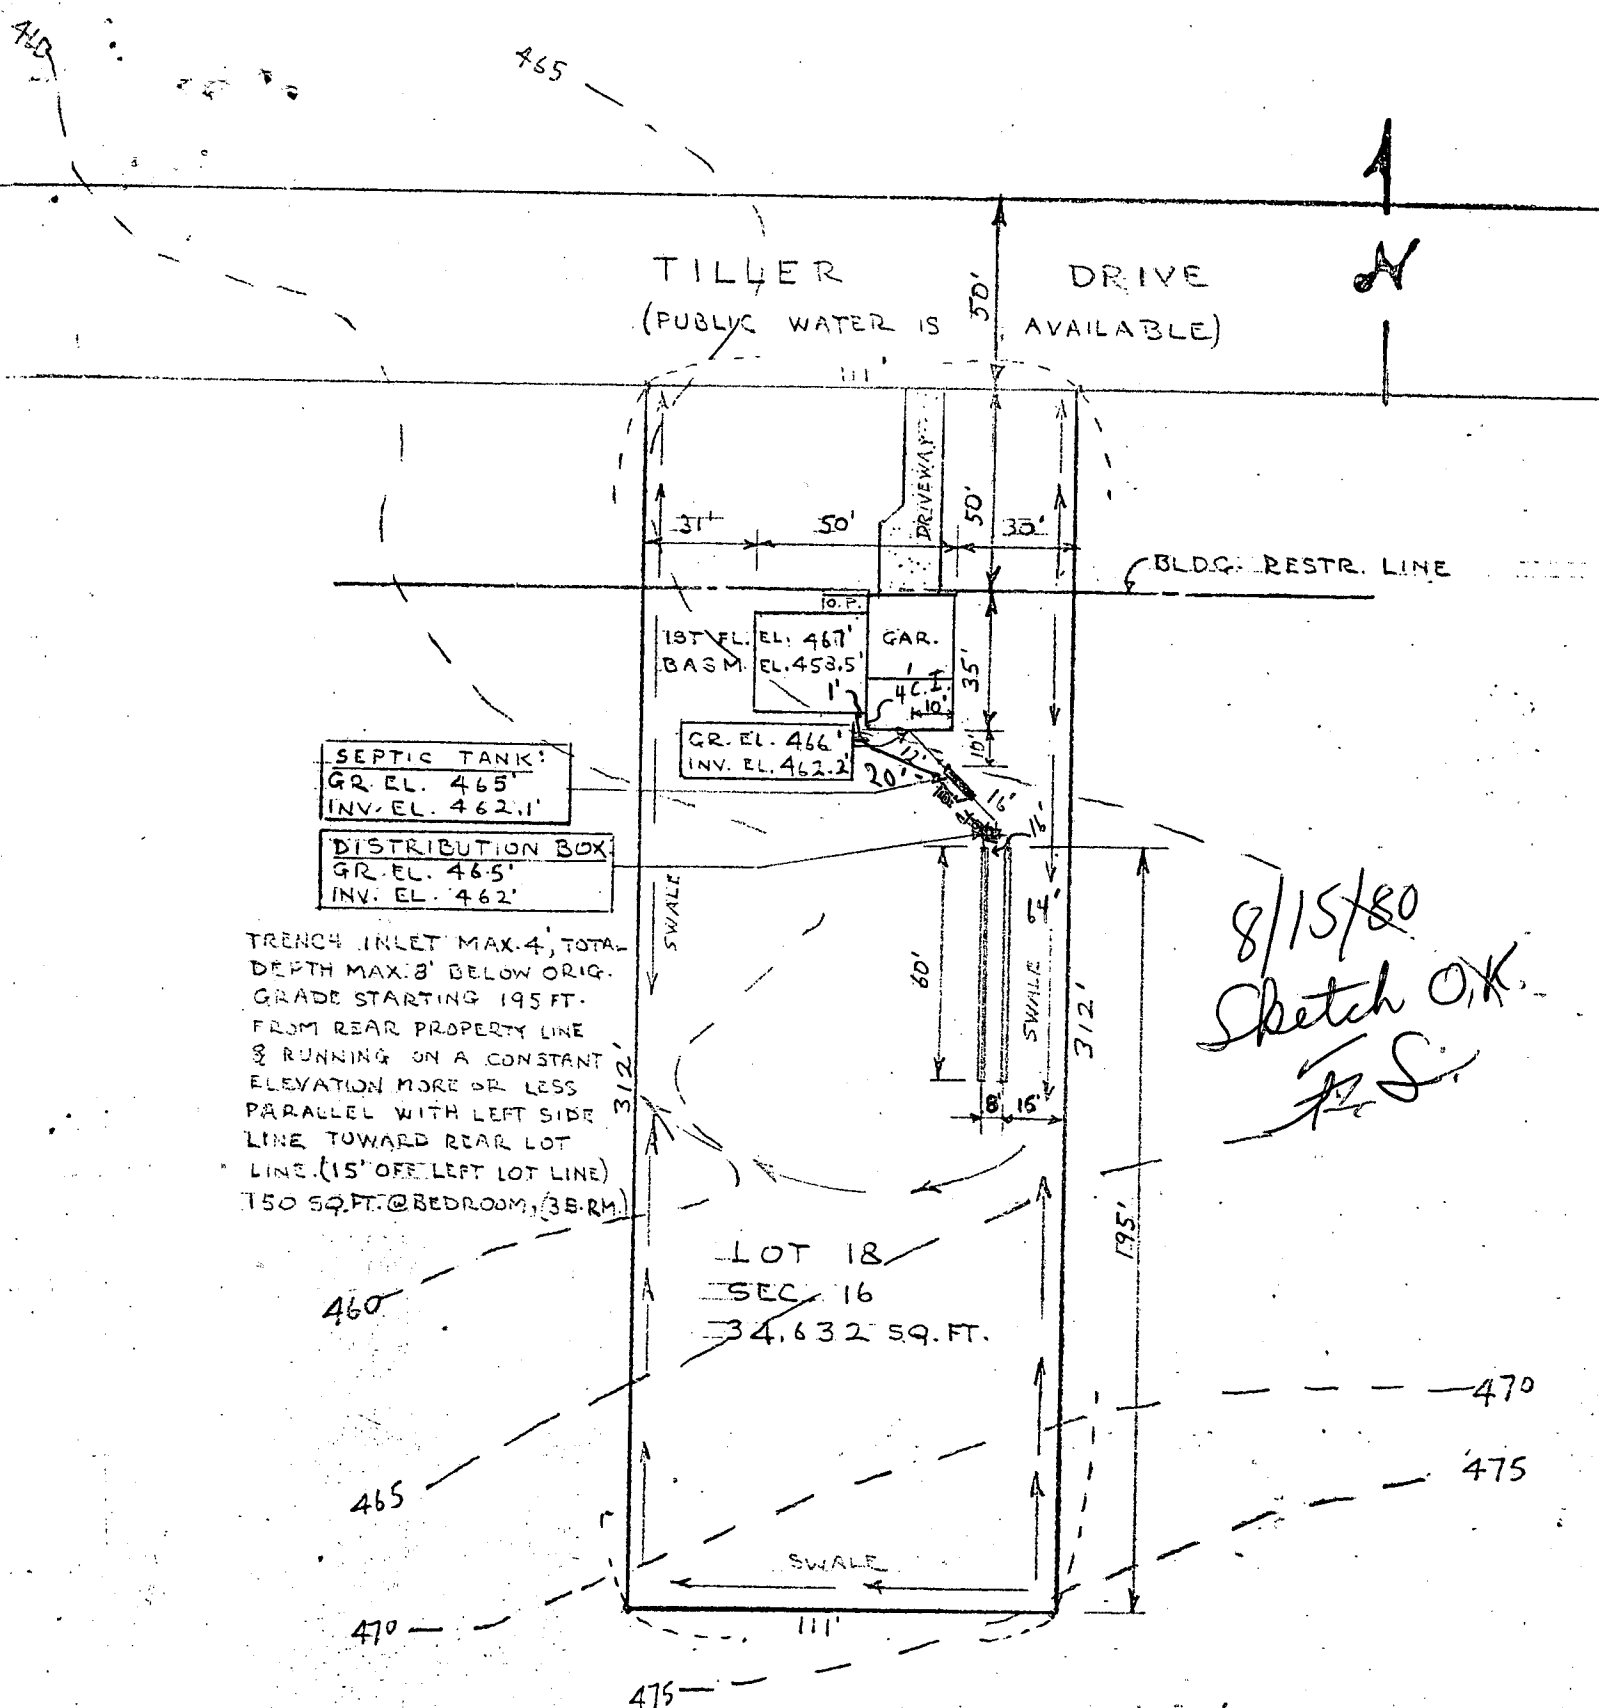

9429 TILLER DR.
"MT. HEBRON"

PREPARED BY: THORNBROOK CORP.
H.J. BAKER 465-2869
2106 MT. HEBRON DR.
ELLICOTT CITY, MD.

SCALE: 1" = 50'

AUG. 4, 1980
REV. AUG. 12, 1980

