

PERMIT

SEWAGE DISPOSAL SYSTEM

P 27208

A

MARYLAND STATE DEPARTMENT OF HEALTH

HOWARD COUNTY

03-295761

ELLICOTT CITY

DISTRICT 3rd

DATE 11/14/77

INDEXED

~~12/13/77~~
~~on no please~~
12/16/77 around 100
file WWB
Selzak Construction

IS PERMITTED TO INSTALL ALTER X

ADDRESS 1408 Woodbridge Rd.

PHONE 747-1785

(2-3 PM)

A SEWAGE DISPOSAL SYSTEM LOCATED AT

SUBDIVISION Shepherds Glen

ROAD 3813 Walt-Ann Dr.

LOT 1

PROPERTY OWNER Daniel Shaner

ADDRESS Same as above

SPECIFICATIONS 3 bedrooms

DRAIN FIELD DEPTH FEET, BOTTOM AREA SQ. FT.

SEEPAGE PITS ABSORBENT SIDE-WALL AREA SQ. FT.

SEPTIC TANK CAPACITY 1000 GALLONS

FOR GARBAGE GRINDER, INCREASE DISPOSAL AREA 22% & TANK CAPACITY 50%.

OTHER NOTE: CALL FOR INSPECTION WHEN GROUND IS OPENED UP AND SANITARIAN WILL RECOMMEND REPAIR SYSTEM.

Trench 62' between ST & DB, run parallel to house from left corner as seen from Walt-Ann Dr., depths same as in option #1 of order TSO


PLANS APPROVED BY Palmer F. Wine

DATE 11/14/77

FILL SEPTIC TANK AND DISTRIBUTION BOX WITH WATER BEFORE CALLING FOR AN INSPECTION. COVER NO WORK UNTIL INSPECTED AND APPROVED.

NEITHER THE HOWARD COUNTY COMMISSIONERS NOR THE HEALTH DEPARTMENT IS RESPONSIBLE FOR THE SUCCESSFUL OPERATION OF ANY SYSTEM.

Repair
12/27/208

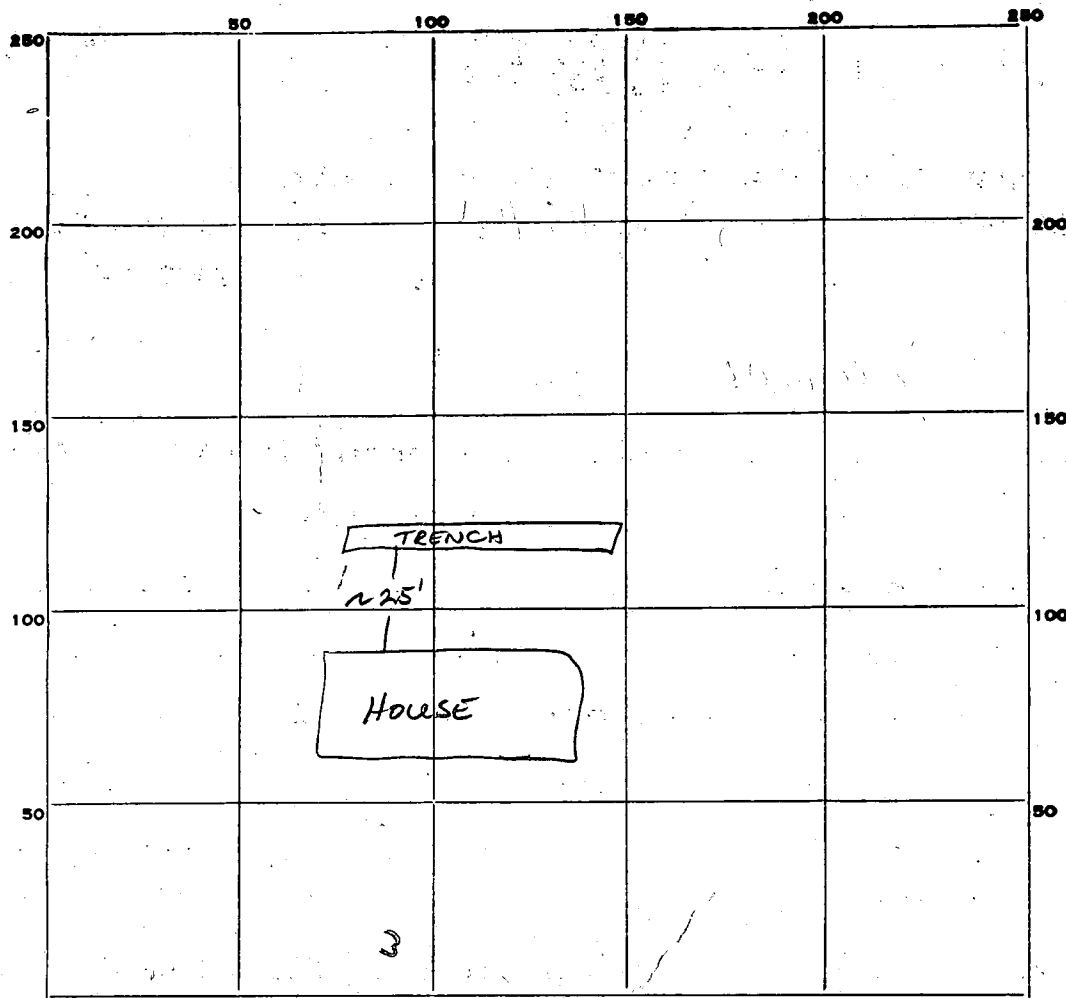

INDICATE NORTH. - NAME ADJOINING ROADWAY AS BASE LINE.

PERMIT CARD ^{12/13} ✓ Verbal to owner & Contractor

SEPTIC TANK, LEVEL _____

CLEANOUTS _____

DISTRIBUTION BOX, LEVEL _____

TILE FIELD, DEPTH 9-9 1/2 FT. TRENCH WIDTH 2 FT.

GRAVEL DEPTH 5-6 FT. TOTAL LENGTH 65 FT.

NUMBER OF TRENCHES 1 TOTAL ^{SIDEWALL} BOTTOM AREA 357 ~~sq~~

SEEPAGE PITS, INSIDE DIAMETER _____ FT. DEPTH BELOW INLET _____ FT.

ABSORBENT AREA _____ SQ. FT.

REMARKS 12/13/77 T.S.D. Trench OK to add stone & pipe
12/15/77 T.S.D. Stone & pipe OK - Finish covering pipe w/ stone, cover
w/ building paper & call for final
12/16/77 Stone and heavy bldg paper installed. OK to cover WWZ

DATE SYSTEM APPROVED 12/16/77

INSPECTOR A. H. Zupp

OLD

ROLLING RD.


N 57° 45' W 522.72'

30' R/W

11' STONE RD.



Sourabh Munshi.

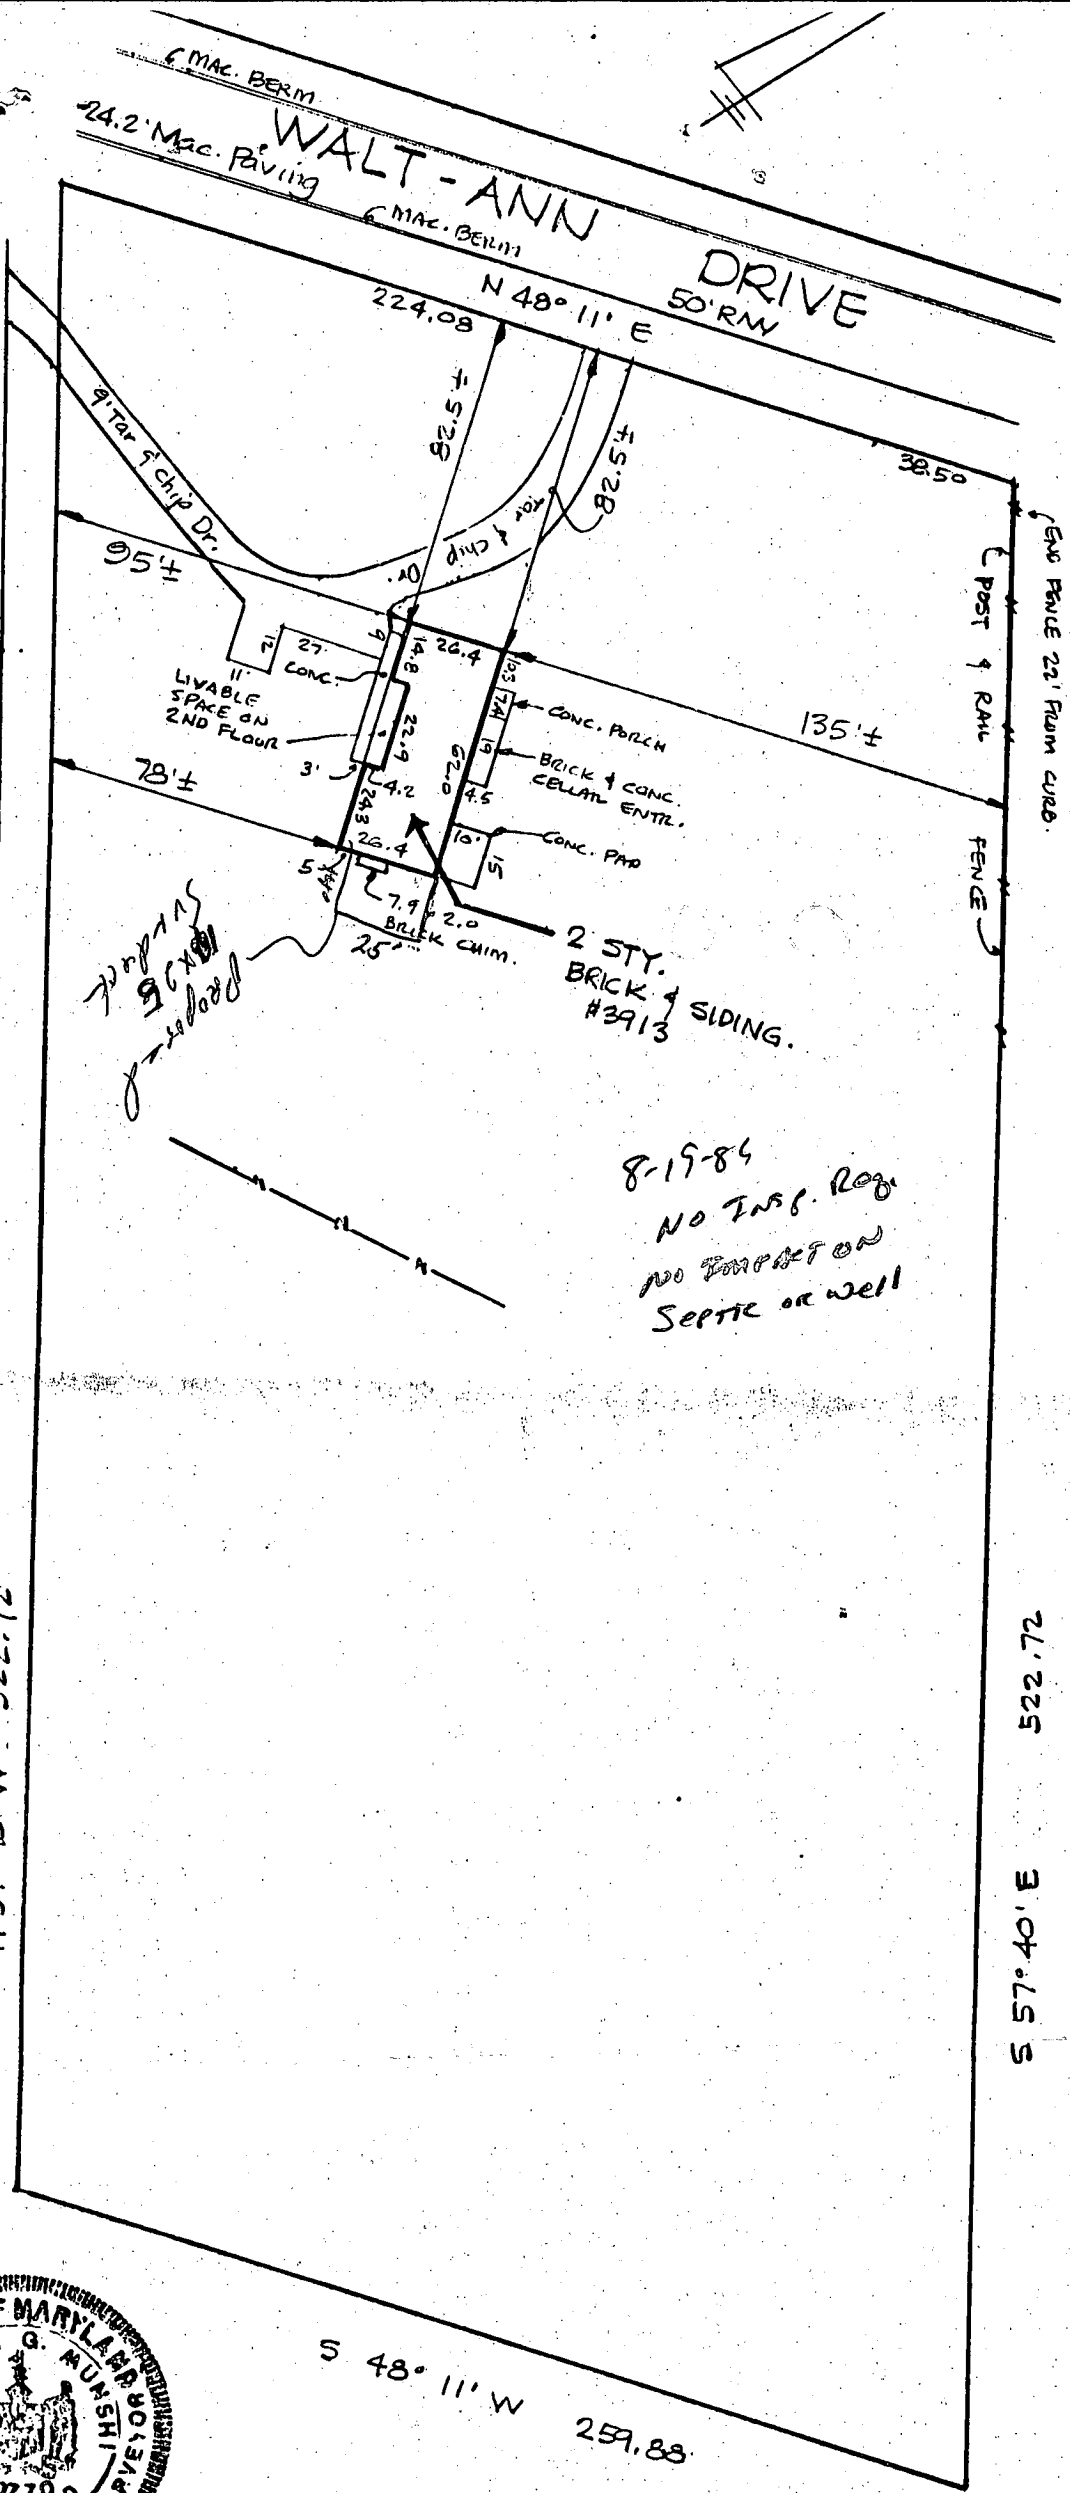

DON LYNCH ASSOC. INC.

4907 HARTFORD ROAD

BALTIMORE, MD 21204