

4/18/78 P.C.O. Ver
C.B.D.

4/17/78
afternoon please
4/18/78
a.m. please

PERMIT

SEWAGE DISPOSAL SYSTEM

MARYLAND STATE DEPARTMENT OF HEALTH*

HOWARD COUNTY

05-377978

ELLICOTT CITY

DISTRICT 5th

P 27820

A Repair

4/19/79 P.C.O.

Verboon
C.B.D.

[INDEXED]

0760/414
22 Mar. 76

DATE 4/14/78

Jack Fyock

IS PERMITTED TO INSTALL _____ ALTER X

ADDRESS _____

PHONE _____

SUBDIVISION _____

ROAD _____

14023
Triadelphia Mill Rd.

LOT _____

PROPERTY OWNER _____

McDonald
O'Donnell

Wayton to Green Bridge - make
left - come to top of hill
on right. Old Green house near
road.

ADDRESS _____

SPECIFICATIONS

SEPTIC TANK CAPACITY _____ GALLONS

DRAIN FIELD _____ DEPTH _____ FEET, BOTTOM AREA _____ SQ. FT.

DEEP TRENCH _____ DEPTH _____ FEET, BOTTOM AREA _____ SQ. FT.

SEEPAGE PITS _____ ABSORBENT SIDE-WALL AREA _____ SQ. FT.

INLET PIPE _____ FT. BELOW ORIGINAL GRADE. MAXIMUM DEPTH _____ FT. BELOW ORIGINAL GRADE

EFFECTIVE DEPTH AT _____ FT. BELOW ORIGINAL GRADE.

LOCATE DISPOSAL AREA _____ FT. FROM _____ LOT LINE AND _____ FT. FROM _____ LOT LINE AS SEEN WHEN
FACING LOT FROM

REPAIR - CALL FOR APPOINTMENT WHEN GROUND IS OPENED UP AND SANITARIAN WILL RECOMMEND
REPAIR SYSTEM.

PLANS APPROVED BY Palmer F. Wine

DATE 4/14/78

COVER NO WORK UNTIL INSPECTED AND APPROVED.

NEITHER THE HOWARD COUNTY COUNCIL NOR THE HEALTH DEPARTMENT IS RESPONSIBLE FOR THE SUCCESSFUL OPERATION OF ANY SYSTEM.

NOTE: IF TRENCH IS USED CALL FOR INSPECTION BEFORE PLACING GRAVEL IN TRENCH.

NOTE: NO DRY WELL SHALL EXCEED 15 FOOT IN DIAMETER.

NOTE: ALL PIPE FROM HOUSE TO DISPOSAL AREA MUST BE CAST IRON.

PERMIT VOID AFTER THREE YEARS.

NOTE: INSTALL STAND PIPE ON SEPTIC TANK AND DRY WELL. STAND PIPES MUST BE 6 INCHES IN DIAMETER. CAST IRON, CONCRETE OR TERRA
COTTA ACCEPTED.

*INSTALLER IS RESPONSIBLE FOR OBTAINING FINAL APPROVAL ON THIS PERMIT.

HD - 23

4/19/79 File

unapproved & uninspected file.


BLDG. PERMIT SIGNED
AND RETURNED 4/27/85

Serial # 64319 addition to Storage Shed

BLDG. PERMIT SIGNED
AND RETURNED 9/17/81
Serial # 44329
Storage Shed

P 27820

C.B.D.

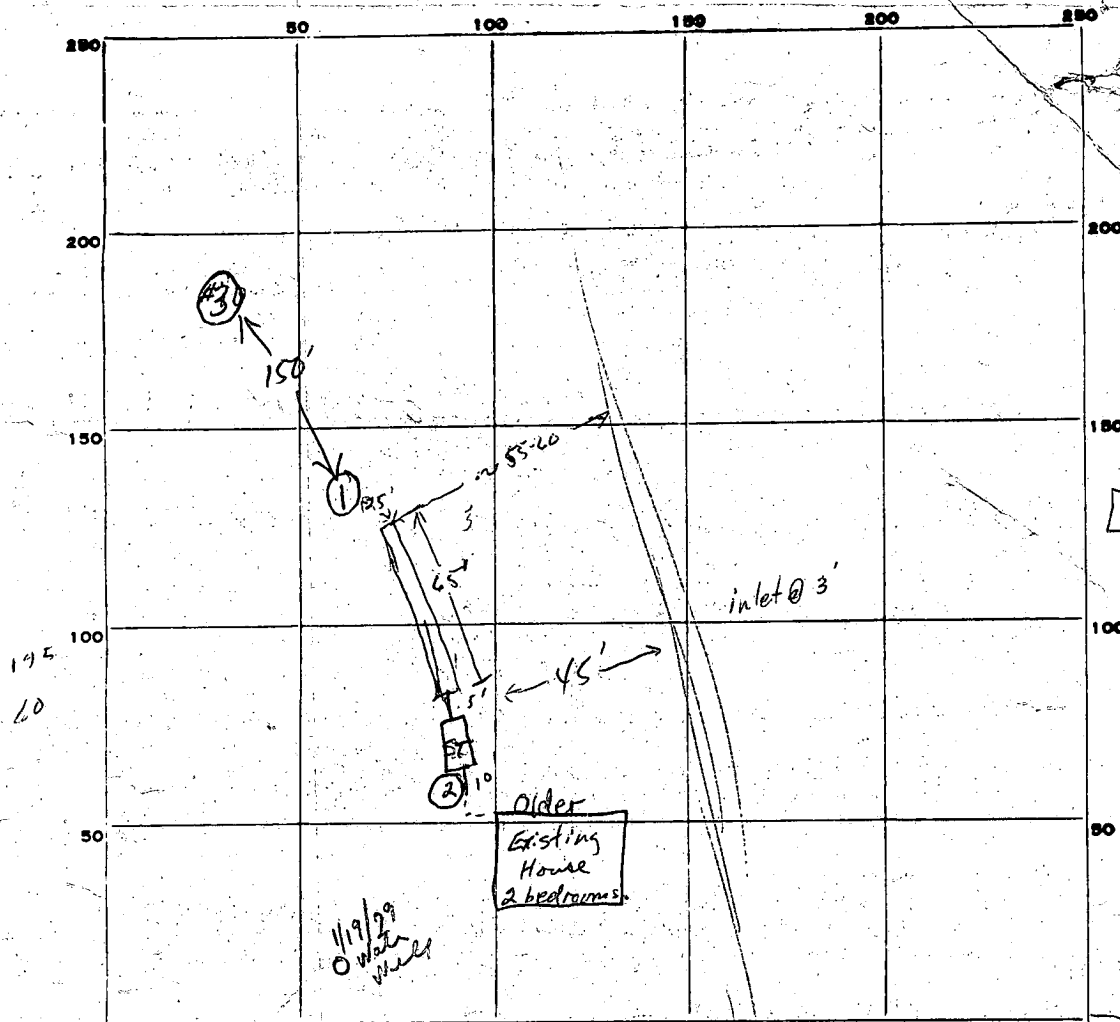

INDICATE NORTH. NAME ADJOINING ROADWAY AS BASE LINE.

PERMIT CARD

yes partial (only ok to convert septic tank)

S.T. / D.W.
OK / N/A

SEPTIC TANK, LEVEL

1000 gal.

CLEANOUTS

DISTRIBUTION BOX, LEVEL

N/A

TILE FIELD, DEPTH

11 1/2 - 12

FT.

TRENCH WIDTH

2

FT.

GRAVEL DEPTH

10'

IN.

TOTAL LENGTH

65'

FT.

NUMBER OF TRENCHES

1

TOTAL BOTTOM AREA

*65
8.5
325
520
552.5*

SEEPAGE PITS, INSIDE DIAMETER

FT.

DEPTH BELOW INLET

FT.

ABSORBENT AREA

650

SQ. FT.

REMARKS

#1) 4' / 1413 - 1423 10 min total

12' / 1413 - 1420 7 min total

#2) 3' / 1415 - 1418, 1418 - 1423, 5 min test.

#3) 3' / 1424 - 1445 19 min total

13' / 1426 - 1436 10 min total

in vent 3'

max depth 11'

552.5 ft²

4/18/78 Partial needs house

*connection c.R. & y
No water well seen on this property*

*1/17/79 Everything graded lower
C.R. &*

OK to add septic & complete hook-up. Call for final.

DATE SYSTEM APPROVED

INSPECTOR

B 1	3288	SEQUENCE NO. (WRA USE ONLY)	STATE OF MARYLAND WATER RESOURCES ADMINISTRATION TAWES STATE OFFICE BLDG., ANNAPOLIS, MARYLAND 21401 APPLICATION FOR PERMIT TO DRILL WELL	WRA PERMIT NUMBER 40-73 2739
1 2 3 (SEQ. NO.) 6 (THIS NUMBER IS TO BE PUNCHED IN COLS. 2-6 ON ALL CARDS)			FILL IN THIS FORM COMPLETELY	

DATE RECEIVED (WRA USE ONLY)	6/30/78 9:30 A.M.		
OWNER	The Donald Office		
COL 15 LAST NAME	FIRST NAME COL. 34		
STREET OR RFD	14032 Paradise Mill Rd.		
COL 55	COL. 55		
POST OFFICE	Paradise Mill Rd.		
COL 57	COL. 76		

B 1	CONTINUED	DRILLER INFORMATION
1 2 3 (SEQ. NO.) 6		
DATE	LICENSE NUMBER	77 80
4/1/78	42	
FIRST NAME	DRILLER	LAST NAME
SIGNATURE		

B 2	WELL INFORMATION
1 2 3 (SEQ. NO.) 6	
MAXIMUM PUMPING RATE (GALLONS PER MINUTE)	8 12
1	600
AVERAGE DAILY QUANTITY NEEDED (GALLONS PER DAY)	14 20
USE FOR WATER (CIRCLE APPROPRIATE BOX)	
☐ D HOME (SINGLE OR DOUBLE HOUSEHOLD UNIT ONLY) ☐ F FARMING, AGRICULTURE, IRRIGATION ☐ I INDUSTRIAL, COMMERCIAL, STATE AND FEDERAL GOVERNMENT. ☐ M MUNICIPAL WATER SUPPLY ☐ P PRIVATE WATER COMPANY ☐ T TEST	
MUST HAVE STATE HEALTH DEPT. APPROVAL	

APPROXIMATE DEPTH OF WELL	24 28 FEET
APPROXIMATE DIAMETER OF WELL	6 (NEAREST INCH)
METHOD OF DRILLING USED (CIRCLE APPROPRIATE METHOD)	
☒ BORED (OR AUGERED) ☐ JETTED ☐ DRIVEN ☐ AIR-ROTARY ☐ AIR-PERCUSSION ☐ ROTARY (HYDRAULIC ROTARY) ☐ CABLE ☐ REVERSE-ROTARY ☐ DRIVE-POINT OTHER (DESCRIBE)	

REPLACEMENT OR DEEPEMED WELLS (CIRCLE APPROPRIATE BOX)	
☐ N THIS WELL WILL NOT REPLACE AN EXISTING WELL ☐ Y THIS WELL WILL REPLACE A WELL THAT WILL BE ABANDONED AND SEALED ☐ S THIS WELL WILL REPLACE A WELL THAT WILL BE USED AS A STANDBY ☐ D THIS WELL WILL DEEPM AN EXISTING WELL PERMIT NUMBER OF WELL TO BE REPLACED OR DEEPEMED (IF AVAILABLE)	

NOT TO BE FILLED IN BY DRILLER (WRA USE ONLY)	
APPROPRIATION PERMIT NUMBER	ENGINEER REVIEW DISTRICT NO.
FORCE	CONDITIONS
WRITE INITIALS IN BOX	A E N S G W Q C L U

B 4	CONTINUED	HEALTH DEPARTMENT APPROVAL
1 2 3 (SEQ. NO.) 6		
DATE	COUNTY NAME	COUNTY NO.
041778	Howard	W27849
APPROVED BY		
Palmer F. Wine		


B 3	LOCATION OF WELL
1 2 3 (SEQ. NO.) 6	
COUNTY	21
SUBDIVISION	42
SECTION	44 46 48 50
NEAREST TOWN	71
MILES FROM TOWN (ENTER 0 IF IN TOWN)	76 77 78

B 4	DIRECTION FROM TOWN (CIRCLE APPROPRIATE BOX)
1 2 3 (SEQ. NO.) 6	
NEAR WHAT ROAD	30
ON WHICH SIDE OF ROAD (CIRCLE APPROPRIATE BOX)	32
DISTANCE FROM ROAD (ENTER DISTANCE AND CIRCLE APPROPRIATE BOX)	37 38 39

DRAW A SKETCH BELOW SHOWING LOCATION OF WELL IN RELATION TO NEARBY TOWNS, ROADS AND STREAMS WITH NORTH IN THE DIRECTION OF THE ARROW, AND GIVE DISTANCE FROM WELL TO NEAREST ROAD JUNCTION OR STREAM CROSSING SHOWN ON THE SKETCH. ALSO SHOW, BY MEANS OF AN "X", THE WELL LOCATION IN THE BOX BELOW AND THE BOX NUMBER FROM THE WELL LOCATION MAP.

DRAW A SKETCH BELOW SHOWING LOCATION OF WELL IN RELATION TO NEARBY TOWNS, ROADS AND STREAMS WITH NORTH IN THE DIRECTION OF THE ARROW, AND GIVE DISTANCE FROM WELL TO NEAREST ROAD JUNCTION OR STREAM CROSSING SHOWN ON THE SKETCH. ALSO SHOW, BY MEANS OF AN "X", THE WELL LOCATION IN THE BOX BELOW AND THE BOX NUMBER FROM THE WELL LOCATION MAP.	N 38' casing 37' open hole 11 bags cement 4/30/78 TSD
BOX NUMBER	E 800 N 500
NORTH COORDINATE	50 51 52 53 54 55
EAST COORDINATE	57 58 59 60 61 62 63
ELEVATION AT WELL HEAD (FEET)	65 66 67 68

B 5	SPECIAL CONDITIONS 8-63 (WRA USE ONLY)
1 2 3 (SEQ. NO.) 6	

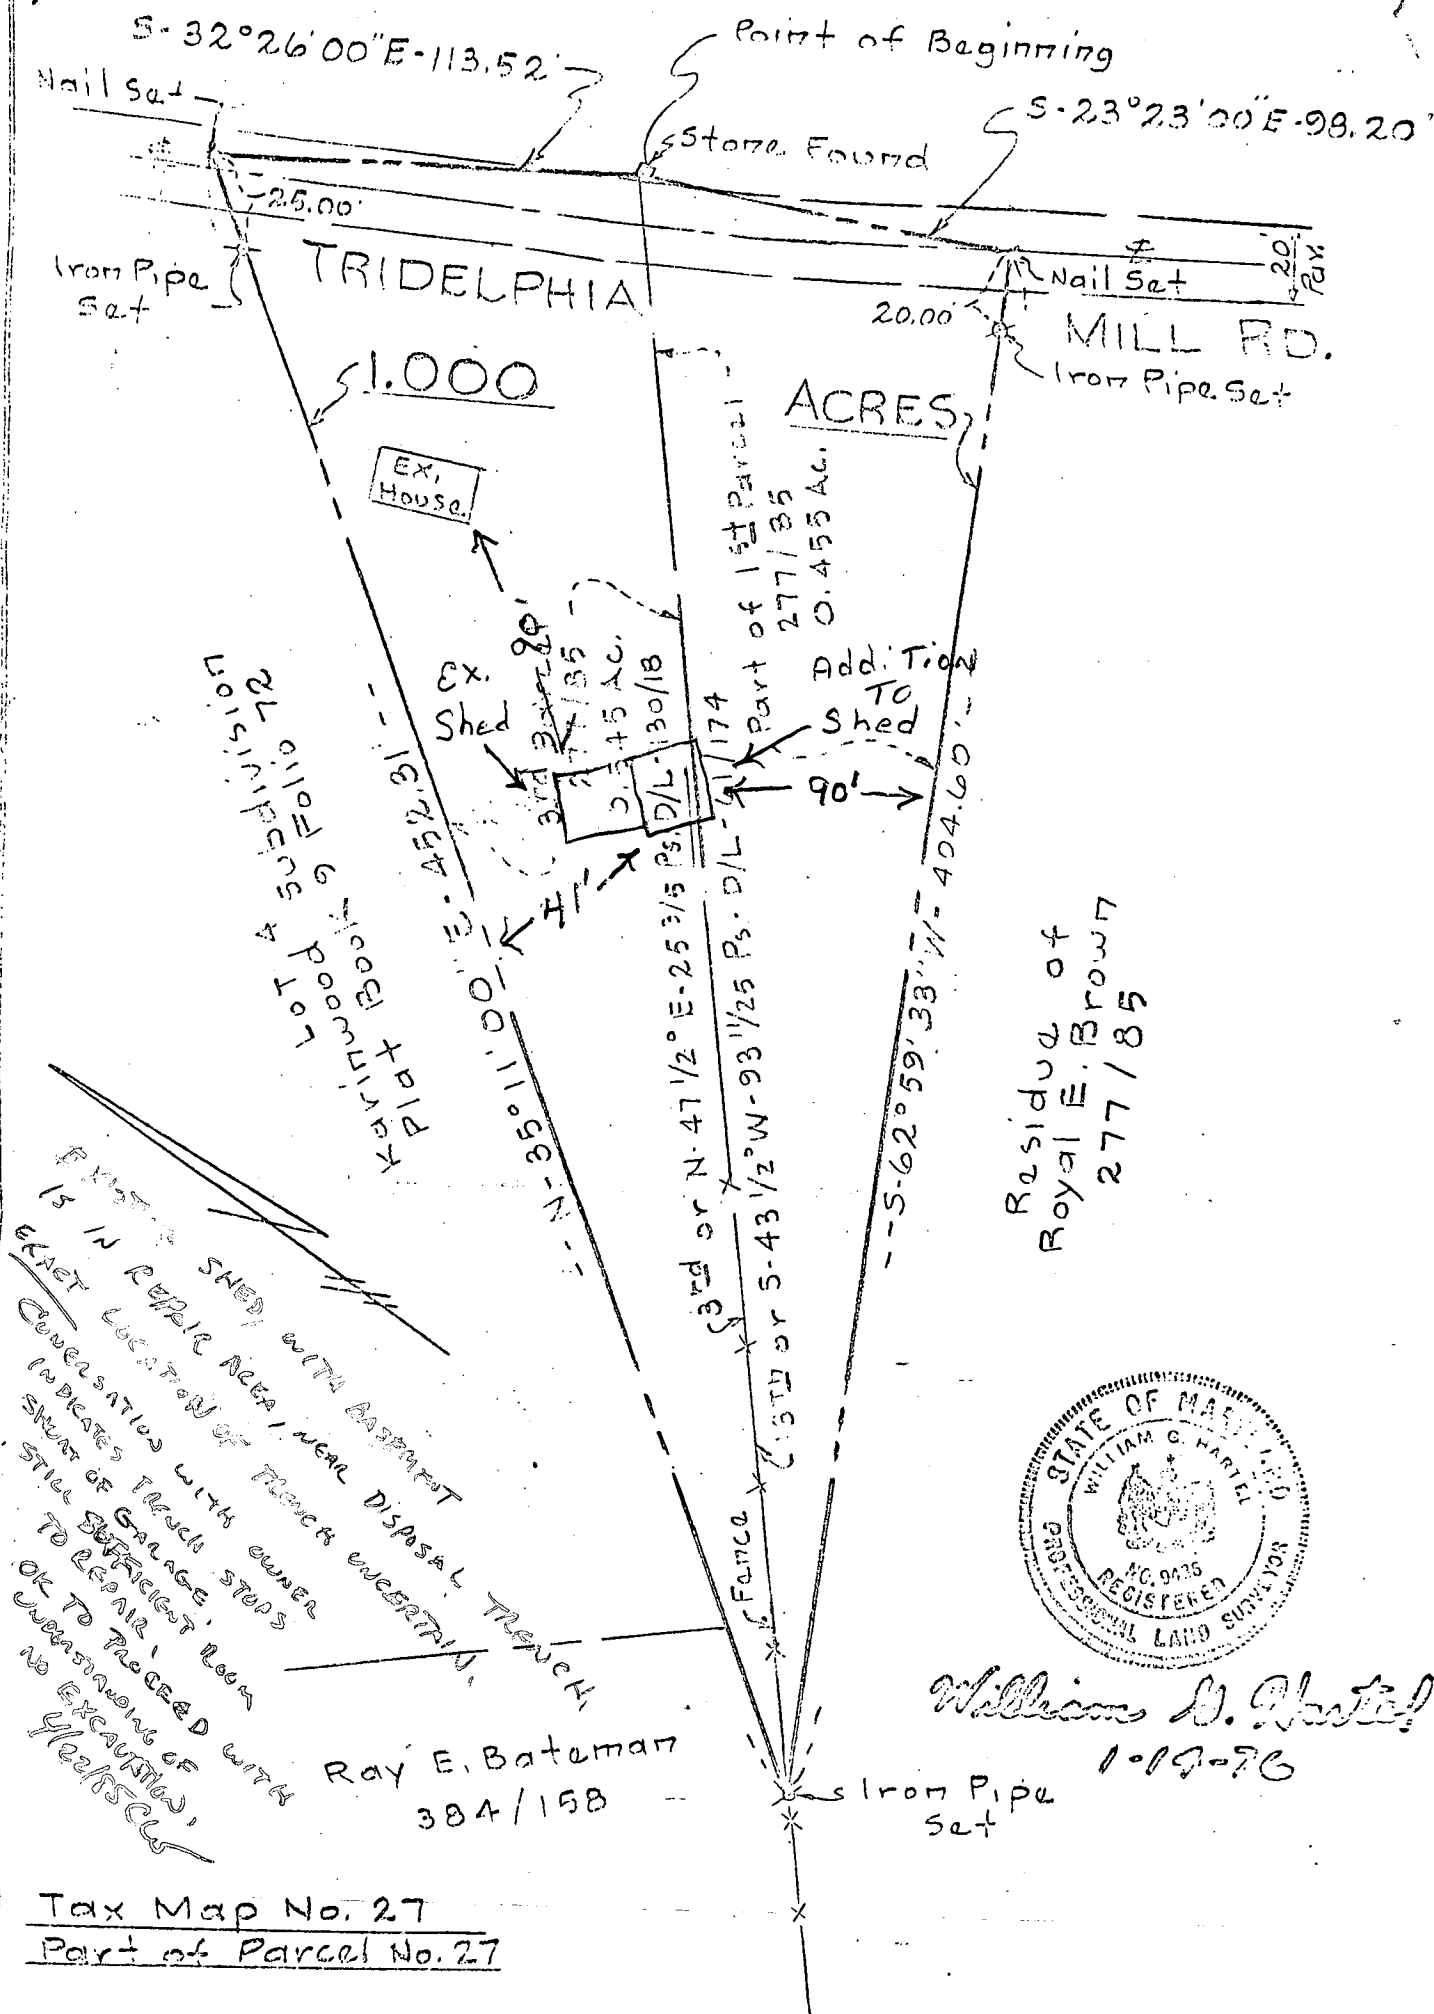

William M. Hartel
1-19-76

TITLE PLAT OF SURVEY				ENGINEERING PLANNING SURVEYING BY BOENDER ASSOCIATES INC. BALTIMORE, MD. 466-7777 SALISBURY, MD. 743-1235 WESTMINSTER, MD. 843-8800
PROJECT ROYAL E. BROWN PROPERTY				
LOCATION 5 TH ELECTION DISTRICT-HOWARD CO., MD.				
DATE: 14 Jan 76	DES. BY: —	DRAWN BY: WGH	CHKD. BY: —	
SCALE: 1" = 50'	JOB NO. 75145	DWG. NO.: 1 of 1		

Eddie McDonald

14023 Triladelphia Mill Rd

Dayton, Md 21036

B00139017

