

PERMIT

SEWAGE DISPOSAL SYSTEM

MARYLAND STATE DEPARTMENT OF HEALTH

HOWARD COUNTY

ELLICOTT CITY

DISTRICT 5th

DATE 4/24/81

Souder Builders, Inc.

IS PERMITTED TO INSTALL ☒ ALTER

ADDRESS 9335 Old Scaggsville Road

PHONE

SUBDIVISION Triadelphia Mill Farms

ROAD 13982 Triadelphia Mill Rd LOT 19

PROPERTY OWNER Souder Builders, Inc.

John Mounts

ADDRESS Same

SPECIFICATIONS 3 Bedrooms

SEPTIC TANK CAPACITY 1000 GALLONS

DRAIN FIELD DEPTH FEET, BOTTOM AREA SQ. FT.

DEEP TRENCH DEPTH FEET, BOTTOM AREA SQ. FT.

Dry Well

SEEPAGE PITS ☒ ABSORBENT SIDE-WALL AREA 160 SQ. FT. per bedroom

INLET PIPE 4 FT. BELOW ORIGINAL GRADE. MAXIMUM DEPTH 10 1/2 FT. BELOW ORIGINAL GRADE

EFFECTIVE DEPTH AT FT. BELOW ORIGINAL GRADE.

LOCATE DISPOSAL AREA 90 FT. FROM left LOT LINE AND 265 FT. FROM edge of Triadelphia Mill Rd LOT LINE AS SEEN WHEN

FACING LOT FROM Triadelphia Mill road.

If trench used with dry well-need:

1. 5' earth buffer between trench and dry well
2. 2 inspections of trench before and after stone in.
3. Run trench on contour.

PLANS APPROVED BY Mr. C. B. Streaker

DATE 12/14/79

COVER NO WORK UNTIL INSPECTED AND APPROVED.

NEITHER THE HOWARD COUNTY COUNCIL NOR THE HEALTH DEPARTMENT IS RESPONSIBLE FOR THE SUCCESSFUL OPERATION OF ANY SYSTEM.

NOTE: IF TRENCH IS USED CALL FOR INSPECTION BEFORE PLACING GRAVEL IN TRENCH.

NOTE: NO DRY WELL SHALL EXCEED 15 FOOT IN DIAMETER.

NOTE: ALL PIPE FROM HOUSE TO DISPOSAL AREA MUST BE CAST IRON.

PERMIT VOID AFTER THREE YEARS.

NOTE: INSTALL STAND PIPE ON SEPTIC TANK AND DRY WELL. STAND PIPES MUST BE 6 INCHES IN DIAMETER. CAST IRON, CONCRETE OR TERRA COTTA ACCEPTED.

*INSTALLER IS RESPONSIBLE FOR OBTAINING FINAL APPROVAL ON THIS PERMIT.

REG. PERMIT SIGNED

AND RETURNED

12-16-89

Serial # B70121799

Sunroom

EH-2-1079

A29066

#19 Triadelphia Mill Farms.

3 BEDROOMS - 1000 GALLON TANK

4 BEDROOMS - 1250 GALLON TANK

DRY WELL - 160 square foot sidewall area per bedroom. Dry well

inlet maximum to be 4 feet below original grade and dry

well bottom to be 10 1/2 feet below original grade. Place the dry well 90'

feet from the LEFT lot line and 265 feet from the EDGE OF TRIADELPHIA MILL

ROAD as seen when facing the lot from TRIADELPHIA MILL road. as of 3/27/81

If trench used with dry well - need:

- (1) 5' earth buffer between trench and dry well.
- (2) 2 inspections of trench before and after stone in.
- (3) Run trench on contour.

3/27/81 - REMEASUREMENT OF PERC HOLES
ENGINEERS CERTIFIED HOLES ARE WRONG
LOCATION OF DRY WELL CHANGED TO
90' FROM LEFT LINE & 265 FT FROM
EDGE OF TRIADELPHIA MILL RD. RH

Address: 13982 Triadelphia Mill Road

Bldg. Permit Signed
and Returned 4/21/81
Serial No. #46257

APPLICATION

A 29066

SEWAGE DISPOSAL TESTING

P _____

STATE OF MARYLAND - DEPARTMENT OF HEALTH AND MENTAL HYGIENE

HOWARD COUNTY HEALTH DEPARTMENT
ENVIRONMENTAL HEALTH SERVICESDISTRICT 5thP. O. BOX 476, ELLICOTT CITY, MARYLAND 21043
TELEPHONE: 465-5000, EXT. 356DATE 10/16/78

SEE ATTACHED SPEC SHEET

TO: THE COUNTY HEALTH OFFICER
ELLICOTT CITY, MARYLAND

I, HEREBY, APPLY FOR THE NECESSARY TEST IN ORDER TO CONSTRUCT (OR RECONSTRUCT) A SEWAGE DISPOSAL SYSTEM:

PROPERTY OWNER Tridelphia Mill Farms Partnership

@ Richard Hallowell

ADDRESS Sandy Spring, Md. 20860 PHONE 286-2988

PROPERTY LOCATION:

Final #19SUBDIVISION Tridelphia Mill FarmsLOT NO. 4- Sheet 2ROAD AND DESCRIPTION On N & S sides of Tridelphia Mill Rd 1,500' E of
Greenbridge Rd. 5th Dist., Dayton, Md.SIZE OF LOT 3.79 acres TYPE BLDG. 4 bedrm, single family dwg.

NUMBER OF BEDROOMS

IF NOT SINGLE RESIDENCE DESCRIBE _____

THE SYSTEM INSTALLED UNDER THIS APPLICATION IS ACCEPTABLE ONLY UNTIL PUBLIC FACILITIES BECOME AVAILABLE.

SIGNATURE OF APPLICANT Richard HallowellAPPROVED BY C.B. STREAKER FOR DRY WELL DATE 12/14/79

(KIND OF SYSTEM)

REJECTED BY _____ FOR Dry Well & Trench DATE _____

(KIND OF SYSTEM)


HOLD PENDING FURTHER TESTS _____ DATE _____

REASONS FOR REJECTION OR HOLDING _____

THIS IS NOT A PERMIT

4 Sheet 2
Final #19

Field
Sheet
Tests per
stake

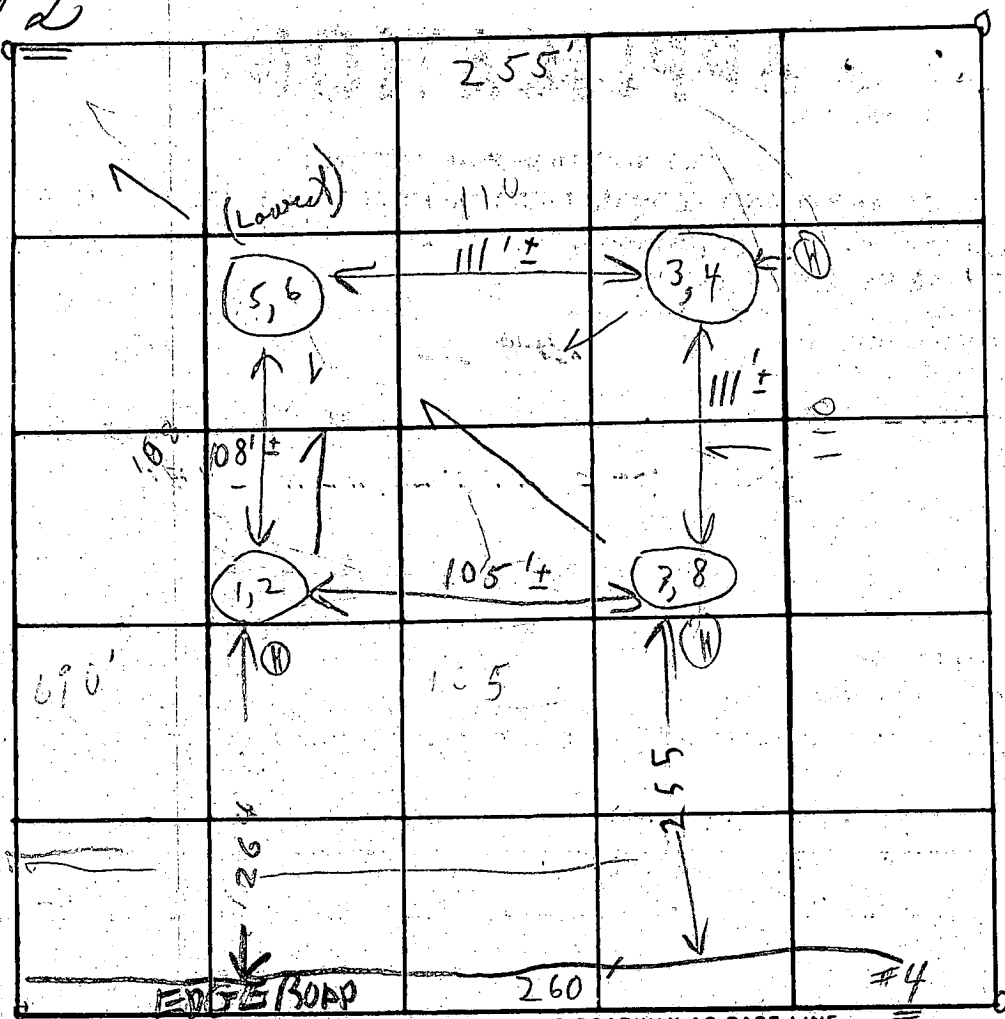

To Dayton

INDICATE NORTH. - NAME ADJOINING ROADWAY AS BASE LINE

Trideltion Mill Rd.

Soil Profile

Below
clay

Sandy
loam

DATE	TEST NO.	DEPTH	PRE-WET		TEST - 1" DROP		TIME
			START	STOP	START	STOP	
11/30/78	1	4 1/2'	12:52	12:55	12:55	1:03	8 min
	(H) 2	12 1/2'	12:53	12:56	12:56	1:04	8 min
	3	3'	1:13	1:21	1:21	1:45	24 min
	4	11 1/2'	1:15	1:18	1:18	1:34	16 min
	5	4 1/2'	1:10	1:20	1:20	1:44	24 min
	6	13'	1:00	1:05	1:05	1:10	5 min
	(H) 7	4'	12:44	12:51	12:51	1:07	16 min
	8	13'	12:46	12:47	12:47	12:49	2 min
						8	103

Unit
4 1/2

13 min
avg

REMARKS

Tests in open corn field

TYPE OF SOIL

TESTED BY

C.B. ✓

ALSO PRESENT:

{ P. Schuler + son }

B 1 11811

SEQUENCE NO.
WRA USE ONLYSTATE OF MARYLAND
APPLICATION FOR PERMIT TO DRILL WELL

WRA PERMIT NUMBER

HO-73-3864

(THIS NUMBER IS TO BE PUNCHED
IN COLS. 3-6 ON ALL CARDS)

please print or type

fill in this form completely

DATE RECEIVED

4/16/81

8 (WRA USE ONLY) 13
OWNER INFORMATION

Soulder Builders Inc

LAST NAME OWNER FIRST NAME

14269 TRIDELPHIA MILL Rd.

36 STREET OR RFD 55

Dayton Md.

TOWN 57 STATE 76 ZIP

B 1 CONTINUED DRILLER INFORMATION

RALPH MAYNE

273

DRILLER'S NAME 77 LICENSE NO. 80

Ralph Mayne 3/25/81

SIGNATURE DATE

B 2 WELL INFORMATION

APPROX. PUMPING RATE (GAL. PER MIN) 5

AVERAGE DAILY QUANTITY NEEDED (GAL. PER DAY) 500

USE FOR WATER (CIRCLE APPROPRIATE BOX)

- ☒ HOME (SINGLE OR DOUBLE HOUSEHOLD UNIT ONLY)
- ☐ FARMING (LIVESTOCK WATERING & AGRICULTURAL IRRIGATION)
- ☐ INDUSTRIAL, COMMERCIAL, STATE AND FEDERAL GOV. OTHER (REQUIRES APPROPRIATION PERMIT)
- ☐ PUBLIC OR PRIVATE WATER COMPANY (REQUIRES APPROPRIATION PERMIT AND STATE HEALTH DEPARTMENT APPROVAL)
- ☐ TEST, OBSERVATION, MONITORING (MAY REQUIRE APPROPRIATION PERMIT)

APPROXIMATE DEPTH OF WELL 150 FEET

APPROXIMATE DIAMETER OF WELL 6 INCH

Method of Drilling (circle one)

BORED (OR AUGERED) JETTED JETTED & DRIVEN

30 AIR ROTARY AIR PERCUSSION ROTARY (HYDRAULIC) 37

CABLE REVERSE ROTARY DRIVE POINT ROTARY

other

REPLACEMENT OR DEEPEMED WELLS

(Circle Appropriate Box)

- ☒ THIS WELL WILL NOT REPLACE AN EXISTING WELL
- ☐ THIS WELL WILL REPLACE A WELL THAT WILL BE ABANDONED AND SEALED
- ☐ THIS WELL WILL REPLACE A WELL THAT WILL BE USED AS A STANDBY
- ☐ THIS WELL WILL DEEPMEN AN EXISTING WELL
- PERMIT NUMBER OF WELL TO BE REPLACED OR DEEPEMED (IF AVAILABLE) 41 52

Not to be filled in by driller (WRA USE ONLY)

APPROX. PERMIT NUMBER 54 GAP 63

FORCE INITIALS CONDITIONS 70 71 72 73 74 75 76 77 78 79

B 5 SPECIAL CONDITIONS 8-63 (WRA USE ONLY)

B 3

LOCATION OF WELL

COUNTY 8 Howard 21

SUBDIVISION 23 TRIADDELPHIA MILL FARMS 42


SECTION 44 I 46 LOT 48 19 50

NEAREST TOWN 52 Dayton 57

MILES FROM TOWN (enter 0 if in town) 73 3 76 77 78 MI

B 4

DIRECTION OF WELL FROM TOWN (CIRCLE BOX)

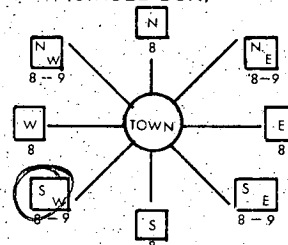TRIADDELPHIA MILL Rd
NEAR WHAT ROAD 30

ON WHICH SIDE OF ROAD (CIRCLE APPROPRIATE BOX) WEST 32 EAST

100 SOUTH

34 DISTANCE FROM ROAD (CIRCLE APPROPRIATE BOX) 37

MI 38 39

SHOW LOCATION OF WELL WITH AN "X" IN THIS BOX

WRITE THE BOX NUMBER FROM THE MAP HERE

E 390
N 500

DRAW A SKETCH BELOW SHOWING LOCATION OF WELL IN RELATION TO NEARBY TOWNS AND ROADS AND GIVE DISTANCE FROM WELL TO NEAREST ROAD JUNCTION

4/16/81 15 Bay of Chesapeake

49' Well Cast

41' Well

3' Cas above ground

then cut to 16" above ground

Well in area called for

Called office spoke to Fred

C.B.

of the

thru

Greenbridge Tric. Rd

well

Dayton

Span out of center

P.W.D. CRUIT

HELD TO 8"

P.W.D. FROM THE

HELD FOR

30 min

ok

C.B.

ok

thru

B 4

NOT TO BE FILLED IN BY DRILLER
HEALTH DEPARTMENT APPROVALHoward
COUNTY NAME237242
COUNTY NO.EHA
SIGNATURESTATE HEALTH
CIRCLE BOX

MO DAY YR

Fred Emmelt Samarian

43 44 45 46 47 48 49 50

CO SIGNATURE

DATE

NORTH 504

EAST 0799

ELEV. (FT.)

GRID 50

55 GRID 57


63

65

Triadelphia Mill Farms
 Lot 19 Sec. 1
 3.711 Ac.

I certify the measurements
 elev. are actual & correct
 Donald Souder

TANK outlet Elev 431.75
 Tank to drywell 20'
 House to Tank 24'
 House Inv elev. 432.50
 Tank Inv. elev. 432'
 Exist. Tank elev 435'
 Drywell Inv. elev. 430'
 Drywell exist. elev. 434'
 Elev. at time of perc. 434'
 Well to drywell 170'

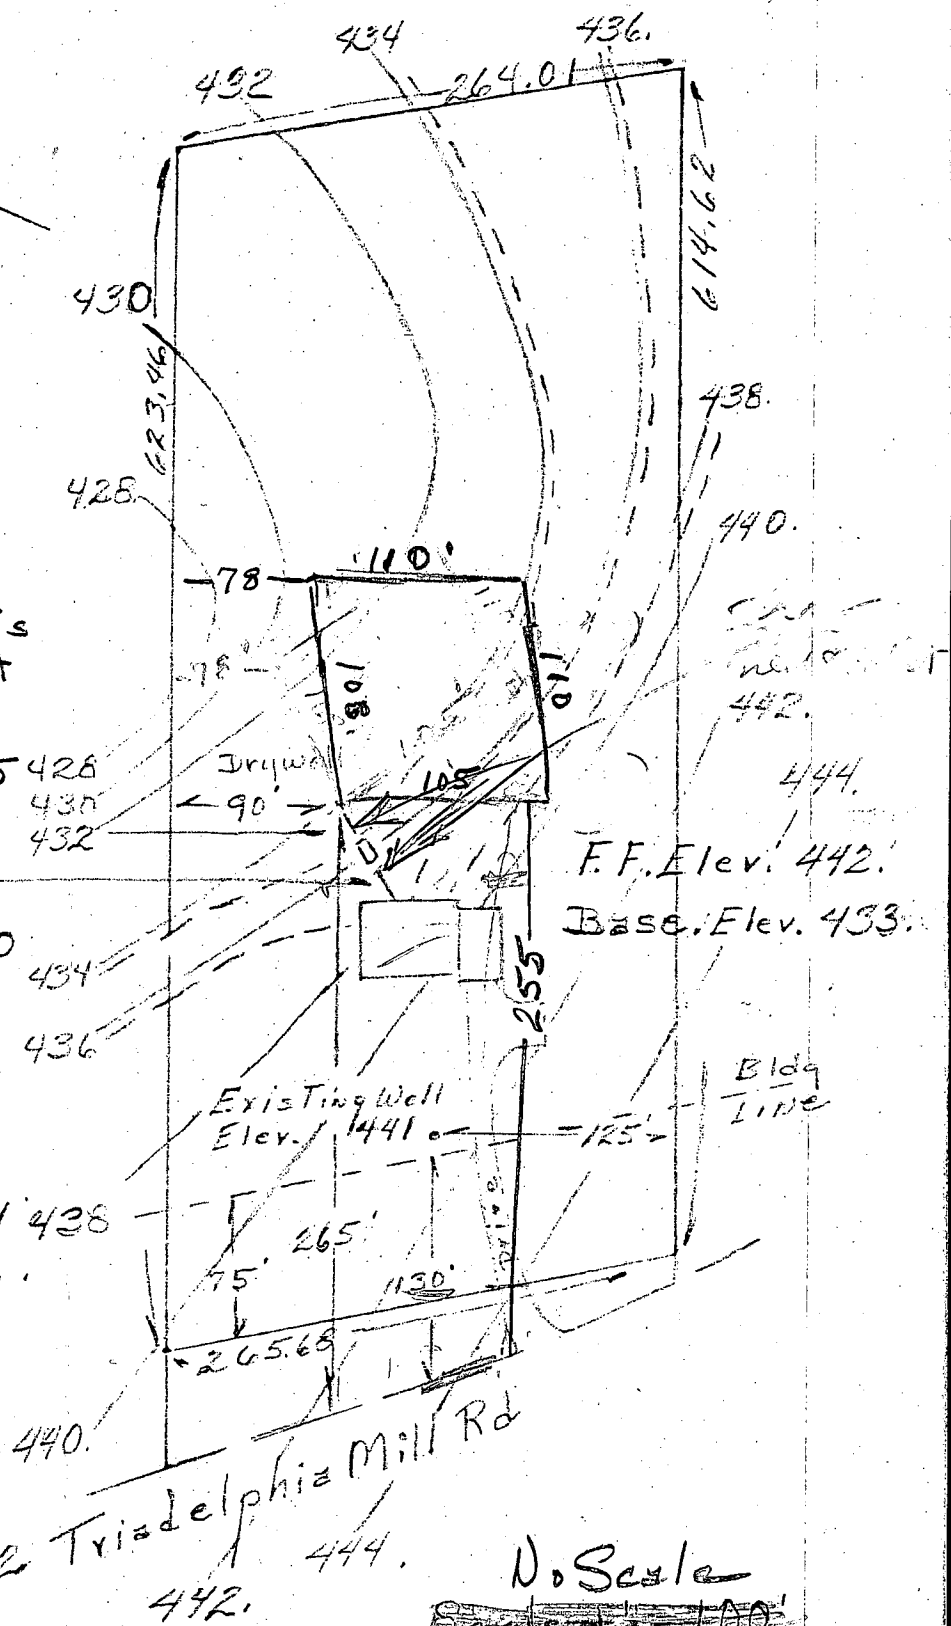

Wayde E Souder
 14191 Triadelphia Mill Rd
 Dayton, Md 21036

Phone 286 3408
 Revised Plan OK R/H

C1	8236	SEQUENCE NO. (WRA USE ONLY)	STATE OF MARYLAND WELL COMPLETION REPORT FILL IN THIS FORM COMPLETELY PLEASE PRINT OR TYPE	THIS REPORT MUST BE SUBMITTED WITHIN 30 DAYS AFTER WELL IS COMPLETED COUNTY NUMBER
----	------	--------------------------------	---	---

Date Received (WRA Use only)	APR 16 1981 DATE WELL COMPLETED	Depth of Well 300 (TO NEAREST FOOT)	PERMIT NO. FROM "PERMIT TO DRILL WELL" 40-73-3867
---------------------------------	------------------------------------	---	---

OWNER last name <u>Souder</u> first name <u>Builders Inc</u>	STREET OR RFD <u>Tridelphia Mill Rd.</u>	TOWN <u>Dayton Md.</u>
SUBDIVISION <u>Tridelphia Mill Farm</u>	SECTION <u>19</u>	LOT <u>19</u>

WELL LOG Not required for driven wells		
STATE THE KIND OF FORMATIONS PENETRATED, THEIR COLOR, DEPTH, THICKNESS AND IF WATER BEARING		
DESCRIPTION (Use additional sheets if needed)	FEET FROM TO	Check if water bearing
Top Soil	0 2	
Sandy	2 36	
Sand Stone	36 40	
Micka	40 70	
Sand Stone	70 80	✓
Micka	80 200	

GROUTING RECORD WELL HAS BEEN GROUTED (Circle Appropriate Box) TYPE OF GROUTING MATERIAL CEMENT <u>CM</u> BENTONITE CLAY <u>BC</u> NO. OF BAGS <u>14</u> NO. OF POUNDS <u>1400</u> GALLONS OF WATER <u>84</u> DEPTH OF GROUT SEAL (to nearest foot) from <u>0</u> ft to <u>45</u> ft (enter 0 if from surface)	
CASING RECORD casing types insert appropriate code below <u>ST</u> <u>CO</u> STEEL CONCRETE <u>PL</u> <u>OT</u> PLASTIC OTHER MAIN CASING TYPE <u>ST</u> Nominal diameter top/main casing (nearest inch) <u>6</u> Total depth of main casing (nearest foot) <u>42</u>	

C 3 (seq no)	PUMPING TEST HOURS PUMPED (nearest hour) <u>4</u> PUMPING RATE (gal. per min. to nearest gal.) <u>6</u> METHOD USED TO MEASURE PUMPING RATE <u>Bucket</u> WATER LEVEL (distance from land surface) BEFORE PUMPING <u>20</u> WHEN PUMPING <u>200</u> TYPE OF PUMP USED (for test) <u>A</u> air <u>P</u> piston <u>T</u> turbine <u>C</u> centrifugal <u>R</u> rotary <u>O</u> other (describe below) <u>J</u> jet <u>S</u> submersible
--------------	---

OTHER CASING (if used) diameter inch depth (feet) from to EACH CASING	
SCREEN RECORD screen type or openhole insert appropriate code below <u>ST</u> <u>BR</u> <u>HO</u> STEEL BRASS BRONZE OPEN HOLE <u>PL</u> <u>OT</u> PLASTIC OTHER	

PUMP INSTALLED DRILLER WILL INSTALL PUMP (CIRCLE APPROPRIATE BOX) YES <u>Y</u> NO <u>N</u> IF DRILLER INSTALLS PUMP, THIS SECTION MUST BE COMPLETED FOR ALL WELLS EXCEPT HOME USE TYPE OF PUMP (WRITE APPROPRIATE LETTER IN BOX - SEE ABOVE: (A, C, J, P, R, S, T, O)) CAPACITY: GALLONS PER MINUTE (to nearest gallon) <u>31</u> <u>35</u> PUMP HORSE POWER <u>37</u> <u>41</u> PUMP COLUMN LENGTH (nearest ft) <u>43</u> <u>47</u> CASING HEIGHT (circle appropriate box and enter casing height) <u>+</u> above LAND SURFACE <u>-</u> below <u>2</u> (nearest foot)	
--	--

CIRCLE APPROPRIATE BOX <u>A</u> A WELL WAS ABANDONED AND SEALED WHEN THIS WELL WAS COMPLETED <u>E</u> ELECTRIC LOG OBTAINED <u>P</u> TEST WELL CONVERTED TO PRODUCTION WELL	
--	--

I HEREBY CERTIFY THAT I HAVE COMPLIED WITH ALL CONDITIONS STATED ON THE ABOVE-CAPTIONED "PERMIT TO DRILL WELL", AND THAT INFORMATION CONTAINED IN THIS REPORT IS TRUE, ACCURATE, AND COMPLETE TO THE BEST OF MY KNOWLEDGE, INFORMATION AND BELIEF.

DRILLERS IDENT. NO. <u>223</u>
DRILLERS SIGNATURE (MUST MATCH SIGNATURE ON APPLICATION) <u>Ralph E. Mayne</u>
SITE SUPERVISOR (sign of driller or journeyman responsible for sitework if different from permittee)

C 2 (seq no)	DEPTH (nearest ft.) <u>45</u> <u>200</u> EACH SCREEN <u>1</u> <u>2</u> <u>3</u> SLOT SIZE <u>2</u> <u>3</u> DIAMETER OF SCREEN (NEAREST INCH) from <u>56</u> to <u>60</u>
--------------	---

GRAVEL PACK IF WELL DRILLED WAS FLOWING WELL CIRCLE BOX <u>F</u> WRA USE ONLY (NOT TO BE FILLED IN BY DRILLER) T (E.R.O.S.) <u>70</u> <u>72</u> <u>74</u> <u>75</u> <u>76</u> TELESCOPE CASING LOG INDICATOR OTHER DATA	
---	--

LOCATION OF WELL ON LOT SHOW PERMANENT STRUCTURE SUCH AS BUILDING, SEPTIC TANKS, AND/OR LANDMARKS AND INDICATE NOT LESS THAN TWO DISTANCES (MEASUREMENTS TO WELL) <u>well</u> <u>100'</u> <u>100'</u> <u>road</u>	
---	--

Building Address 13982 TRIADOLPHIA RD
DAYTON, MD 21036

Suite/Apt. #: _____ SDP/WP/Petition #: _____

Census Tract 6030 Subdivision Tria Mill Farms

Section _____ Area _____ Lot 19

Tax Map 22 Parcel _____ Grid _____

Zoning _____ Map Coordinates 9G1D Lot size _____

Existing Use SFO

Proposed Use SFO / SUNROOM

Estimated Construction Cost \$ 19,000

Description of Work BUILD 12'x16 SUNROOM
BUILD 7'x30 OPEN DECK. WITH
4'x6' LANDINGS

Occupant or Tenant John Mounts

Contact Name BRAD Fleagle

Address 601 DOVER RD

City ROCK State MD Zip Code 20850

Phone 301-294-0445 Fax _____

Property Owner's Name John Mounts

Address 13982 TRIADOLPHIA RD.

City DAYTON State MD Zip Code 21036

Home Phone 301-854-3168 Work Phone _____

Applicant's Name & Mailing Address, (if other than stated hereon):
BRAD Fleagle
601 DOVER RD. ROCK MD, 20850

Phone 301-294-0445 Fax _____

Contractor Company AMERICAN ALL SEASON SURVIVING

Contact Person BRAD Fleagle

Address 601 DOVER RD

City ROCK State MD Zip Code 20850

License No. 20391

Phone 301-294-0445 Fax _____

Engineer or Architect Company _____

Contact Person _____

Address _____

City _____ State _____ Zip Code _____

Phone _____ Fax _____

BUILDING DESCRIPTION - COMMERCIAL

Building Characteristics

Height: 9'0"

No. of stories: 1

Gross area, sq. ft. per floor: _____

Use group: _____

Construction type:
☐ Reinforced Concrete
☐ Structural Steel
☐ Masonry
☐ Wood Frame

☐ State Certified Modular

Utilities

Water Supply:
☐ Public
☒ Private

Sewage Disposal:
☐ Public
☒ Private

Electric Yes ☐ No ☐

Gas Yes ☐ No ☐

Heating System:
Electric ☐ Oil ☐

Natural Gas ☐

Propane Gas ☐

Sprinkler system: N/A ☐

☐ Full
☐ Partial
☐ Other Suppression
of Heads _____

BUILDING DESCRIPTION - RESIDENTIAL

Building Characteristics

SF Dwelling ☒ SF Townhouse ☐

Depth Width

1st floor: 12' 16'

2nd floor: _____

Basement: _____

Finished Basement ☐ Unfinished Basement ☐

Crawl space ☐ Slab on Grade ☐

No. of Bedrooms _____

Multi-family dwellings:
No. of efficiency units: _____

No. of 1 BR units: _____

No. of 2 BR units: _____

No. of 3 BR units: _____

Other Structure: _____

Dimensions: _____

Footings: _____

Roof: _____

☐ State Certified Modular
☐ Manufactured Home

Utilities

Water Supply:
☐ Public
☒ Private

Sewage Disposal:
☐ Public
☒ Private

Electric Yes ☐ No ☐

Gas Yes ☐ No ☐

Heating System:
Electric ☐ Oil ☐

Natural Gas ☐

Propane Gas ☐

Sprinkler system: N/A ☐

☐ NFPA #13D
☐ NFPA #13R
☐ Other: _____

THE UNDERSIGNED HEREBY CERTIFIES AND AGREES AS FOLLOWS: (1) THAT HE/SHE IS AUTHORIZED TO MAKE THIS APPLICATION; (2) THAT THE INFORMATION IS CORRECT; (3) THAT HE/SHE WILL COMPLY WITH ALL REGULATIONS OF HOWARD COUNTY WHICH ARE APPLICABLE THERETO; (4) THAT HE/SHE WILL PERFORM NO WORK ON THE ABOVE REFERENCED PROPERTY NOT SPECIFICALLY DESCRIBED IN THIS APPLICATION; (5) THAT HE/SHE GRANTS COUNTY OFFICIALS THE RIGHT TO ENTER ONTO THIS PROPERTY FOR THE PURPOSE OF INSPECTING THE WORK PERMITTED AND POSTING NOTICES.

Paul H. [Signature]
Applicant's Signature
Field Sup American All Season
Title/Company

BRAD Fleagle
Print Name
12/15/99
Date

Checks payable to: **DIRECTOR OF FINANCE OF HOWARD COUNTY**
**** PLEASE WRITE NEATLY AND LEGIBLY. ****
- FOR OFFICE USE ONLY -

AGENCY

☒ Land Development, DPZ
☒ State Highways
☒ Building Official
☒ Dev. Engineering, DPZ
☒ Health
☐ Fire Protection

DATE

12/15/99
12/16/99

SIGNATURE APPROVAL

[Signature]
Mark E. [Signature]

DPZ SETBACK INFORMATION

Front: _____

Rear: _____

Side: _____

Side St.: _____

All minimum setbacks met?
YES ☐ NO ☐

Is Entrance Permit required?
YES ☐ NO ☐

Historic District?
YES ☐ NO ☐

Lot Coverage for New Town Zone _____

SDP/Red-line approval date _____

PROPERTY ID#: 74406

Filing fee \$ 25

Permit fee \$ 25

Excise tax \$ 154

Sub-total paid \$ _____

Add'l permit fee \$ _____

TOTAL FEES \$ 204

Balance due \$ _____

Check # 7734

Validation # 2692

Accepted by [Signature]

CONTINGENCY CONSTRUCTION START: ☐


ONE STOP SHOP: ☐

Distribution of Copies- White: Building Official Green: LDD, DPZ Yellow: DED, DPZ Pink: Health Gold: SHA

a:\permit.frm

Rev. 10/15/98

LANDTECH ASSOCIATES INC.
P.O. BOX 443 GLEN BURNIE, MD. 21061 (301)768-2121

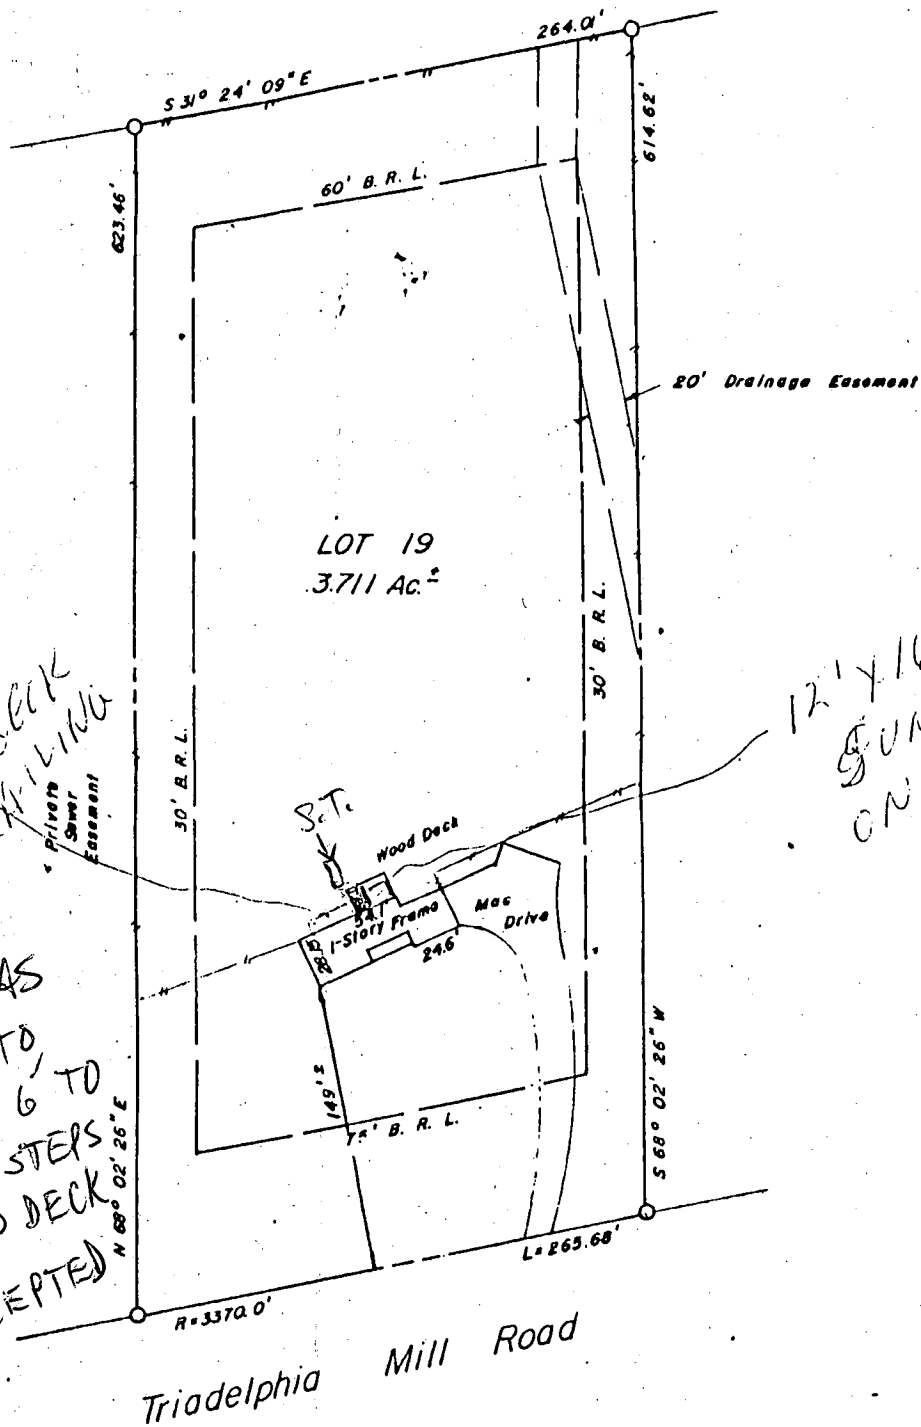

12/16/99
7'x30'
OPEN DECK
PRIVATE SEWER
EASEMENT
S.T. APPROX AS
SHOWN 8' TO
7x30 DECK, 6 TO
CLOSEST COR. OF STEPS
ADJ. TO DECK
PROPOSAL ACCEPTED
(MD)

12'x16'
GUNROOM
ON DECK

* See Plat For Private Sewage Easement



NO TITLE REPORT FURNISHED

CERTIFICATION: THIS IS TO CERTIFY THAT THE IMPROVEMENTS INDICATED HEREON ARE LOCATED AS SHOWN. THIS IS NOT A PROPERTY LINE SURVEY AND SHOULD NOT BE USED AS SUCH.

Braden A. Rogers
BRADEN A. ROGERS

PROPT. L.S. NO. 119

LIBER _____ FOLIO _____
LOT 19 _____ BLOCK _____ SECT. 1 _____ PLAT _____
PLAT ENTITLED Triadelphia Mill Farms
RECORDED IN Howard County, _____, MD.
PLAT BOOK _____ FOLIO _____

13982 Triadelphia Mill Road
5th District
Dayton, Maryland
Howard County

SCALE 1" = 100'
DATE 5-20, 1986
CASE NO. 1
JOB NO. 115086-437