

SEPTIC SYSTEM MUST BE INSTALLED
BEFORE BUILDING PERMIT CAN BE
ISSUED.

PERMIT

SEWAGE DISPOSAL SYSTEM

MARYLAND STATE DEPARTMENT OF HEALTH

HOWARD COUNTY
BUREAU OF ENVIRONMENTAL HEALTH
992-2330

INDEXED
04-341783

ELLICOTT CITY

DISTRICT 4th

DATE 12/19/83

Foremost Industries

IS PERMITTED TO INSTALL ☒ ALTER ☐

ADDRESS 2375 Buchanan Trail West, Greencastle, Pa. 17225 PHONE 829-0886 (Mr. Rosensteel)

SUBDIVISION Poplar Springs ROAD 912 Watersville Road LOT 3

PROPERTY OWNER Foremost Industries, Inc.

ADDRESS same as above

IF GARBAGE GRINDER IS USED INCREASE SEPTIC TANK CAPACITY BY 50% AND ABSORPTION AREA BY 22%.

GARBAGE GRINDER? YES ☐ NO ☒

SEPTIC TANK CAPACITY 1000 GALLONS NUMBER OF BEDROOMS 3

~~DRY WELL OR DRY WELL AND TRENCH - 154 sq. ft. per bedroom absorbent sidewall area. Inlet 4 1/2 ft. below original grade. Bottom maximum depth 10 1/2 ft. below original grade. Effective area begins at 4 1/2 ft. below original grade. If trenches only used need 187 sq. ft. per bedroom, one sidewall area. Trench to be 2 ft. wide. Inlet and maximum depth same as on dry well. 6 feet of stone below distribution pipe. Place the dry well or trench between perc holes #1 and #4. Perc hole #1 is located 20 ft. from the lot line which is 190 ft. long and runs N77°07' 25" W and 10 ft. from the lot line which is 80 ft. long and runs N12°52' 35"E. Perc hole #4 is located 120 ft. from the lot line which is 190 ft. long and runs N77°07' 25"W and 160 ft. from the lot line which is 98.7 ft. long and runs S32°00' 00"N.~~

PLANS APPROVED BY Raymond Hodges

DATE 10/19/83

COVER NO WORK UNTIL INSPECTED AND APPROVED.

NEITHER THE HOWARD COUNTY COUNCIL NOR THE HEALTH DEPARTMENT IS RESPONSIBLE FOR THE SUCCESSFUL OPERATION OF ANY SYSTEM.

NOTE: IF TRENCH IS USED CALL FOR INSPECTION BEFORE AND AFTER PLACING GRAVEL IN TRENCH.

NOTE: NO DRY WELL SHALL EXCEED 15 FOOT IN DIAMETER. NO ABSORPTION TRENCH TO EXCEED 100 FEET IN LENGTH.

NOTE: ALL PIPE FROM HOUSE TO SEPTIC TANK MUST BE CAST IRON OR SCHEDULE 40 PVC OR ABS.

PERMIT VOID AFTER THREE YEARS.

NOTE: INSTALL STAND PIPE ON SEPTIC TANK AND DRY WELL. STAND PIPES MUST BE 6 INCHES IN DIAMETER. CAST IRON, CONCRETE OR TERRA COTTA, OR PVC OR ABS ACCEPTED. IF TOP OF SEPTIC TANK IS DEEPER THAN 3 FEET MANHOLE TO GRADE REQUIRED.


***INSTALLER IS RESPONSIBLE FOR OBTAINING FINAL APPROVAL ON THIS PERMIT**

*CALL 992-2330 FOR INSPECTION OF SEPTIC SYSTEMS.

EH - 2-1082

A 29473

154
3
462

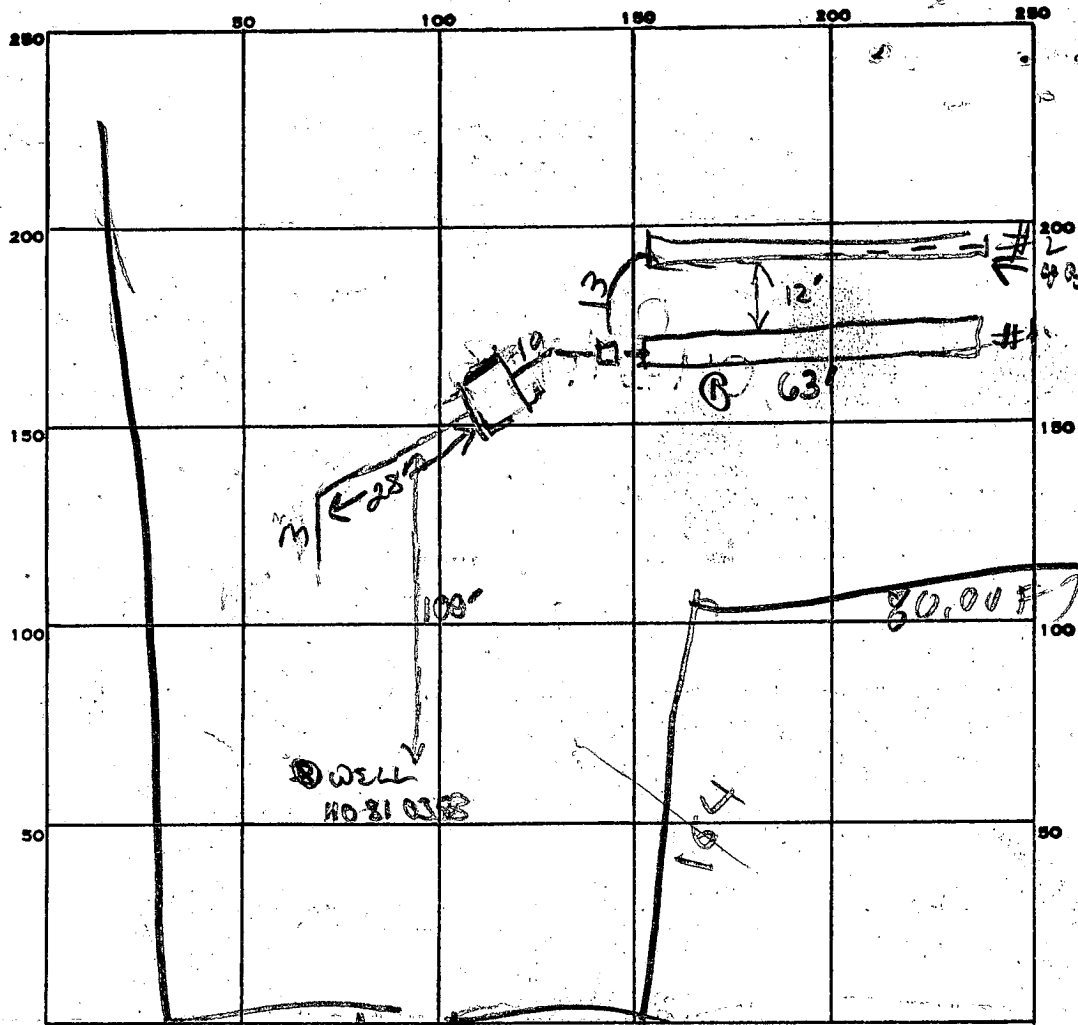

190.00 FT

PERMIT CARD

SEPTIC TANK, LEVEL OK 1250

CLEANOUTS OK

DISTRIBUTION BOX, LEVEL #1

TILE FIELD, DEPTH 10' 10.5 FT. TRENCH WIDTH 2 FT. #1 #2

GRAVEL DEPTH 6' 6 1/2 IN. TOTAL LENGTH 63' 63 FT.

NUMBER OF TRENCHES 2 TOTAL BOTTOM AREA 368 368 736

SEEPAGE PITS, INSIDE DIAMETER _____ FT. DEPTH BELOW INLET _____ FT.

ABSORBENT AREA _____ SQ. FT.

REMARKS OK TO stone & add pipe to trench #1 & cover

10/29 OK to start trench 2 - stone & add pipe

10/29/85 LOCATION OK STONE ADDED TO BOT
TRENCHES & TANK & BOX CONNECTED, OK TO COVER
CALL WHEN HOUSE SEWER INSTALLED RH

10-24-86 House connection OK
DATE SYSTEM APPROVED 10/24-86 INSPECTOR Stanger

**HOWARD COUNTY HEALTH DEPARTMENT
BUREAU OF ENVIRONMENTAL HEALTH
WATER AND SEWERAGE PROGRAM
TEL: (410)313-2640 FAX: (410)313-2648**

Information Form for the Installation of the Well Pump, Pitless Adapter, and Supply Piping

NOTE: The installer is responsible for requesting an inspection prior to 9 am on the day of the desired inspection. No work is to be covered until approved by the Health Department. All installations must comply with the National Standard Plumbing Code (NSPC, as amended locally) and COMAR 26.04.04 (MD Well Construction Regulations). Submission of a complete form is required prior to Use and Occupancy approval.

Company Name: Easterday Well Pump Telephone #: 301-831-7057
Address: 9265 Dawn Church Rd
MT Airy MD 21771

(Must circle one) Licensed Plumber Licensed Well Driller Licensed Well Pump Installer
License # and name of individual responsible for the field installation:
Name (Print): Lester Simmons License# AW D611
*A licensed individual must perform the actual installation. Apprentices must be under the supervision of a licensed journeyman or master plumber, pump installer or well driller. Licenses may be subjected to field verification. Unlicensed individuals may be reported to the appropriate licensing agency.

Name of Property Owner: John Schneebagen Telephone #: _____
Subdivision: _____ Lot #: _____ Well Tag #: HO 94-3494
Site Address: 912 E Watersville Rd

<u>Submersible Pump Data</u>	<u>Pitless Adapter</u>	<u>Well Cap and Electric Conduit</u>
Make: <u>Goulds</u>	Make: <u>Cambel</u>	Two piece watertight cap: <u>✓</u>
Model #: <u>5G501402</u>	Model#: <u>B-10K</u>	Screened, vented well cap: <u>✓</u>
Pump Capacity: <u>5</u> GPM	Depth: <u>43'</u> (36" min)	Cap secured to casing: <u>Y</u>
Well Yield: <u>6</u> GPM	NSP/WSC approved: _____	Conduit min 18" B.G.: <u>Y</u>
Depth of well encountered at time of pump installation: _____ (feet)		Conduit secured to well cap: <u>Y</u>
If pump capacity exceeds well yield, a low water cut off switch is required by NSPC 1990 Section 17.8.4		
Torque arrestors, Cable guards, or other acceptable method used- Must circle one		
Safety rope, if used, attached to brass rope adapter or other acceptable method <u>inside of well casing</u> <u>✓</u>		

<u>Piping to house</u>	<u>House Connection</u>
Type: <u>Crossline</u>	PVC sleeve to undisturbed soil at wall penetration: <u>✓</u>
PSI: <u>200</u> (160 psi min)	Approximate length of sleeve: <u>54</u>
Depth of supply line: <u>3/2</u> (36" min)	Sleeve caulked and sealed properly: <u>✓</u>

The water supply line is required to be at least ten feet from the septic tank, pump chamber, sewage piping, distribution box, drainfields, and sewage reserve area. If this cannot be accomplished, contact this office for approval prior to installation.

Signature of company representative responsible for installation: [Signature] date: 10/30/02

For Health Department Use Only - Not to be completed by Installer

Date Insp. Requested: _____ Date Insp. Approved: 10/31/02 Inspector: (50)
Inspection Data: Pitless adapter watertight & water supply line at least 36" below grade ✓
Two piece cap installed and attached to casing securely ✓
Elec. conduit extends at least 18" below grade/attached to cap properly ✓
Safety rope not seen outside of well cap/casing ✓
Correct well tag attached properly and casing 8" above finished grade ✓
Water supply line sleeved adequately at house connection ✓
Adequate grade observed below pitless adapter ✓
Field to ex. house conn.

14246

SEQUENCE NO.
(MDE USE ONLY)STATE OF MARYLAND
WELL COMPLETION REPORT
FILL IN THIS FORM COMPLETELY
PLEASE TYPETHIS REPORT MUST BE SUBMITTED WITHIN
45 DAYS AFTER WELL IS COMPLETED.COUNTY
NUMBER A29473

ST/CO USE ONLY

DATE RECEIVED

MM

DD

YY

DATE WELL COMPLETED

10/22/02

Depth of Well

400
(TO NEAREST FOOT)PERMIT NO.
FROM "PERMIT TO DRILL WELL"
H0-94-3494

OWNER

STREET OR RFD

SUBDIVISION

912 E. WATERSVILLE RD
POPLAR SPRINGS

TOWN

LISBON

SECTION

LOT

3

WELL LOG

Not required for driven wells

STATE THE KIND OF FORMATIONS PENETRATED, THEIR
COLOR, DEPTH, THICKNESS AND IF WATER BEARINGDESCRIPTION (Use
additional sheets if needed)

FEET

FROM

TO

check
if water
bearing

topsoil	0	1	
reddish/brown shale	1	8	
Brown shale	8	23	
Tannish/brown shale	23	32	
Brown slate	32	50	
Greenish/gray slate	50	90	
Tannish/gray slate	90	110	
Green slate	110	215	
Gray slate	215	242	
Green slate	242	400	

GROUTING RECORD

WELL HAS BEEN GROUTED
(Circle Appropriate Box)YES ☒ NO ☐

TYPE OF GROUTING MATERIAL (Circle one)

CEMENT ☒ BENTONITE CLAY ☐

NO. OF BAGS 21 NO. OF POUNDS 510

GALLONS OF WATER 126

DEPTH OF GROUT SEAL (to nearest foot)

from 0 to 40 ft. to 68 ft. BOTTOM

(enter 0 if from surface)

CASING RECORD

casing
types
insert
appropriate
code
belowSTEEL ☒CONCRETE ☐PLASTIC ☐OTHER ☐MAIN
CASING
TYPENominal diameter
top (main) casing
(nearest inch)Total depth
of main casing
(nearest foot)

62 63 64 65 66 67 68 69 70

OTHER CASING (if used)

diameter depth (feet)

inch from to

EACH CASING

screen type or open hole

SCREEN RECORD

insert
appropriate
code
belowSTEEL ☒BRASS ☐OPEN HOLE ☐BRONZE ☐OTHER ☐PLASTIC ☐OTHER ☐

NUMBER OF UNSUCCESSFUL WELLS:

WELL HYDROFRACTURED

YES ☐ NO ☒

CIRCLE APPROPRIATE LETTER

A A WELL WAS ABANDONED AND SEALED

WHEN THIS WELL WAS COMPLETED

E ELECTRIC LOG OBTAINED

P TEST WELL CONVERTED TO PRODUCTION

WELL

I HEREBY CERTIFY THAT THIS WELL HAS BEEN CONSTRUCTED IN
ACCORDANCE WITH COMAR 28.04.04 "WELL CONSTRUCTION" AND
IN CONFORMANCE WITH ALL CONDITIONS STATED IN THE ABOVE
CAPTIONED PERMIT, AND THAT THE INFORMATION PRESENTED
HEREIN IS ACCURATE AND COMPLETE TO THE BEST OF MY
KNOWLEDGE.

DRILLERS LIC. NO.

MWD 0440
Easterday

DRILLERS SIGNATURE

(MUST MATCH SIGNATURE ON APPLICATION)

LIC. NO.

MWD 7227

SITE SUPERVISOR (sign. of driller or journeyman
responsible for sitework if different from permittee)GRAVEL PACK
IF WELL DRILLED
WAS FLOWING WELL
INSERT F IN BOX 68

MDE USE ONLY

(NOT TO BE FILLED IN BY DRILLER)

T (E.R.O.S.)

W Q

70 71 72

TELESCOPE
CASINGLOG
INDICATOR74 75 76
OTHER DATA

C 3

PUMPING TEST

HOURS PUMPED (nearest hour)

3

PUMPING RATE (gal. per min.)

6

METHOD USED TO
MEASURE PUMPING RATE

Bucket

WATER LEVEL (distance from land surface)

BEFORE PUMPING

5

WHEN PUMPING

400

TYPE OF PUMP USED (for test)

A

P

T

C

R

O

J

S

O

J

S

O

J

S

O

PUMP INSTALLED

DRILLER INSTALLED PUMP YES

(CIRCLE) (YES or NO)

IF DRILLER INSTALLS PUMP, THIS SECTION
MUST BE COMPLETED FOR ALL WELLS.

TYPE OF PUMP INSTALLED

PLACE (A,C,J,P,R,S,T,O)

IN BOX 29

CAPACITY

GALLONS PER MINUTE

(to nearest gallon)

PUMP HORSE POWER

PUMP COLUMN LENGTH

(nearest ft.)

CASING HEIGHT (circle appropriate box

and enter casing height)

above

below

LAND SURFACE

(nearest foot)

LOCATION OF WELL ON LOT

SHOW PERMANENT STRUCTURE SUCH AS

BUILDING, SEPTIC TANKS, AND /OR

LANDMARKS AND INDICATE NOT LESS

THAN TWO DISTANCES

(MEASUREMENTS TO WELL)


B 1 1302	SEQUENCE NO. (MDE USE ONLY)	STATE OF MARYLAND APPLICATION FOR PERMIT TO DRILL WELL 517441 please type	STATE PERMIT NUMBER HO-94-3474 fill in this form completely
Date Received (APA) 08 28 02 OWNER INFORMATION 9193 SCHNEEBERGER JOHN 15 Last Name Owner First Name 34 912 E. WATERSVILLE RD 36 Street or RFD 55 MT. AIRY, MD 21771 57 Town 70 State 72 Zip 76		B 3 Howard LOCATION OF WELL 8 COUNTY 21 23 SUBDIVISION 42 SECTION 44 46 LOT 48 50 Lisbon 52 NEAREST TOWN 71 MILES FROM TOWN (enter 0 if in town) 2 M 73 76 77 78	
DRILLER INFORMATION George F. Easterday M WD 040 Driller's Name 76 License No. 81 L. Franklin Easterday, Inc. Firm Name 9265 Brown Church Rd., MT. Airy, Md. 21771 Address <i>George F. Easterday</i> 8/28/2002 Signature Date		B 4 912 East Watersville Rd 11 NEAR WHAT ROAD 30 ON WHICH SIDE OF ROAD (CIRCLE APPROPRIATE BOX) NORTH N WEST W SOUTH S EAST E 34 50 37 DISTANCE FROM ROAD ENTER FT OR MI 38 39 TAX MAP: 07 BLK 03 PARCEL 287	
B 2 WELL INFORMATION 1 2 APPROX. PUMPING RATE (GAL. PER MIN.) 8 12 500 AVERAGE DAILY QUANTITY NEEDED (GAL. PER DAY) 14 20		NOT TO BE FILLED IN BY DRILLER HEALTH DEPARTMENT APPROVAL Howard (13) A29473 COUNTY NAME COUNTY NO. STATE SIGNATURE INSERT S → 41 DATE ISSUED 08 28 02 <i>John</i> 08/28/03 43 MM DD YY 48 CO SIGNATURE EXP. DATE NORTH GRID 550 0 0 0 EAST GRID 772 0 0 0 50 55 57 63	
USE FOR WATER (CIRCLE APPROPRIATE BOX) ☒ DOMESTIC POTABLE SUPPLY & RESIDENTIAL IRRIGATION ☐ FARMING (LIVESTOCK WATERING & AGRICULTURAL IRRIGATION) ☐ INDUSTRIAL, COMMERCIAL, DEWATERING ☐ PUBLIC WATER SUPPLY WELL ☐ TEST, OBSERVATION, MONITORING ☐ GEO-THERMAL		SHOW MAJOR FEATURES OF BOX & LOCATE WELL WITH AN X SOURCES OF DRILLING WATER 1. wells 2. 3. WRITE THE BOX NUMBER FROM THE MAP HERE E 770 772 550 000 N	
APPROXIMATE DEPTH OF WELL 300 FEET 24 28 APPROXIMATE DIAMETER OF WELL 6 INCH 30 34 NEAREST INCH		10/22/02 2 pm Grant look's OK (SC)	
METHOD OF DRILLING (circle one) BORED (or Augered) JETTED Jetted & DRIVEN 30 AIR-ROTARY AIR-PERCussion ROTARY (Hydraulic Rotary) 37 CABLE REVERSE-ROTARY Drive-POINT. other		DRAW A SKETCH BELOW SHOWING LOCATION OF WELL IN RELATION TO NEARBY TOWNS AND ROADS AND GIVE DISTANCE FROM WELL TO NEAREST ROAD JUNCTION 3 4 Watersville Rd Lisbon 144	
REPLACEMENT OR DEEPEMED WELLS (CIRCLE APPROPRIATE BOX) ☐ THIS WELL WILL NOT REPLACE AN EXISTING WELL ☐ THIS WELL WILL REPLACE A WELL THAT WILL BE ABANDONED AND SEALED ☒ THIS WELL WILL REPLACE A WELL THAT WILL BE USED AS A STANDBY-CONTACT LOCAL APPROVING AUTHORITY FOR POLICY ON STANDBY WELLS ☐ THIS WELL WILL DEEPEMED AN EXISTING WELL PERMIT NUMBER OF WELL TO BE REPLACED OR DEEPEMED (IF AVAILABLE) 41 52		Not to be filled in by driller (MDE OR COUNTY USE ONLY) APPROX. PERMIT NUMBER G PERMIT No. HO-94-3474 70 71 72 73 74 75 76 77 78 79	
SPECIAL CONDITIONS NOTE: APPROVING AUTHORITIES SHOULD USE SEPARATE SHEET IF NEEDED			

8/28/02
11:00

SITE INSPECTION SHEET

OWNER: Schneeberger PHONE #: _____
ADDRESS: 912 E. WATERSVILLE ROAD CONTRACTOR: EASTERDAY
WELL TAG #: HO-94-3494
SUBDIVISION: POPLAR SPRINGS LOT: 3 COUNTY #: HOWARD A29473
PROPOSAL: Replacement Well

LOCATION DIAGRAM

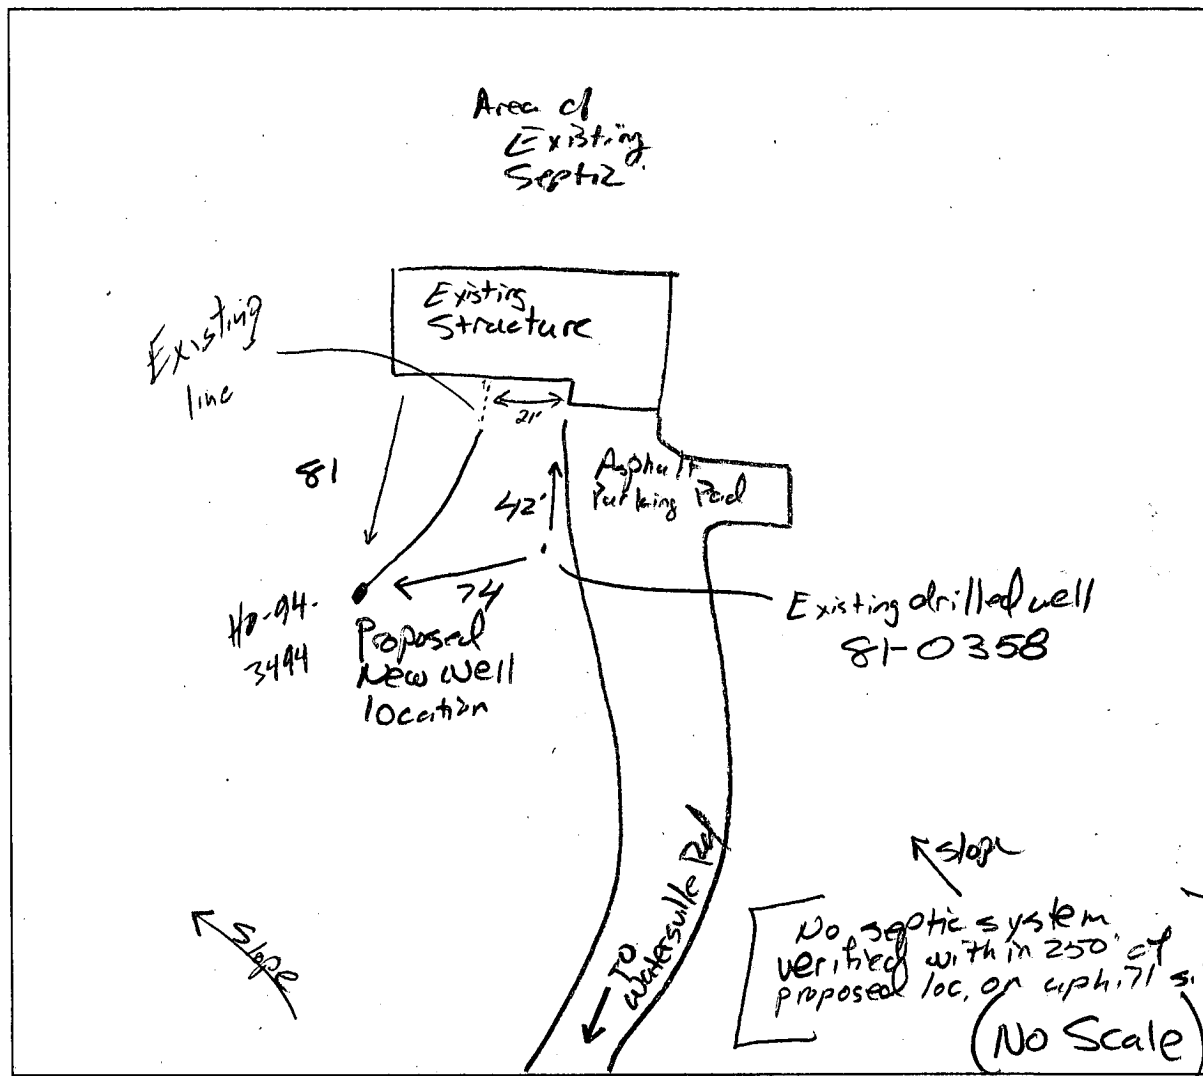

COMMENTS: keeping existing low yield well. Its possible that well driller will tie both wells together, 10/31/02 old well to be abandoned (50)

DATE: 8/28/02 INSPECTOR: J. Boris

MARYLAND DEPARTMENT OF THE ENVIRONMENT, WATER MANAGEMENT ADMINISTRATION
2500 BROENING HIGHWAY, BALTIMORE, MARYLAND 21224, (410) 631-3784

WATER WELL ABANDONMENT-SEALING REPORT FORM

SUBMIT COPIES OF COMPLETED FORM TO:

- COUNTY ENVIRONMENT AGENCY (contact MDE, WMA if address needed)
- WELL OWNER
- MDE, WATER MANAGEMENT ADMINISTRATION, WELL PROGRAM

DATE WELL ABANDONED: 11/29/02 (month/day/year)

PERMIT NUMBER OF ABANDONED WELL (if any)

H0 - 81 - 0358

PERMIT NUMBER OF REPLACEMENT WELL

H0 - 94 - 3494

PERSON ABANDONING WELL: Richard A. Crummitt

WELL DRILLERS LICENSE NUMBER: WRO 014

CIRCLE: MWD/MSD/MGD

OWNER'S NAME: JOHN SCHWEEBERGER

SITE LOCATION MAP

WELL LOCATION:

COUNTY: HOWARD


NEAREST TOWN: MT AIRY

TAX MAP _____ BLOCK _____ PARCEL _____

SUBDIVISION: _____

SECTION: _____ LOT: _____

NEAREST ROAD: 912 E. Watersville Rd

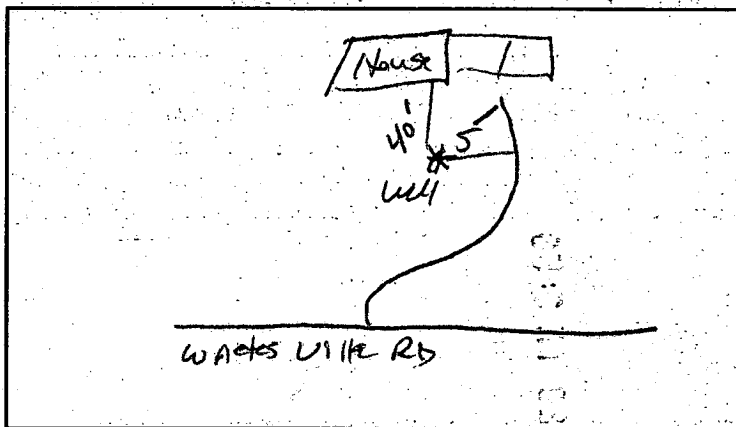

TYPE OF WELL BEING ABANDONED:

- ☒ DRILLED ☐ JETTED
- ☐ BORED/AUGERED ☐ HAND DUG
- ☐ OTHER (specify) _____

USE CODE:

- ☒ DOMESTIC ☐ MUNICIPAL/PUBLIC
- ☐ IRRIGATION ☐ INDUSTRIAL
- ☐ TEST/OBSERVATION ☐ GEOTHERMAL

TYPE OF CASING:

- ☒ STEEL ☐ PLASTIC
- ☐ CONCRETE ☐ OTHER (specify) _____

SIZE OF CASING: 6 INCHES IN DIAMETER

DEPTH OF WELL: 249 FEET DEEP

WAS ANY CASING REMOVED? ☒ YES ☐ NO
if yes, length removed, in feet: 4

WAS CASING RIPPED OR PERFORATED? ☐ YES ☒ NO

LOG OF SEALING MATERIAL

MATERIAL	FEET	
	FROM	TO
Bentonite	249	4
Gravel	4	0
VOLUME OF MATERIAL USED		
10 Bags Bentonite		

SIGNATURE MASTER WELL DRILLER OR SUPERVISING SANITARIAN

LICENSE #

040 MWD/MSD/MGD

DATE

12-17-02

C1 0878
SEQUENCE NO. (OEP USE ONLY)
THIS NUMBER IS TO BE PUNCHED IN COLUMNS 3-6 ON ALL CARDS

STATE OF MARYLAND
WELL COMPLETION REPORT
FILL IN THIS FORM COMPLETELY
PLEASE PRINT OR TYPE

THIS REPORT MUST BE SUBMITTED WITHIN 45 DAYS AFTER WELL IS COMPLETED.
COUNTY NUMBER A29473

DATE Received 122083
DATE WELL COMPLETED 122083
Depth of Well 260 (TO NEAREST FOOT)
PERMIT NO. FROM "PERMIT TO DRILL WELL" H0-81-0358
OWNER Foremost Industries
STREET OR RFD last name Watersville Rd. first name
TOWN Poplar Springs
SUBDIVISION Poplar Springs SECTION LOT 3

WELL LOG
Not required for driven wells

STATE THE KIND OF FORMATIONS PENETRATED, THEIR COLOR, DEPTH, THICKNESS AND IF WATER BEARING

DESCRIPTION (Use additional sheets if needed)	FEET		Check if water bearing
	FROM	TO	
Top Soil	0	2	
Brown Shale	2	40	✓
Brown Shale	40	45	
Blue Shale	45	60	
Brown Shale	60	65	✓
Blue Shale	65	260	

GROUTING RECORD
WELL HAS BEEN GROUTED (Circle Appropriate Box)
TYPE OF GROUTING MATERIAL
CEMENT CM BENTONITE CLAY BC
NO. OF BAGS 15 NO. OF POUNDS 1500
GALLONS OF WATER 90
DEPTH OF GROUT SEAL (to nearest foot)
from 0 ft. to 30 ft. (enter 0 if from surface)
CASING RECORD
casing types insert appropriate code below
STEEL ST CONCRETE CO
PLASTIC PL OTHER OT
MAIN CASING TYPE S+
Nominal diameter top (main) casing (nearest inch) 6
Total depth of main casing (nearest foot) 52

C3
PUMPING TEST
HOURS PUMPED (nearest hour) 6
PUMPING RATE (gal. per min. to nearest gal.) 3
METHOD USED TO MEASURE PUMPING RATE bucket
WATER LEVEL (distance from land surface)
BEFORE PUMPING 25
WHEN PUMPING 260
TYPE OF PUMP USED (for test)
A air P piston T turbine
C centrifugal R rotary O other (describe below)
J jet S submersible

OTHER CASING (if used)
diameter inch depth (feet) from to

PUMP INSTALLED
DRILLER WILL INSTALL PUMP YES NO
IF DRILLER INSTALLS PUMP, THIS SECTION MUST BE COMPLETED FOR ALL WELLS EXCEPT HOME USE
TYPE OF PUMP INSTALLED
PLACE (A,C,J,P,R,S,T,O) IN BOX - SEE ABOVE:
CAPACITY: GALLONS PER MINUTE (to nearest gallon)
PUMP HORSE POWER
PUMP COLUMN LENGTH (nearest ft.)
CASING HEIGHT (circle appropriate box and enter casing height)
+ above } LAND SURFACE 2 (nearest foot)
- below }

CIRCLE APPROPRIATE LETTER
A A WELL WAS ABANDONED AND SEALED WHEN THIS WELL WAS COMPLETED
E ELECTRIC LOG OBTAINED
P TEST WELL CONVERTED TO PRODUCTION WELL

C2
screen type or open hole insert appropriate code below
STEEL ST BRASS BR OPEN HOLE HO
PLASTIC PL OTHER OT
DEPTH (nearest ft.)
H0 50 260
SLOT SIZE 1 2 3
DIAMETER OF SCREEN (NEAREST INCH)
from to

LOCATION OF WELL ON LOT
SHOW PERMANENT STRUCTURE SUCH AS BUILDING, SEPTIC TANKS, AND/OR LANDMARKS AND INDICATE NOT LESS THAN TWO DISTANCES (MEASUREMENTS TO WELL)
well 125' 100' Prop Line

I HEREBY CERTIFY THAT THIS WELL HAS BEEN CONSTRUCTED IN ACCORDANCE WITH COMAR 10.17.13 "WELL CONSTRUCTION" AND IN CONFORMANCE WITH ALL CONDITIONS STATED IN THE ABOVE CAPTIONED PERMIT, AND THAT THE INFORMATION PRESENTED HEREIN IS ACCURATE AND COMPLETE TO THE BEST OF MY KNOWLEDGE.
DRILLERS IDENT. NO. 223
Robert Mayne
DRILLERS SIGNATURE (MUST MATCH SIGNATURE ON APPLICATION)
SITE SUPERVISOR (sign. of driller or journeyman responsible for sitework if different from permittee)

GRAVEL PACK
IF WELL DRILLED WAS FLOWING WELL INSERT F IN BOX 68
OEP USE ONLY (NOT TO BE FILLED IN BY DRILLER)
T (E.R.O.S.) WQ
TELESCOPE CASING LOG INDICATOR OTHER DATA

Page 1 of 1
Date Dec 20, 1983

Review OK 12/4/88 C.W.L.

FIELD DATA SHEET
HOWARD COUNTY WELL YIELD TEST

Well Permit No. HO - 81-0358
Location of property (road) Watersville Road
Subdivision Poplar Springs Lot 3 Block Plat Sec.
Well Driller Ralph Mayne Owner Foremost Industries

Depth of well 260 ft
Distance of measuring point (M.P.) above ground 2 ft
Static water level (S.W.L.) below M.P. 25 ft

I. High rate pumping -- reservoir drawdown

Time pump started 7:30 Pumping rate 9 G.P.M.
Total time 15 min to reach pumping water level 34 ft. below M.P.

II. Recovery pump test data - observations to be recorded every 15 minutes

TIME (in 15 minute intervals)	WATER LEVEL below M.P.	PUMPING RATE time to fill 1 gallon bucket	FLOW METER READING (if used)	CALCULATED FLOW (gallons per minute)
7:45	34 ft	20 sec		3 G.P.M.
8:00	34 ft	20 sec		3 G.P.M.
8:15	34 ft	20 sec		3 G.P.M.
8:30	34 ft	20 sec		3 G.P.M.
8:45	34 ft	20 sec		3 G.P.M.
9:00	34 ft	20 sec		3 G.P.M.
9:15	34 ft	20 sec		3 G.P.M.
9:30	34 ft	20 sec		3 G.P.M.
9:45	34 ft	20 sec		3 G.P.M.
10:00	34 ft	20 sec		3 G.P.M.
10:15	45 ft	20 sec		3 G.P.M.
10:30	55 ft	20 sec		3 G.P.M.
10:45	65 ft	60 sec		1 G.P.M.
11:00	65 ft	60 sec		1 G.P.M.
11:15	65 ft	60 sec		1 G.P.M.
11:30	65 ft	60 sec		1 G.P.M.
11:45	65 ft	60 sec		1 G.P.M.
12:00	65 ft	60 sec		1 G.P.M.
12:15	65 ft	60 sec		1 G.P.M.
12:30	65 ft	60 sec		1 G.P.M.
12:45	65 ft	60 sec		1 G.P.M.
1:00	65 ft	60 sec		1 G.P.M.
1:15	65 ft	60 sec		1 G.P.M.
1:30	65 ft	60 sec		1 G.P.M.

1:45 65 ft 60 sec
1:50 150 sec

1 G.P.M.

B

6689

SEQUENCE NO.
(OEP USE ONLY)STATE OF MARYLAND
PERMIT TO DRILL WELL

OEP PERMIT NUMBER

H0-81-0358

(THIS NUMBER IS TO BE PUNCHED
IN COLS. 3-6 ON ALL CARDS)

please print or type

fill in this form completely

Date Received

112883

OWNER INFORMATION

FORMOST INDUSTRIES

Last Name Owner First Name

2375 BUCHANAN TRAIL

Street or RFD

GREENCASTLE PAID 225

Town State Zip

DRILLER INFORMATION

Ralph MAYNE 273

Driller's Name 77 License No. 80

Firm Name RALPH MAYNE (well Drilling)

Address 9120 Bryn Church Rd. Mt. Airy Md.

Signature Date 11/21/83

Signature Date

WELL INFORMATION

APPROX. PUMPING RATE (GAL. PER MIN.) 5

AVERAGE DAILY QUANTITY NEEDED
(GAL. PER DAY) 500

USE FOR WATER (CIRCLE APPROPRIATE BOX)

- ☒ HOME (SINGLE OR DOUBLE HOUSEHOLD UNIT ONLY)
- ☐ FARMING (LIVESTOCK WATERING & AGRICULTURAL IRRIGATION)
- ☐ INDUSTRIAL, COMMERCIAL, STATE AND FEDERAL GOV. OTHER (REQUIRES APPROPRIATION PERMIT)
- ☐ PUBLIC OR PRIVATE WATER COMPANY (REQUIRES APPROPRIATION PERMIT AND STATE HEALTH DEPARTMENT APPROVAL)
- ☐ TEST, OBSERVATION, MONITORING (MAY REQUIRE APPROPRIATION PERMIT)

APPROXIMATE DEPTH OF WELL 150 FEET

APPROXIMATE DIAMETER OF WELL 6 INCH

METHOD OF DRILLING (circle one)

- BORED (or Augered) JETTED Jetted & DRIVEN
- ☒ AIR-ROTARY AIR-PERCussion ROTARY (Hydraulic Rotary)
- CABLE REVERSE-ROTARY DRIVE-POINT

other

REPLACEMENT OR DEEPEMED WELLS
(CIRCLE APPROPRIATE BOX)

- ☒ THIS WELL WILL NOT REPLACE AN EXISTING WELL
- ☐ THIS WELL WILL REPLACE A WELL THAT WILL BE ABANDONED AND SEALED
- ☐ THIS WELL WILL REPLACE A WELL THAT WILL BE USED AS A STANDBY
- ☐ THIS WELL WILL DEEPMEN AN EXISTING WELL

PERMIT NUMBER OF WELL TO BE REPLACED OR DEEPMED
(IF AVAILABLE)

Not to be filled in by driller (OEP USE ONLY)

APPROP. PERMIT NUMBER GAP

FORCE FE WRITE INITIALS IN BOX PERMIT No. H0-81-0358

SPECIAL CONDITIONS

B 3

LOCATION OF WELL

HOWARD
COUNTY
POPLAR SPRINGS

23 SUBDIVISION


SECTION 44 46 LOT 3 48 50

POPLAR SPRINGS

52 NEAREST TOWN


MILES FROM TOWN (enter 0 if in town) 0 MI

B 4

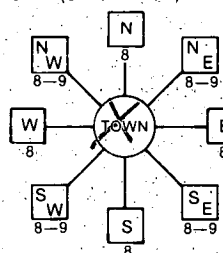DIRECTION OF WELL FROM
TOWN (CIRCLE BOX)

WATERSVILLE Rd.

NEAR WHAT ROAD

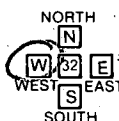ON WHICH SIDE OF ROAD
(CIRCLE APPROPRIATE BOX)DISTANCE FROM ROAD
ENTER FT. or MI 500 FT.NOT TO BE FILLED IN BY DRILLER
HEALTH DEPARTMENT APPROVAL

HOWARD

COUNTY NAME

A29473

COUNTY NO.

OEP

STATE HEALTH

SIGNATURE

INSERT S

DATE ISSUED

120183 Frank Skinner 6/1/84

NORTH

GRID

551 0 0 0

EAST


GRID

0772 0 0 0

SHOW MAJOR FEATURES OF
BOX & LOCATE WELL
WITH AN X

SOURCES OF DRILLING WATER

1. well
- 2.
- 3.

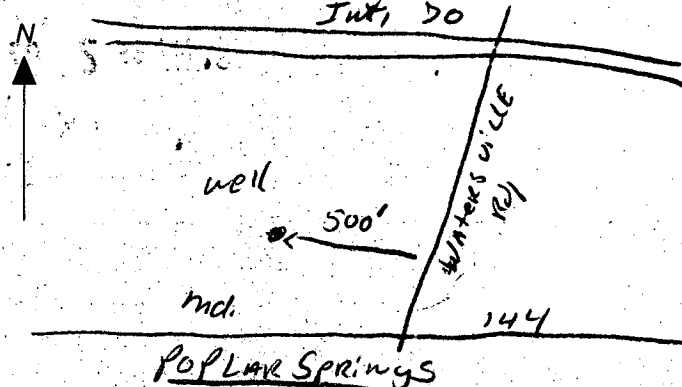WRITE THE BOX NUMBER
FROM THE MAP HEREE 550 2
N 550 1DRAW A SKETCH BELOW SHOWING LOCATION OF WELL IN
RELATION TO NEARBY TOWNS AND ROADS AND GIVE
DISTANCE FROM WELL TO NEAREST ROAD JUNCTION

Prel.

lot 3

APPLICATION

SEWAGE DISPOSAL TESTING

STATE OF MARYLAND - DEPARTMENT OF HEALTH AND MENTAL HYGIENE

HOWARD COUNTY HEALTH DEPARTMENT
ENVIRONMENTAL HEALTH SERVICES
P.O. BOX 476 ELLICOTT, MARYLAND 21043
TELEPHONE: 992-2330

A 29473

P _____

DISTRICT 4th

DATE 2/1/79

TO: THE COUNTY HEALTH OFFICER
ELLICOTT CITY, MARYLAND

I, HEREBY, APPLY FOR THE NECESSARY TEST IN ORDER TO CONSTRUCT (OR RECONSTRUCT) A SEWAGE DISPOSAL SYSTEM.

PROPERTY OWNER ~~Georgia Conn property, c/o E. Brooke Lee~~ *Foremost Ind. Inc.*

ADDRESS 10000 Sweepstakes Road, Damascus, Md. 20750 PHONE Boender - 465-7777

PROPERTY LOCATION _____

SUBDIVISION _____ LOT NO. *Now 3*

ROAD AND DESCRIPTION *912* Watersville Road

(old 5 old 6 old 4 combined to make new 3)

SIZE OF LOT 3 acres m/1 TYPE BLDG. 3 or 4 bedrooms

THE SYSTEM INSTALLED UNDER THIS APPLICATION IS ACCEPTABLE ONLY UNTIL PUBLIC FACILITIES BECOME AVAILABLE.

I FULLY UNDERSTAND THE FEE CONNECTED WITH THE FILING OF THIS PERC TEST APPLICATION IS NON-REFUNDABLE UNDER

ANY CIRCUMSTANCES.

SIGNATURE OF APPLICANT /s/ Jack Boender for E. Brooke Lee

APPROVED BY _____ FOR _____ DATE _____

REJECTED BY _____ FOR _____ DATE _____

HOLD PENDING FURTHER TESTS _____ DATE _____

REASONS FOR REJECTION OR HOLDING _____


B.P. # 67678

THIS IS NOT A PERMIT


LOT 3

lot 3

①
SOIL PROFILE

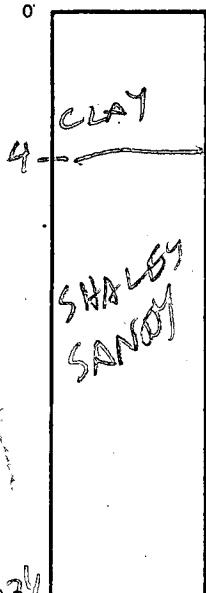

13 1/2
ALL HOLES
SMALL AMTS.
WEATHERED
SHALES

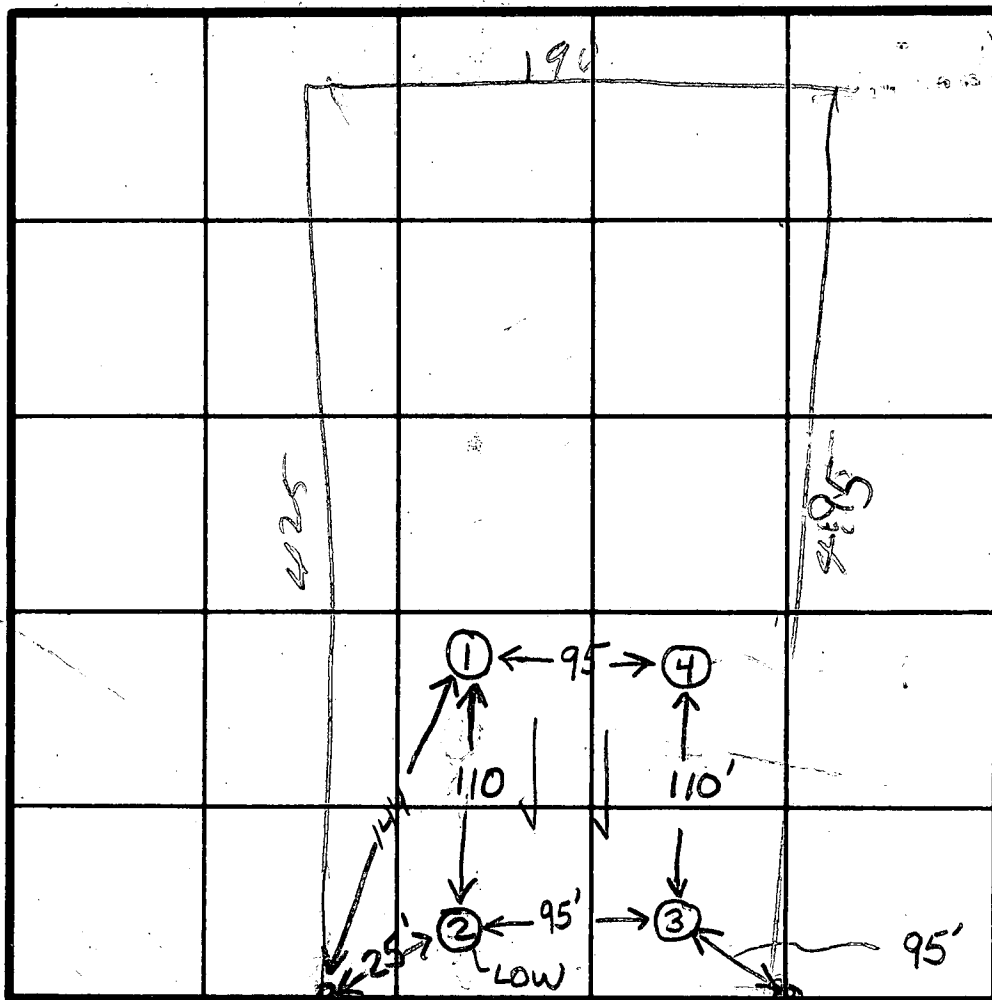

① 3 ④
EQUALLY
HIGH

② 3 ③
EQUALLY
LOW

INDICATE NORTH - NAME ADJOINING ROADWAY AS BASE LINE.

COUNT A

DATE	TEST NO.	DEPTH	PRE-WET		TEST - 1" DROP		TIME
			START	STOP	START	STOP	
3/20/79	1 D	13 1/2	207	227	227	253	26
3/20/79	1 S	5 1/2	207	215	215	227	8
3/30/79	2S	4	146	154	154	200	6
	2D	13	145	147	147	151	4
	3S	5	155	158	158	208	10
	3D	14	155	202	202	213	11
	4S	5	215	216	216	220	4
	4D	12 1/2	VISUAL - SIMILAR TO		③		

REMARKS open field

TYPE OF SOIL

TESTED BY BH

ALSO PRESENT DENNY T. DEURA

APPLICATION⁶

SEWAGE DISPOSAL TESTING

STATE OF MARYLAND - DEPARTMENT OF HEALTH AND MENTAL HYGIENE

HOWARD COUNTY HEALTH DEPARTMENT
ENVIRONMENTAL HEALTH SERVICES

P.O. BOX 476 ELLICOTT, MARYLAND 21043
TELEPHONE: 992-2330

A 29478

P

DISTRICT 4th

DATE 2/1/79

TO: THE COUNTY HEALTH OFFICER
ELLICOTT CITY, MARYLAND

I, HEREBY, APPLY FOR THE NECESSARY TEST IN ORDER TO CONSTRUCT (OR RECONSTRUCT) A SEWAGE DISPOSAL SYSTEM.

PROPERTY OWNER Georgia Conn property, c/o E. Brooke Lee

ADDRESS 10000 Sweepstakes Road, Damascus, Md. 20750 PHONE Boender - 465-7777

PROPERTY LOCATION:

SUBDIVISION

LOT NO.

ROAD AND DESCRIPTION

Watersville Road

SIZE OF LOT 3 acres m/1

TYPE BLDG. 3 or 4 bedrooms

THE SYSTEM INSTALLED UNDER THIS APPLICATION IS ACCEPTABLE ONLY UNTIL PUBLIC FACILITIES BECOME AVAILABLE.

I FULLY UNDERSTAND THE FEE CONNECTED WITH THE FILING OF THIS PERC TEST APPLICATION IS NON-REFUNDABLE UNDER

ANY CIRCUMSTANCES.

SIGNATURE OF APPLICANT /s/ Jack Boender for E. Brooke Lee

APPROVED BY FOR DATE

REJECTED BY FOR DATE

HOLD PENDING FURTHER TESTS DATE

REASONS FOR REJECTION OR HOLDING



THIS IS NOT A PERMIT

320



6

120
103.5

SOIL PROFILE

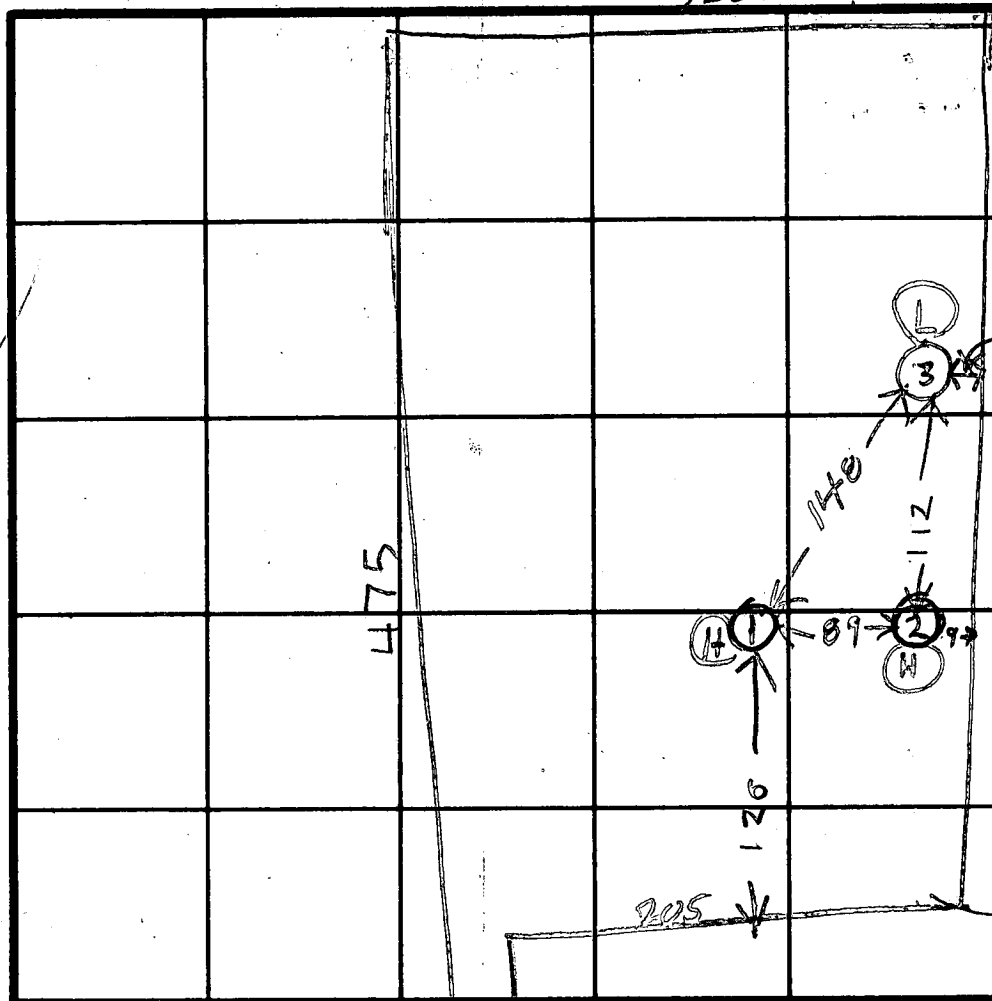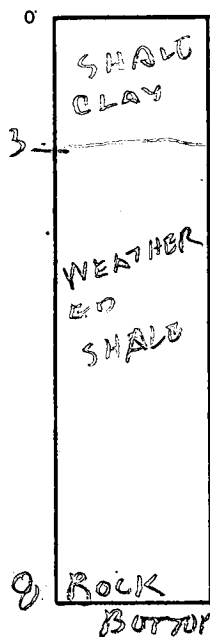

INDICATE NORTH - NAME ADJOINING ROADWAY AS BASE LINE.

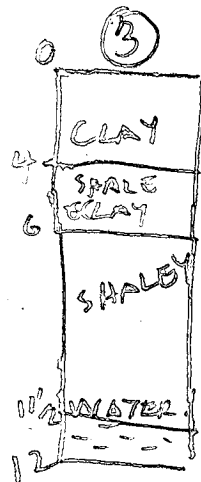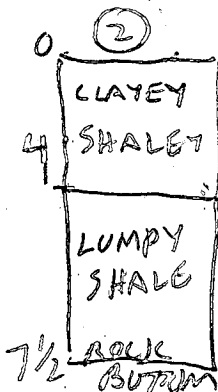

DATE	TEST NO.	DEPTH	PRE-WET		TEST - 1" DROP		TIME
			START	STOP	START	STOP	
5/2/77	①	8	SEE SOIL PROFILE ROCK BOTTOM				HIGH
5/2/77	②	7 1/2	SEE SOIL PROFILE ROCK BOTTOM				HIGH
5/1/77	③	12	SEE SOIL PROFILE WATER 11 1/2 FT.				LOW

REMARKS _____

TYPE OF SOIL _____

TESTED BY BH

ALSO PRESENT DENNIS GARY

APPLICATION

lot 5

A 27893

SEWAGE DISPOSAL TESTING

P _____

STATE OF MARYLAND - DEPARTMENT OF HEALTH AND MENTAL HYGIENE

HOWARD COUNTY HEALTH DEPARTMENT
ENVIRONMENTAL HEALTH SERVICES
P. O. BOX 476, ELLICOTT CITY, MARYLAND 21043
TELEPHONE: 465-5000, EXT. 356

DISTRICT 4th
DATE 4/18/78

TO: THE COUNTY HEALTH OFFICER
ELLICOTT CITY, MARYLAND

I, HEREBY, APPLY FOR THE NECESSARY TEST IN ORDER TO CONSTRUCT (OR RECONSTRUCT) A SEWAGE DISPOSAL SYSTEM.

PROPERTY OWNER GA-Conn. Inc. & Conn.-Aspen Inc.

ADDRESS _____ PHONE _____

PROPERTY LOCATION:

SUBDIVISION _____ LOT NO. Now 3
old 4, old 5, old 6

ROAD AND DESCRIPTION Watersville Rd.

SIZE OF LOT ? TYPE BLDG. 3 or 4
Combined to make
new 3

NUMBER OF BEDROOMS

IF NOT SINGLE RESIDENCE DESCRIBE _____

THE SYSTEM INSTALLED UNDER THIS APPLICATION IS ACCEPTABLE ONLY UNTIL PUBLIC FACILITIES BECOME AVAILABLE.

SIGNATURE OF APPLICANT /s/ E. Brooke Lee

APPROVED BY _____ FOR _____ DATE _____
(KIND OF SYSTEM)

REJECTED BY _____ FOR _____ DATE _____
(KIND OF SYSTEM)


HOLD PENDING FURTHER TESTS F. Skinner DATE 5/12/78

REASONS FOR REJECTION OR HOLDING 7/17/78 - Poor soil (clay, water, or
Rock throughout lot) GLK

THIS IS NOT A PERMIT

INTER STATE 70

2 = highest
part of
lot

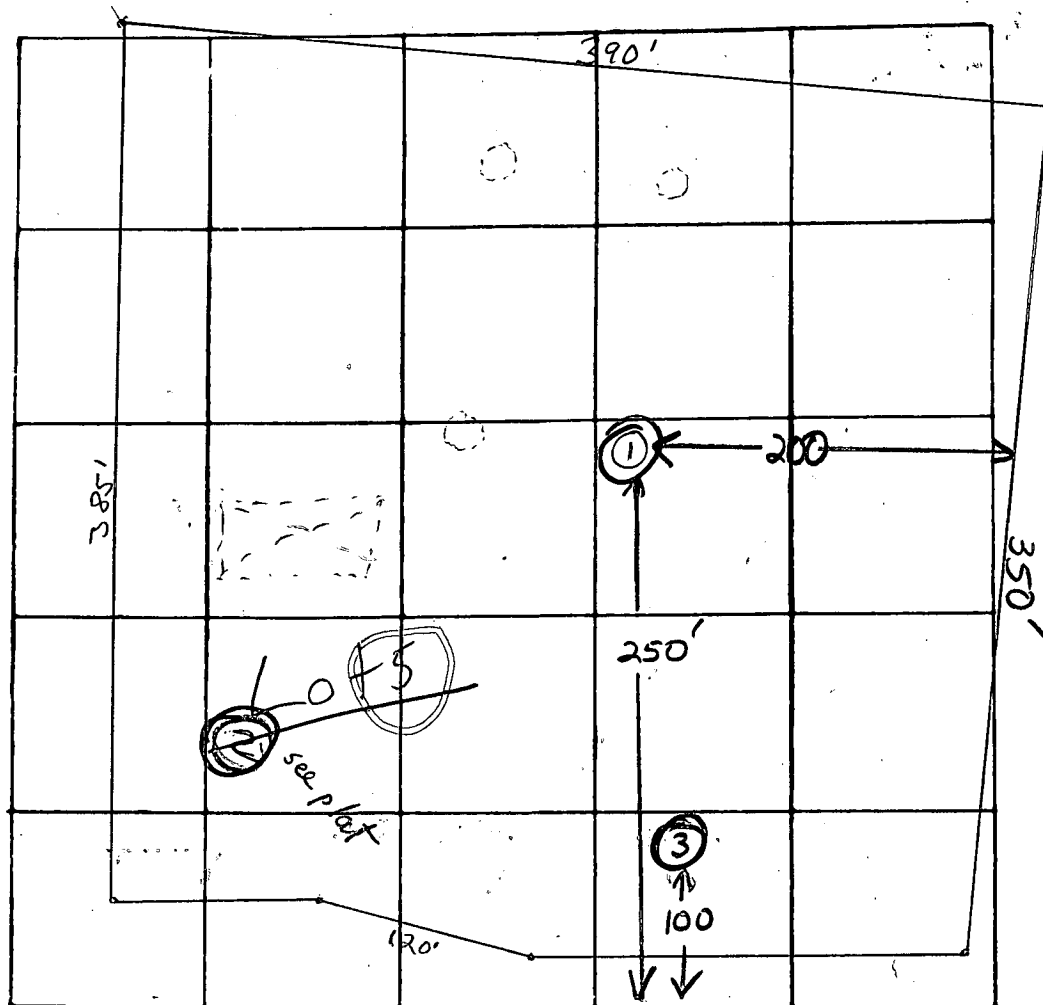

INDICATE NORTH - NAME ADJOINING ROADWAY AS BASE LINE

Watersville Rd.

DATE	TEST NO.	DEPTH	PRE-WET		TEST - 1" DROP		TIME	
			START	STOP	START	STOP		
5/11/78	①	6'	1:41	polled pgs	2:03	1/4" drop	FAILS	
	①A	13'	Clayey throughout					
7/14/78	2	hard blue mica at 2'						
	③	water at 3'						

REMARKS

TYPE OF SOIL

clayey

TESTED BY

F.S. on 5/11/78

ALSO PRESENT:


Rick Fyncke crew

Lot 5

INTERSTATE 70

2: highest part of lot

A29473

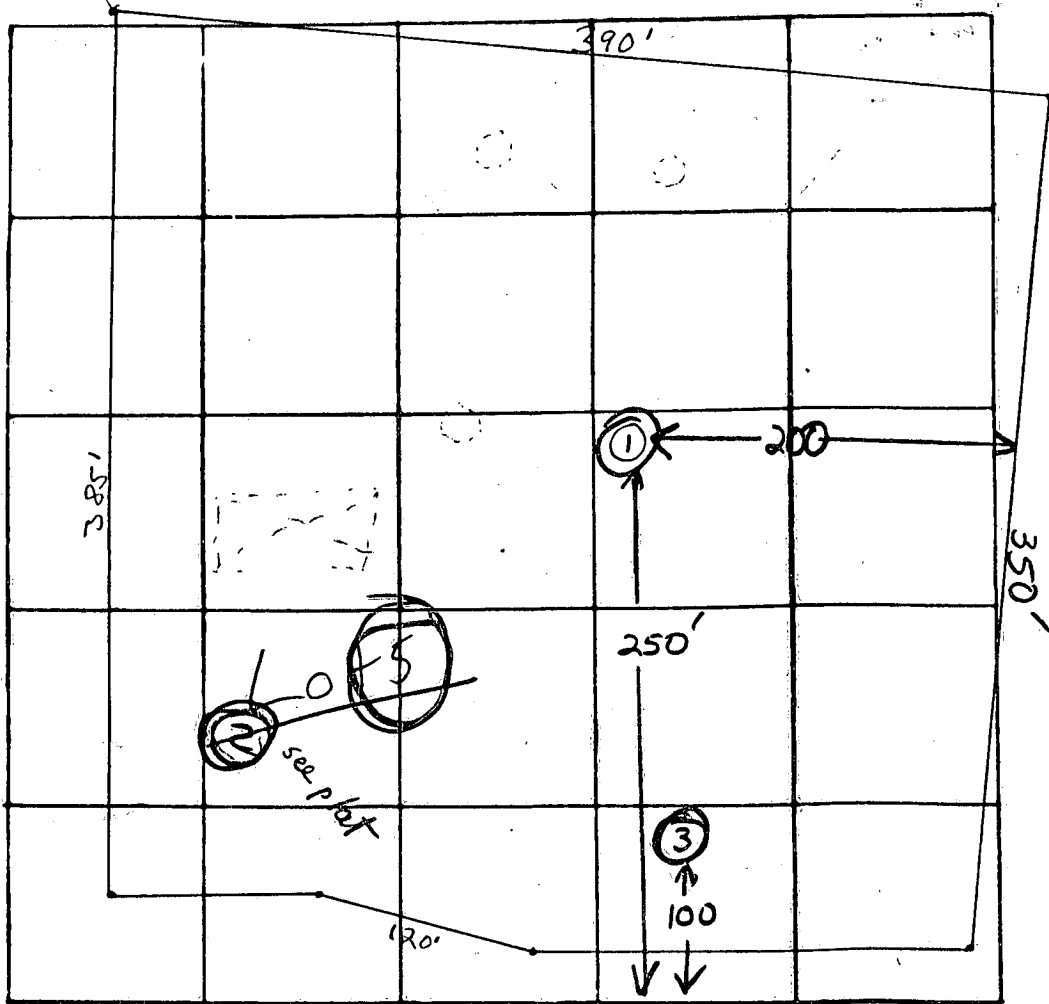

INDICATE NORTH - NAME ADJOINING ROADWAY AS BASE LINE
Watersville Rd.

DATE	TEST NO.	DEPTH	PRE-WET		TEST - 1" DROP		TIME
			START	STOP	START	STOP	
5/11/78	①	6'	1:41	pulled ppg	2:03	1/4" drop	FAILS
	①A	13'	Clayey throughout				
7/14/78	2	hard blue mica at 2'					
	③	water at 3'					

REMARKS _____

TYPE OF SOIL clayey

TESTED BY F. S. on 5/11/78

ALSO PRESENT: Rick Fyncks crew

James E. Wallace Jr.
364/282

John R. Irwin
954/220

LOT 3
10.879 AC.

Sewer Line Elevations	
Invert elev. (out of house)	- 703.0
" " (into septic)	- 702.6
" " (out of tank)	- 702.3
" " (into dry well)	- 701.9
" " (out of ")	- 701.3

House elevations:	
R.F. 709.8	corner
R.R. 708.2	corner
L.F. 707.0	ground
L.R. 706.6	ground
House Floor elev. 706.6	
Basement elev. 701.6	

NOV. 4, 1982
Foremost Industries Inc.
2375 Buchanan Trail West
Greencastle, PA 17225
Telephone: (717) 597-7166
Md Sales Mgr & Balto.-Wash. Co-Ord.
J. Hoke Rosensteel
404 N. Main St. Mt. Airy, Md.
21771 Phone (301) 829-0886

Poplar Springs Lot #3	
Plate # 4849	Parcel A
TAX Map 7	4th Elect. Dist.
From Survey by Boender Assoc.	
J.H.R. For Foremost Industries Inc.	

Scale: 1" = 100'

