

PERMIT
SEWAGE DISPOSAL SYSTEM

A 1072

MARYLAND STATE DEPARTMENT OF HEALTH

HOWARD COUNTY

ELLICOTT CITY

DISTRICT 1

REINDEXED

DATE 6/20/75

Patrick J. Lendrin

IS PERMITTED TO INSTALL ☒ ALTER ☐

ADDRESS 14010 Forvythe Road, Sykesville, Md.

PHONE 442-2416

A SEWAGE DISPOSAL SYSTEM LOCATED AT

SUBDIVISION Sycamore Springs

12270
ROAD Philadelphia

LOT 4

PROPERTY OWNER Alan H. Cohen

Howard Schultze

ADDRESS

SPECIFICATIONS 3 bedrooms

DRAIN FIELD DEPTH FEET, BOTTOM AREA SQ. FT.

SEEPAGE PITS ABSORBENT SIDE-WALL AREA SQ. FT.

SEPTIC TANK CAPACITY 1,000 GALLONS

FOR GARBAGE GRINDER, INCREASE DISPOSAL AREA 25% & TANK CAPACITY 50%.

OTHER Dry well - 125 sq. ft. sidewall area below inlet pipe per bedroom. Inlet no deeper than 4 ft. Max. depth for dry well is 11 ft. below original grade. Place dry well

about 200 ft. from front lot line and about 84 ft. from left side line as seen when facing from Philadelphia Road.

NOTE: ALL SUMP FROM HOUSE TO DISPOSAL AREA MUST BE CAST IRON.

PERMIT VOIDS AFTER THREE YEARS.

NOTE: INSTALL STAND PIPE ON SEPTIC TANK AND DRY WELL. STAND PIPES MUST BE 6" IN DIA., CAST IRON, CONCRETE OR TERRA COTTA ACCEPTED.

PLANS APPROVED BY D. W. McLaughlin

DATE 6/28/66

FILL SEPTIC TANK AND DISTRIBUTION BOX WITH WATER BEFORE CALLING FOR AN INSPECTION. COVER NO WORK UNTIL INSPECTED AND APPROVED.


NEITHER THE HOWARD COUNTY COMMISSIONERS NOR THE HEALTH DEPARTMENT IS RESPONSIBLE FOR THE SUCCESSFUL OPERATION OF ANY SYSTEM.

BLDG. PERMIT SIGNED

AND RETURNED 9-17-88

Serial # BR 114084
Shirley Shu

4 29974-B

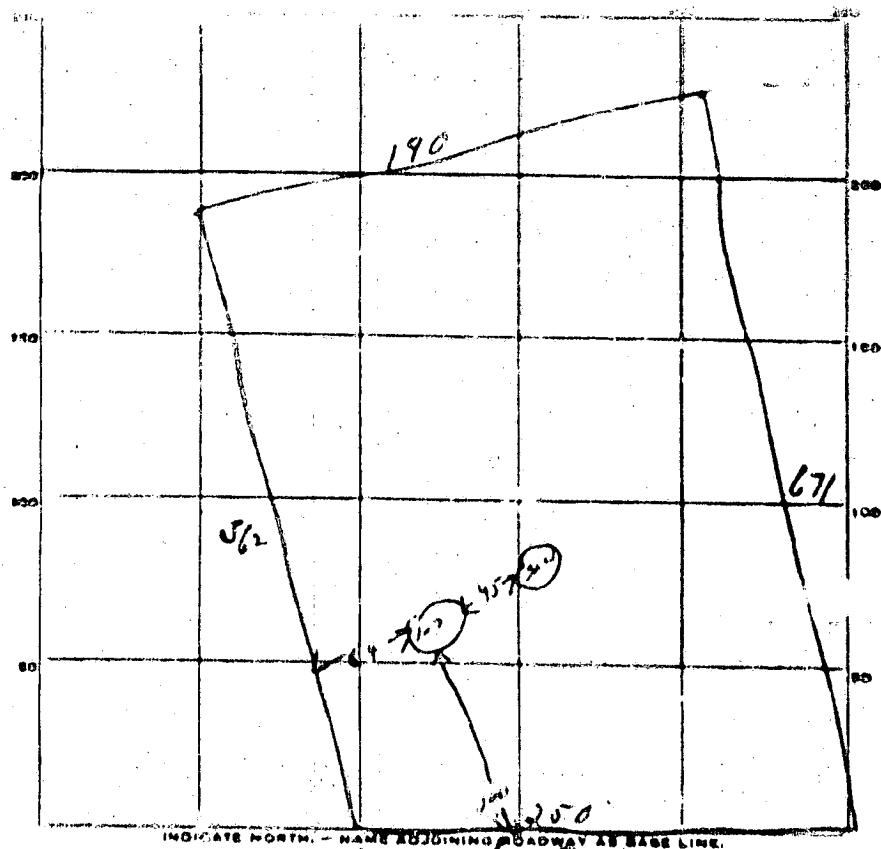

INDICATE NORTH. - NAME ADJOINING ROADWAY AT BASE LINE

Trudolph Rd


DATE	TEST NO.	DEPTH	PRE-WET		TEST - 1" DROP		TIME
			START	STOP	START	STOP	
1/12/66	1	10" N	11	12	11	12	2 min
	2	14" N	11	17	11	21	6 min
	3	16" N	11	19	11	22	2 min
	4	18" N	11	21	11	23	2 min

SOIL ALGER FINDING

TESTED BY JOHN


REMARKS: 3

... INTERLUCE FOR
 IN ESTABLISHING PROPERTY
 LINES.

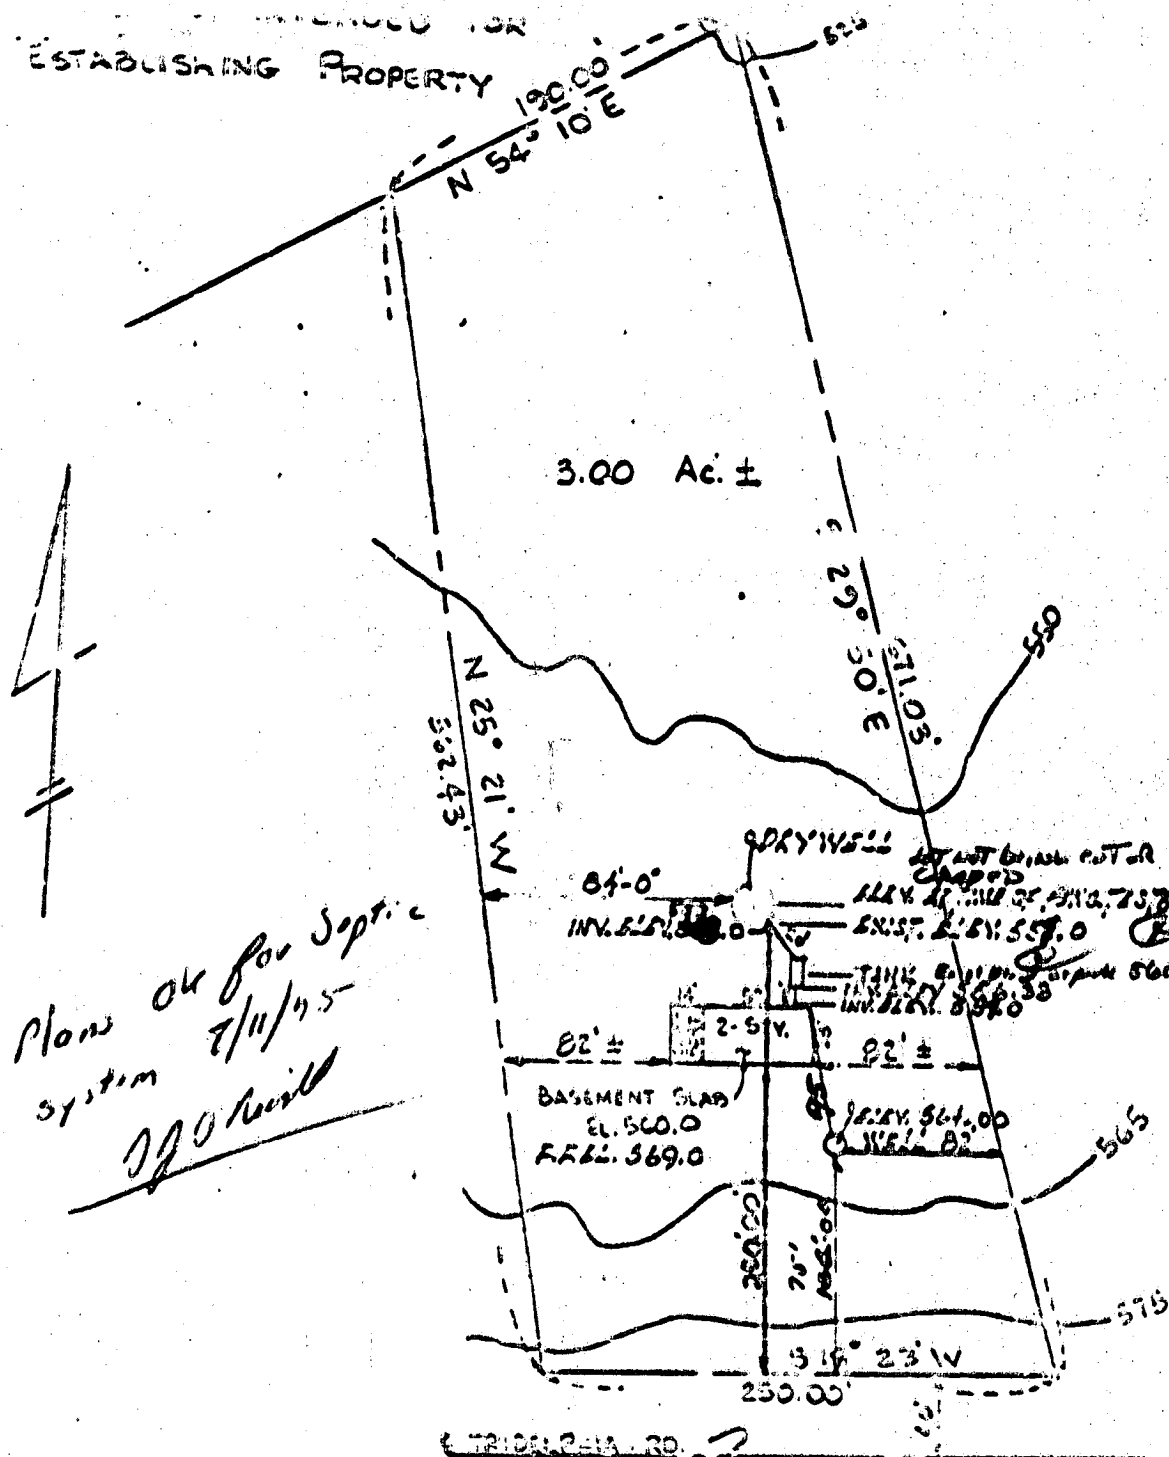

INFORMATION TAKEN
 FROM A PLAN ENTITLED:

SYCAMORE SPRING SUBDIVISION
LOT 4, B. & C. 10

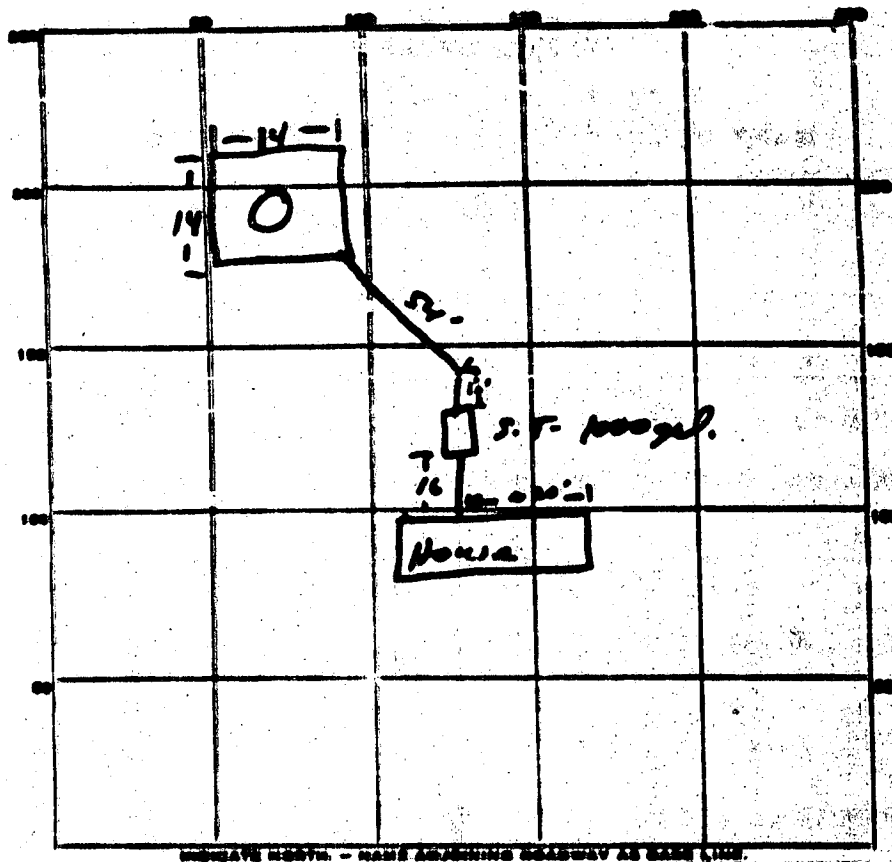

INDICATE NORTH - ROAD ADJOINING SEASIDE AS EAST LINE

PERMIT CARD _____

SEPTIC TANK, LEVEL _____

CLEANOUTS _____

DISTRIBUTION BOX LEVEL _____

TRENCH DEPTH _____ TRENCH WIDTH _____ FT.

GRAVEL DEPTH _____ TOTAL SANDWICH _____ FT.

NUMBER OF TRENCHES _____ TOTAL COVER AREA _____

PERIMETER 52 FT. DEPTH BELOW INLET 8 FT.

ABSORBENT AREA 448 SQ. FT.

REMARKS cleanout to DW. struck in pipe; when handle
pulled, pipe pulled off of lid; reconnect properly and
free lid from pipe

DATE SYSTEM APPROVED

4/2/76


INSPECTOR

R. Mansfield


R.E. BATEMAN et. al.

9/17/98

proposed shed will
have no impact on
well and septic
as shown (KMO)

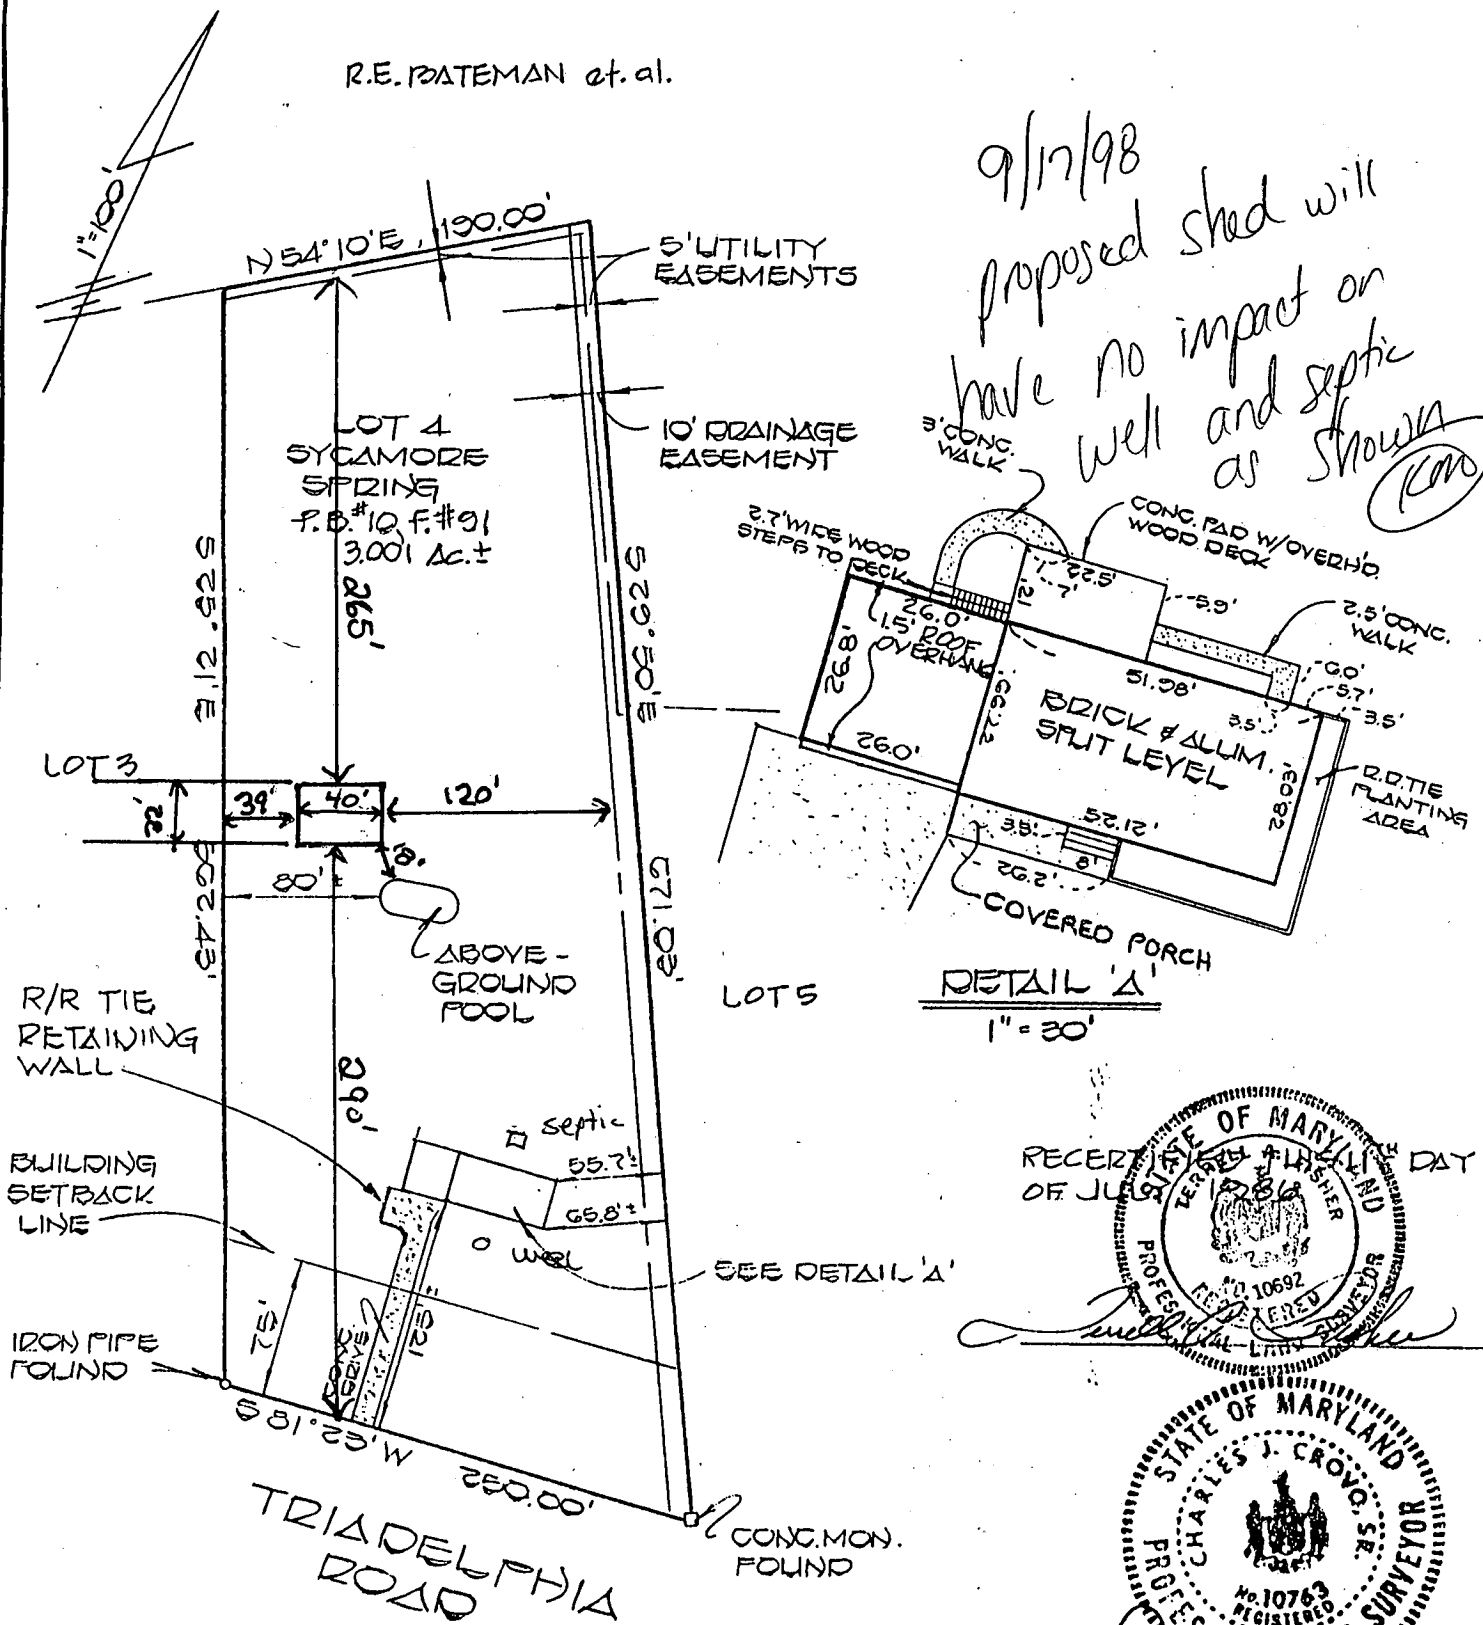

RECEIVED
OF JULY 1998

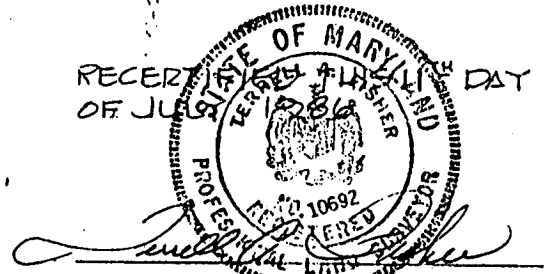

RECEIVED FEBRUARY 4, 1992

This is to certify that I have surveyed the property known as: LOT 4, SYCAMORE SPRING, #12770

TRIADAPLHIA ROAD, HOWARD COUNTY, MARYLAND, RECORDED IN

PLAT BOOK 10 AT FOLIO 91

for the purpose of locating the improvements thereon, and the improvements are located as shown.

Signed this 10th day of JULY 1998

FISHER, COLLINS AND CARTER, INC.
CIVIL ENGINEERS AND LAND SURVEYORS

8388 COURT AVENUE
ELLCOTT CITY, MARYLAND 21043
(301) 461-2855

[Signature]

This plat is not intended for use in
the establishment of property lines.

REC 114

H.L. 292

90422

HL16/2

11712