

# PERMIT

SEWAGE DISPOSAL SYSTEM

MARYLAND STATE DEPARTMENT OF HEALTH

HOWARD COUNTY

05-353505

ELLICOTT CITY

DISTRICT

DATE 7/12/79

INDEXED

Mr. James Hilton

IS PERMITTED TO INSTALL ALTER X

ADDRESS 13816 Wayside Drive, Clarksville, Md.

PHONE

SUBDIVISION (Wayside Estates) ROAD 13816 Wayside Drive LOT 6, Blk.A

PROPERTY OWNER Mr. James Hilton

ADDRESS same as above

SPECIFICATIONS 4 bedrooms

SEPTIC TANK CAPACITY 1250 GALLONS

DRAIN FIELD DEPTH FEET, BOTTOM AREA SQ. FT.

DEEP TRENCH DEPTH FEET, BOTTOM AREA SQ. FT.

SEEPAGE PITS ABSORBENT SIDE-WALL AREA SQ. FT.

INLET PIPE FT. BELOW ORIGINAL GRADE. MAXIMUM DEPTH FT. BELOW ORIGINAL GRADE

EFFECTIVE DEPTH AT FT. BELOW ORIGINAL GRADE.

LOCATE DISPOSAL AREA FT. FROM LOT LINE AND FT. FROM LOT LINE AS SEEN WHEN  
FACING LOT FROM

REPAIR-CALL FOR INSPECTION WHEN GROUND IS OPENED UP SO SANITARIAN CAN RECOMMEND

8/1/79 REPAIR. Trench - 40ft long - 14ft deep - 2ft wide (minimum)  
with at least 8ft stone.

Mr Hilton will verify length & depth & amt of gravel with written statement 7/12/79

PLANS APPROVED BY Palmer F. Wine

DATE

COVER NO WORK UNTIL INSPECTED AND APPROVED.

NEITHER THE HOWARD COUNTY COUNCIL NOR THE HEALTH DEPARTMENT IS RESPONSIBLE FOR THE SUCCESSFUL OPERATION OF ANY SYSTEM.

NOTE: IF TRENCH IS USED CALL FOR INSPECTION BEFORE PLACING GRAVEL IN TRENCH.

NOTE: NO DRY WELL SHALL EXCEED 15 FOOT IN DIAMETER.


NOTE: ALL PIPE FROM HOUSE TO DISPOSAL AREA MUST BE CAST IRON.

PERMIT VOID AFTER THREE YEARS.

NOTE: INSTALL STAND PIPE ON SEPTIC TANK AND DRY WELL. STAND PIPES MUST BE 6 INCHES IN DIAMETER. CAST IRON, CONCRETE OR TERRA  
COTTA ACCEPTED.

\*INSTALLER IS RESPONSIBLE FOR OBTAINING FINAL APPROVAL ON THIS PERMIT.

P29982

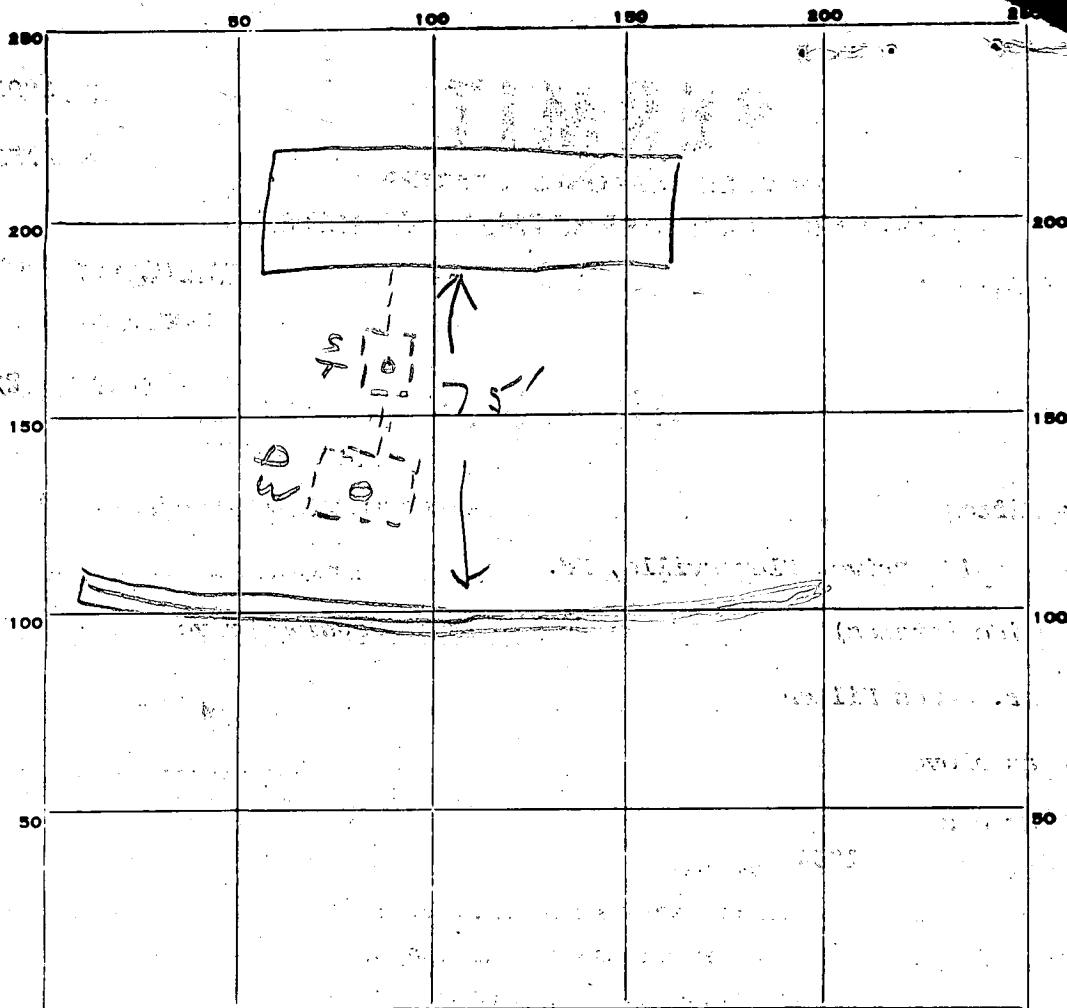

INDICATE NORTH. - NAME ADJOINING ROADWAY AS BASE LINE.

PERMIT CARD \_\_\_\_\_

SEPTIC TANK, LEVEL \_\_\_\_\_

CLEANOUTS \_\_\_\_\_

DISTRIBUTION BOX, LEVEL \_\_\_\_\_

TILE FIELD, DEPTH 11 FT. TRENCH WIDTH 2 FT.

GRAVEL DEPTH 8' IN. TOTAL LENGTH 75 FT.

NUMBER OF TRENCHES 1 TOTAL BOTTOM AREA 600

SEEPAGE PITS, INSIDE DIAMETER \_\_\_\_\_ FT. DEPTH BELOW INLET \_\_\_\_\_ FT.

ABSORBENT AREA 600 SQ. FT.

8/8/79  
REMARKS OK to cover trench JS

DATE SYSTEM APPROVED

8/8/79

INSPECTOR

J. [Signature]

Aug. 6. 1979

HOWARD COUNTY HEALTH DEPT.  
P.O. Box 476  
ELLCOTT CITY, MD. 21043

DEAR MR. MONAHAN

I HEREBY CERTIFY THAT  
THE DRAIN DITCH LOCATED ON MY PROPERTY  
AT LT6 BLKA (13816) WAYSIDE DR., WAYSIDE ESTATES,  
CHARKSVILLE, MD. IS 78' LONG, WITH A MINIMUM OF  
12' IN DEPTH AND 65 TONS OF #1 AND #2 STONE  
IN SAID DITCH. THE STONE IS APPROXIMATELY  
10' IN DEPTH FOR THE LENGTH OF THE TRENCH  
THE WIDTH OF THE DITCH IS 2'.

IF ANY ADDITIONAL INFORMATION IS  
NECESSARY PLEASE CALL MY HOME AT  
286-2970

Very Truly Yours  
James J. Nitta