

10/19/82 App JTS

10/19/82

PERMIT

P 32190

SEWAGE DISPOSAL SYSTEM

A 28417

MARYLAND STATE DEPARTMENT OF HEALTH

HOWARD COUNTY

ELLICOTT CITY

DISTRICT 3rd.

INDEX

DATE 9/21/82

R. L. O. Contractor _____ IS PERMITTED TO INSTALL ALTER _____

ADDRESS 13938 Highland Road, Clarksville, Md. 21029 PHONE 596-9394

SUBDIVISION Farside ROAD 11910 Farside Road LOT 39

PROPERTY OWNER Richard Smith Floyd + Medna Malveaux

ADDRESS _____

SPECIFICATIONS 3 Bedrooms

SEPTIC TANK CAPACITY 1000 GALLONS

DRAIN FIELD _____ DEPTH _____ FEET. BOTTOM AREA _____ SQ. FT.

DEEP TRENCH _____ DEPTH _____ FEET. BOTTOM AREA _____ SQ. FT.

Dry Well SEEPAGE PITS ABSORBENT SIDE-WALL AREA 150 SQ. FT. per bedroom

INLET PIPE 4 FT. BELOW ORIGINAL GRADE. MAXIMUM DEPTH 10 FT. BELOW ORIGINAL GRADE

EFFECTIVE DEPTH AT _____ FT. BELOW ORIGINAL GRADE.

LOCATE DISPOSAL AREA 55 FT. FROM left LOT LINE AND 142 FT. FROM Front LOT LINE AS SEEN WHEN FACING LOT FROM Farside Road

NOTE: Okay to used trench if needed: (1) 5 ft. earth buffer between dry well and trench (2) 2 inspections of trench - before and after stone in (3) Run trench on contour of land.

PLANS APPROVED BY C. B. Streaker DATE 12/18/79

COVER NO WORK UNTIL INSPECTED AND APPROVED.

NEITHER THE HOWARD COUNTY COUNCIL NOR THE HEALTH DEPARTMENT IS RESPONSIBLE FOR THE SUCCESSFUL OPERATION OF ANY SYSTEM.

NOTE: IF TRENCH IS USED CALL FOR INSPECTION BEFORE PLACING GRAVEL IN TRENCH.

NOTE: NO DRY WELL SHALL EXCEED 15 FOOT IN DIAMETER.

NOTE: ALL PIPE FROM HOUSE TO DISPOSAL AREA MUST BE CAST IRON.


PERMIT VOID AFTER THREE YEARS.

NOTE: INSTALL STAND PIPE ON SEPTIC TANK AND DRY WELL. STAND PIPES MUST BE 6 INCHES IN DIAMETER. CAST IRON, CONCRETE OR TERRAZO ACCEPTED.

*INSTALLER IS RESPONSIBLE FOR OBTAINING FINAL APPROVAL ON THIS PERMIT.

BLDG. PERMIT SIGNED AND RETURNED 9/24/82
Serial # 44136
deed

BLDG. PERMIT SIGNED AND RETURNED 9/24/82
Serial 439718
Storage Shed

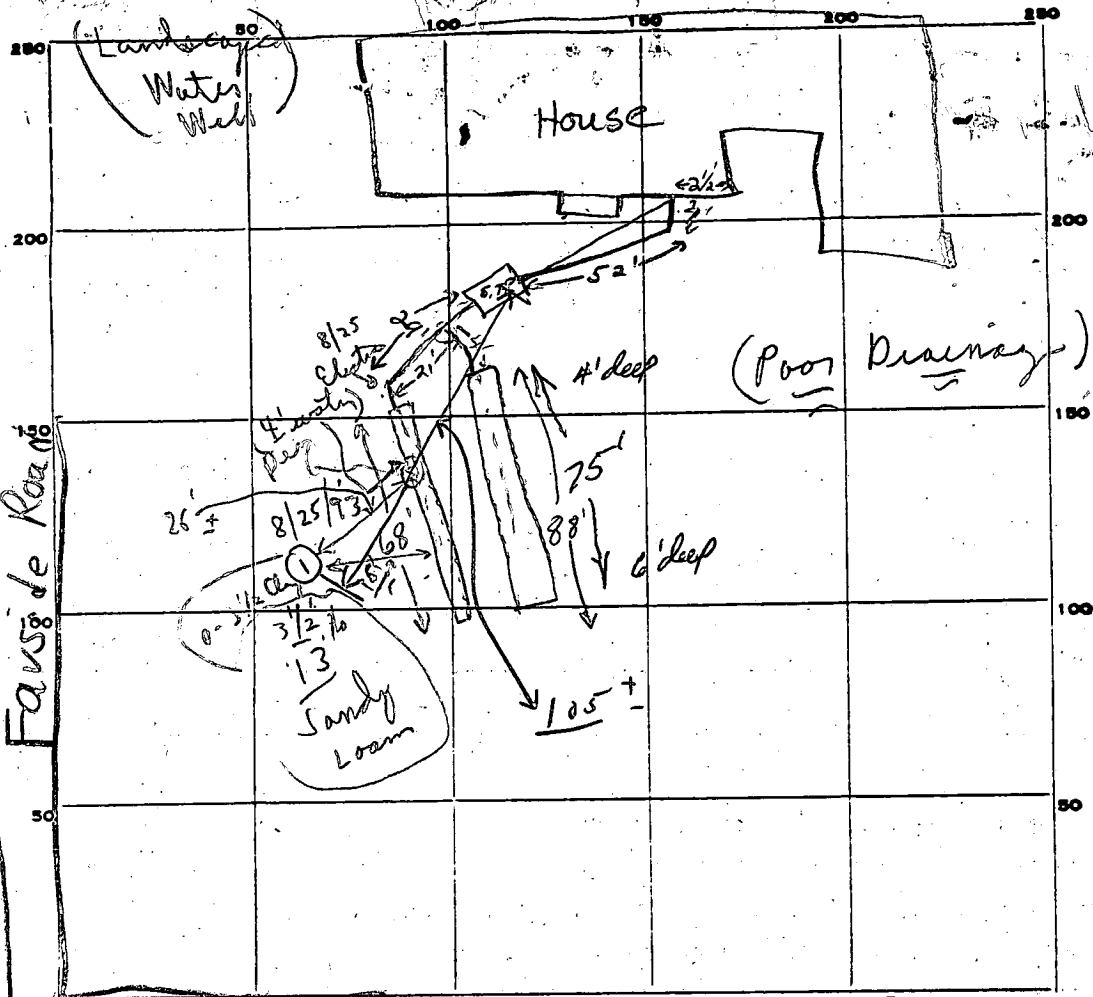

INDICATE NORTH. - NAME ADJOINING ROADWAY AS BASE LINE.

Road

PERMIT CARD *Septic work ok to continue*

SEPTIC TANK, LEVEL

CLEANOUTS S.T. OK.

DISTRIBUTION BOX, LEVEL n/a

TILE FIELD, DEPTH 4-6 FT. TRENCH WIDTH 3 FT.

GRAVEL DEPTH 1 1/2 FT. TOTAL LENGTH 156 FT.

NUMBER OF TRENCHES 2 TOTAL BOTTOM AREA 468 sq. ft.

SEEPAGE PITS, INSIDE DIAMETER _____ FT. DEPTH BELOW INLET ~ 2 FT.

ABSORBENT AREA ± 468 SQ. FT.

REMARKS 10-18-82, trench 75' long 4' deep near tank 6' deep toward road because ground higher toward road, ok to add gravel to both trenches J.F.

10/19/82 O.K. to continue J.F.S.

DATE SYSTEM APPROVED

10/19/82

INSPECTOR

R. Shuman

2
150
3 | 450