

PERMIT

SEWAGE DISPOSAL SYSTEM

MARYLAND STATE DEPARTMENT OF HEALTH

HOWARD COUNTY

ELLICOTT CITY

DISTRICT 3

DATE 11/10/73

P 19257

A 13005

INDEXED

Jack Fyock

IS PERMITTED TO INSTALL X ALTER

ADDRESS Ten Oaks Road, Glenelg, Md.

PHONE 286-2939

A SEWAGE DISPOSAL SYSTEM LOCATED AT _____

SUBDIVISION Woodmark, Inc.

ROAD

12212
Fawnhaven Ct. &
Carroll Mill Rd.

LOT 26, Blk. B,
Sec. 2

PROPERTY OWNER Woodmark, Inc.

ADDRESS

Robert Segraves

SPECIFICATIONS 3 bedrooms

DRAIN FIELD _____ DEPTH _____ FEET, BOTTOM AREA _____ SQ. FT.

SEEPAGE PITS _____ ABSORBENT SIDE-WALL AREA _____ SQ. FT.

SEPTIC TANK CAPACITY 1,000 GALLONS

FOR GARBAGE GRINDER, INCREASE DISPOSAL AREA 22% & TANK CAPACITY 50%.

OTHER Dry well - 125 sq. ft. absorbent sidewall area per bedroom to begin below

inlet. Inlet to be 4 ft. below original grade. Max. depth of dry well 12 ft. below

original grade. Place dry well about 65 ft. from front lot line and 34 ft. from left

side line as seen when facing from Fawnhaven Ct.

NOTE: ALL PIPE FROM HOUSE TO DRY WELL MUST BE CAST IRON.

PERMIT VOID AFTER THREE YEARS.

NOTE: INSTALL STAND PIPE ON SEPTIC TANK AND DRY WELL.

PLANS APPROVED BY D. W. Monaghan DATE 3/12/68

FILL SEPTIC TANK AND DISTRIBUTION BOX WITH WATER BEFORE CALLING FOR AN INSPECTION. COVER NO WORK UNTIL INSPECTED AND APPROVED.

NEITHER THE HOWARD COUNTY COMMISSIONERS NOR THE HEALTH DEPARTMENT IS RESPONSIBLE FOR THE SUCCESSFUL OPERATION OF ANY SYSTEM.

A 13005


11/13/73
after 12 noon

11/15/73

988-9245

Hell-Center

Planning on job

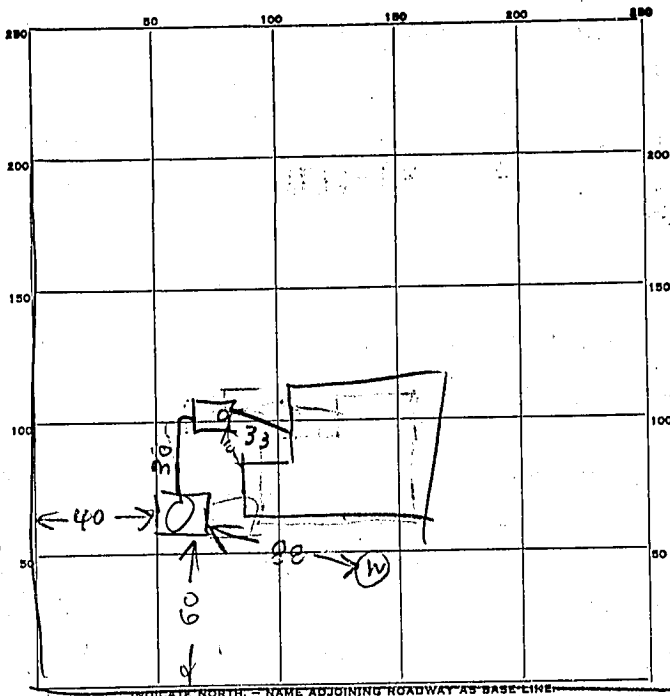

INDICATE NORTH - NAME ADJOINING ROADWAY AS BASE LINE
FAWN HAVEN CT

14
 14
 14
 42
 11
 5

54
 7.5
 270

54

PERMIT CARD _____

SEPTIC TANK, LEVEL OK, 000 concrete CLEANOUTS OK

Top in 26' 3" below grade

DISTRIBUTION BOX, LEVEL _____

TILE FIELD, DEPTH _____ FT. TRENCH WIDTH _____ FT.

GRAVEL DEPTH _____ IN. TOTAL LENGTH _____ FT.

NUMBER OF TRENCHES _____ TOTAL BOTTOM AREA _____

SEEPAGE PITS, INSIDE DIAMETER 10 FT. DEPTH BELOW INLET 7 1/2 FT.

379
 4050

125

ABSORBENT AREA 405 SQ. FT. country stone

REMARKS 11/13/73 - Not Ready Fyock said He will call later R.A
11/15/73 - Day Well in Oct. 3 1/2 FT below grade
Parameter in 5' 4" FT

DATE SYSTEM APPROVED 11/15/73 INSPECTOR Raymond Hodge