

6/8/01
Layout - 1:00
6/11/01
Late PM
6/12/01
10:00

PERMIT

SEWAGE DISPOSAL SYSTEM
HOWARD COUNTY HEALTH DEPARTMENT
BUREAU OF ENVIRONMENTAL HEALTH
410-313-2640

P 515277-A

A 57679-H

ISSUE DATE 6/6/2001

APPROVAL DATE 6/12/01

01-243969

INDEXED

Union Paving Company, Inc

IS PERMITTED TO INSTALL ALTER

ADDRESS 5977 Sandy Ridge Road, Elkridge, MD 21075 PHONE 410-397-6463

SUBDIVISION Rosebar LOT NUMBER 20 ADDRESS 3030 Hobbs Road

PROPERTY OWNER Michael Pritchard PROPERTY OWNER'S ADDRESS 8376 Glenmar Rd, EC 21043

SEPTIC TANK CAPACITY 1500 GALLONS * TOP SEAMED SEPTIC TANK REQUIRED *

PUMP CHAMBER CAPACITY N/A GALLONS

NUMBER OF BEDROOMS 5

SQUARE FEET PER BEDROOM 210

LINEAR FEET OF TRENCH REQUIRED 263

TRENCHES: Trenches to be 2 feet wide. Inlet 2 feet below original grade. Bottom maximum depth

6 feet below original grade. 4 feet of stone below distribution ~~box~~ pipe

LOCATION: Place the distribution box 210 feet down the right lot line and 10 feet off this same lot line. Run (3) trenches on contour toward front of lot as shown on plan.

KEEP 100' FROM WELL TO SEPTIC TANK

PLANS APPROVED Mark Rifkin, R.S. OKSRH DATE 3/21/2001

3/23/01

PERMIT VOID AFTER 2 YEARS

NOTE: CONTRACTOR RESPONSIBLE FOR SCHEDULING A PRE-CONSTRUCTION INSPECTION FOR ALL INSTALLATIONS

NOTE: TOP OF SEPTIC TANKS ARE TO BE NO DEEPER THAN 3.0 FEET BELOW FINISH GRADE

NOTE: WATERTIGHT SEPTIC TANKS REQUIRED

NOTE: CLEANOUT REQUIRED EVERY 70 FEET OF SEWER LINE AND/OR AT 90° SWEEPS IN LINES FROM HOUSE TO DRAIN FIELDS, 90° ELBOWS ARE NOT ACCEPTABLE

NOTE: ALL PARTS OF SEPTIC SYSTEMS (I.E. TANK, DISTRIBUTION BOX, DRAINFIELDS) TO BE 100 FEET FROM ANY WATER WELL UNLESS OTHERWISE SPECIFICALLY AUTHORIZED

NOTE: NO ABSORPTION TRENCH TO EXCEED 100 FEET IN LENGTH UNLESS SPECIFICALLY AUTHORIZED

NOTE: ALL PIPE FROM HOUSE TO SEPTIC TANK MUST BE CAST IRON OR SCHEDULE 35/40 PVC OR ABS

NOTE: MANHOLE RISERS REQUIRED ON ALL SEPTIC TANKS AND PUMP CHAMBERS

NOTE: DISTRIBUTION BOXES MUST HAVE BAFFLES

NOTE: IF PUMPED SEPTIC SYSTEM REQUIRED, (1) SEPTIC PUMP DETAIL TO BE PROVIDED BY INSTALLER PRIOR TO ISSUANCE OF SEPTIC PERMIT (2) PUMP PERFORMANCE TEST IS NECESSARY PRIOR TO HEALTH DEPARTMENT APPROVAL OF SEPTIC PERMIT


BUILDING PERMIT SIGNED

AND RETURNED 6-26-02
BOO B 7144 DECK

NEITHER THE HOWARD COUNTY COUNCIL NOR THE HEALTH DEPARTMENT IS RESPONSIBLE FOR THE SUCCESSFUL OPERATION OF ANY SYSTEM
PERMITTEE RESPONSIBLE FOR OBTAINING FINAL APPROVAL ON THIS PERMIT
CALL 410-313-2640 FOR INSPECTION OF SEPTIC SYSTEM

1015277-1

NOT TO SCALE

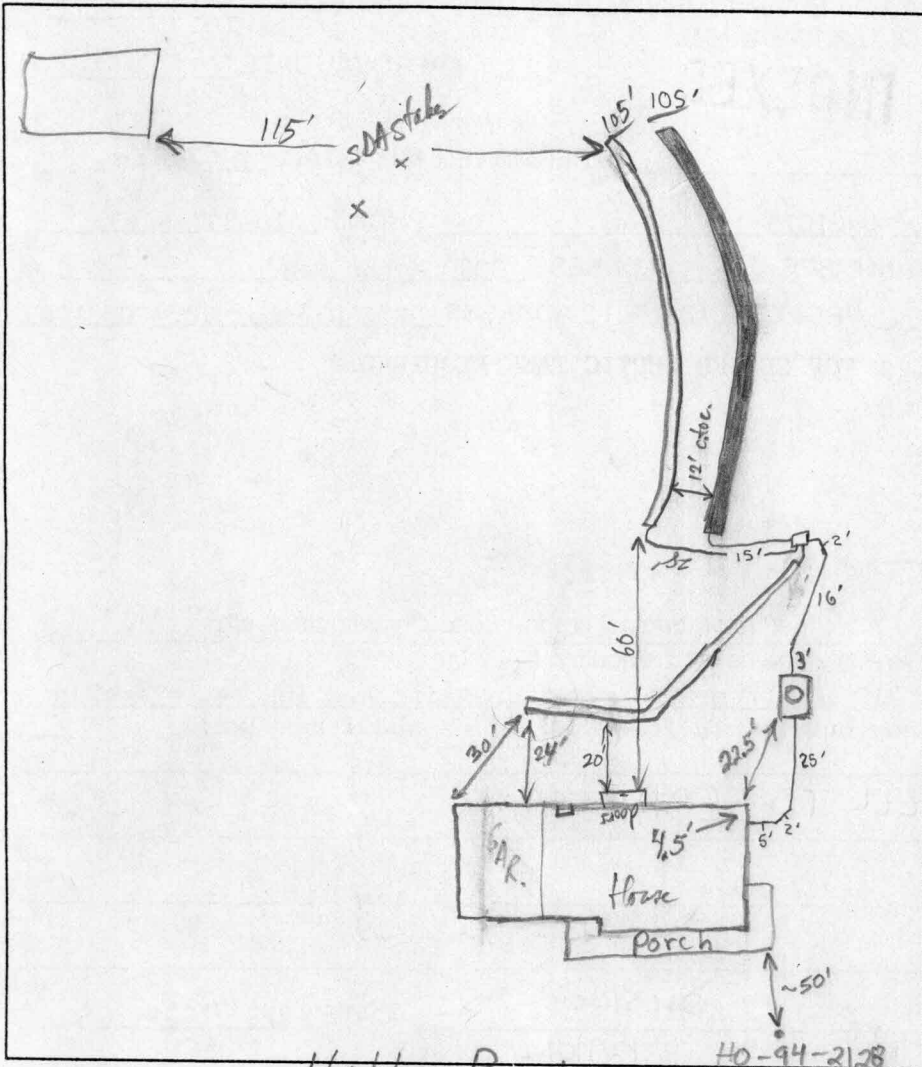

Hobbs Road

HO-94-2128

TRENCH DATA

TRENCH WIDTH 2'
 TRENCH INLET DEPTH 2'
 TRENCH BOTTOM DEPTH 6'
 DEPTH OF STONE 4'
 NUMBER OF TRENCHES 3
 (2 x 105') + (1 x 60')
 TOTAL TRENCH LENGTH 270 LF
 ABSORBENT AREA 1040 sq ft
 DISTRIBUTION BOX LEVEL
 BAFFLE IN DISTRIBUTION BOX

SEPTIC TANK DATA

SEPTIC TANK 1500 TS GALLONS
 MANHOLE RISER Yes on center
 6 INCH INSPECTION PORT _____

PUMP CHAMBER DATA N/A

~~PUMP CHAMBER GALLONS _____
 MANHOLE RISER _____
 ALARM _____
 PUMP PERFORMANCE TEST _____~~

PRE-CONSTRUCTION INSPECTION: 6/8/01 2-long trenches towards back lot line.

1-60 to 65' trench near house. Trenches may have more than 8' of spacing in places due to contour. (BA)
 INSPECTION COMMENTS: 6/8/01 Tank set. W/R O.K. (BB) (House connection complete (40' in ground))
6/11/01- ON TO CONTINUE WORK - (SRU) Septic Trenches O.K. to cover. O.K. to cover all. (RP) 6/12/01

BUILDING PERMIT SIGNED
 AND RETURNED

INSPECTOR Ronald Wally

DATE SYSTEM APPROVED 6/12/01

N39°41'58"E
127.20'

30' BRL

LOT 20
40,000 Sq.Ft.

LEGEND

- O/H = OVERHANG
- A/C = HEAT PUMP/AIR COND.
- G/M = GAS METER
- E/M = ELECTRIC METER
- C = CHIMNEY
- B/W = BAY WINDOW
- D/W = DRIVEWAY
- CONC = CONCRETE
- S = CONC STOOP


S 69°40'36" E 357.80'

LOT 21

N75°48'W 322.16'

WALL CHECK
OK
6/5/07

LOT 19

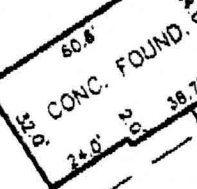

TOP OF WALL ELEV. = 607.8±
FIRST FLOOR ELEV. =
ADDRESS: HOBBS ROAD

LOT 20
ROSEBAR PROPERTY

LOTS 14 THRU 22
& PRES. PARCEL A
A RESUBDIVISION OF
LOTS 10 THRU 13

HOBBS ROAD
(50' ROW)

PLAT NO. 14033
ELECTION DISTRICT No. 4
HOWARD COUNTY, MARYLAND

THE INFORMATION SHOWN HAS BEEN ESTABLISHED BY CURRENT ACCEPTABLE SURVEY PROCEDURES AND FROM AVAILABLE RECORD INFORMATION. THIS DRAWING IS TO BE USED FOR TITLE TRANSFER FINANCING, OR REFINANCING ONLY AND IS NOT TO BE USED FOR THE ESTABLISHMENT OF PROPERTY LINES, LOCATION OF FENCES, GARAGES, BUILDINGS, OR OTHER EXISTING OR FUTURE IMPROVEMENTS.